




FIELD BOLT SUMMARY				NOTE: 4% ADDITIONAL BOLTS ADDED + 3 FOR TESTING	
LINE	No. OF BOLT BOLTS/DIAM	TYPE	BOLT LENGTH	ACTUAL COUNT	REMARKS
1	97	3/8" ASTM - A325 TYPE 3	2 1/2"	90	w / 1 FLAT WASHER
2	-	-	-	-	-
3	-	-	-	-	-
4	-	-	-	-	-

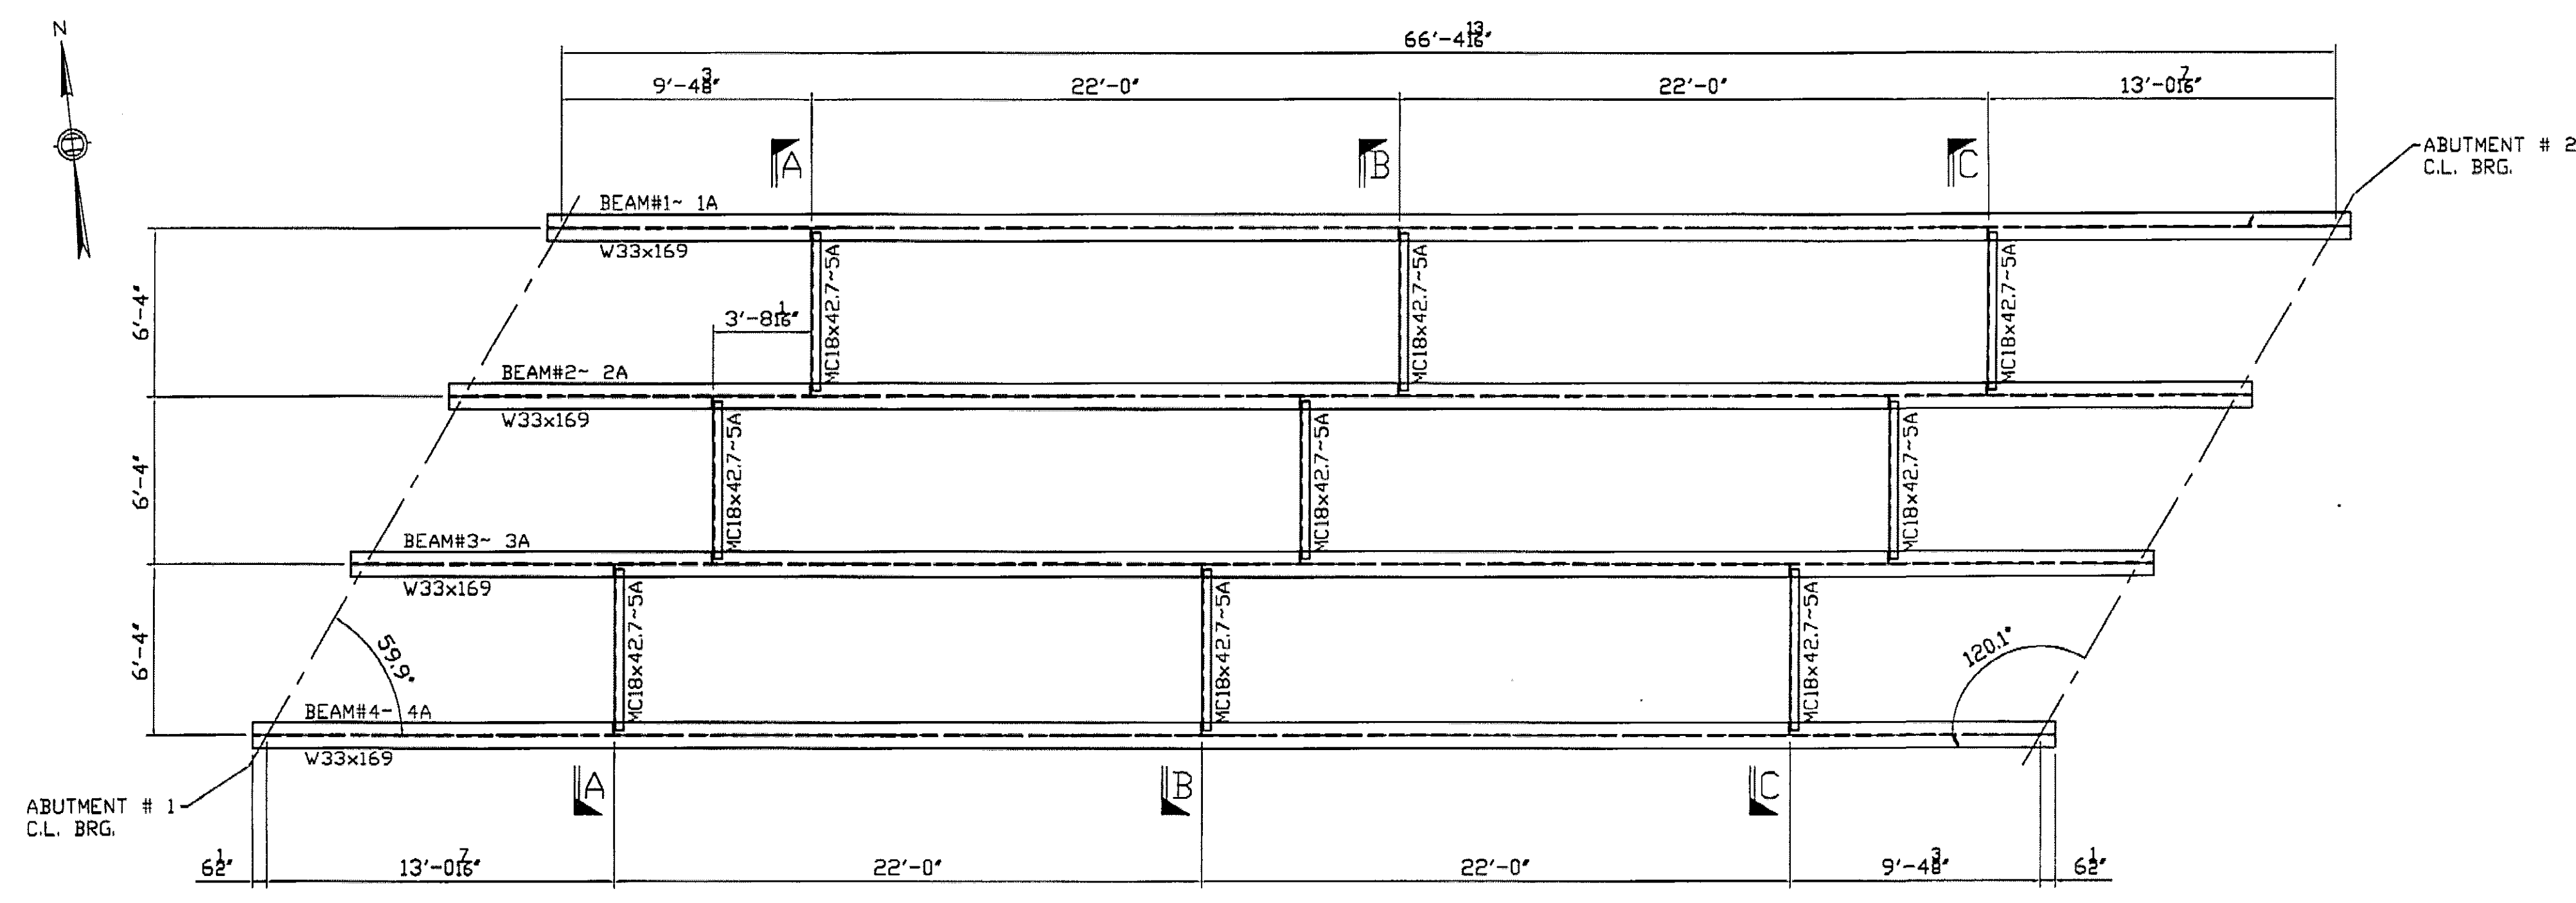


PLAN VIEW

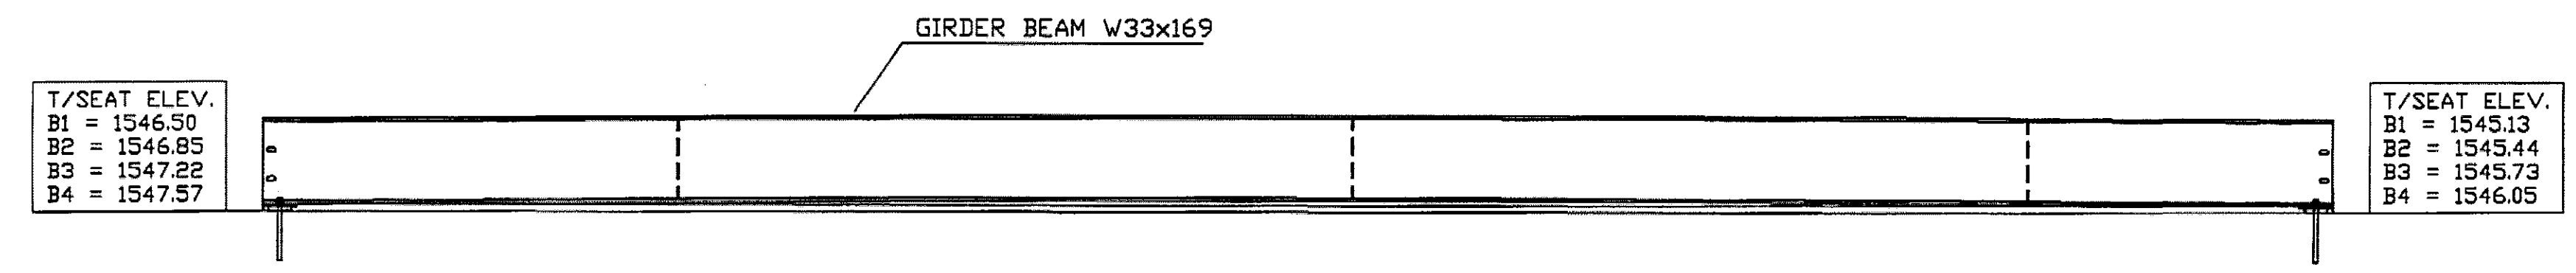


ELEVATION VIEW

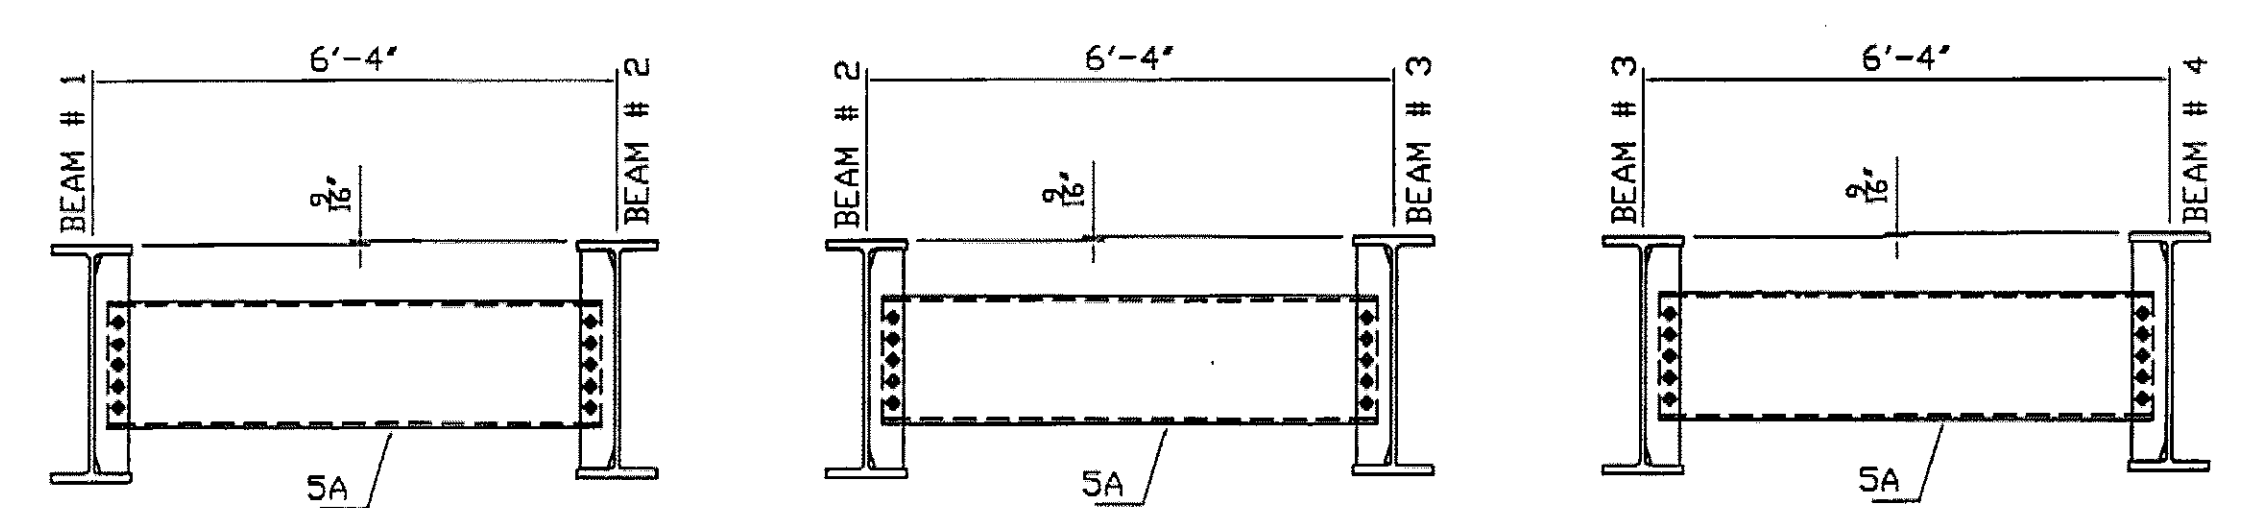

SECTION A-A

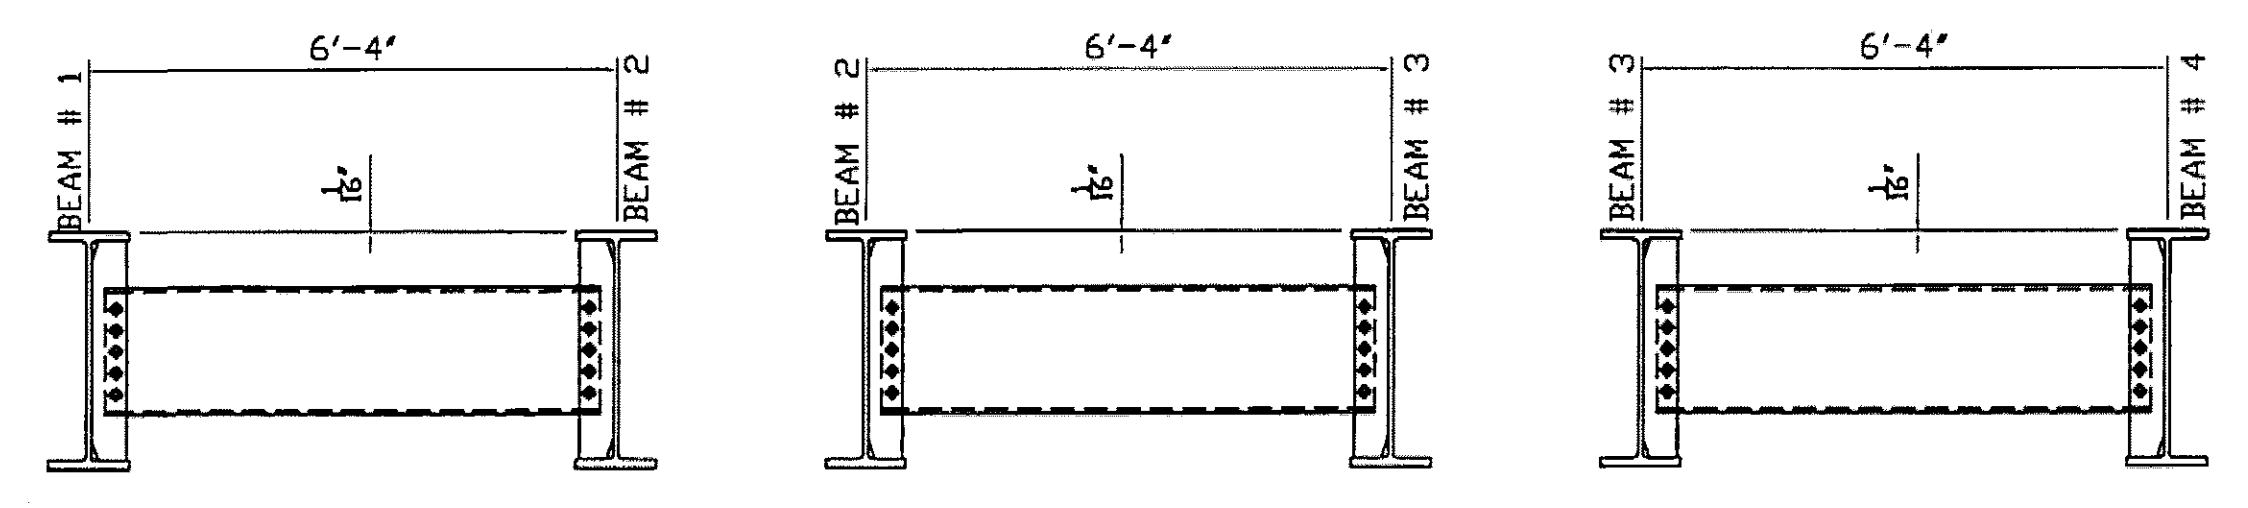

SECTION C-C

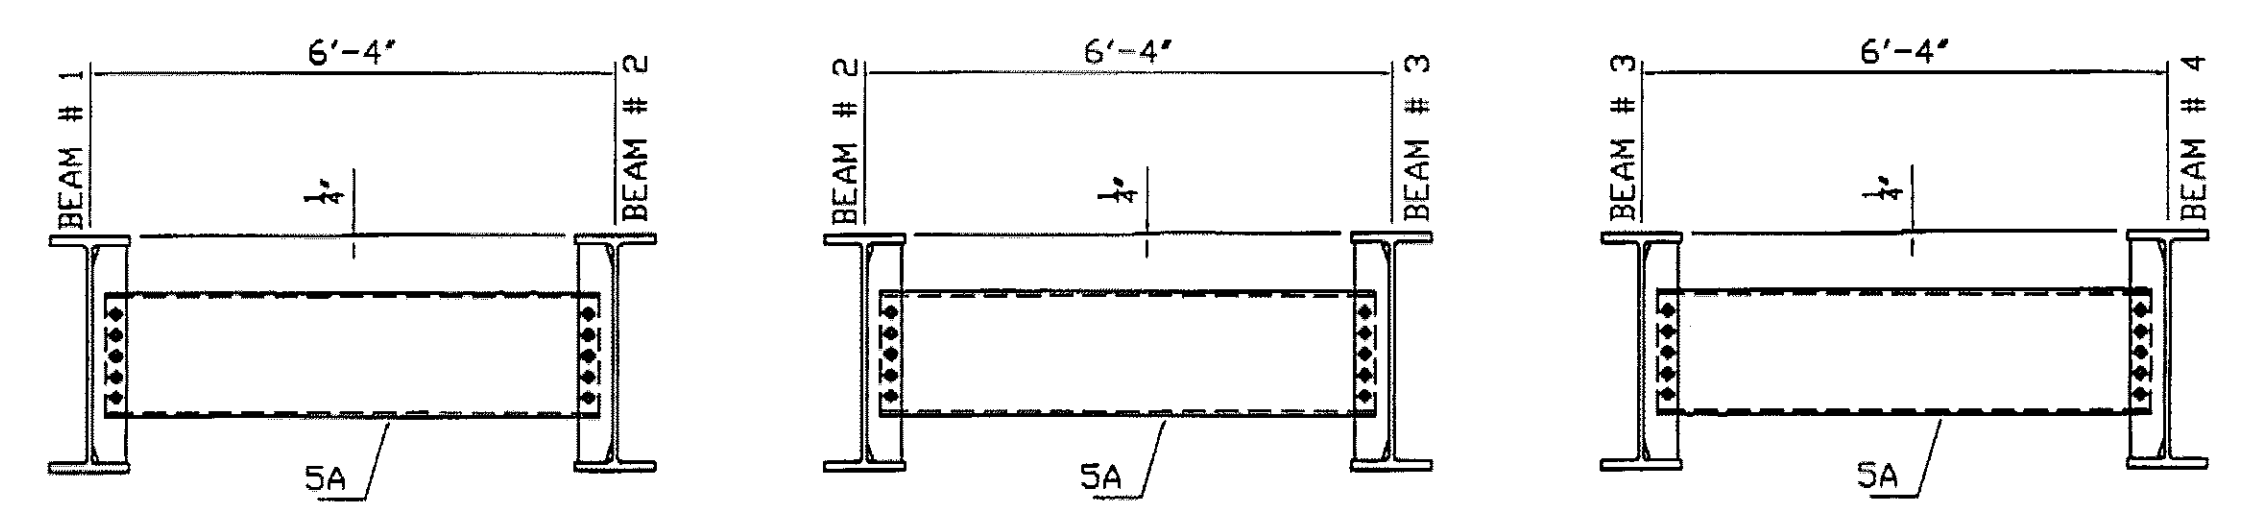

SECTION B-B

Handwritten notes:
 1/19/10
 CPW

SHOP NOTES
 HOLES 15/16" Ø (U.N.)
 BOLTS NONE
 PAINT NONE
 WELDS TO BE MADE USING ER80-NiL ELECTRODES
 MATERIAL M270 Gr-50W

REV. NO.	DATE	REVISION

ERECTOR DRAWING
 ROUTE TH 1 (FAS 0114) TOWN OF WARDBORO
 PROJECT NO.: BHF 0114(5) COUNTY OF WINDHAM

DRAWN BY		CHECKED BY		JDB NO.	SHEET NO.
KC	02/22/10	WL	02/25/10	3525	E1

FOSTER • PRECISE
 3 FARM LANE GEORGETOWN, MA 01833
 978-352-2591 FAX 978-352-2182

OWNER: VT AOT
 CONTRACTOR: B.U.R. CONSTRUCTION