




X1A ~ GUSSET ~ 9 REQ'D

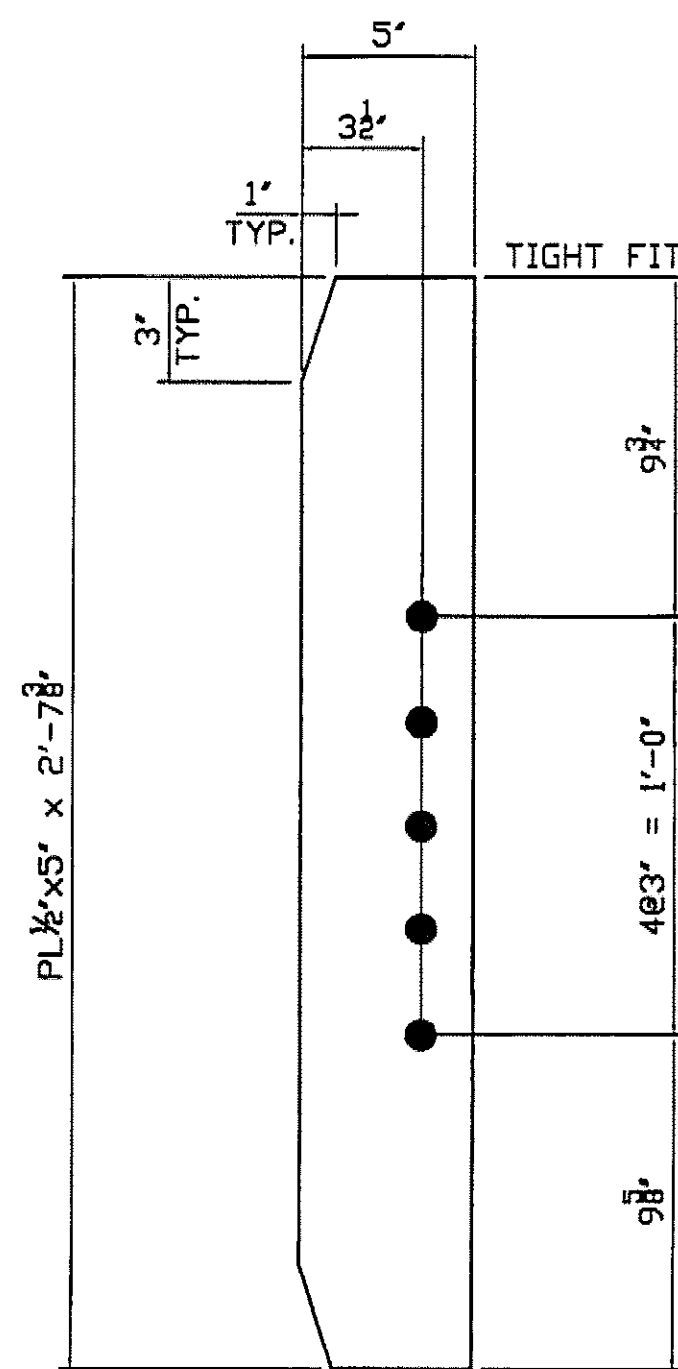


X1B ~ GUSSET ~ 3 REQ'D

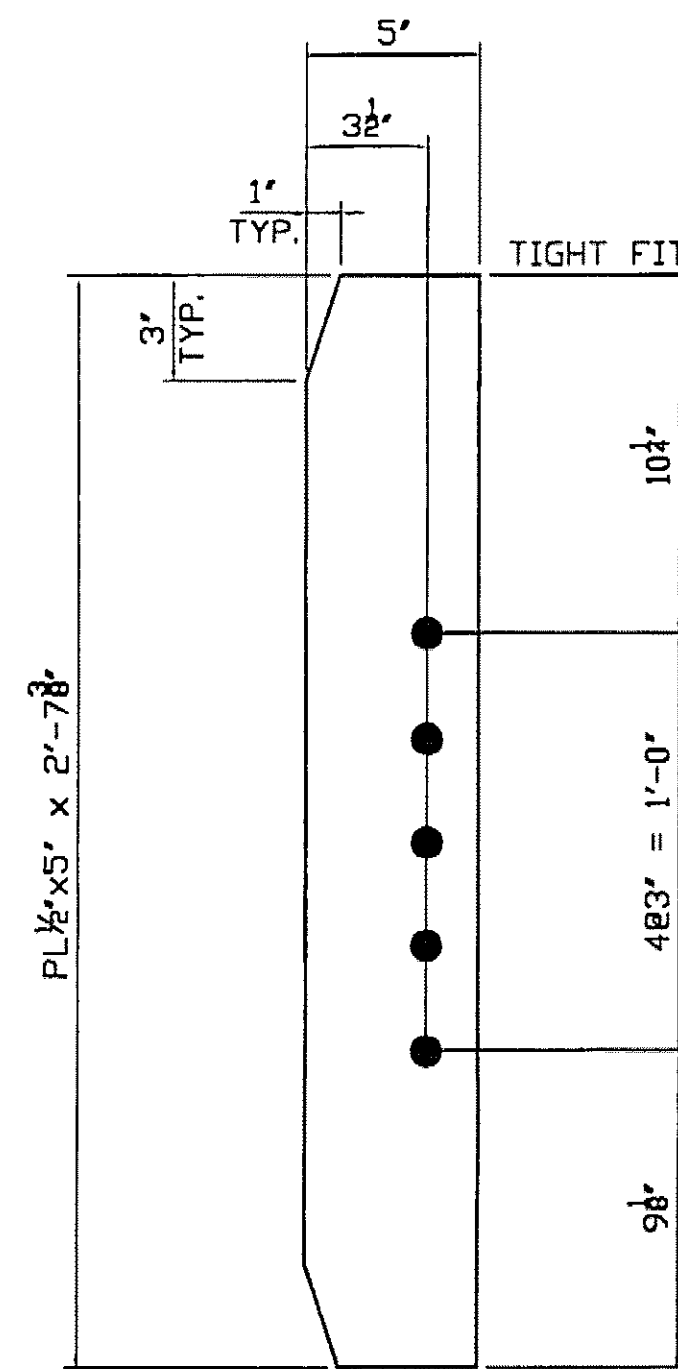

X1C ~ GUSSET ~ 3 REQ'D

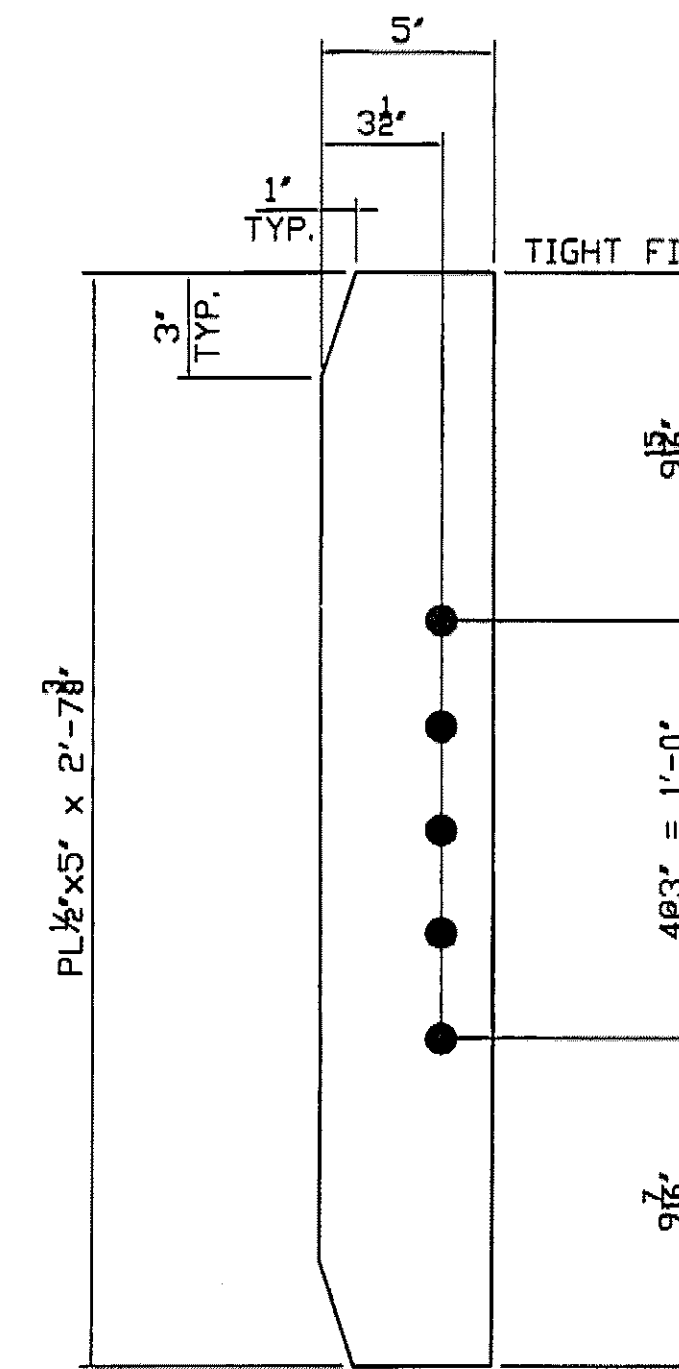


X1D ~ GUSSET ~ 3 REQ'D

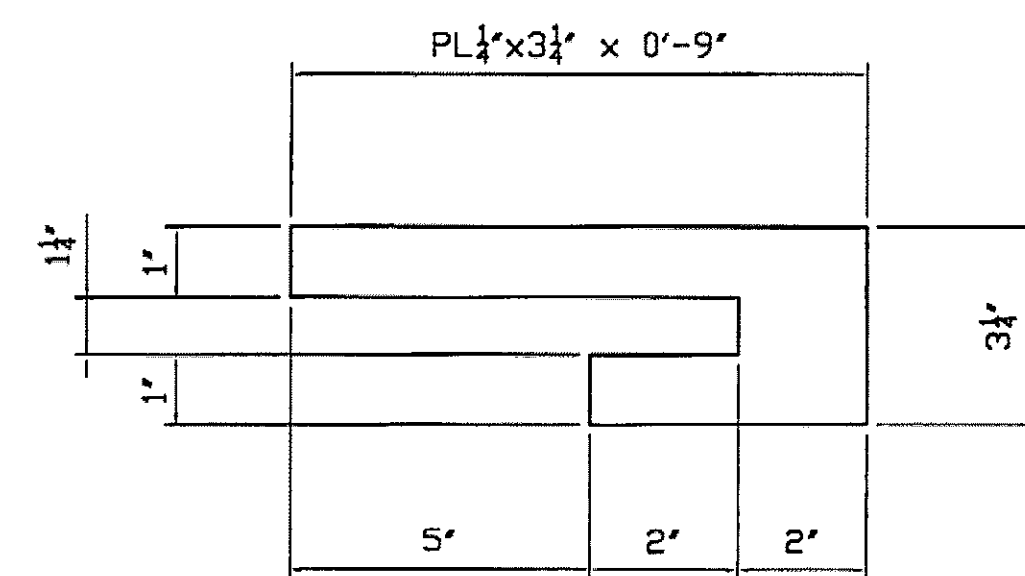

X1E ~ GUSSET ~ 2 REQ'D

FIT TO SEAL PER DRIP PL. DETAIL ON SHTS 1&4

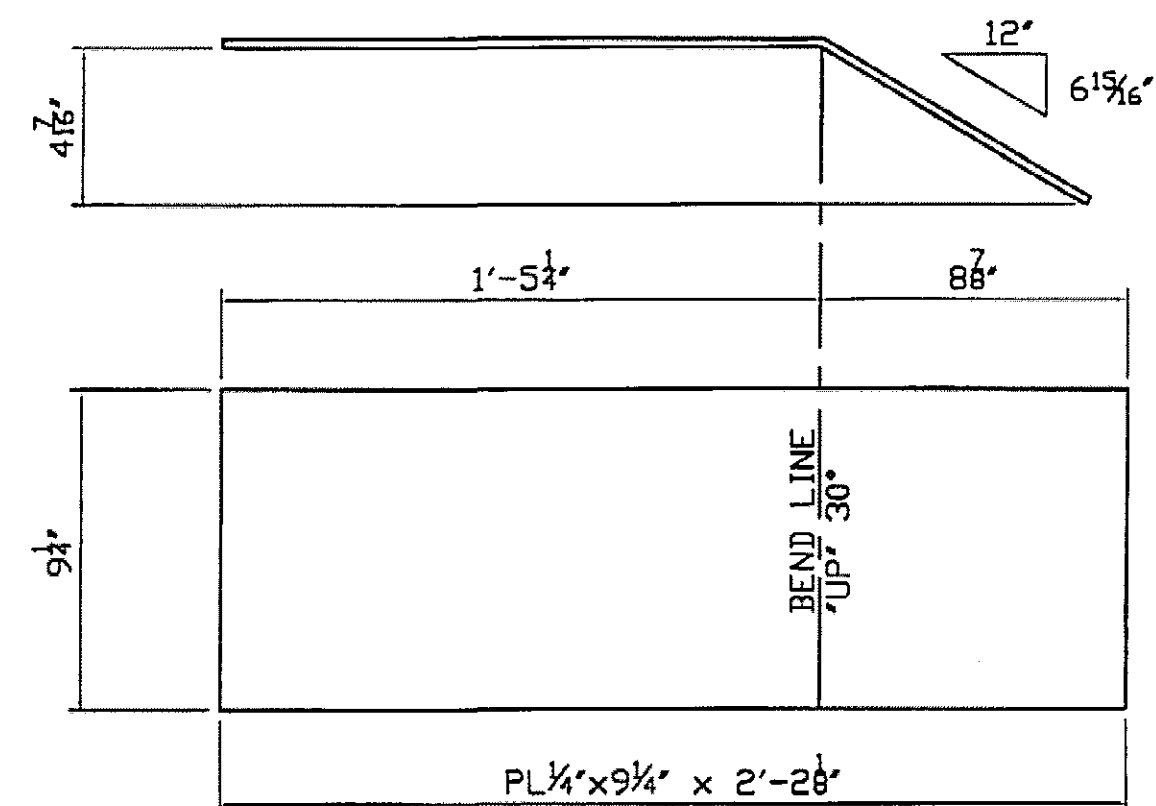

X1F ~ END PLATE ~ 8 REQ'D

REV. NO.	DATE	APPROVER COMMENTS	REVISION
3			
2			
1	4/9/10		

PART DETAILS
 ROUTE TH 1 (FAS 0114) TOWN OF WARDBORO
 PROJECT NO.: BHF 0114(5) COUNTY OF WINDHAM

SHOP NOTES
 HOLES 15/16" Ø (U.N.)
 BOLTS NONE
 PAINT NONE
 WELDS TO BE MADE USING ER80-NiL ELECTRODES
 MATERIAL M270 Gr.50W

FOSTER • PRECISE
 3 FARM LANE GEORGETOWN, MA 01833
 978-352-2591 FAX 978-352-2182

OWNER: VT AOT
 CONTRACTOR: B.U.R. CONSTRUCTION

DRAWN BY	CHECKED BY	JOB NO.	SHEET NO.
KC	WL	3525	X1
02/22/10	02/26/10		

Handwritten notes:
 BUC
 CRW 4/19/10