



STATE OF VERMONT AGENCY OF TRANSPORTATION

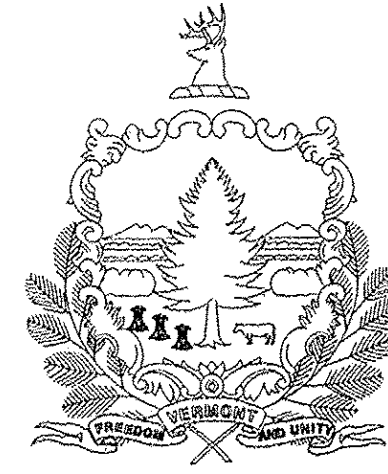

PROPOSED IMPROVEMENT BRIDGE PROJECT

TOWN OF BRISTOL, ADDISON COUNTY


ROUTE NO : TH 5 CLASS II, LOCAL ROAD (SOUTH STREET) BRIDGE NO : 31

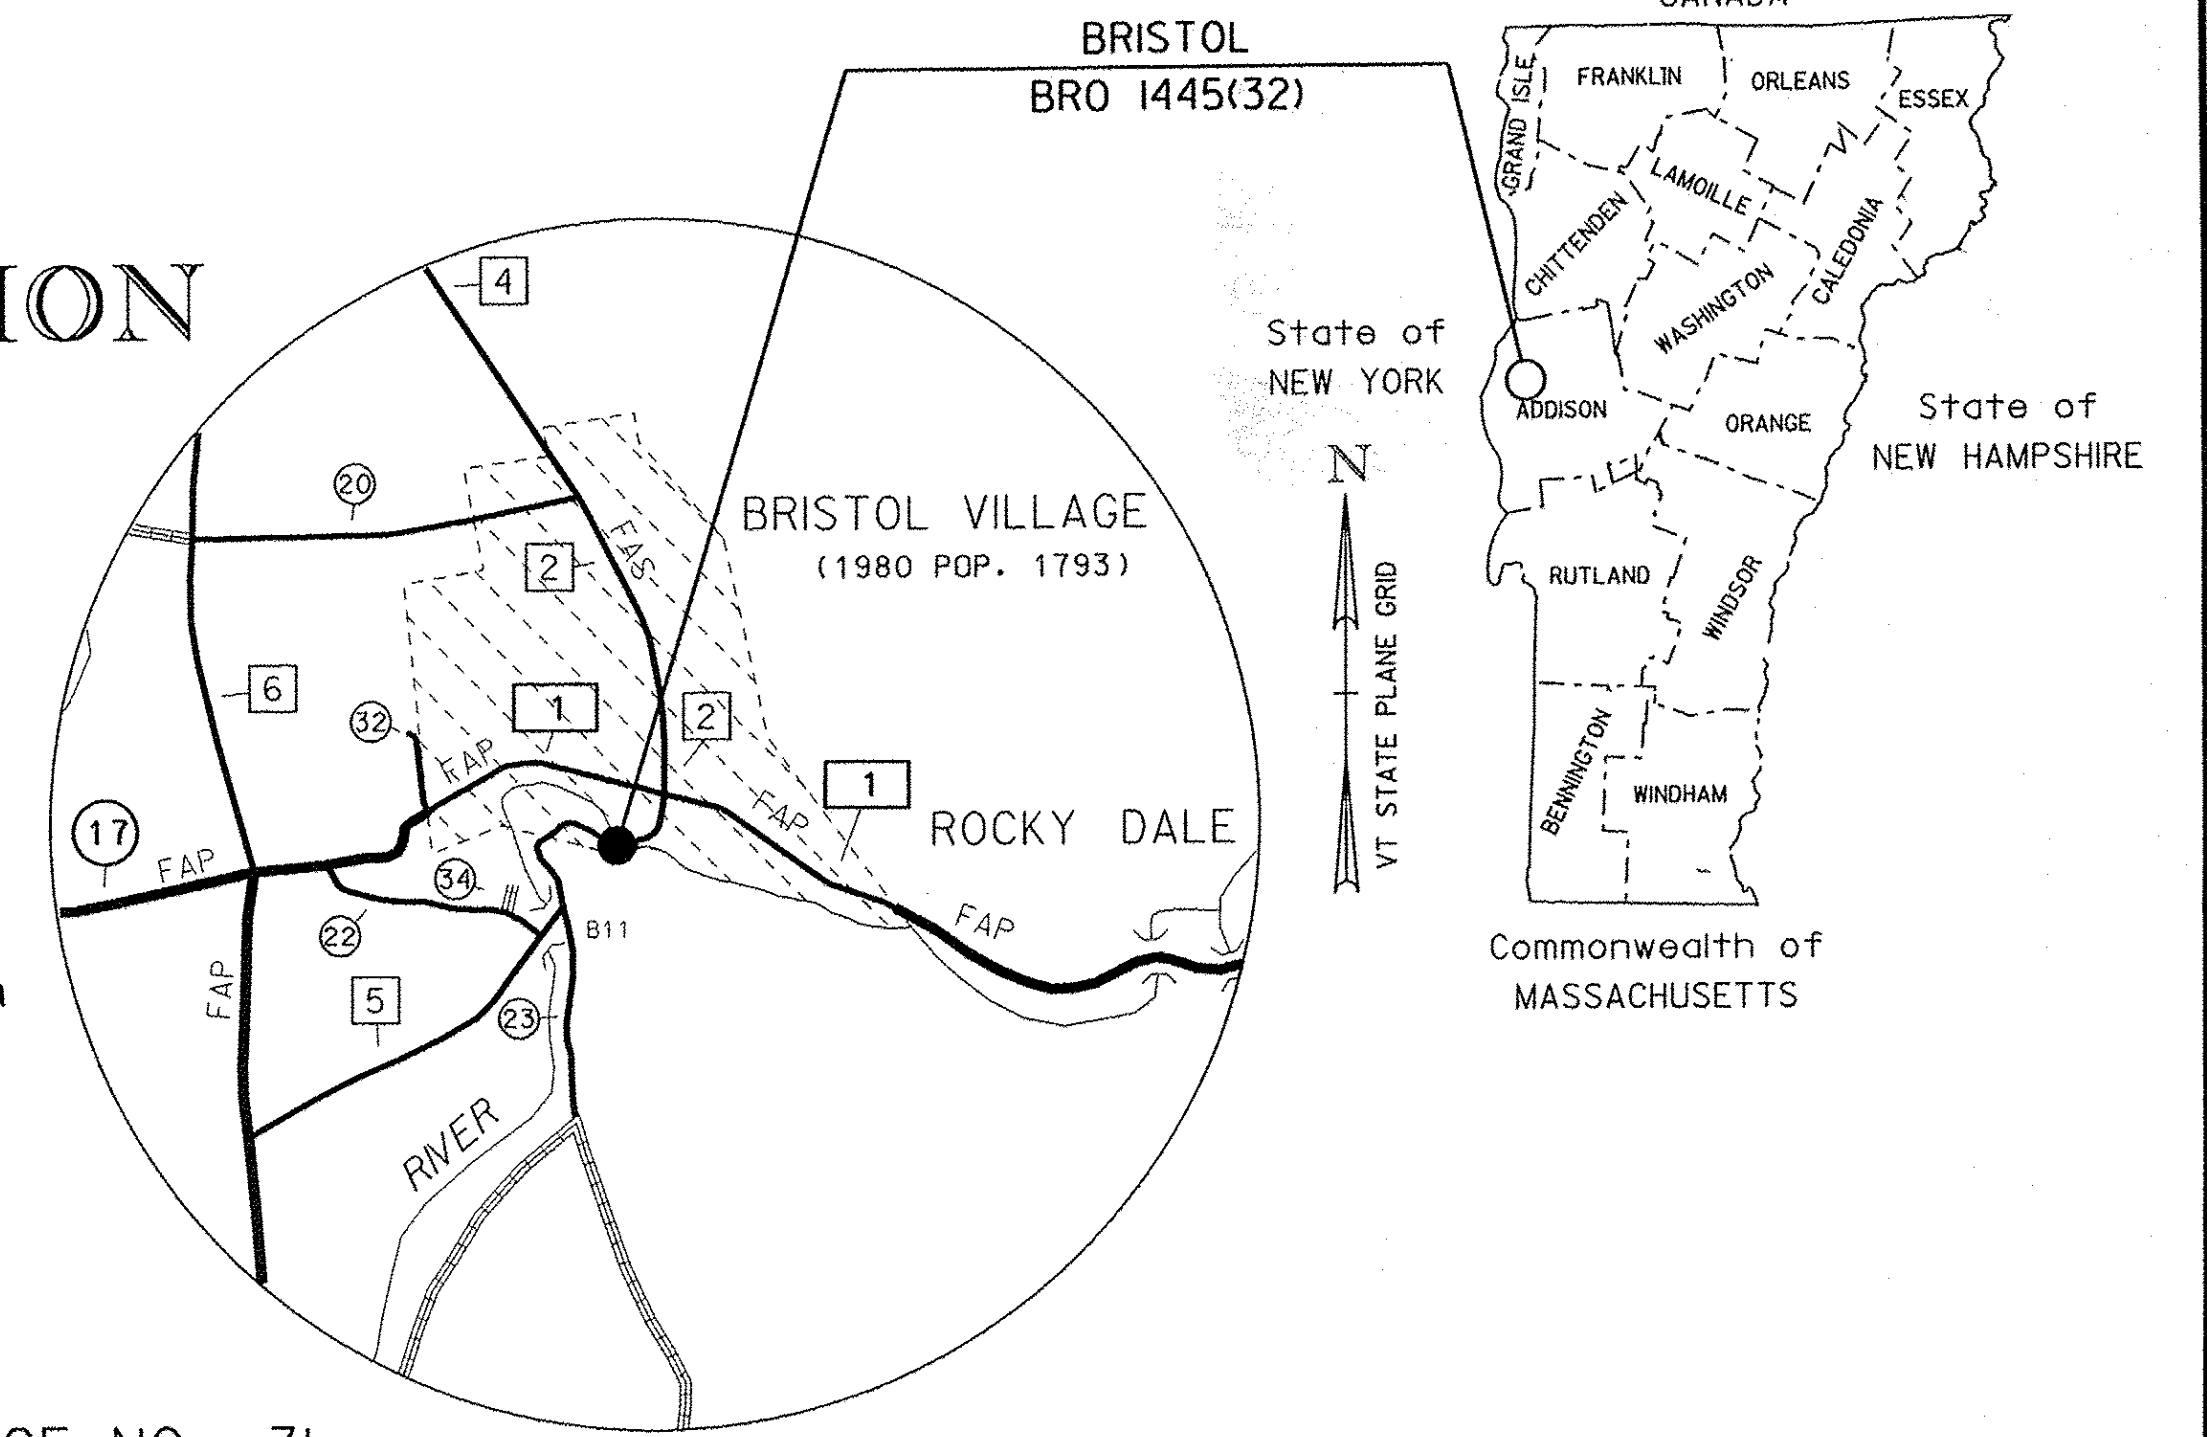

RECORD PLANS	
CONTRACTOR:	BLOW & COTE INC. - MORRISVILLE, VT
RESIDENT ENGINEER:	JOE KNIPES
CONSTRUCTION BEGAN:	SEPTEMBER 3, 2013
CONSTRUCTION COMPLETE:	AUGUST 22, 2014
RECORD PLANS BY:	JOE KNIPES & JESSE IVES
I HEREBY CERTIFY THAT ALL THE CONSTRUCTION REQUIRED BY THIS SET OF DRAWINGS HAS BEEN ACCOMPLISHED AS INDICATED HEREIN.	
BY:	<i>[Signature]</i> RESIDENT ENGINEER
DATE:	1-17-17
NOTE: Any further information concerning final quantities, amounts or other details relative to this project may be found at Central Files in the electronic archives.	

PROJECT LOCATION : THE BRIDGE IS LOCATED ON TOWN HIGHWAY 5 (SOUTH STREET) APPROXIMATELY 0.2 MILES SOUTHWEST OF THE INTERSECTION OF TOWN HIGHWAY 5 AND VT RTE 17.
 PROJECT DESCRIPTION : REPLACEMENT OF EXISTING TRUSS BRIDGE WITH A NEW SINGLE SPAN BRIDGE, NEW ABUTMENTS AND NECESSARY APPROACH WORK.

LENGTH OF STRUCTURE : 122.20 FEET
 LENGTH OF ROADWAY : 177.80 FEET
 LENGTH OF PROJECT : 300.00 FEET

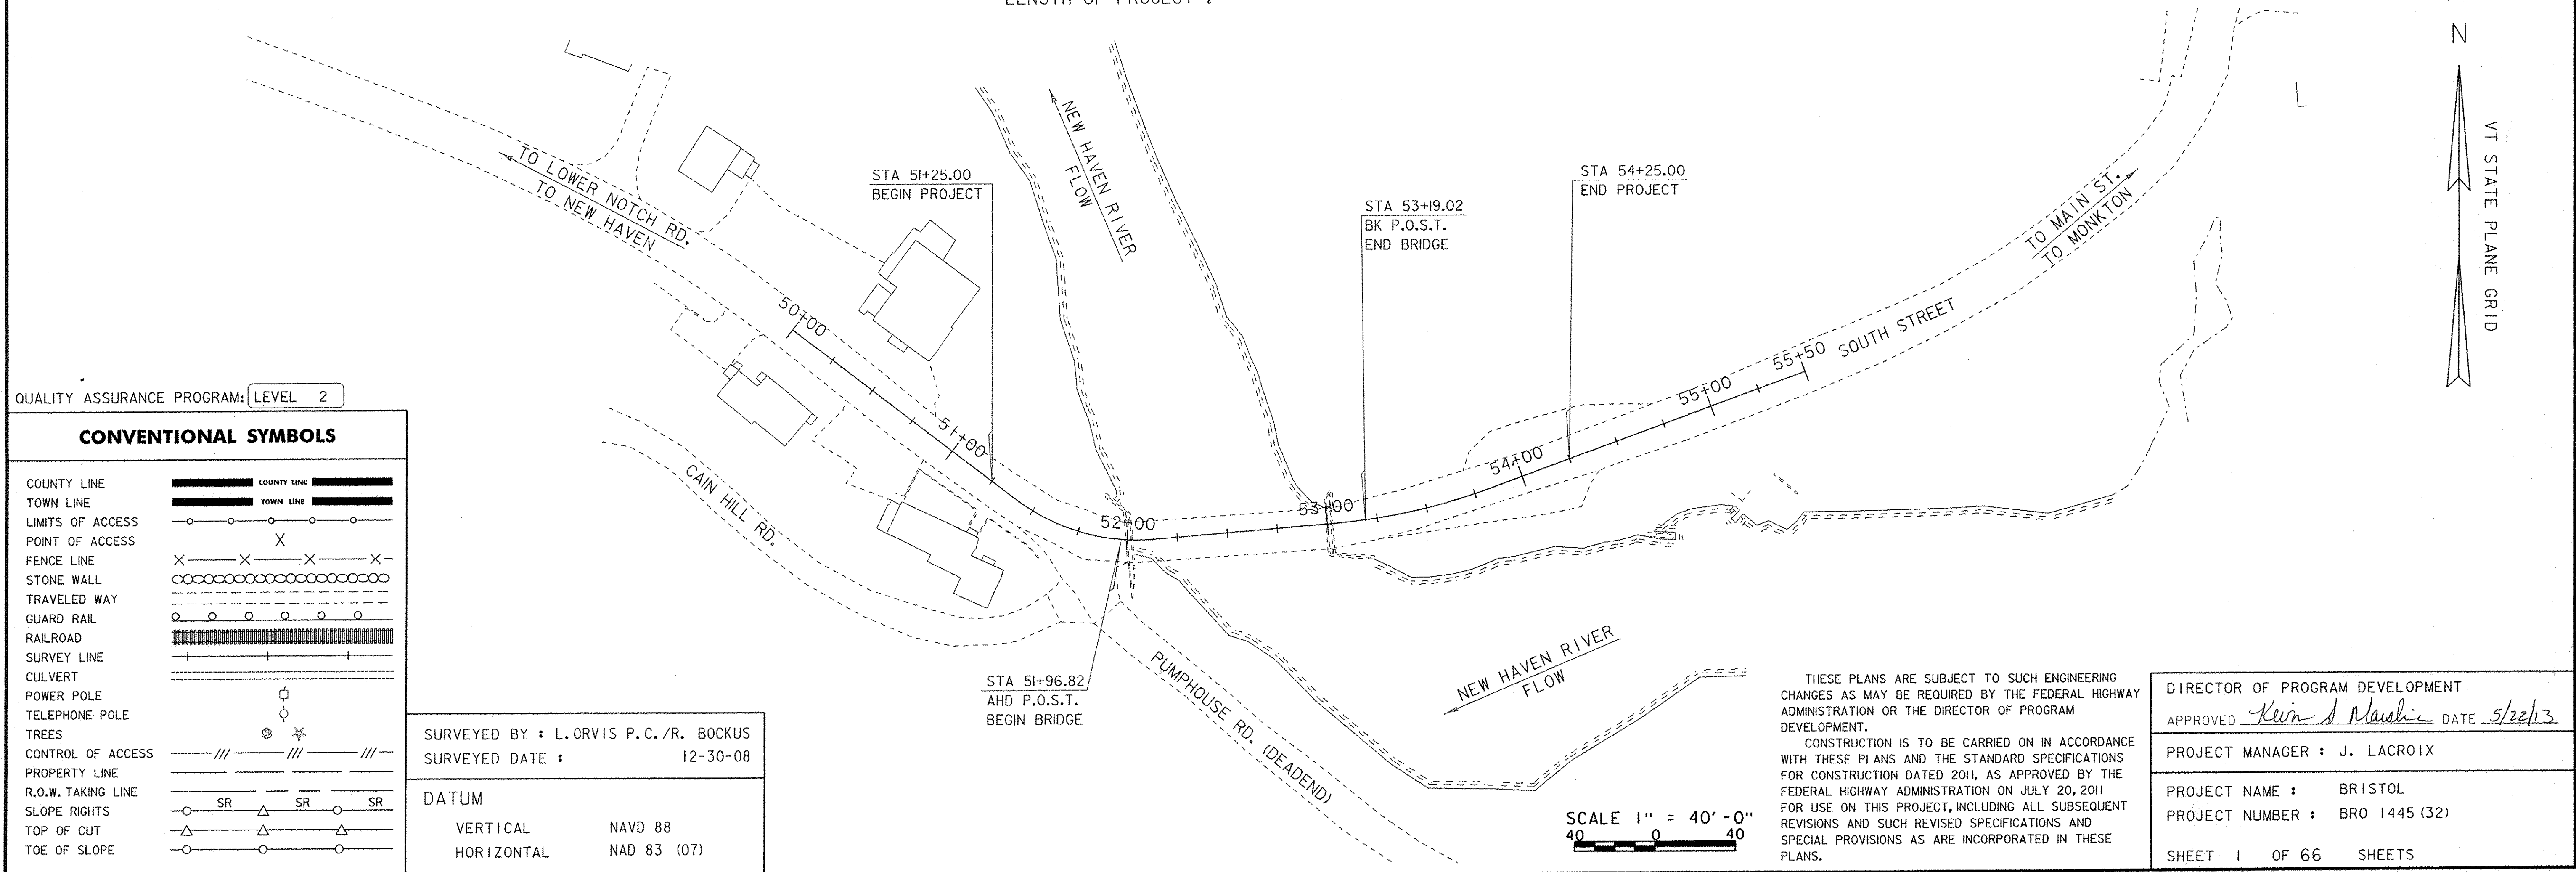

QUALITY ASSURANCE PROGRAM: LEVEL 2

CONVENTIONAL SYMBOLS	
COUNTY LINE	
TOWN LINE	
LIMITS OF ACCESS	
POINT OF ACCESS	
FENCE LINE	
STONE WALL	
TRAVELED WAY	
GUARD RAIL	
RAILROAD	
SURVEY LINE	
CULVERT	
POWER POLE	
TELEPHONE POLE	
TREES	
CONTROL OF ACCESS	
PROPERTY LINE	
R.O.W. TAKING LINE	
SLOPE RIGHTS	
TOP OF CUT	
TOE OF SLOPE	

SURVEYED BY : L. ORVIS P.C./R. BOCKUS
 SURVEYED DATE : 12-30-08

DATUM
 VERTICAL NAVD 88
 HORIZONTAL NAD 83 (07)

THESE PLANS ARE SUBJECT TO SUCH ENGINEERING CHANGES AS MAY BE REQUIRED BY THE FEDERAL HIGHWAY ADMINISTRATION OR THE DIRECTOR OF PROGRAM DEVELOPMENT.

CONSTRUCTION IS TO BE CARRIED ON IN ACCORDANCE WITH THESE PLANS AND THE STANDARD SPECIFICATIONS FOR CONSTRUCTION DATED 2011, AS APPROVED BY THE FEDERAL HIGHWAY ADMINISTRATION ON JULY 20, 2011 FOR USE ON THIS PROJECT, INCLUDING ALL SUBSEQUENT REVISIONS AND SUCH REVISED SPECIFICATIONS AND SPECIAL PROVISIONS AS ARE INCORPORATED IN THESE PLANS.

DIRECTOR OF PROGRAM DEVELOPMENT
 APPROVED *Kevin J. Nash* DATE 5/22/13

PROJECT MANAGER : J. LACROIX

PROJECT NAME : BRISTOL
 PROJECT NUMBER : BRO 1445 (32)

SHEET 1 OF 66 SHEETS

