

SPECIAL PROVISION (RETAINING WALL)
 STA 53+32.47 - STA 53+42.89 RT
 SEE DETAIL "SPECIAL PROVISION (RETAINING WALL)" ON SHEET 56

BOX BEAM GUARDRAIL (PAINTED BLACK)
 STA 51+46.38 - STA 51+53.48 LT
 STA 53+50.03 - STA 53+59.39 LT
 PUMPHOUSE RD STA 4+84.56 - STA 5+23.55 RT
 STA 53+55.06 - STA 53+98.89 RT

STONE FILL, TYPE II
 STA 53+32.40 - STA 53+61.60 RT
 PUMPHOUSE STA 4+62.22 - STA 4+82.85 RT

REMOVAL OF EXISTING FENCE
 STA 51+04.77 - STA 51+56.12 LT

CHAIN LINK FENCE, 6 FEET
 STA 11+51.00 - STA 12+25.00 LT

BRIDGE RAILING, GALVANIZED 3 RAIL BOX BEAM (PAINTED BLACK)
 STA 51+85.46 - STA 53+16.65 LT
 STA 52+01.37 - STA 53+24.29 RT


CONSTRUCT PAVED APRON
 CAIN HILL ROAD STA 1+25.00 (STA 1+81.00 ML) - STA 1+86.00
 PUMPHOUSE ROAD STA 4+55.00 - STA 4+70.00 LT

GUARDRAIL APPROACH SECTION, GALVANIZED 3 RAIL BOX BEAM (PAINTED BLACK)
 STA 51+53.48 - STA 51+85.46 LT
 PUMPHOUSE RD STA 4+84.56 - (ML STA 52+01.37 RT)
 STA 53+16.65 - STA 53+50.03 LT
 STA 53+24.29 - STA 53+55.06 RT

RELOCATE MAILBOX, SINGLE SUPPORT
 PUMPHOUSE STA 4+75.00 RT

REMOVE HYDRANT
 STA 54+18.02 - OFFSET 28.03 RT

MANUFACTURED TERMINAL SECTION, TANGENT
 STA 53+59.39 - STA 53+74.02 LT
 STA 5+23.55 - STA 5+37.55 RT
 STA 53+98.89 - STA 54+12.90 RT

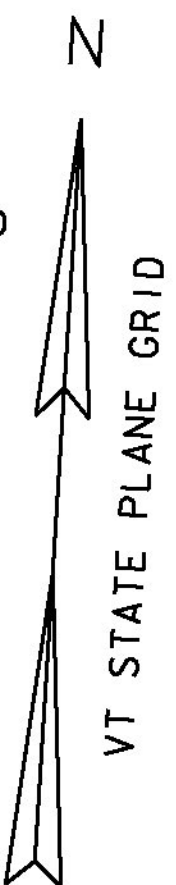

LAYOUT SHEET

SCALE 1" = 20' - 0"
 20 0 20

EXISTING BRIDGE DATA
 STEEL PONY TRUSS
 LENGTH = 105 FT
 WIDTH = 19.9 FT CURB TO CURB
 BUILT IN 1928

PROJECT NAME: BRISTOL
 PROJECT NUMBER: BRO 1445(32)

FILE NAME: s05j352bdr.dgn
 PROJECT LEADER: J. LACROIX
 DESIGNED BY: G. LAROCHE
 LAYOUT SHEET

PLOT DATE: 04-JUN-2013
 DRAWN BY: J. SALVATORI
 CHECKED BY: T. FILLBACH
 SHEET 10 OF 66