




50+25
BEGIN APPROACH

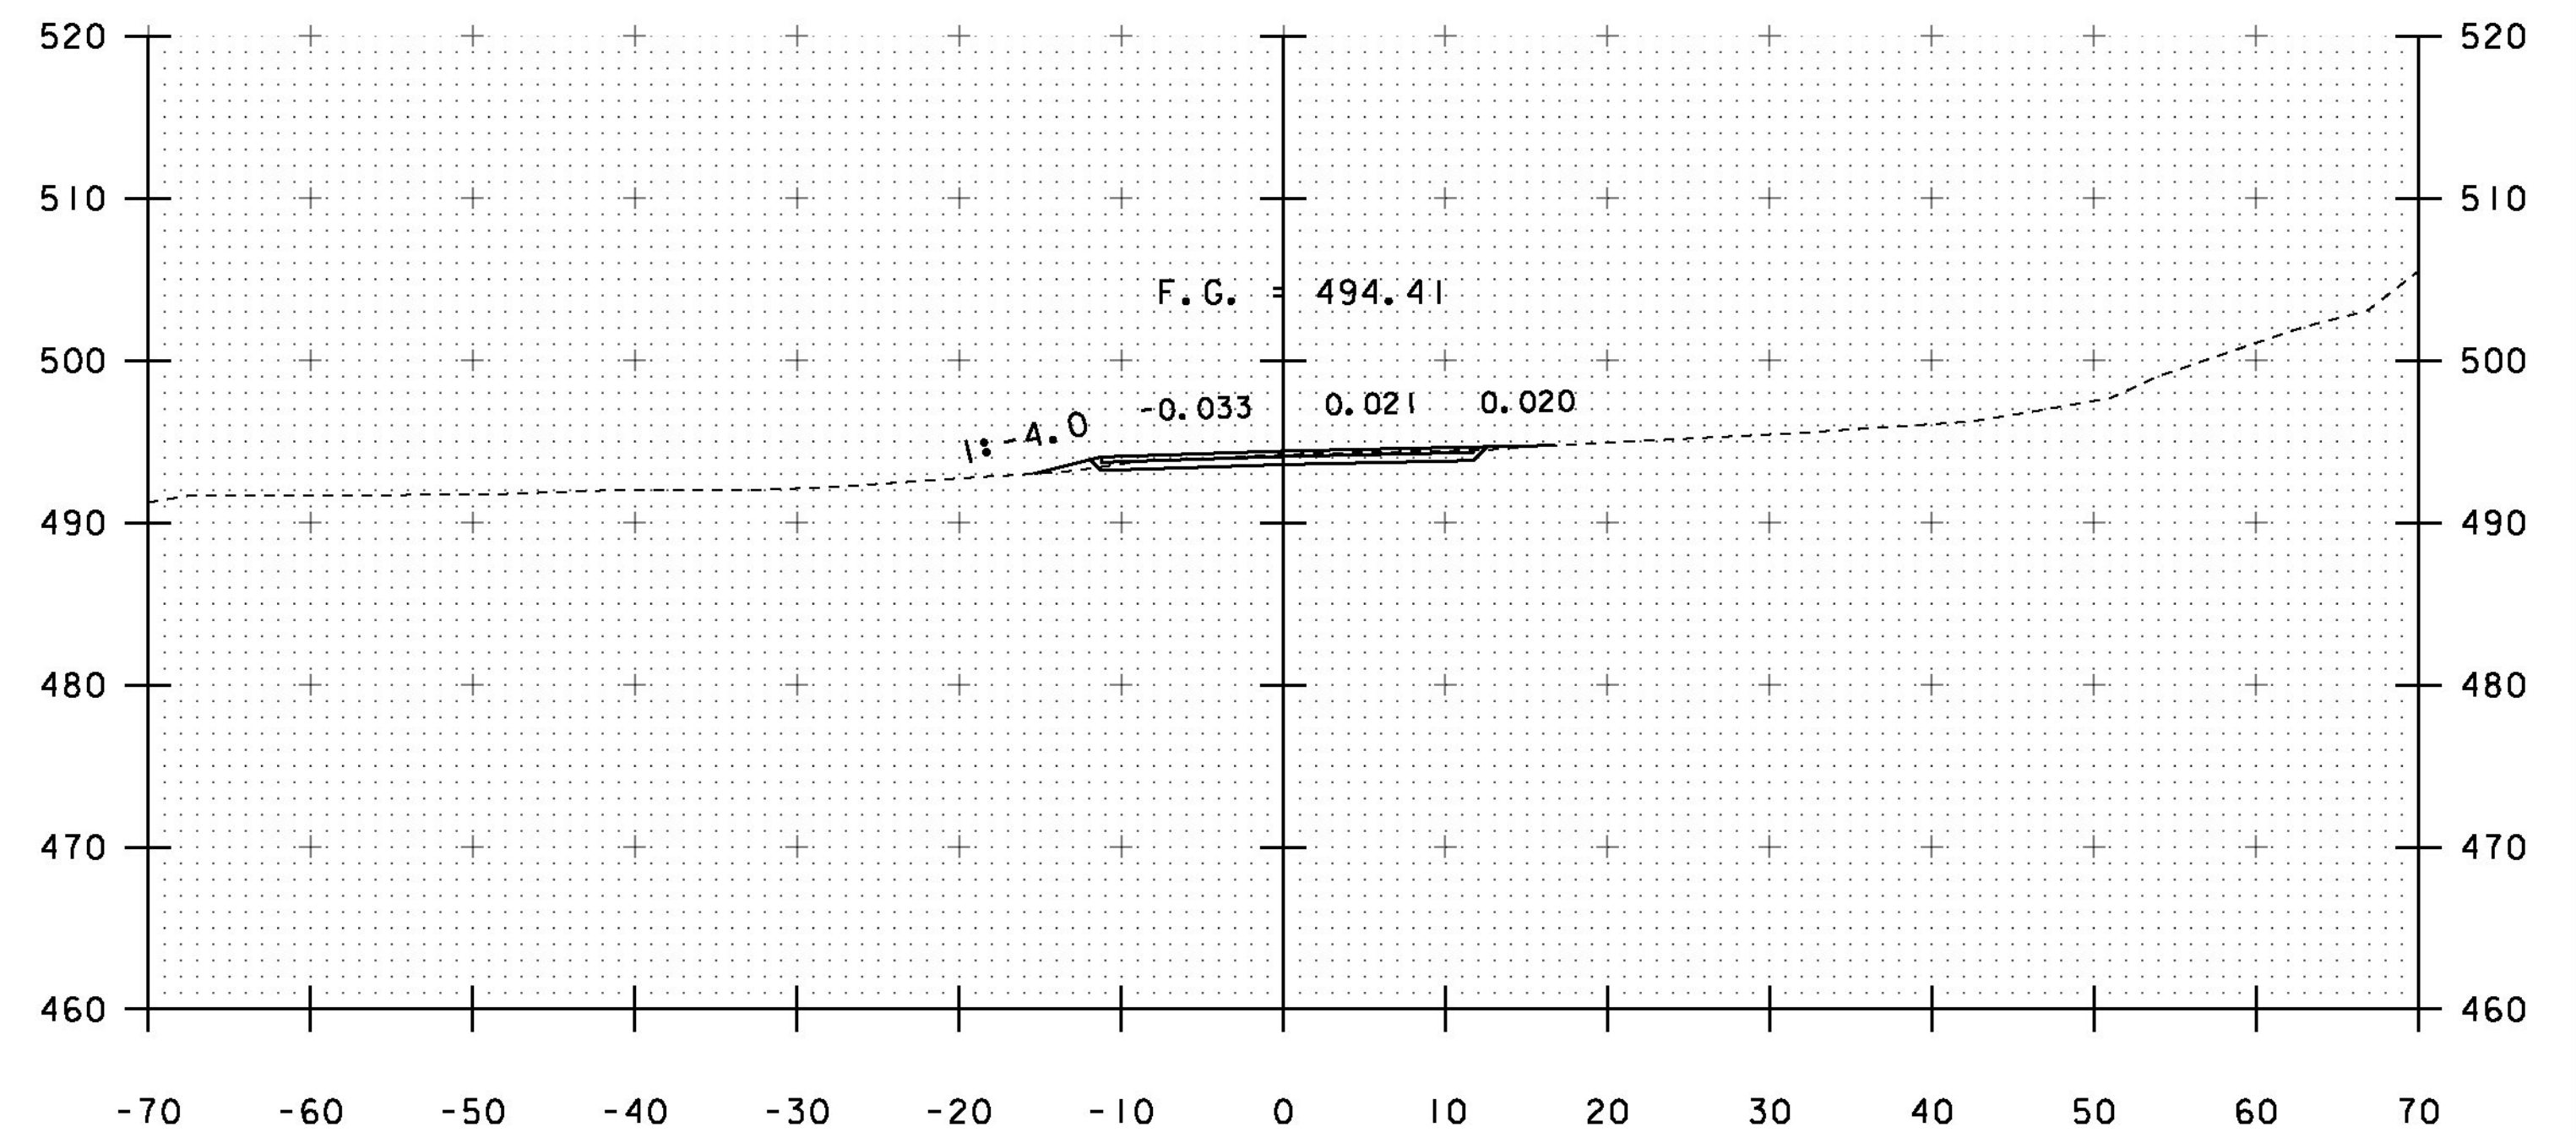

50+75

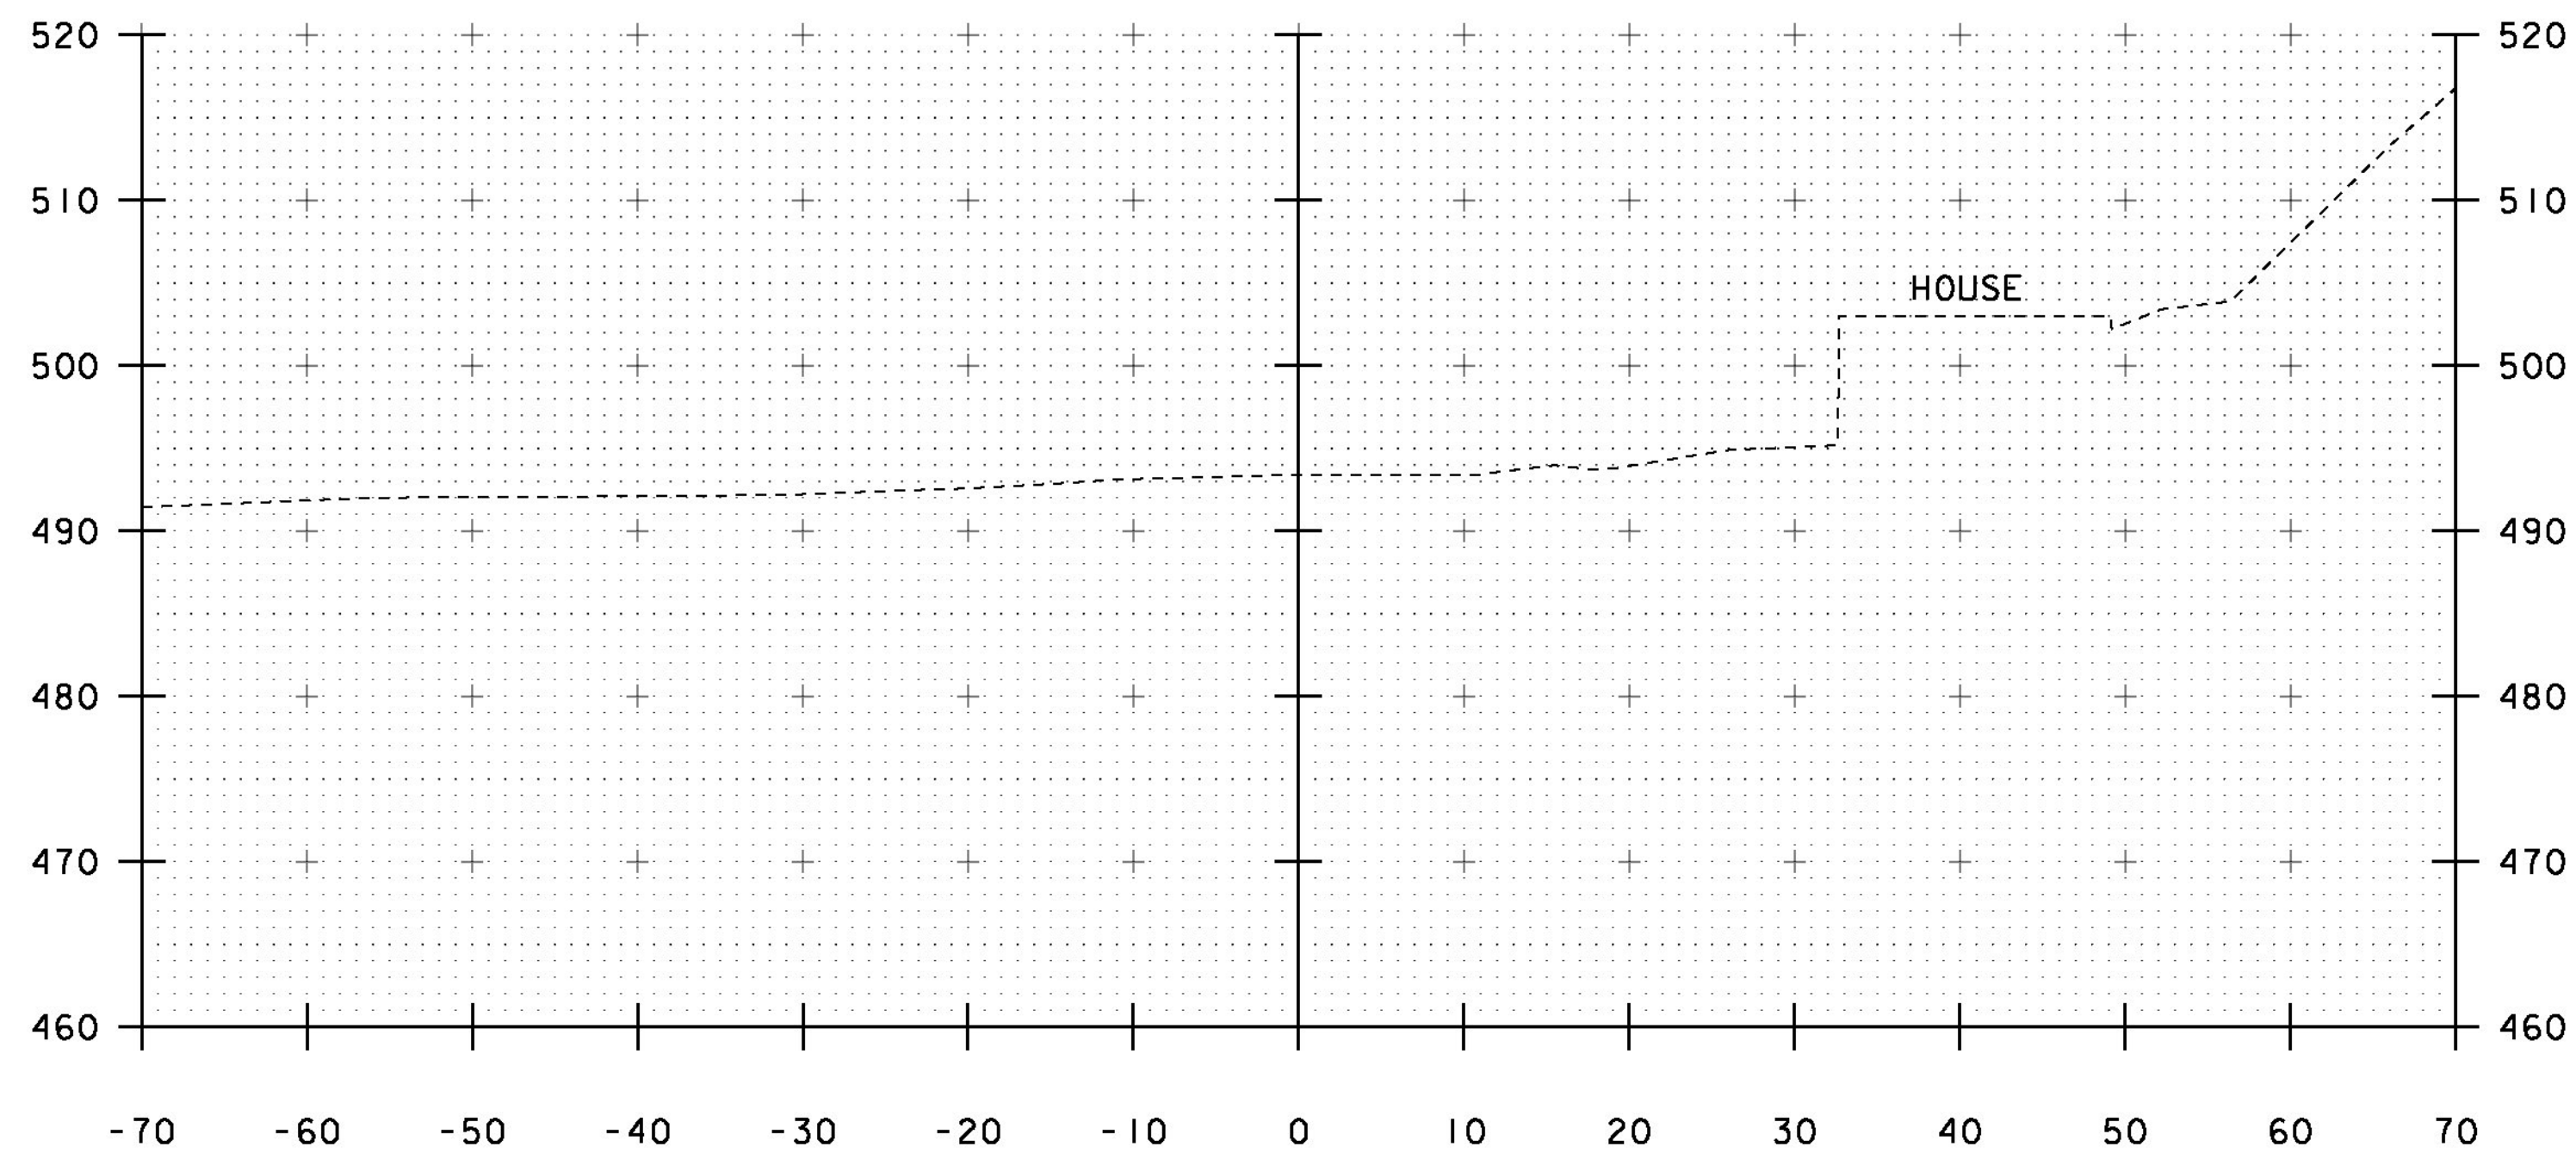

50+00

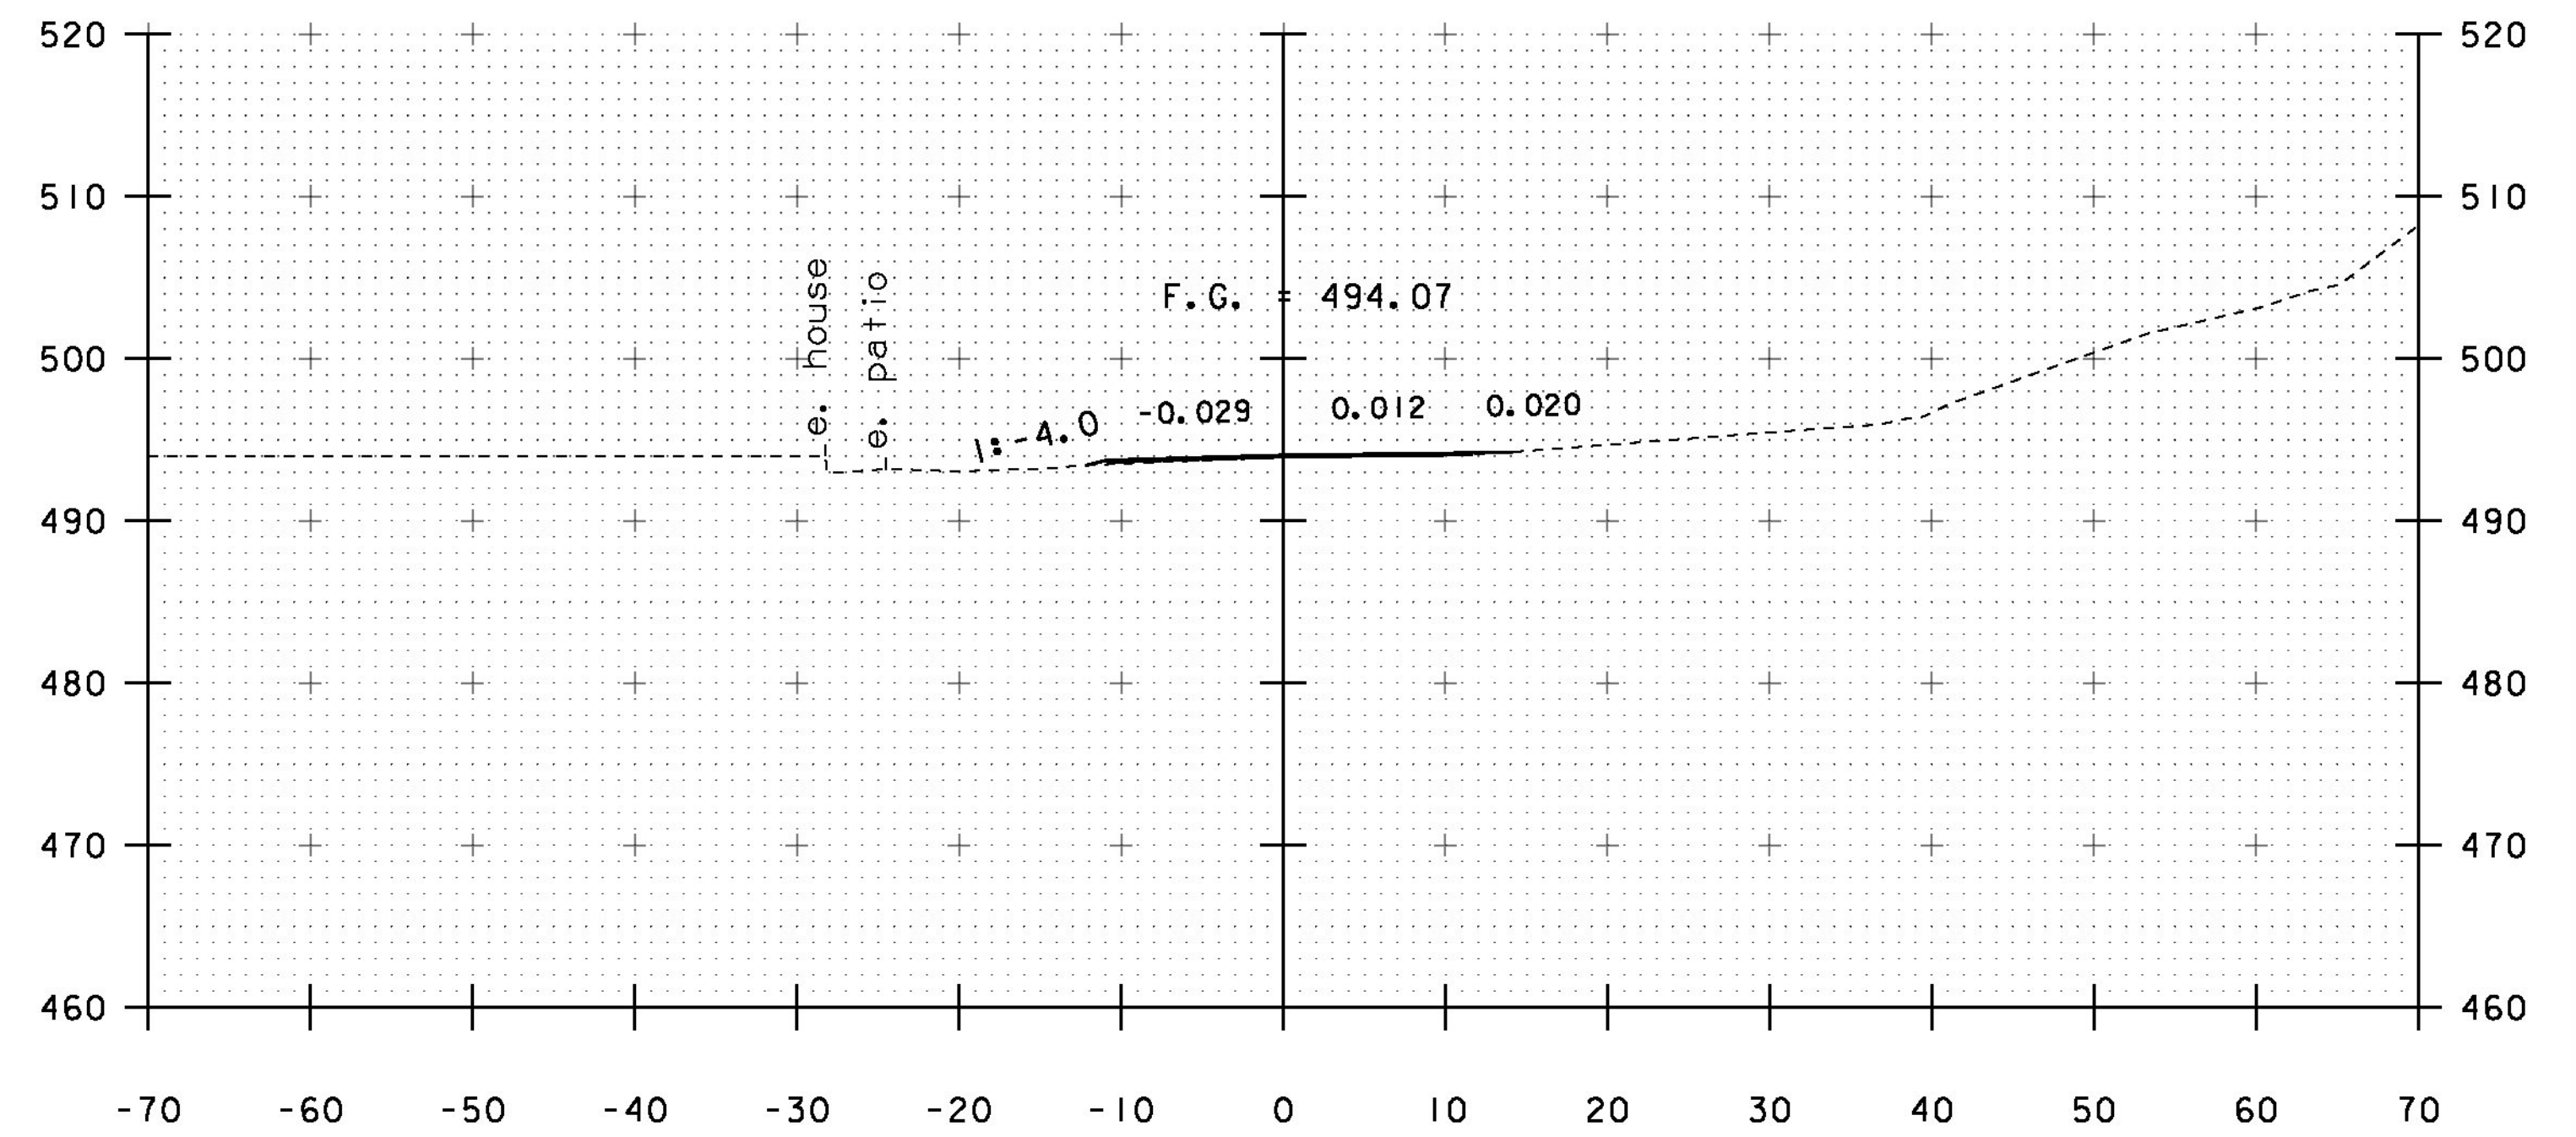

50+50

PROJECT NAME:	BRISTOL
PROJECT NUMBER:	BRO 1445(32)
FILE NAME: s05j352xs2.dgn	PLOT DATE: 04-JUN-2013
PROJECT LEADER: J. LACROIX	DRAWN BY: R. PELLET
DESIGNED BY: G. LAROCHE	CHECKED BY: T. FILLBACH
MAINLINE SECTIONS *1	SHEET 45 OF 66

STA. 50+00 TO STA. 50+75