




52+00
BEGIN BRIDGE
STA - 51+96.67

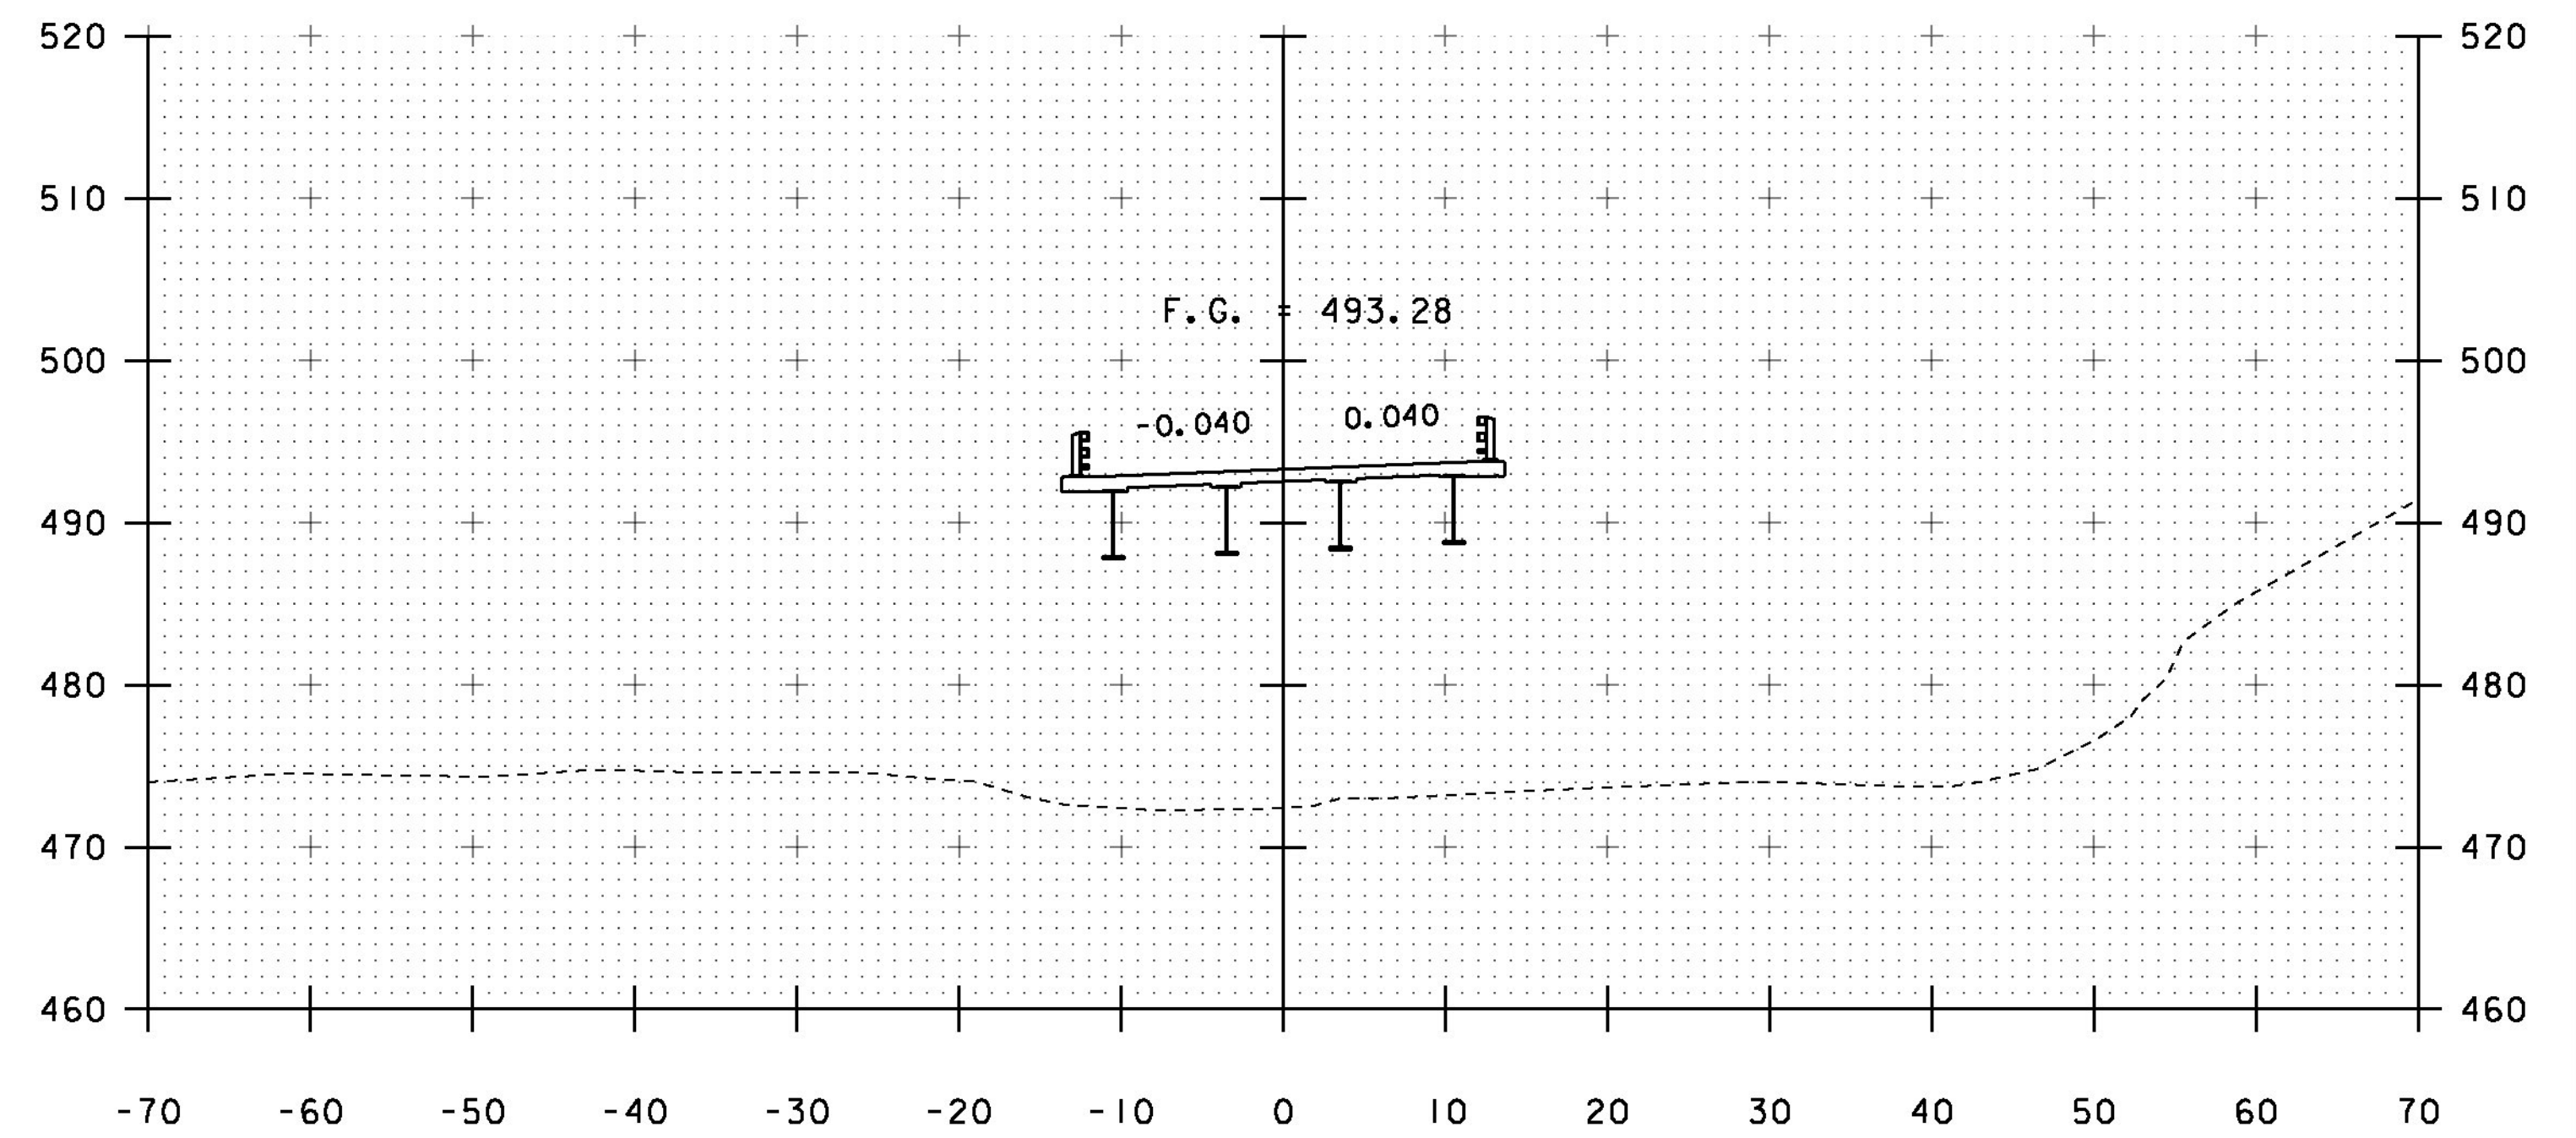

52+50

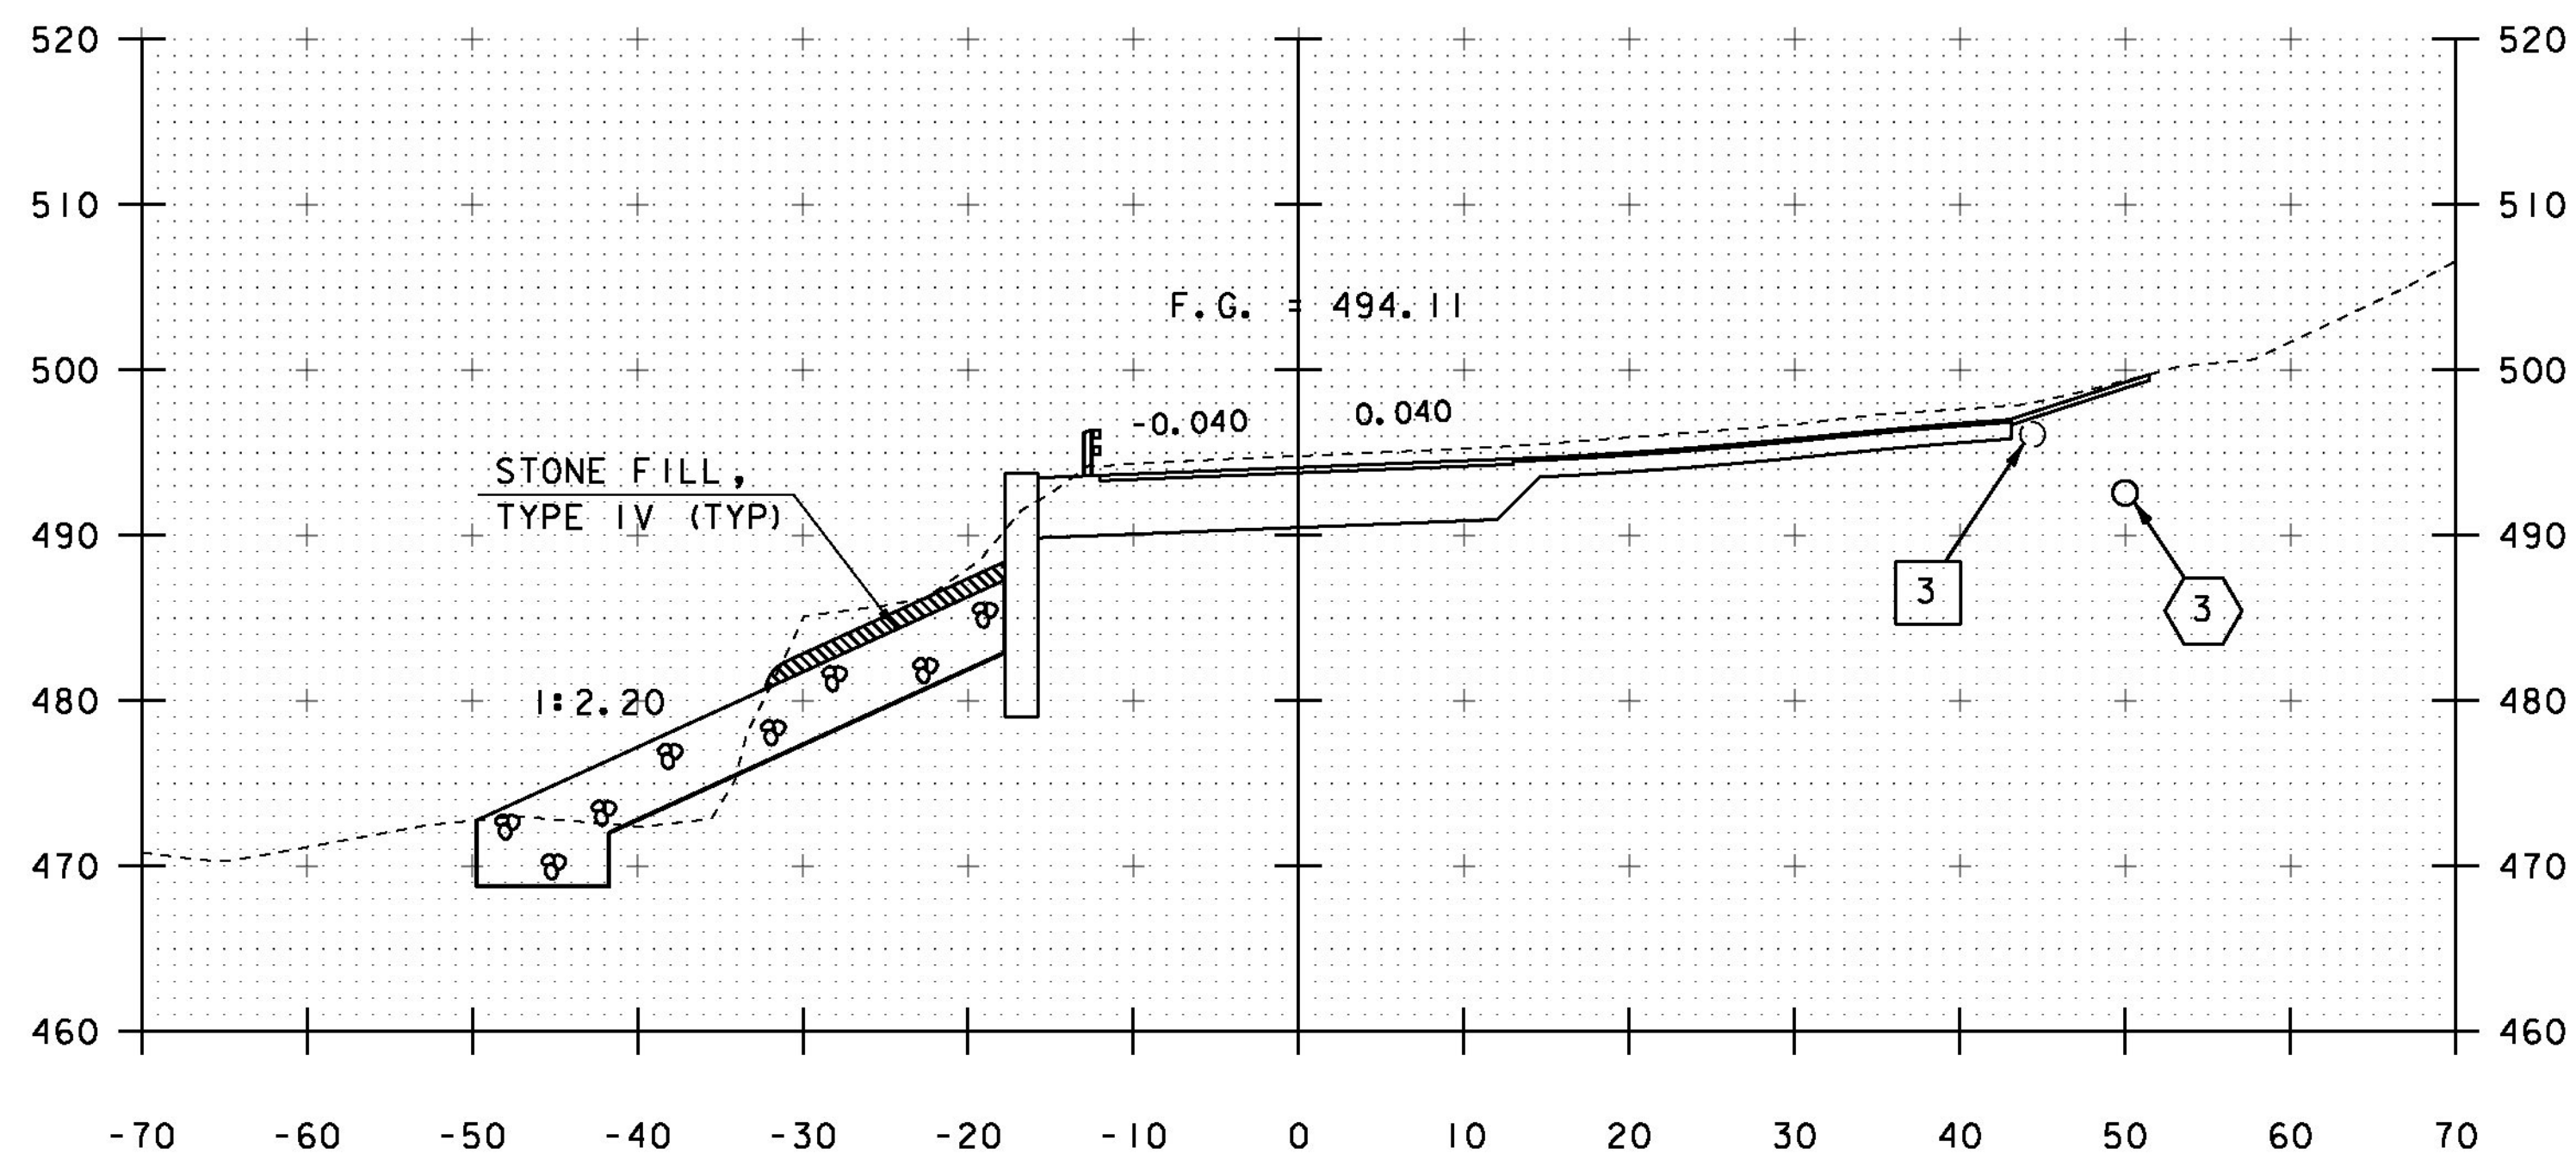

51+81
INTERSECTION
SOUTH STREET / CAIN HILL

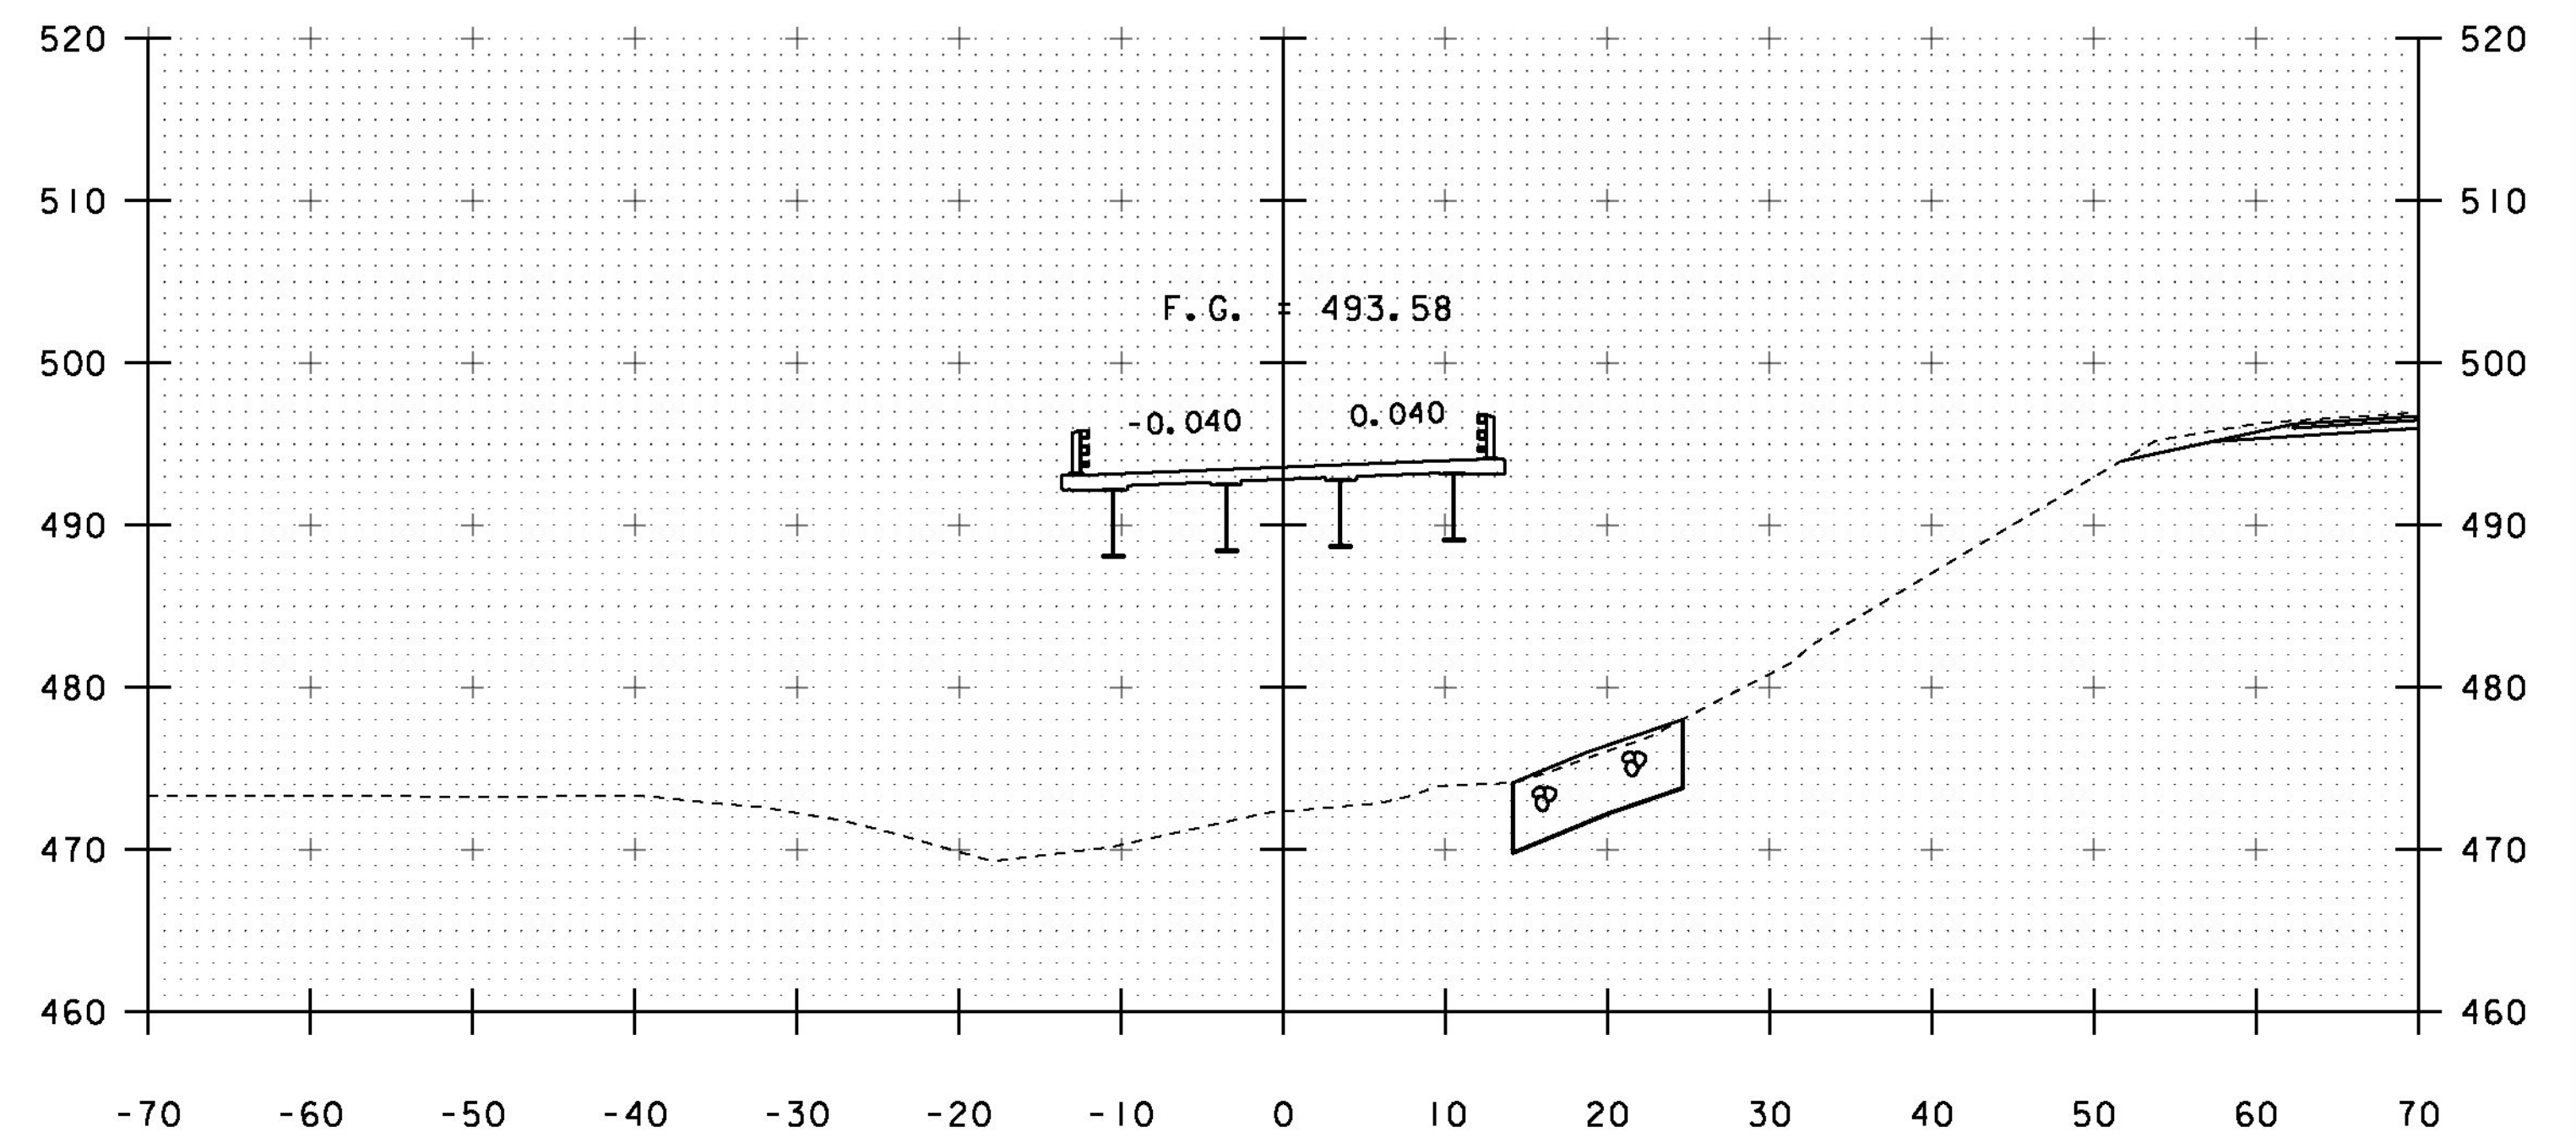

52+25

- 3 EXISTING 18" ACCGMP CULVERT
- 3 PROPOSED 18" PIPE OPTION
34' - 11" RIGHT

STA. 51+81 TO STA. 52+50

PROJECT NAME: BRISTOL
PROJECT NUMBER: BRO 1445(32)

FILE NAME: s05j352xs2.dgn
PROJECT LEADER: J. LACROIX
DESIGNED BY: G. LAROCHE
MAINLINE SECTIONS *3

PLOT DATE: 04-JUN-2013
DRAWN BY: R. PELLET
CHECKED BY: T. FILLBACH
SHEET 47 OF 66