




53+00

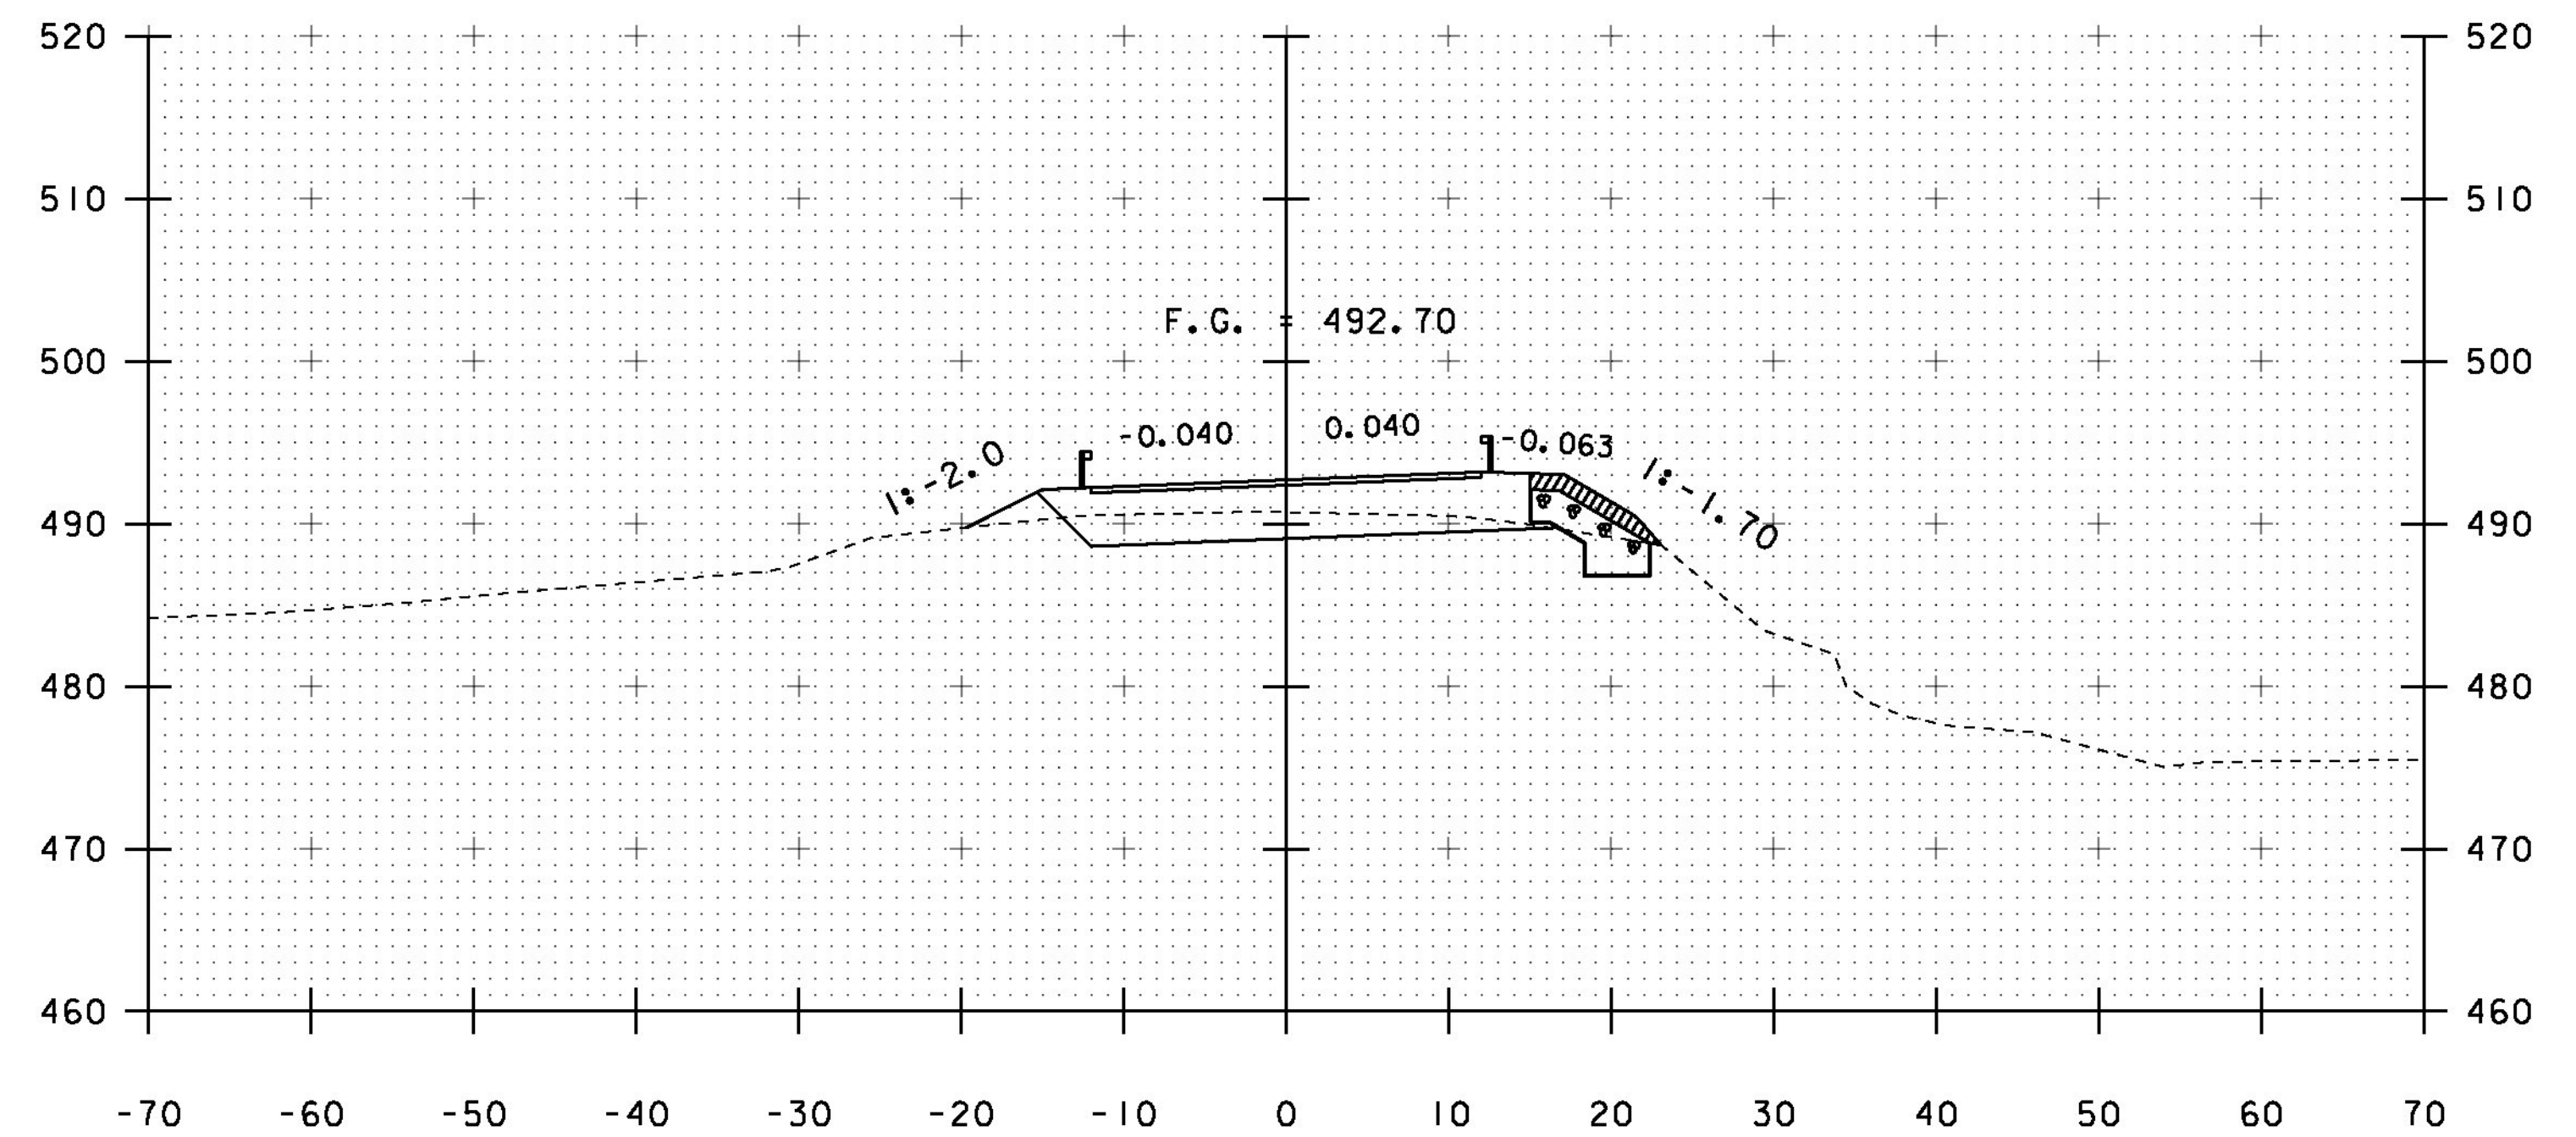

53+50

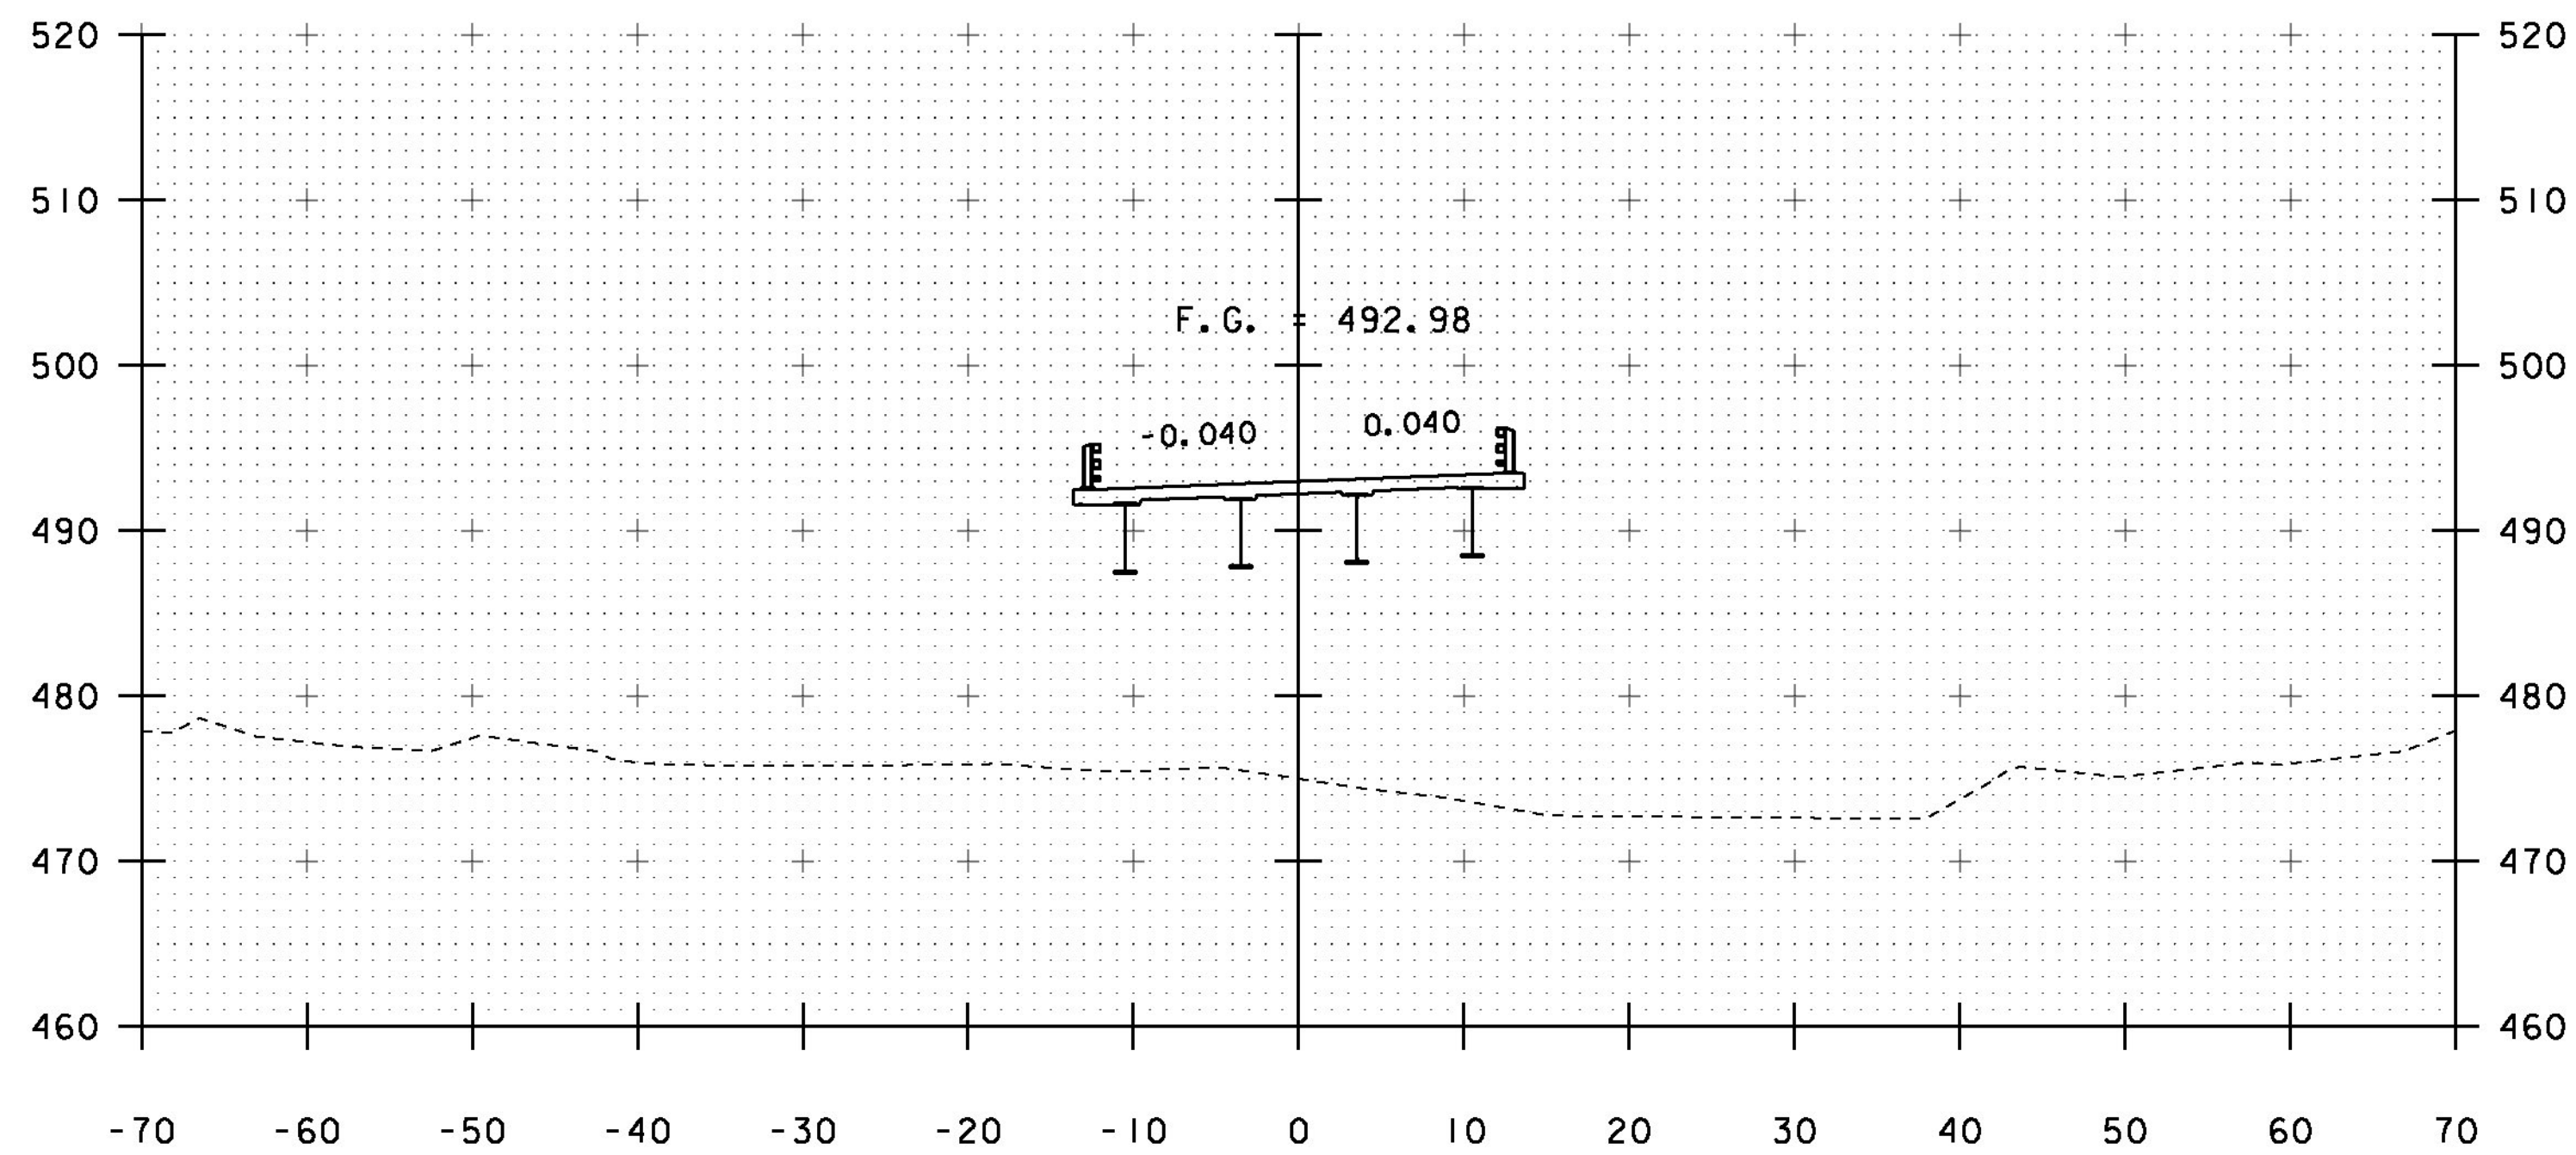

52+75

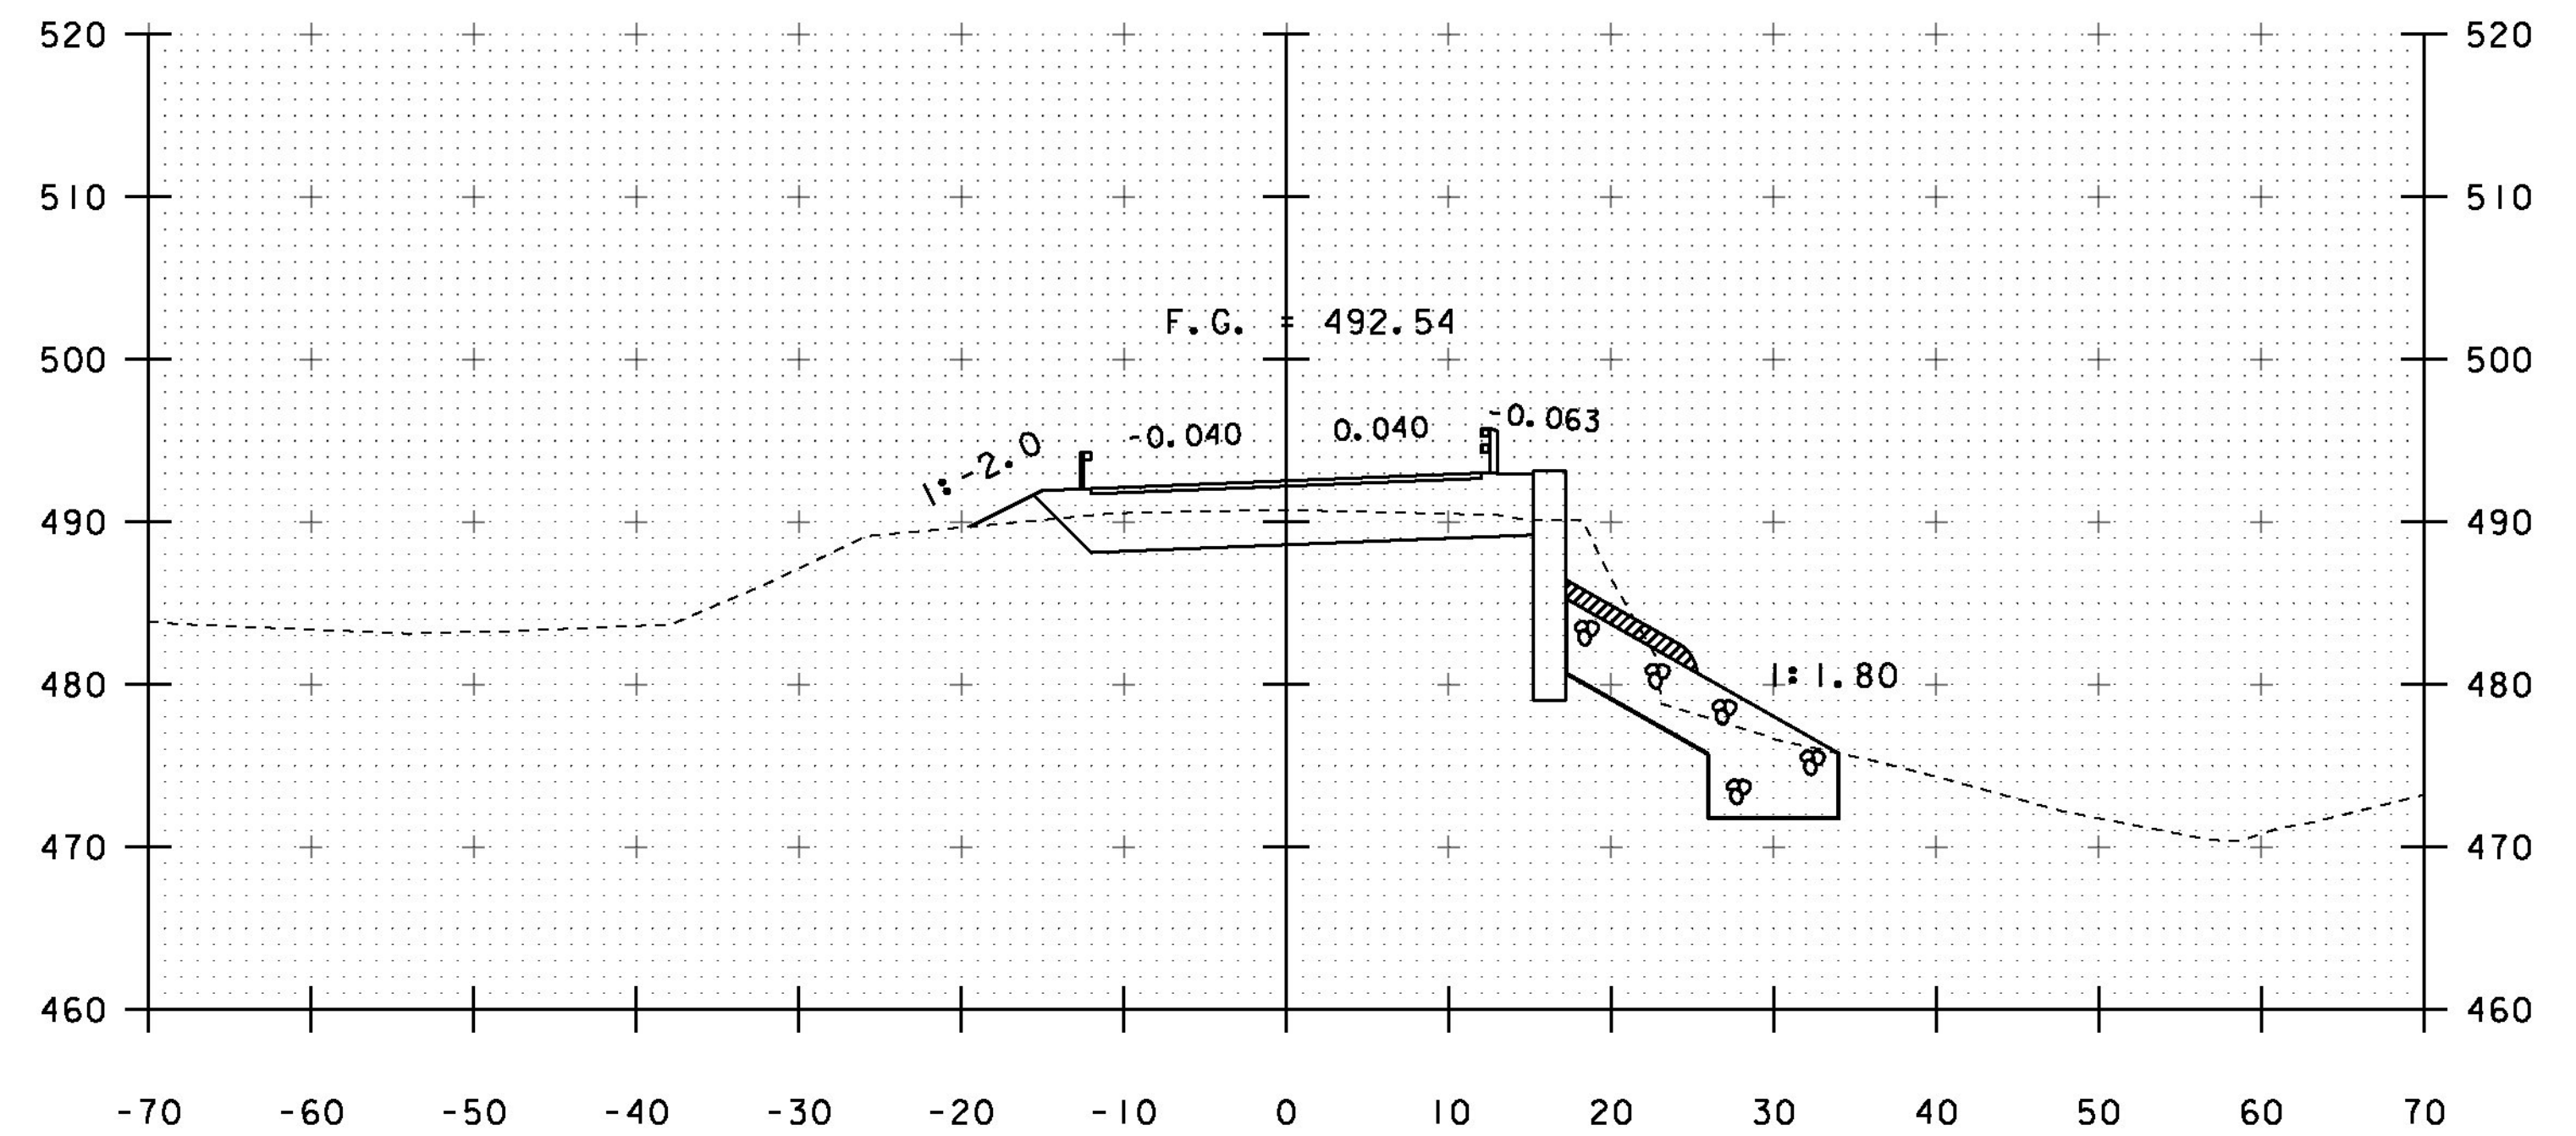

53+25

END BRIDGE  
STA - 53+19.02

PROJECT NAME: BRISTOL	PLOT DATE: 04-JUN-2013
PROJECT NUMBER: BRO 1445(32)	DRAWN BY: R. PELLET
FILE NAME: s05j352xs2.dgn	CHECKED BY: T. FILLBACH
PROJECT LEADER: J. LACROIX	SHEET 48 OF 66
DESIGNED BY: G. LAROCHE	
MAINLINE SECTIONS *4	

STA. 52+75 TO STA. 53+50