




54+00

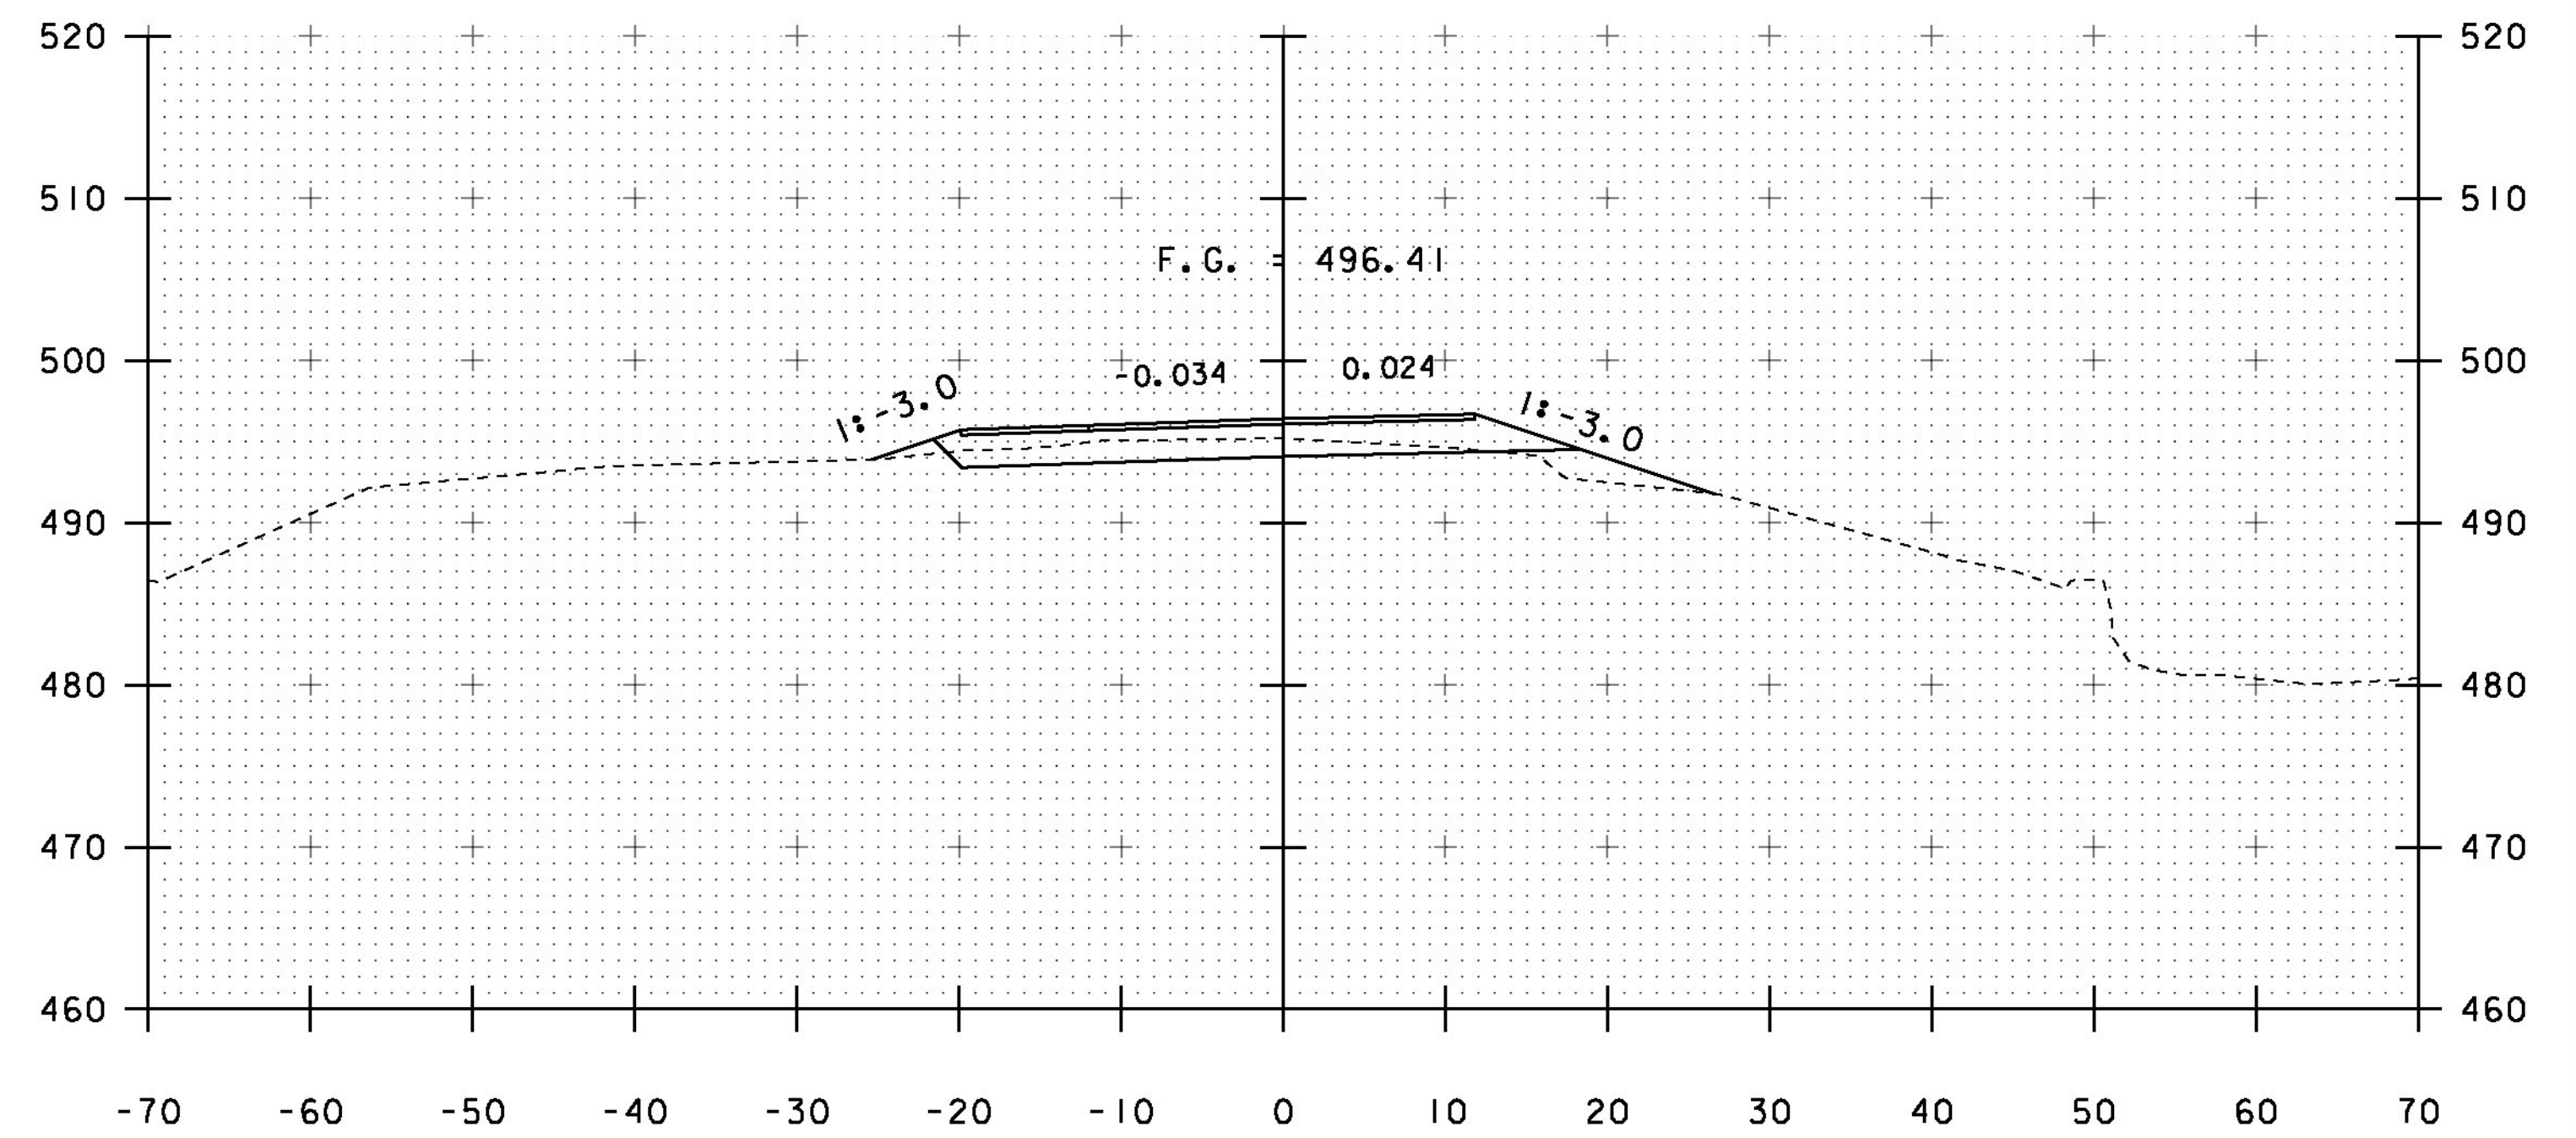

54+50

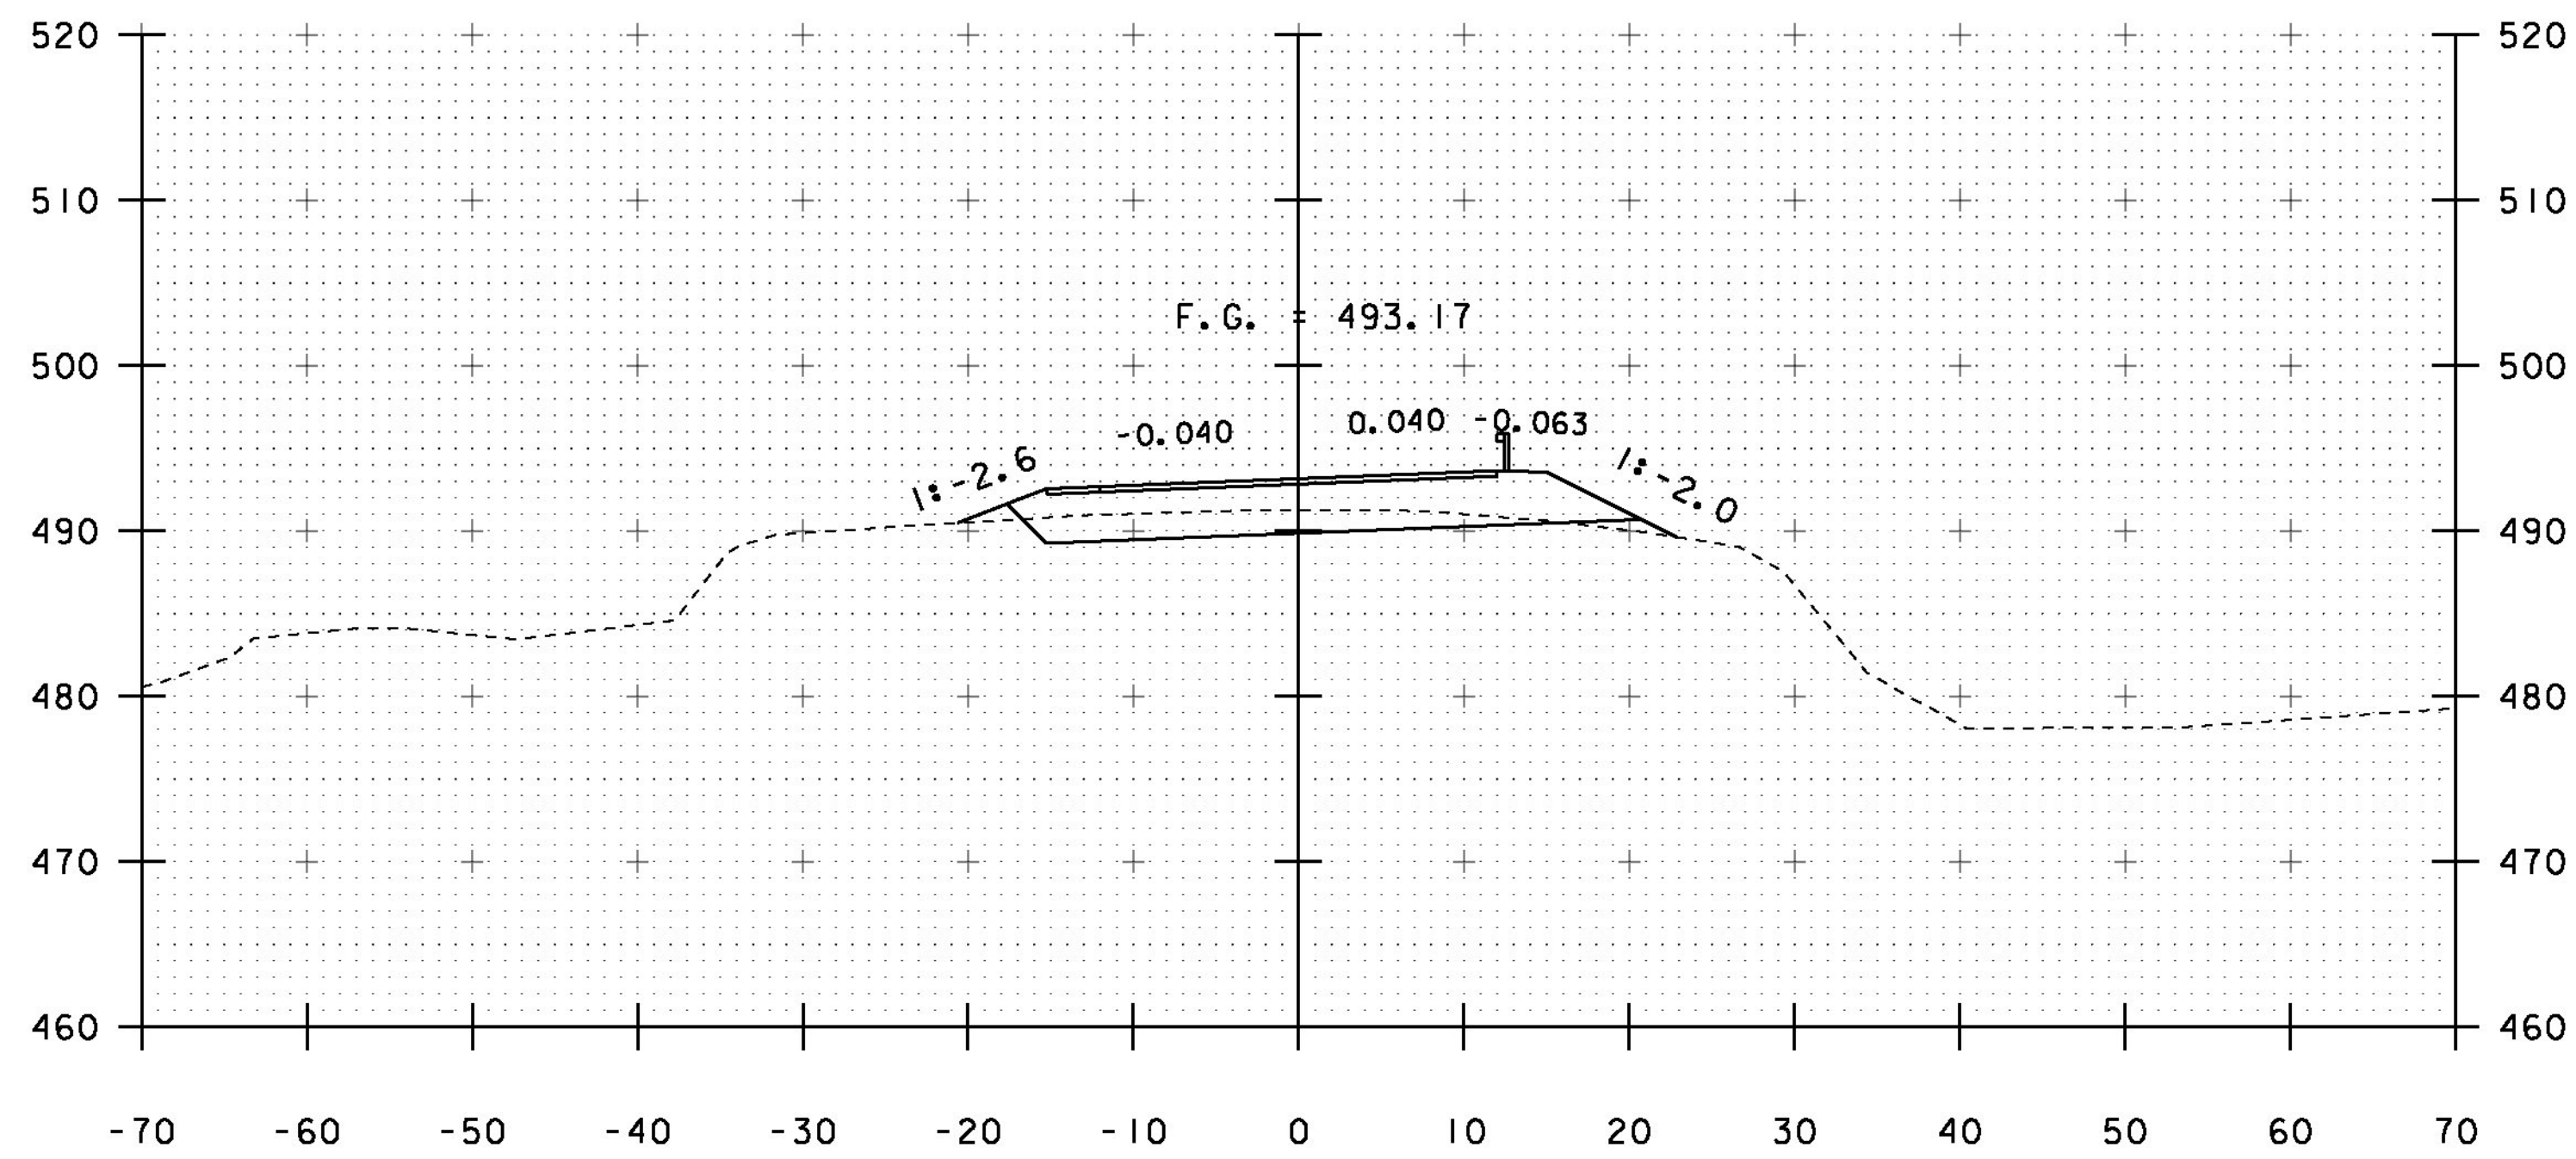

53+75

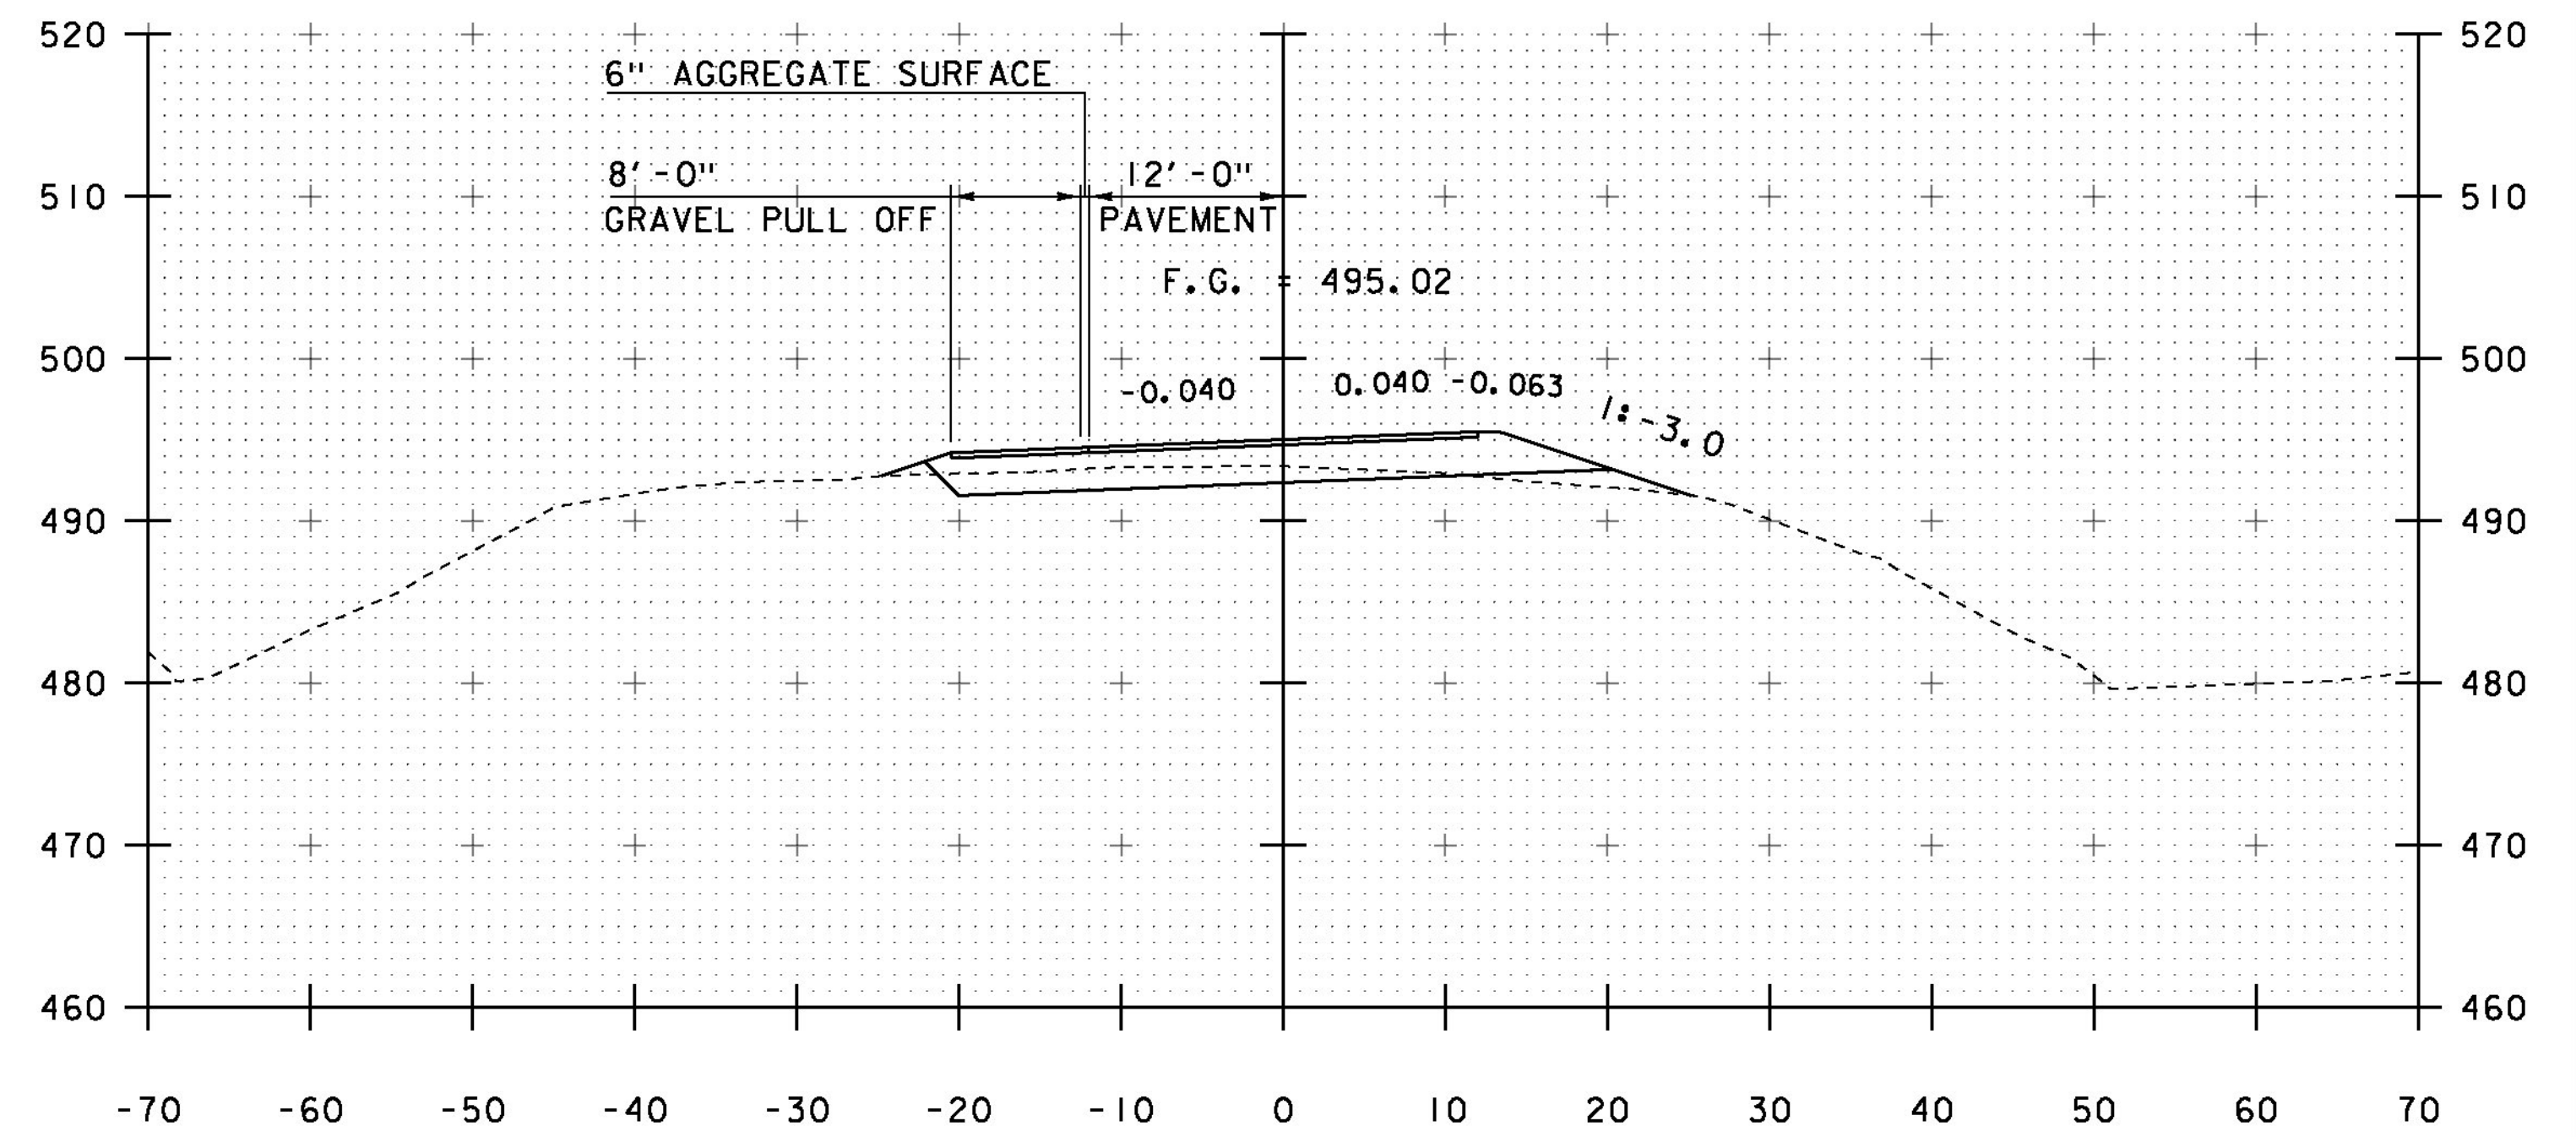

54+25
END PROJECT

PROJECT NAME: BRISTOL	PLOT DATE: 04-JUN-2013
PROJECT NUMBER: BRO 1445(32)	DRAWN BY: R. PELLETT
FILE NAME: s05j352xs2.dgn	CHECKED BY: T. FILLBACH
PROJECT LEADER: J. LACROIX	SHEET 49 OF 66
DESIGNED BY: G. LAROCHE	
MAINLINE SECTIONS #5	

STA. 53+75 TO STA. 54+50