




1+65

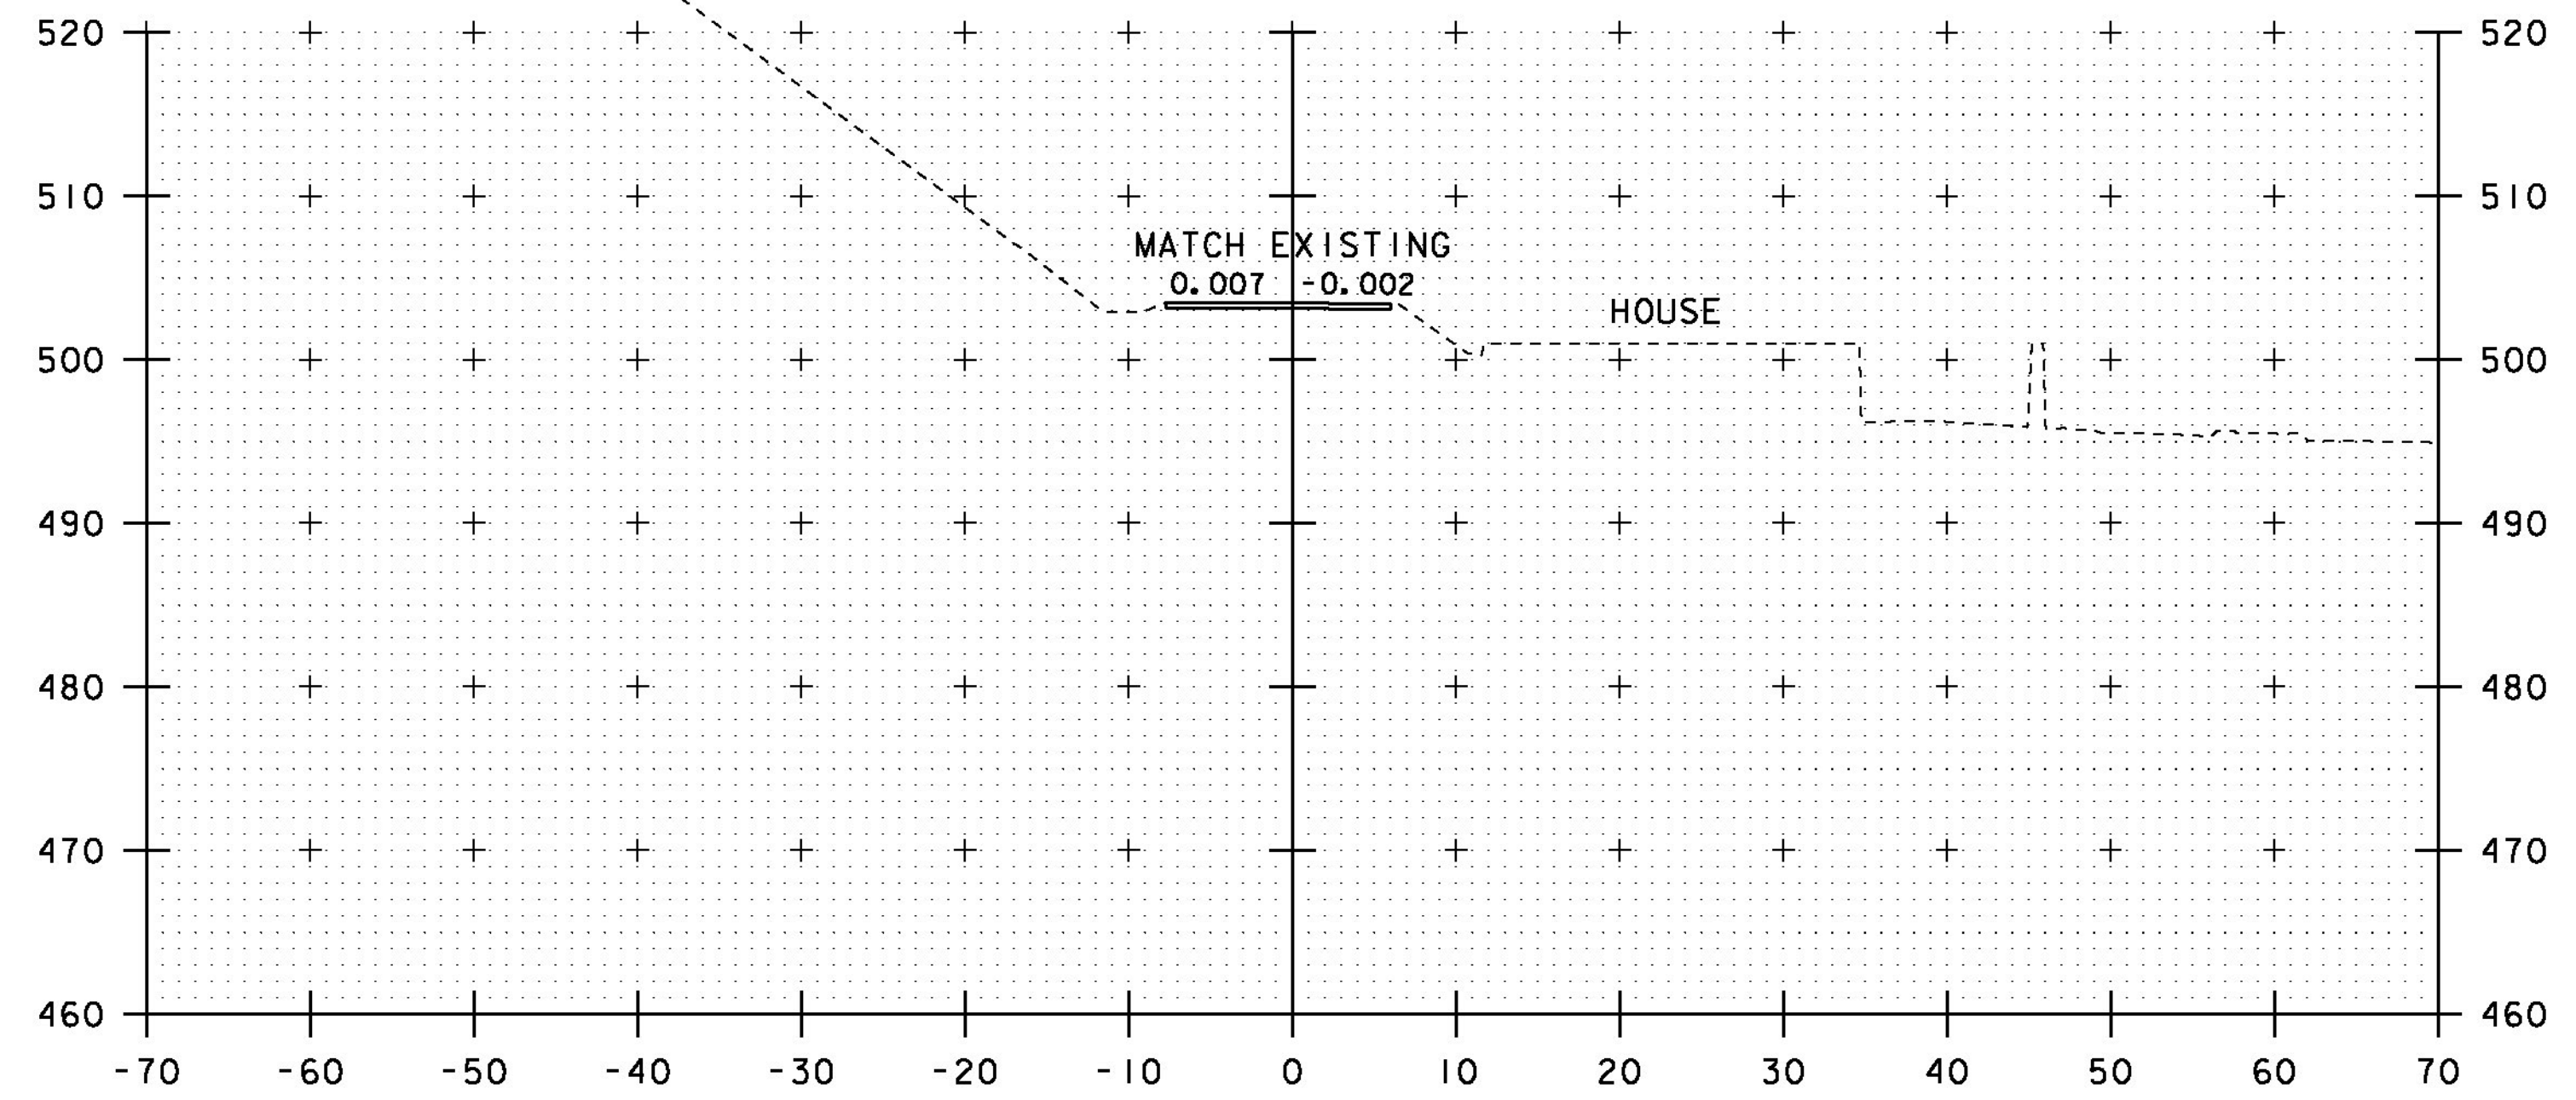

2+00

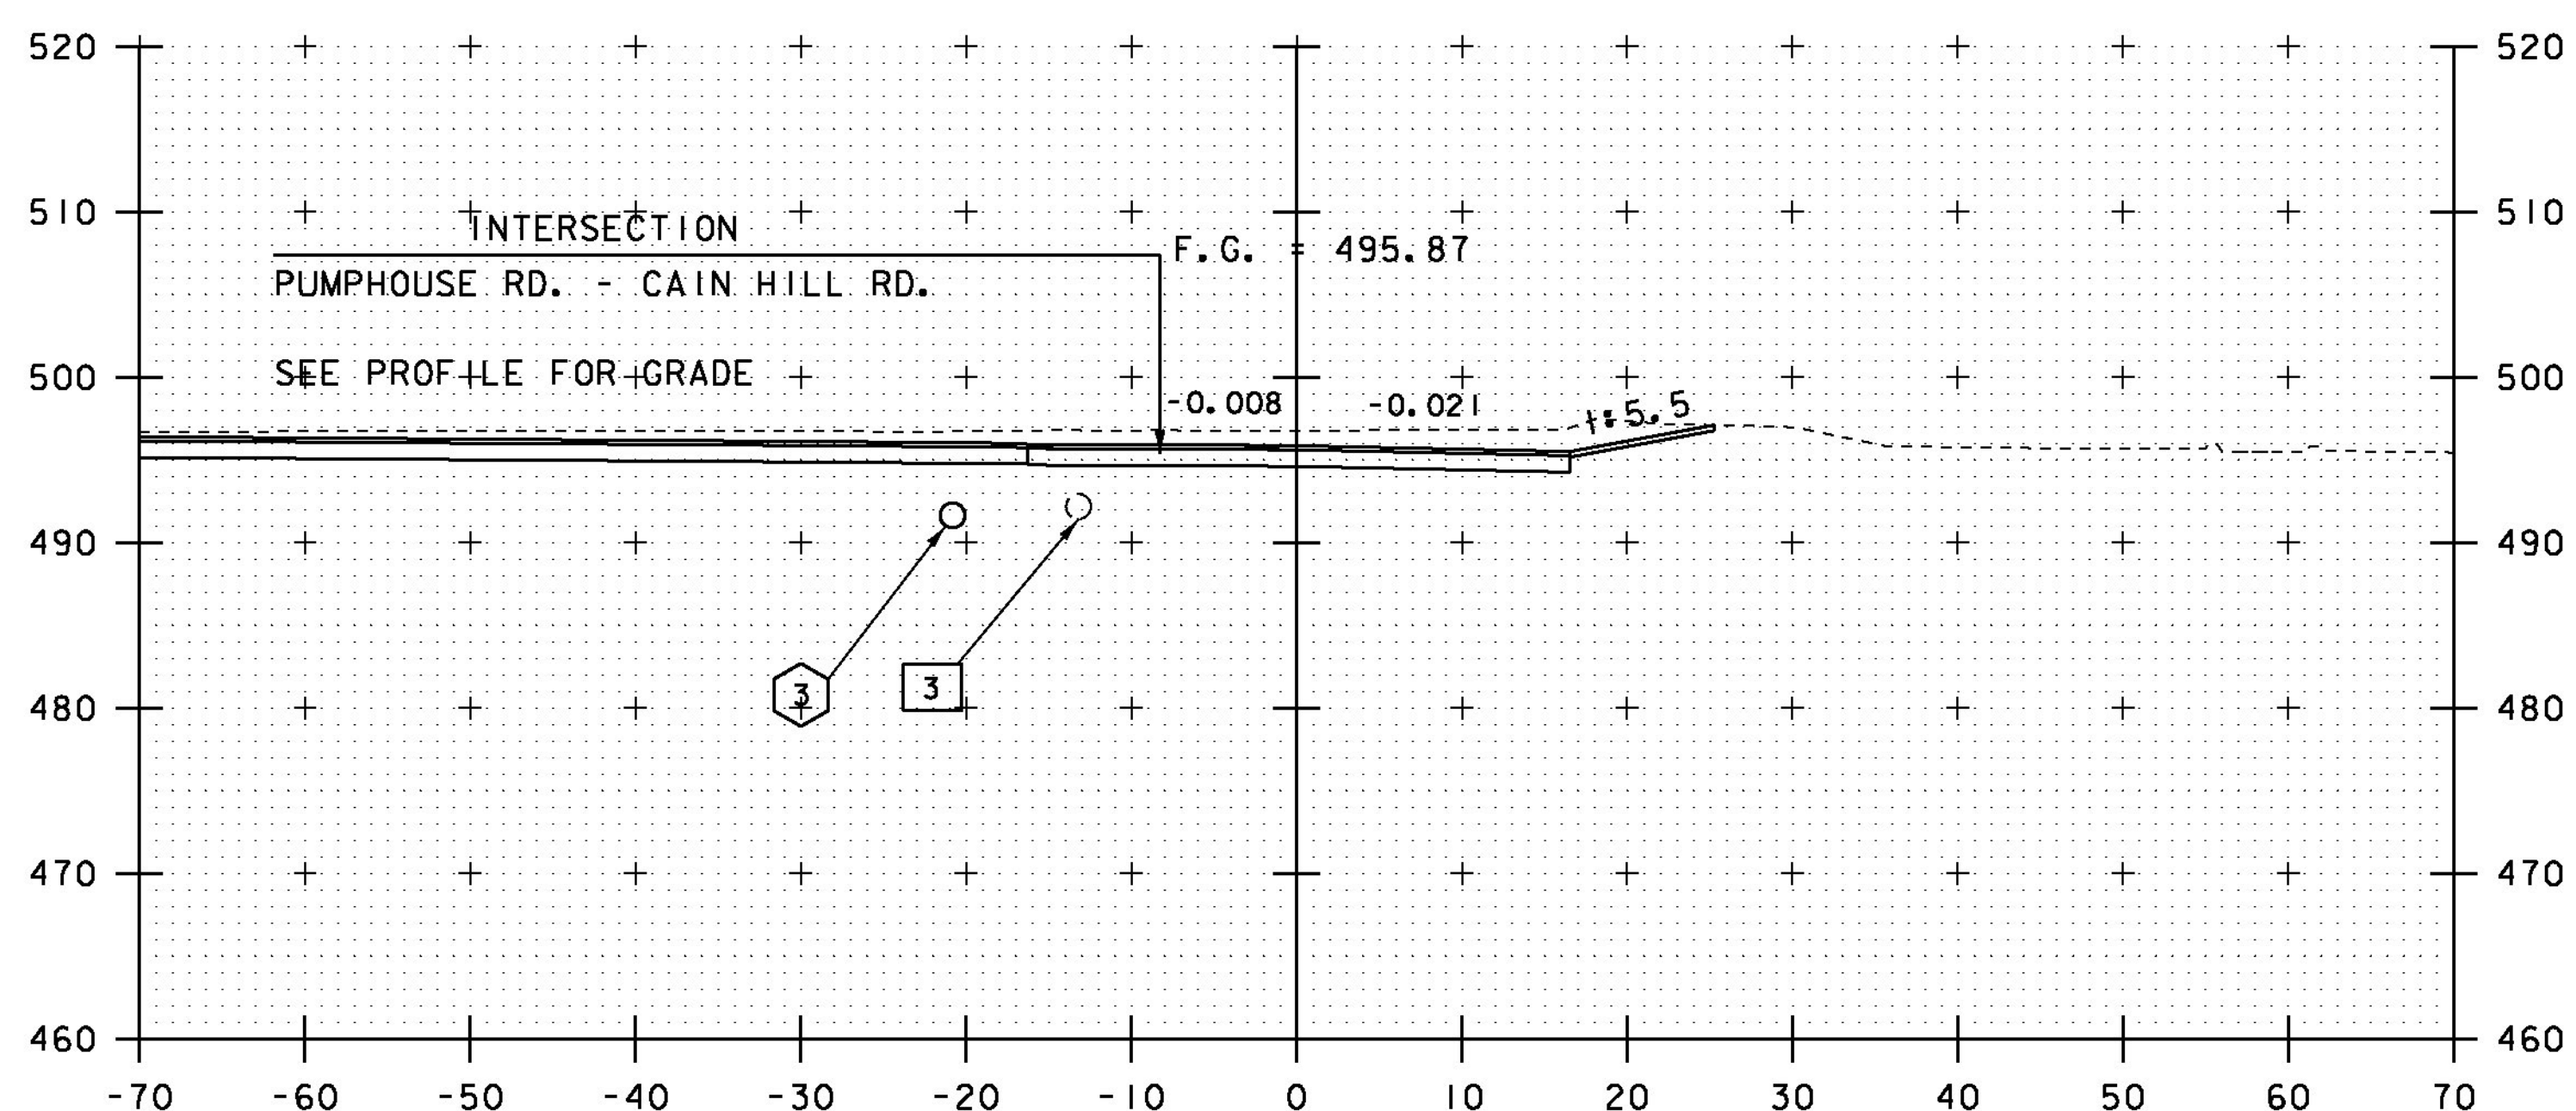

1+55

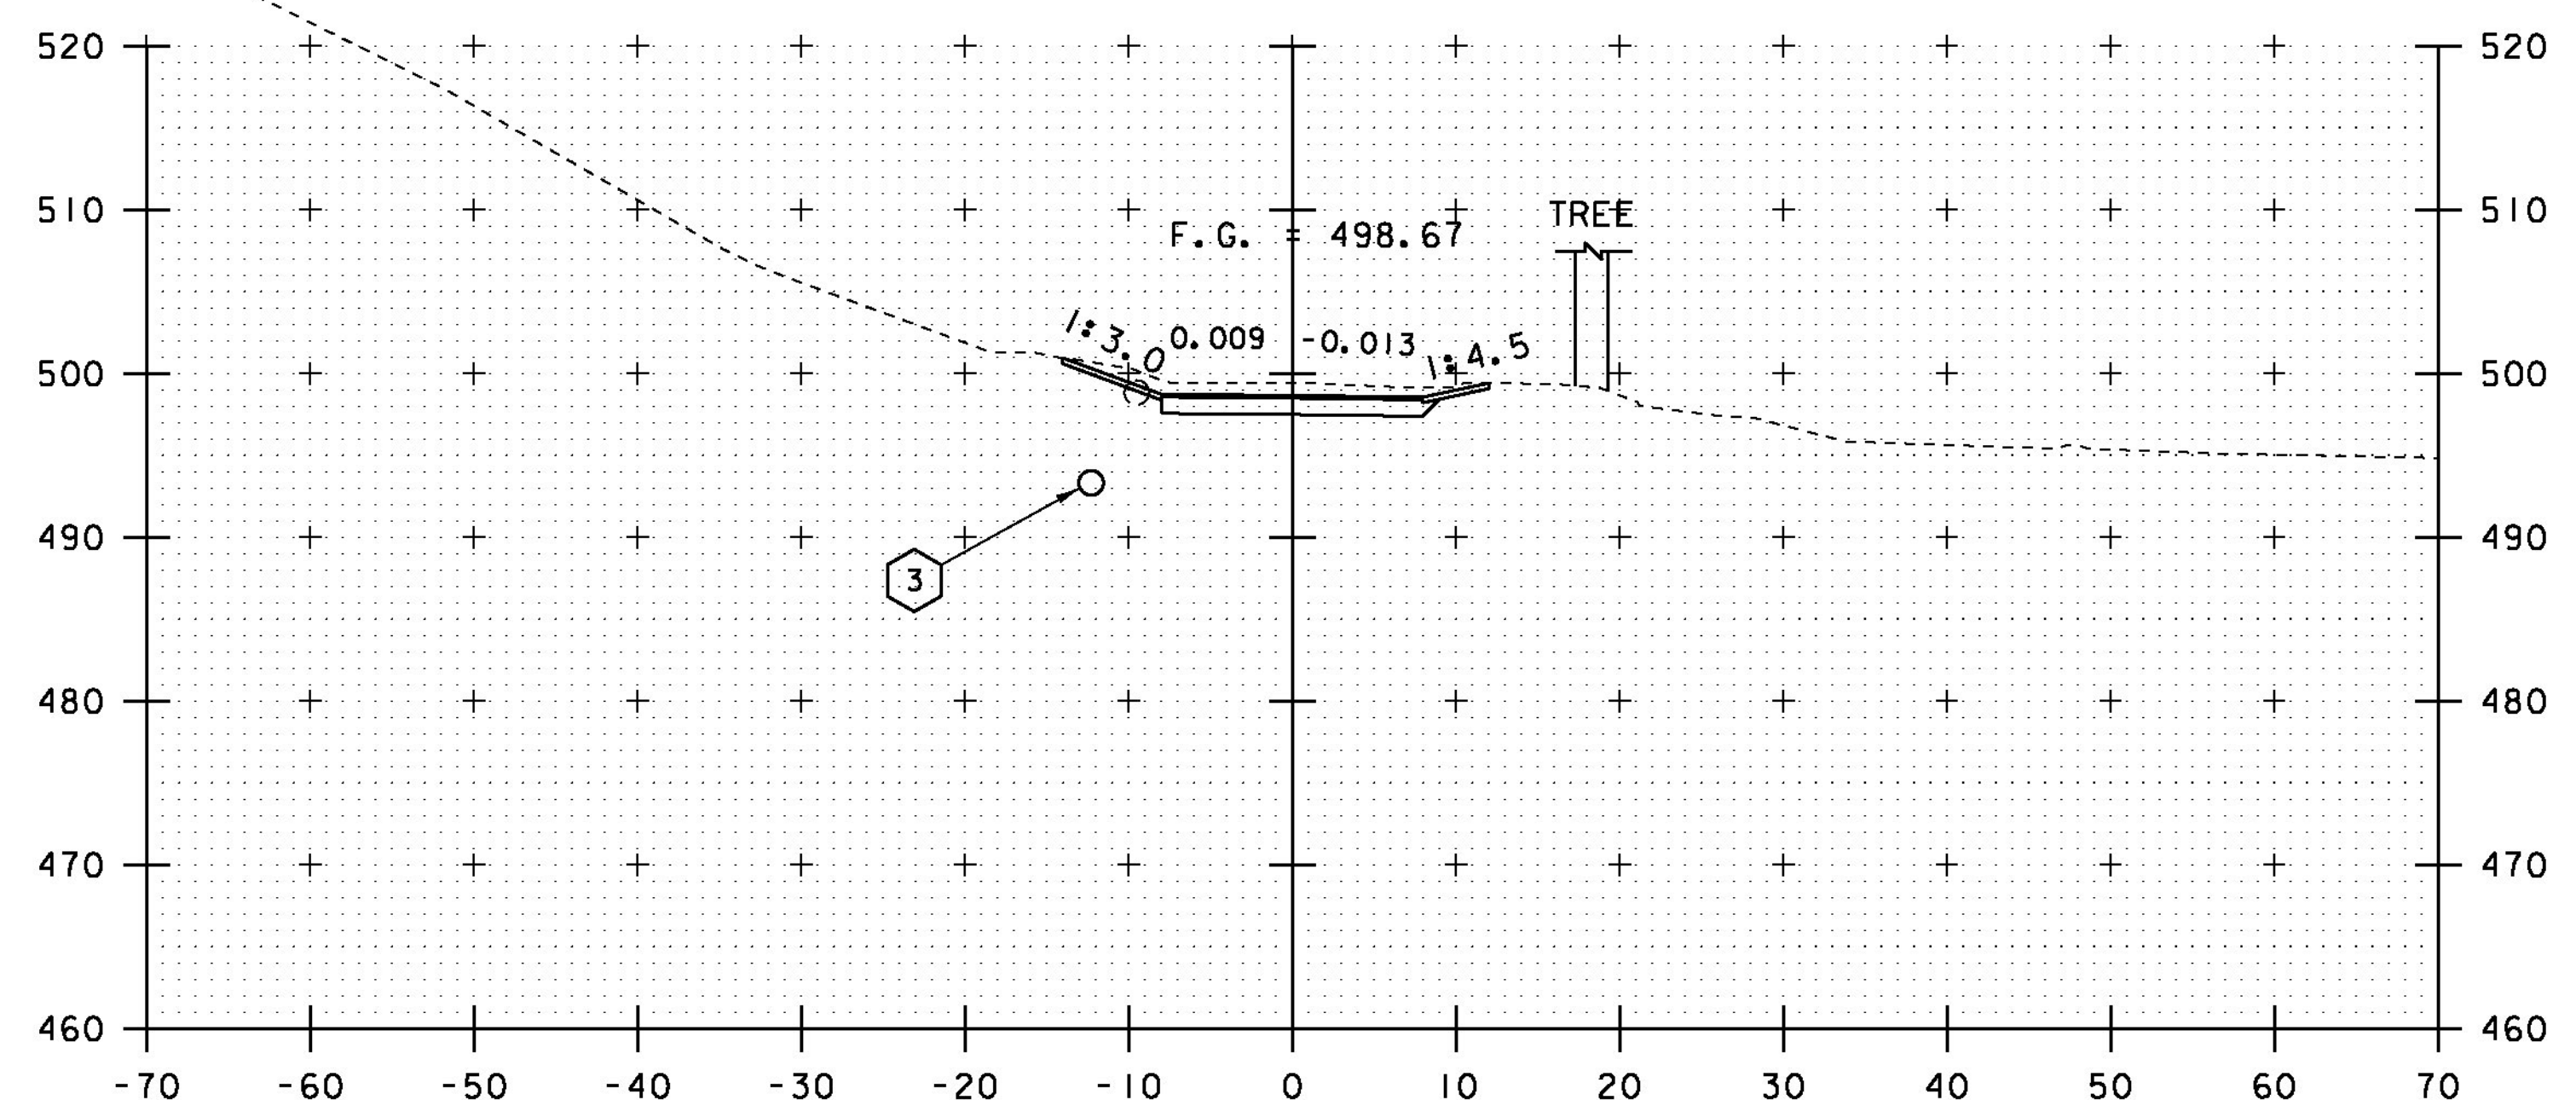

1+75

3 EXISTING 18" ACCGMP PIPE

3 PROPOSED 18" OPTION PIPE

STA. 1+55 TO STA. 2+00

PROJECT NAME:	BRISTOL	PLOT DATE:	04-JUN-2013
PROJECT NUMBER:	BRO 1445(32)	DRAWN BY:	R. PELLETT
FILE NAME:	s05j352xs2.dgn	DESIGNED BY:	G. LAROCHE
PROJECT LEADER:	J. LACROIX	CHECKED BY:	T. FILLBACH
CAIN HILL SECTIONS #2		SHEET	52 OF 66