




4+75

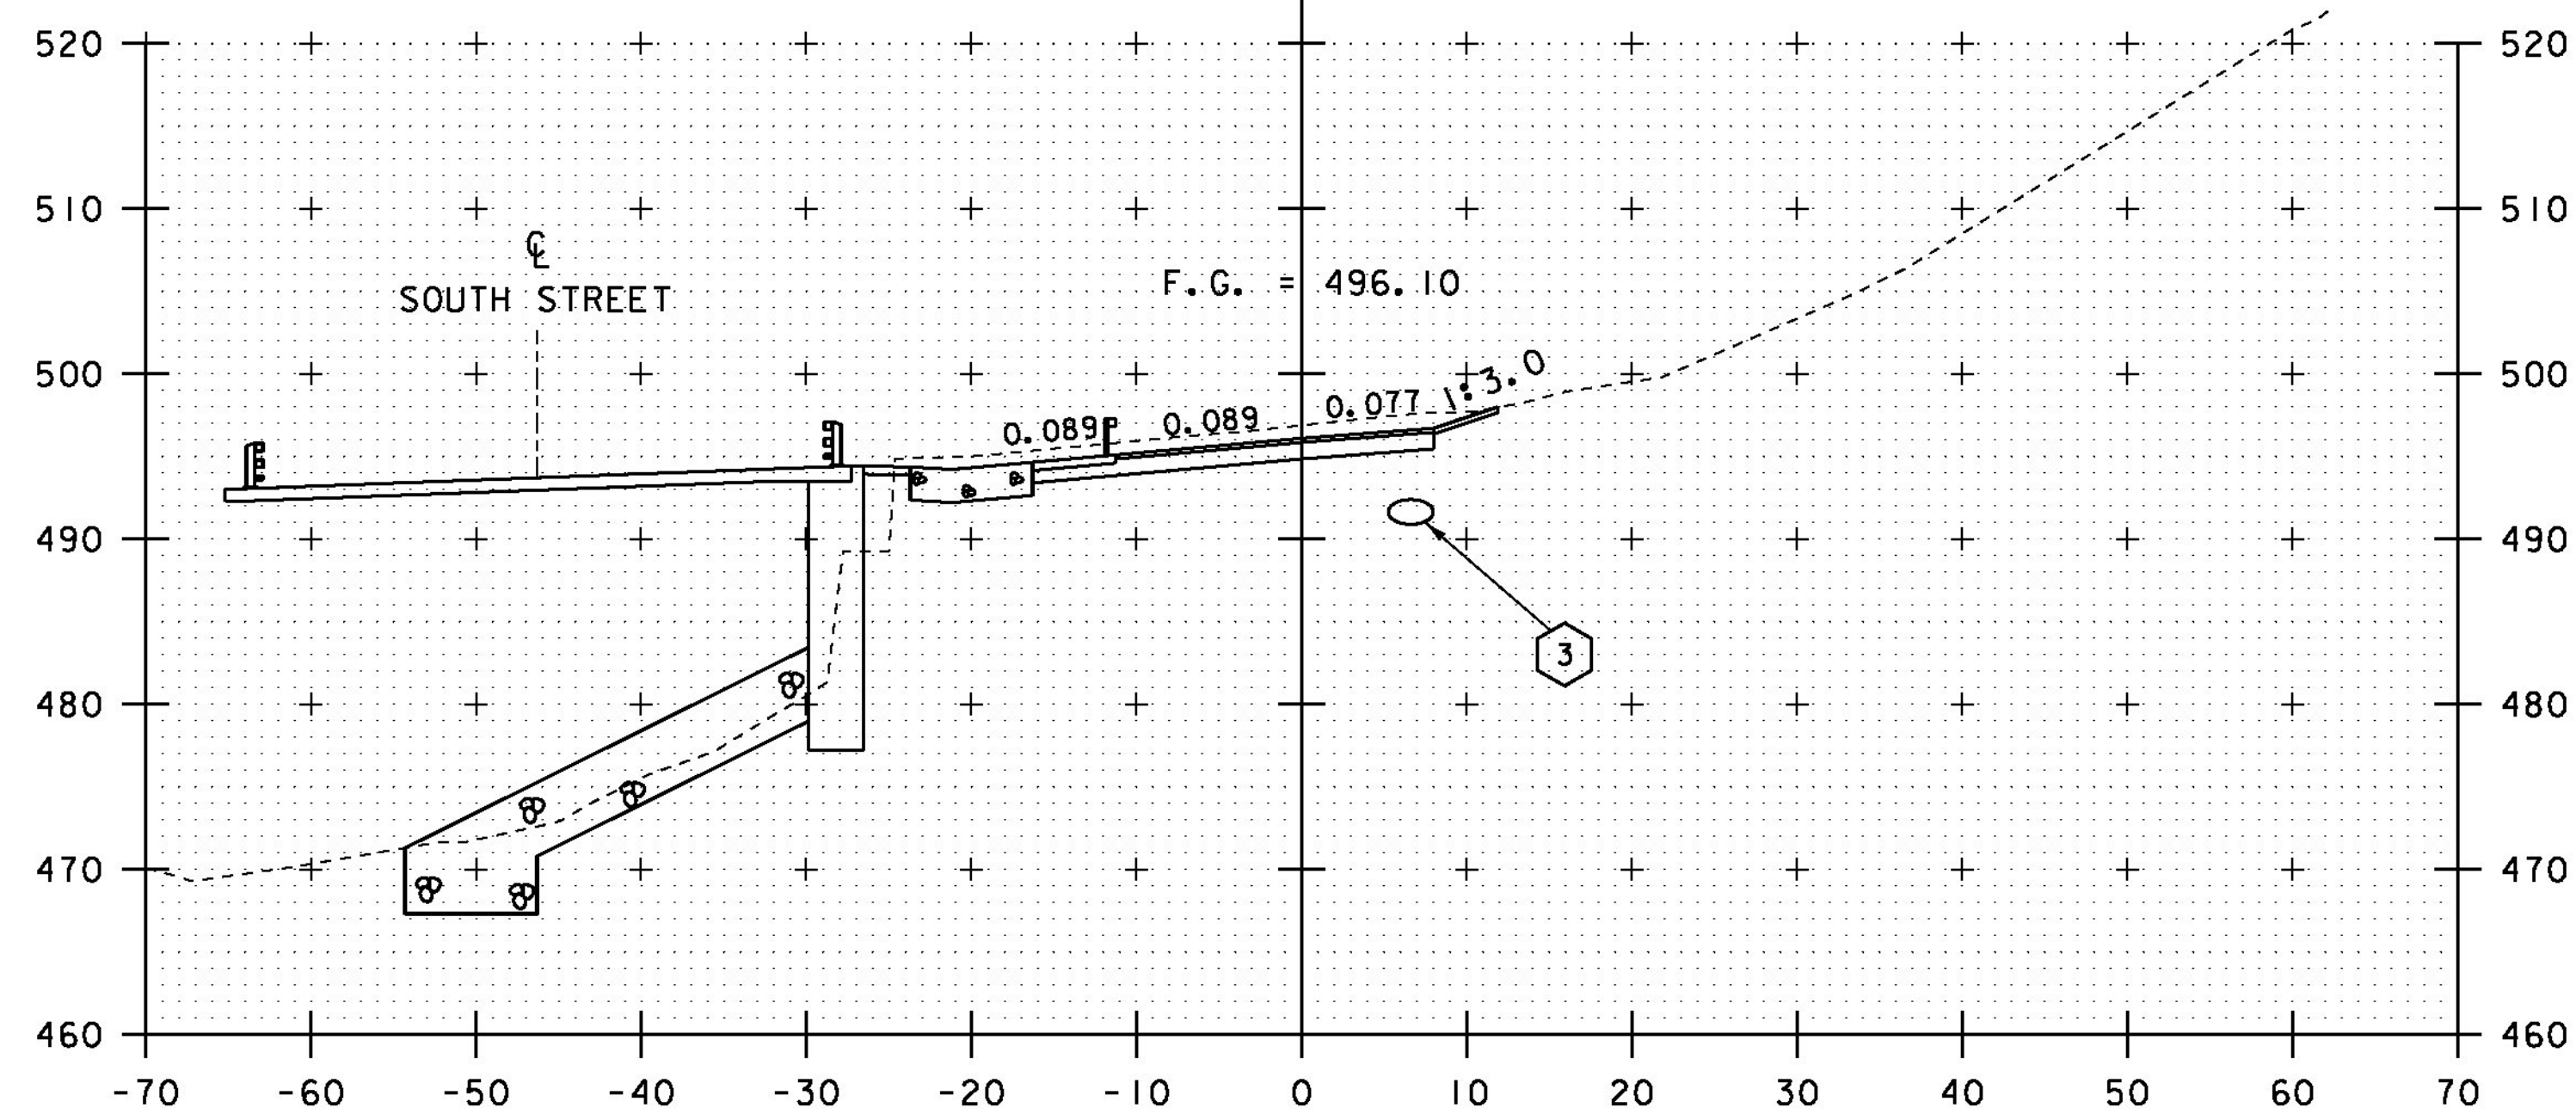

4+70

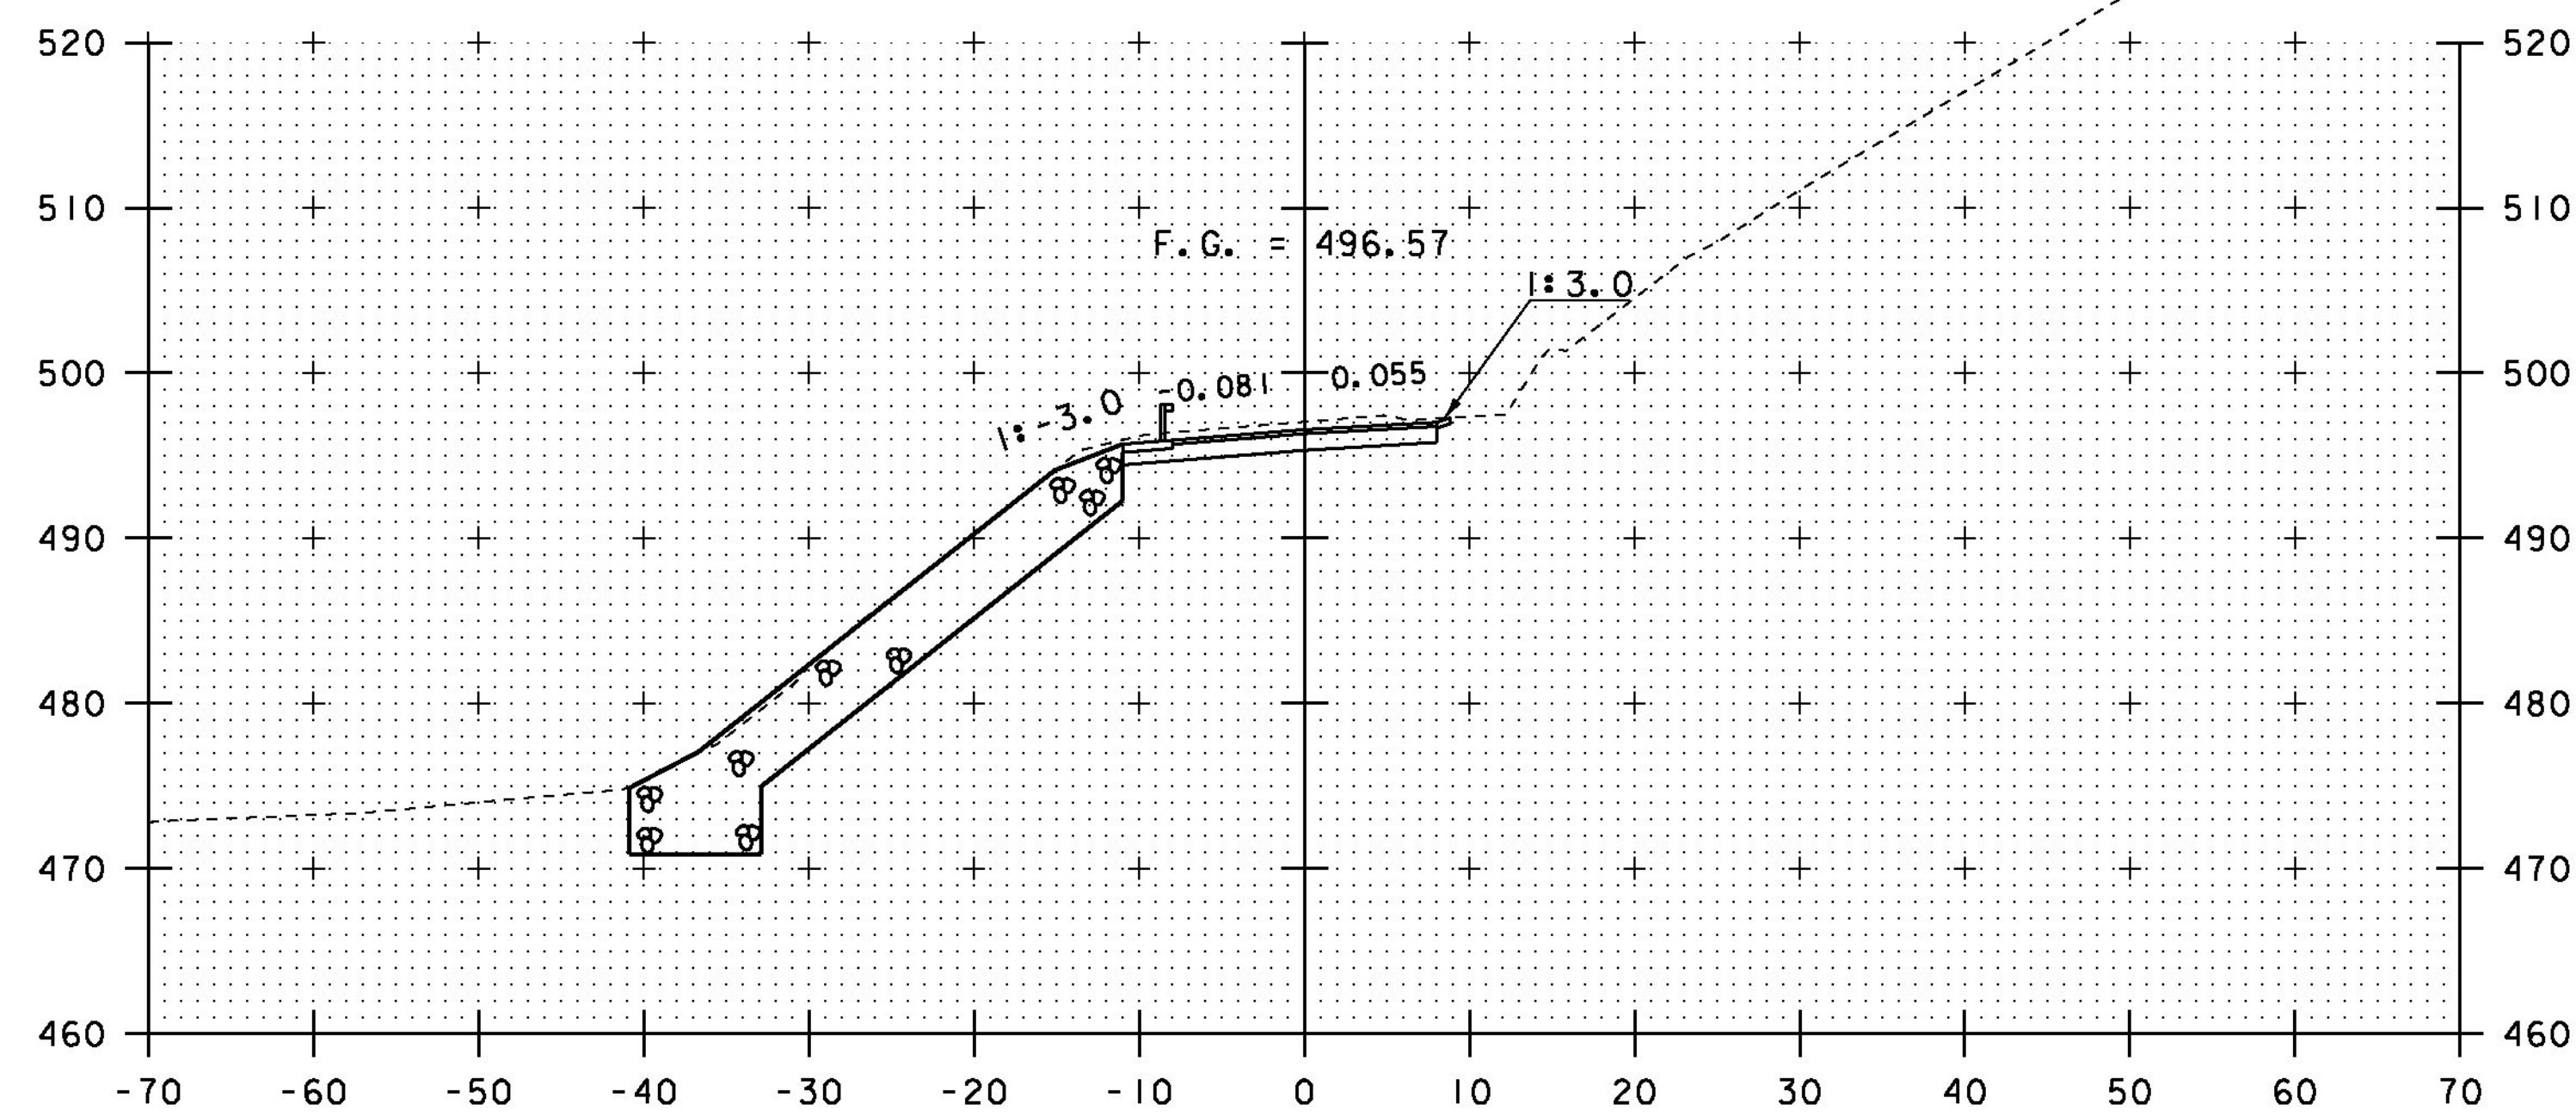

5+00

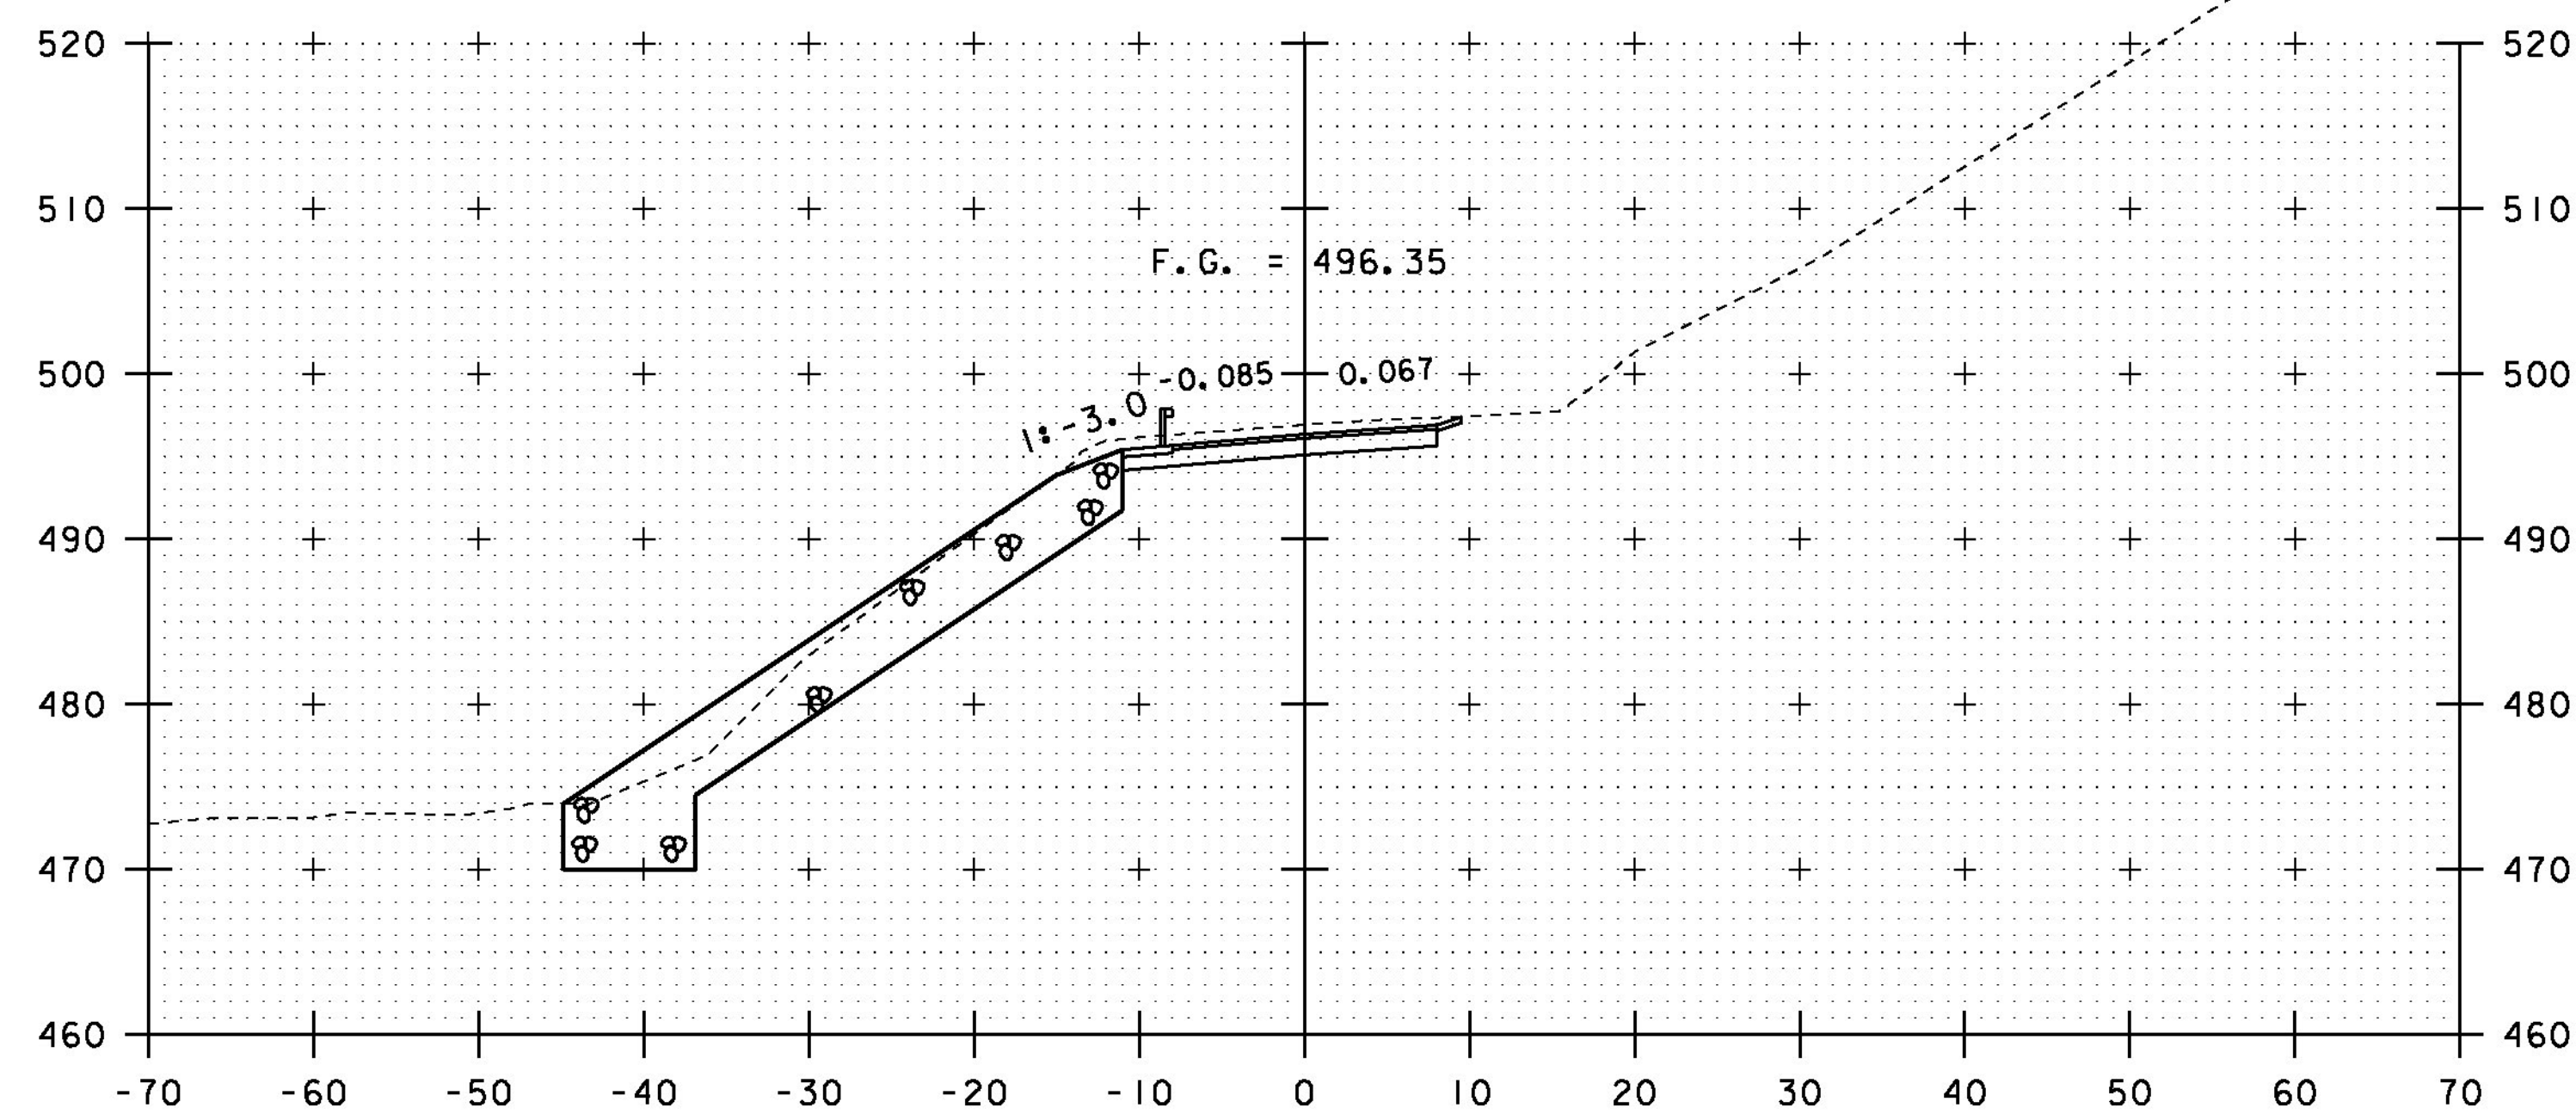

4+85

3 EXISTING 18" ACCGMP PIPE

3 PROPOSED 18" OPTION PIPE

STA. 4+70 TO STA. 5+00

PROJECT NAME: BRISTOL
PROJECT NUMBER: BRO 1445(32)

FILE NAME: s05j352xs2.dgn
PROJECT LEADER: J. LACROIX
DESIGNED BY: G. LAROCHE
PUMPHOUSE SECTIONS #1

PLOT DATE: 04-JUN-2013
DRAWN BY: R. PELLET
CHECKED BY: T. FILLBACH
SHEET 53 OF 66