




5+25

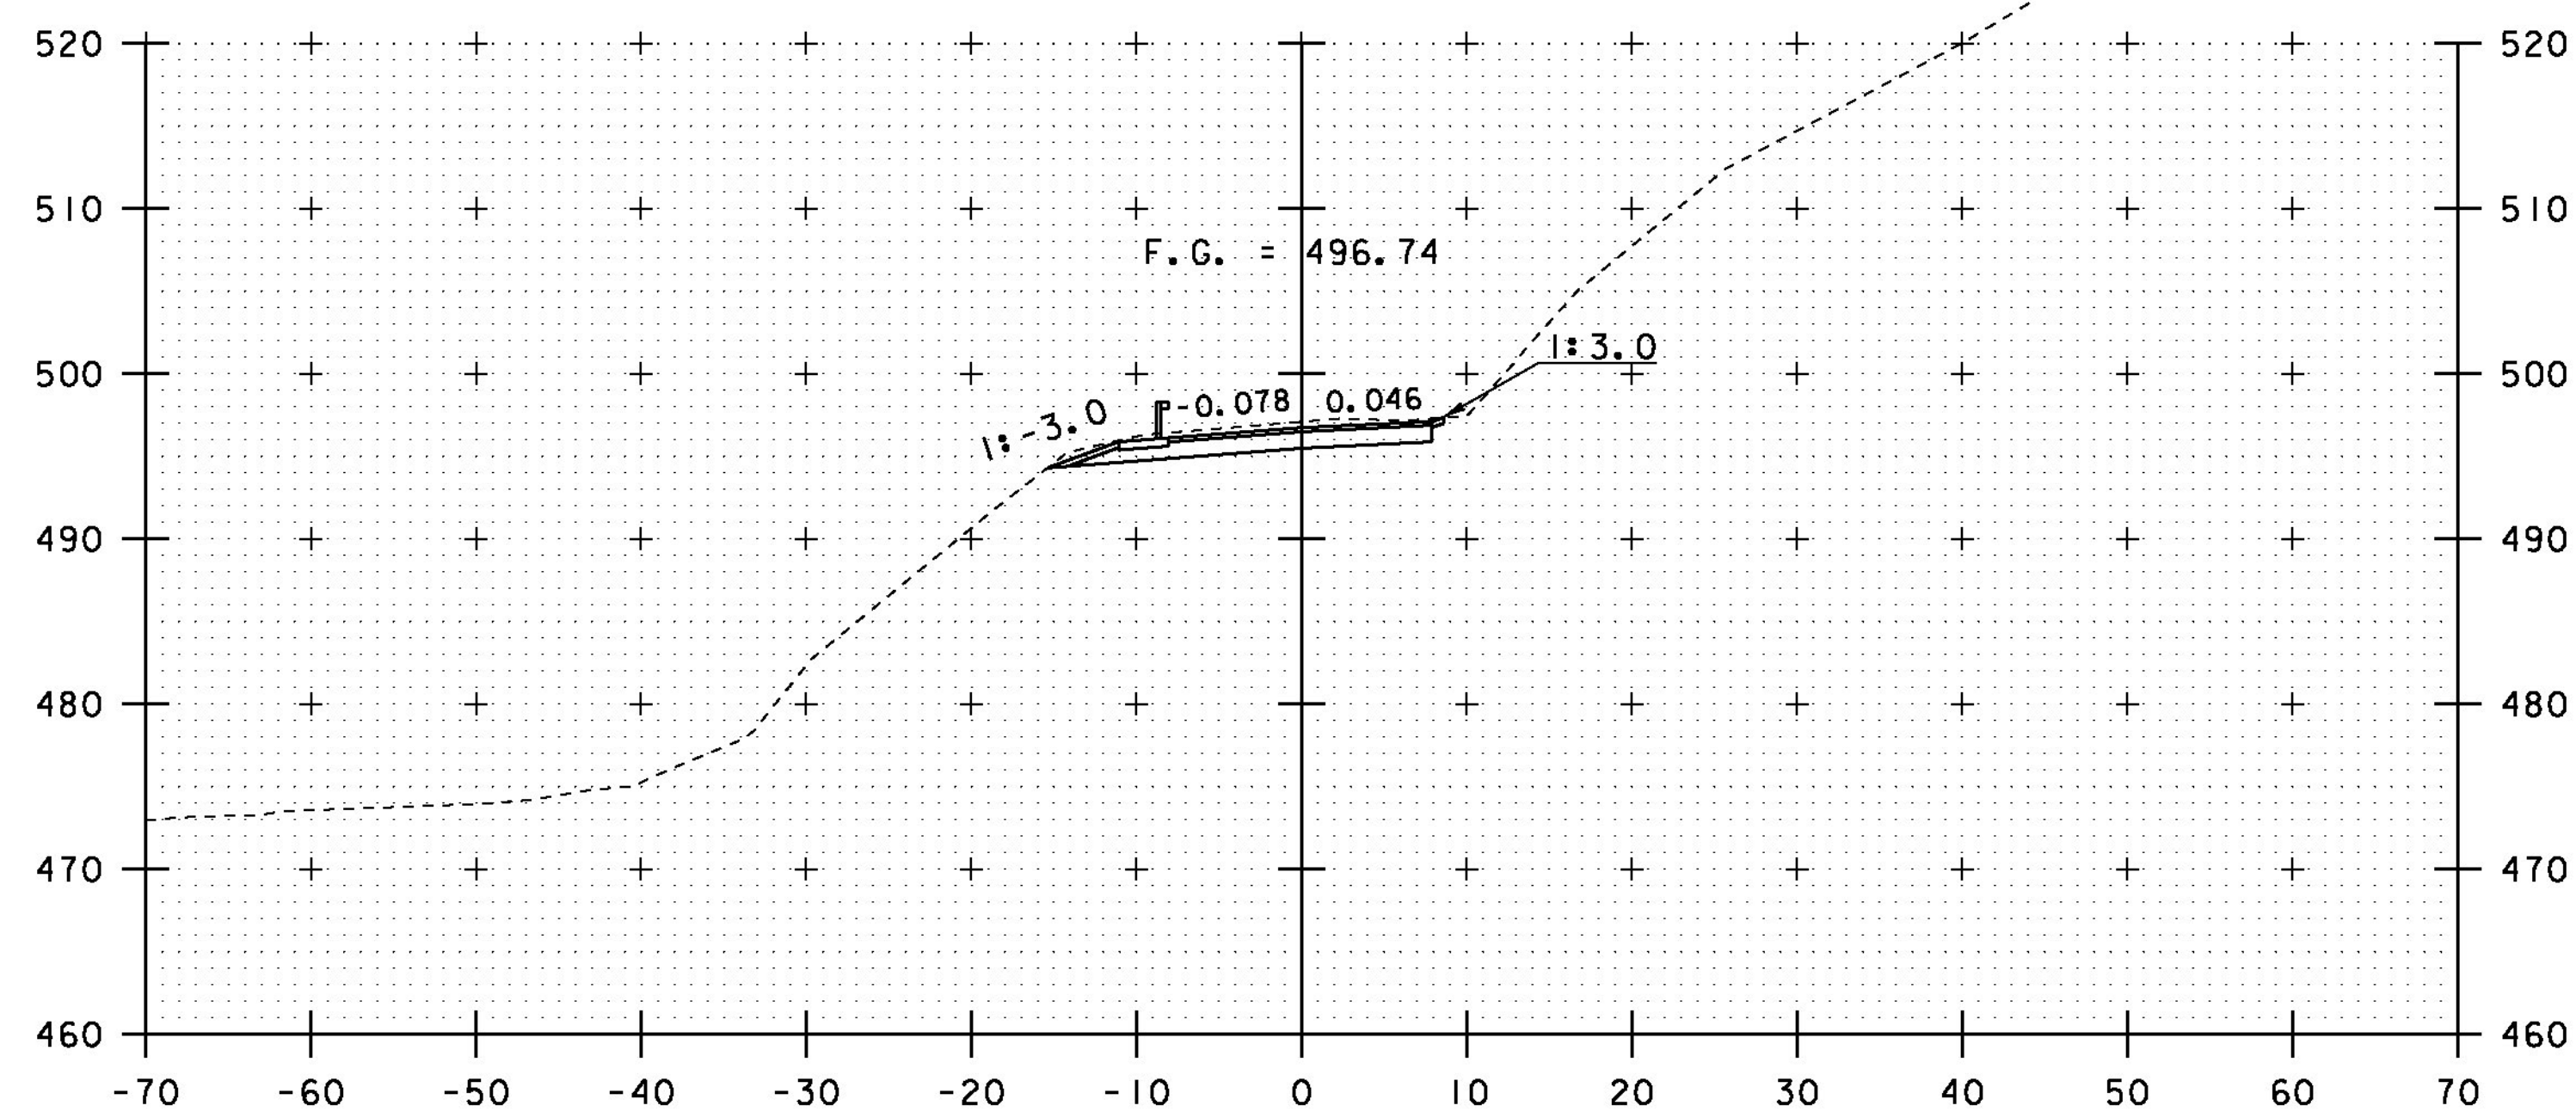

5+12

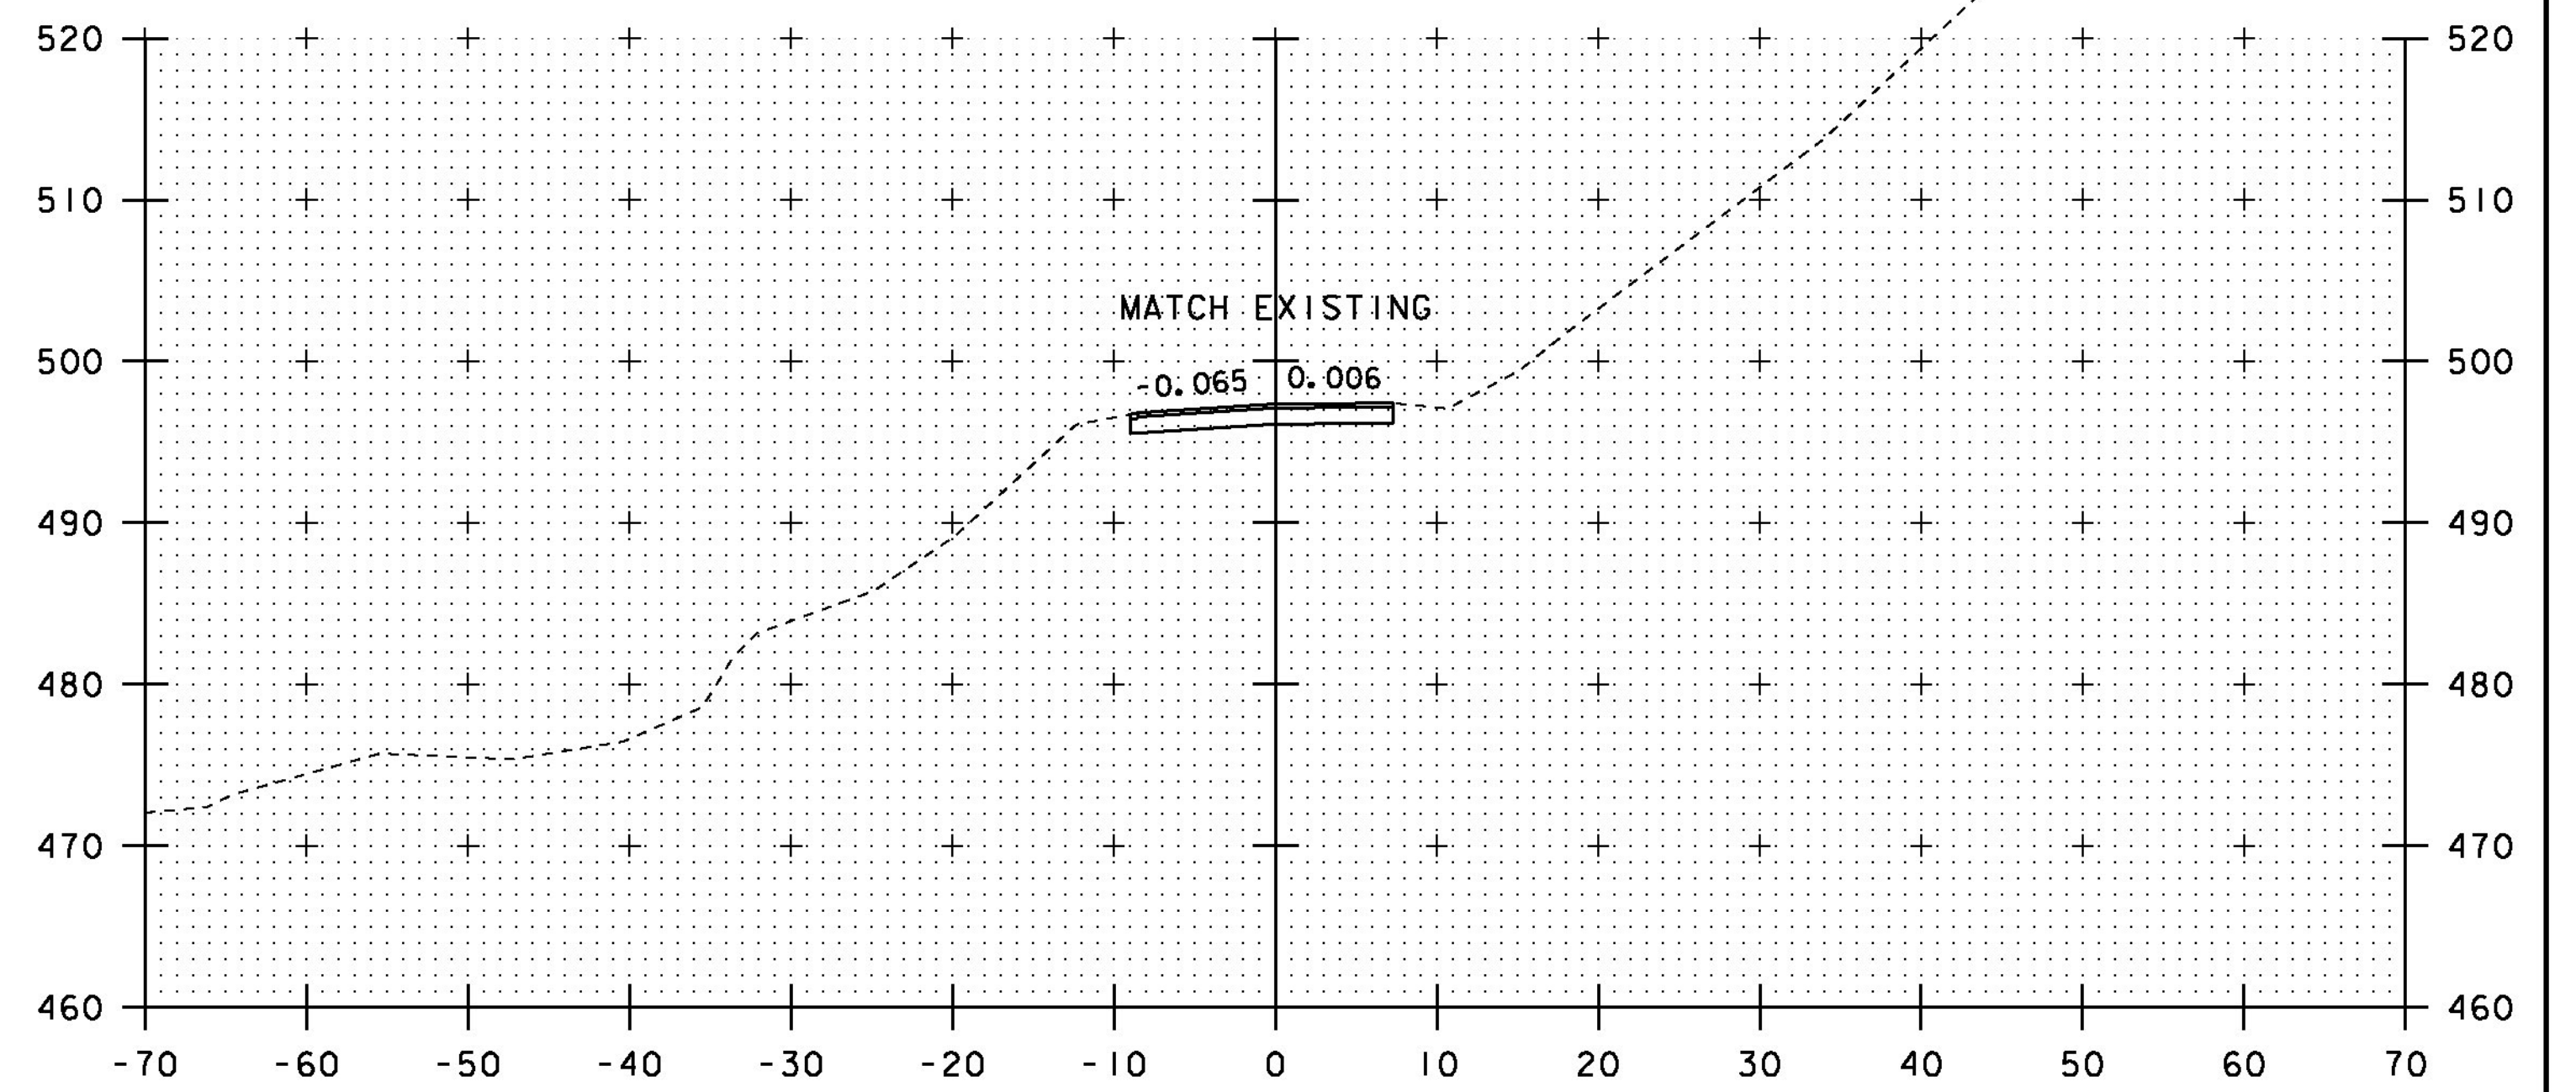

5+62

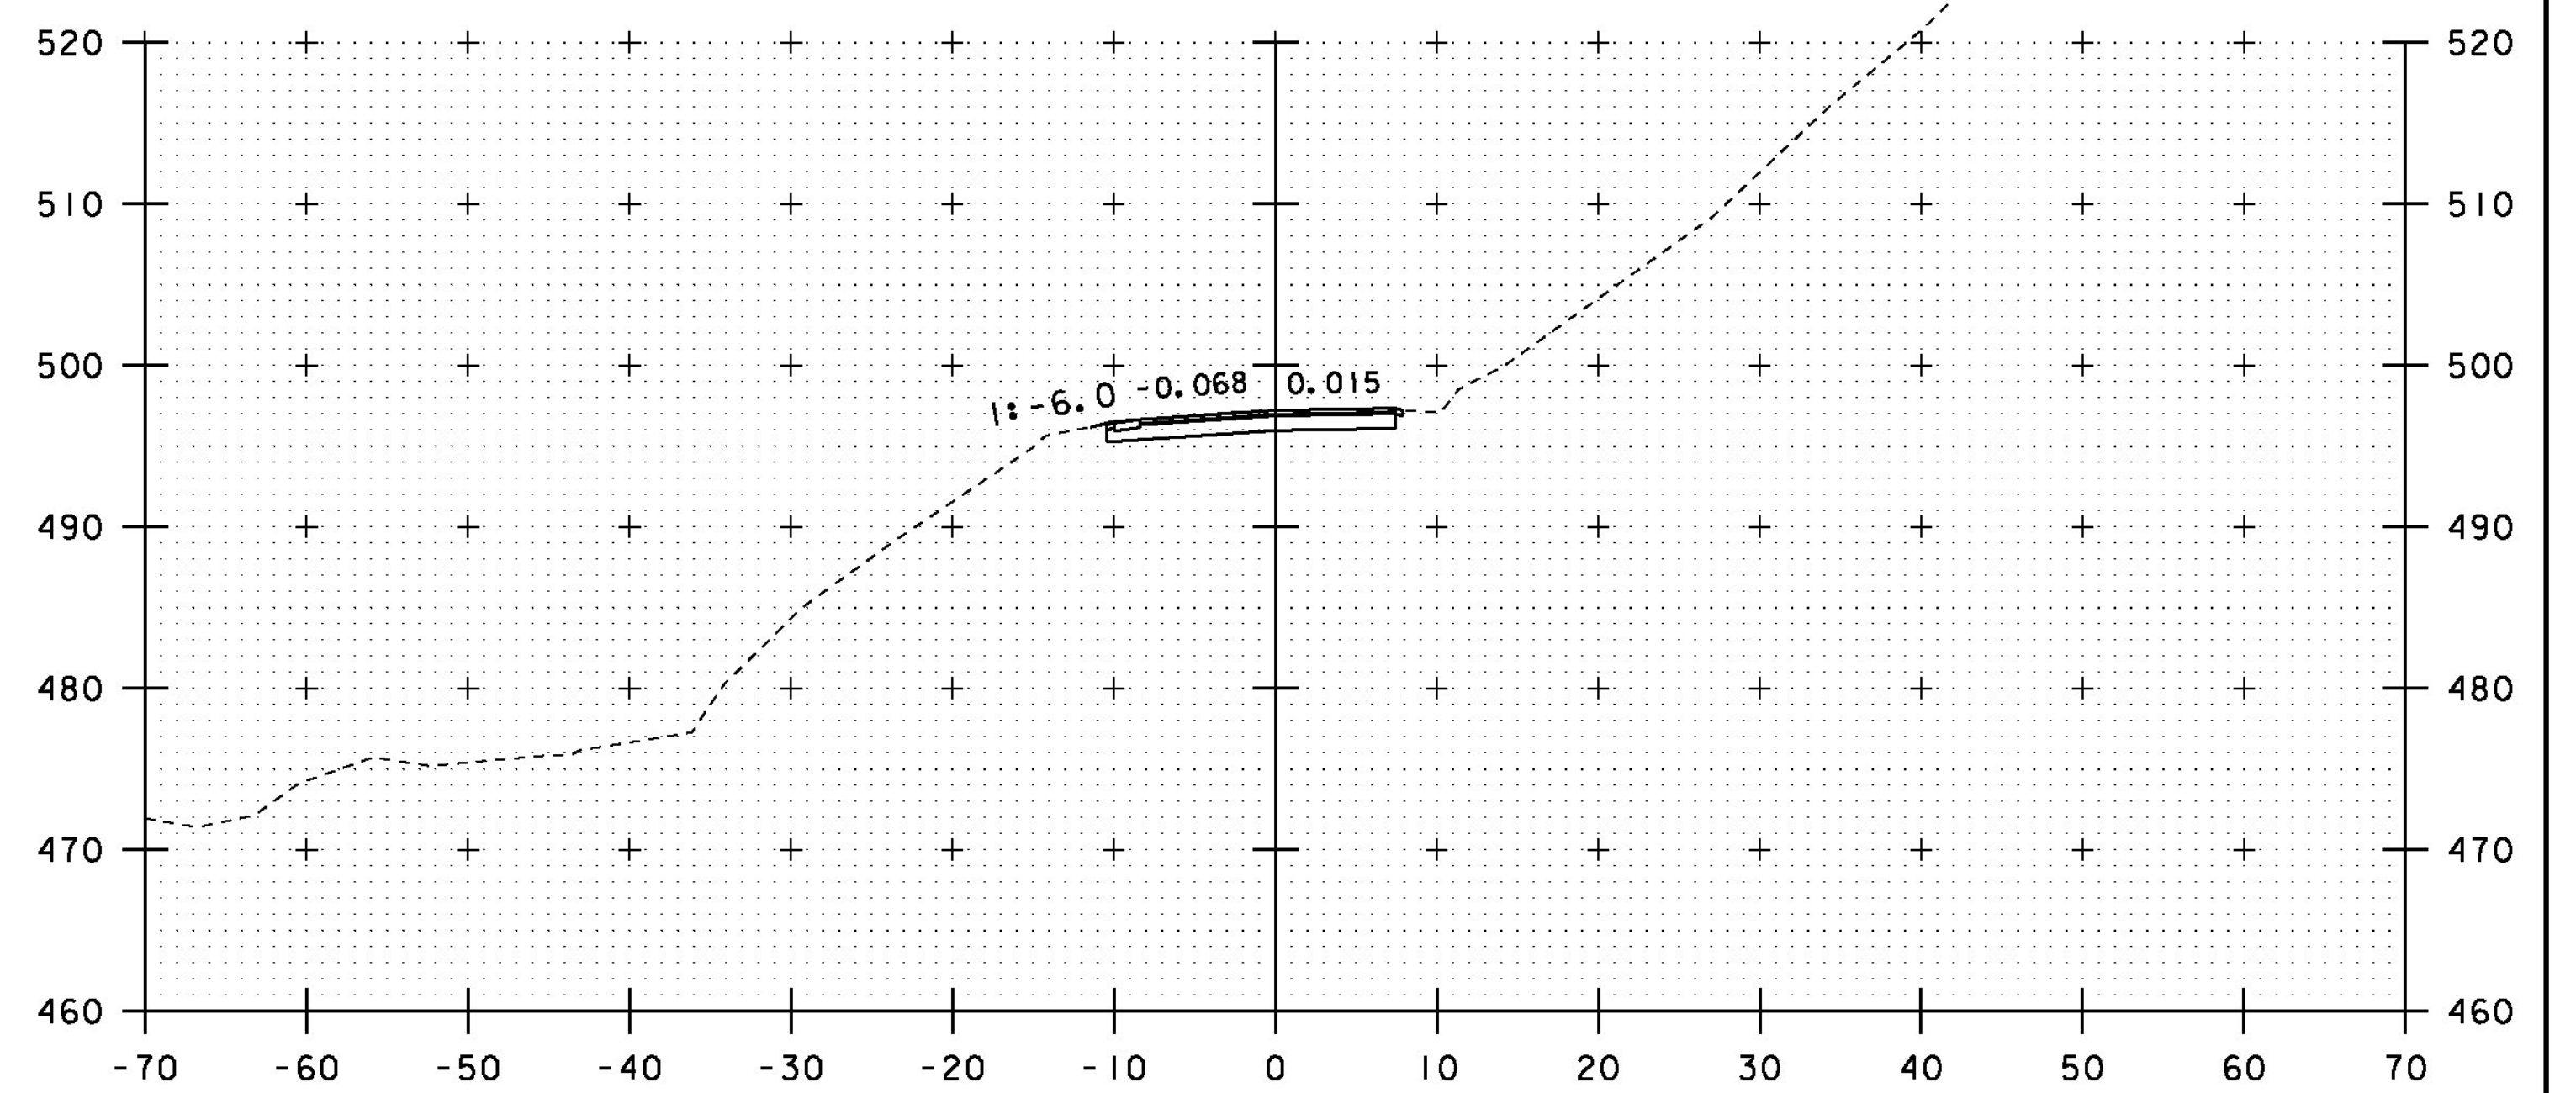

5+50

STA. 5+12 TO STA. 5+62

PROJECT NAME:	BRISTOL	PLOT DATE:	04-JUN-2013
PROJECT NUMBER:	BRO 1445(32)	DRAWN BY:	R. PELLETT
FILE NAME:	s05j352xs2.dgn	CHECKED BY:	T. FILLBACH
PROJECT LEADER:	J. LACROIX	SHEET	54 OF 66
DESIGNED BY:	G. LAROCHE		
PUMPHOUSE SECTIONS #2			