


**SOUTH ST (TH 5)
MATERIAL TRANSITION**
HOR. SCALE 1" = 20' -0"
NO VERT. SCALE

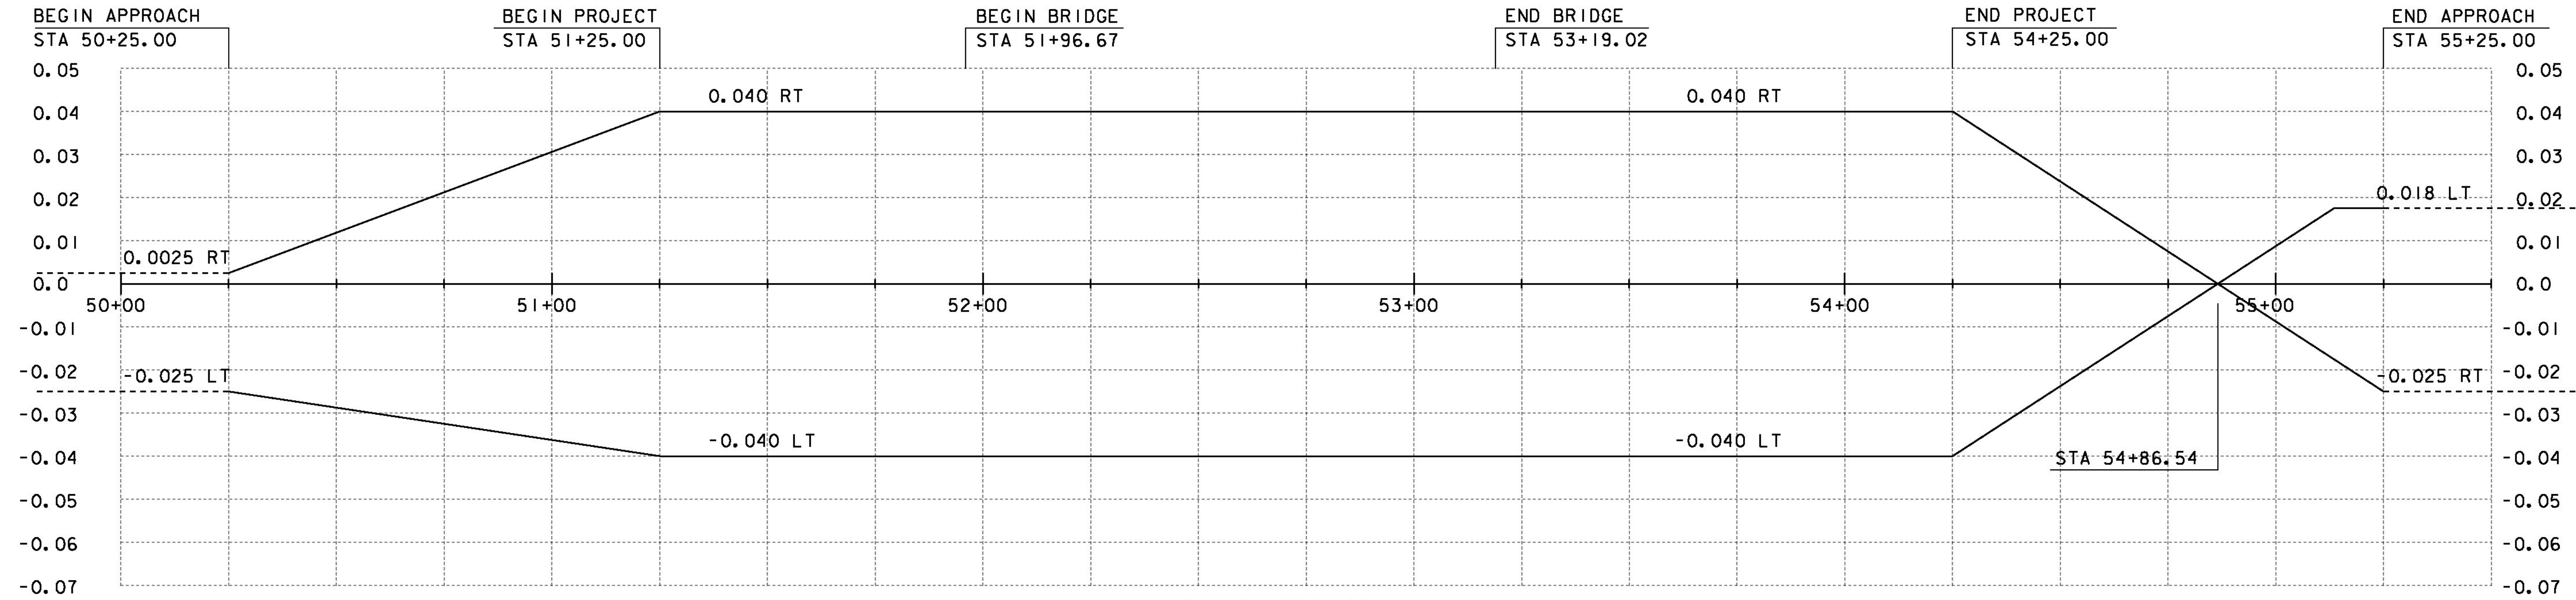

**SOUTH ST (TH 5)
BANKING DIAGRAM**
HOR. SCALE 1" = 20' -0"
NO VERT. SCALE

PROJECT NAME:	BRISTOL
PROJECT NUMBER:	BRO 1445(32)
FILE NAME:	s05j352pro.dgn
PROJECT LEADER:	J. LACROIX
DESIGNED BY:	G. LAROCHE
MATERIAL TRANSITION & BANKING DIAGRAM #1 SHEET	55 OF 66
PLOT DATE:	04-JUN-2013
DRAWN BY:	R. PELLET
CHECKED BY:	T. FILLBACH