




11+20

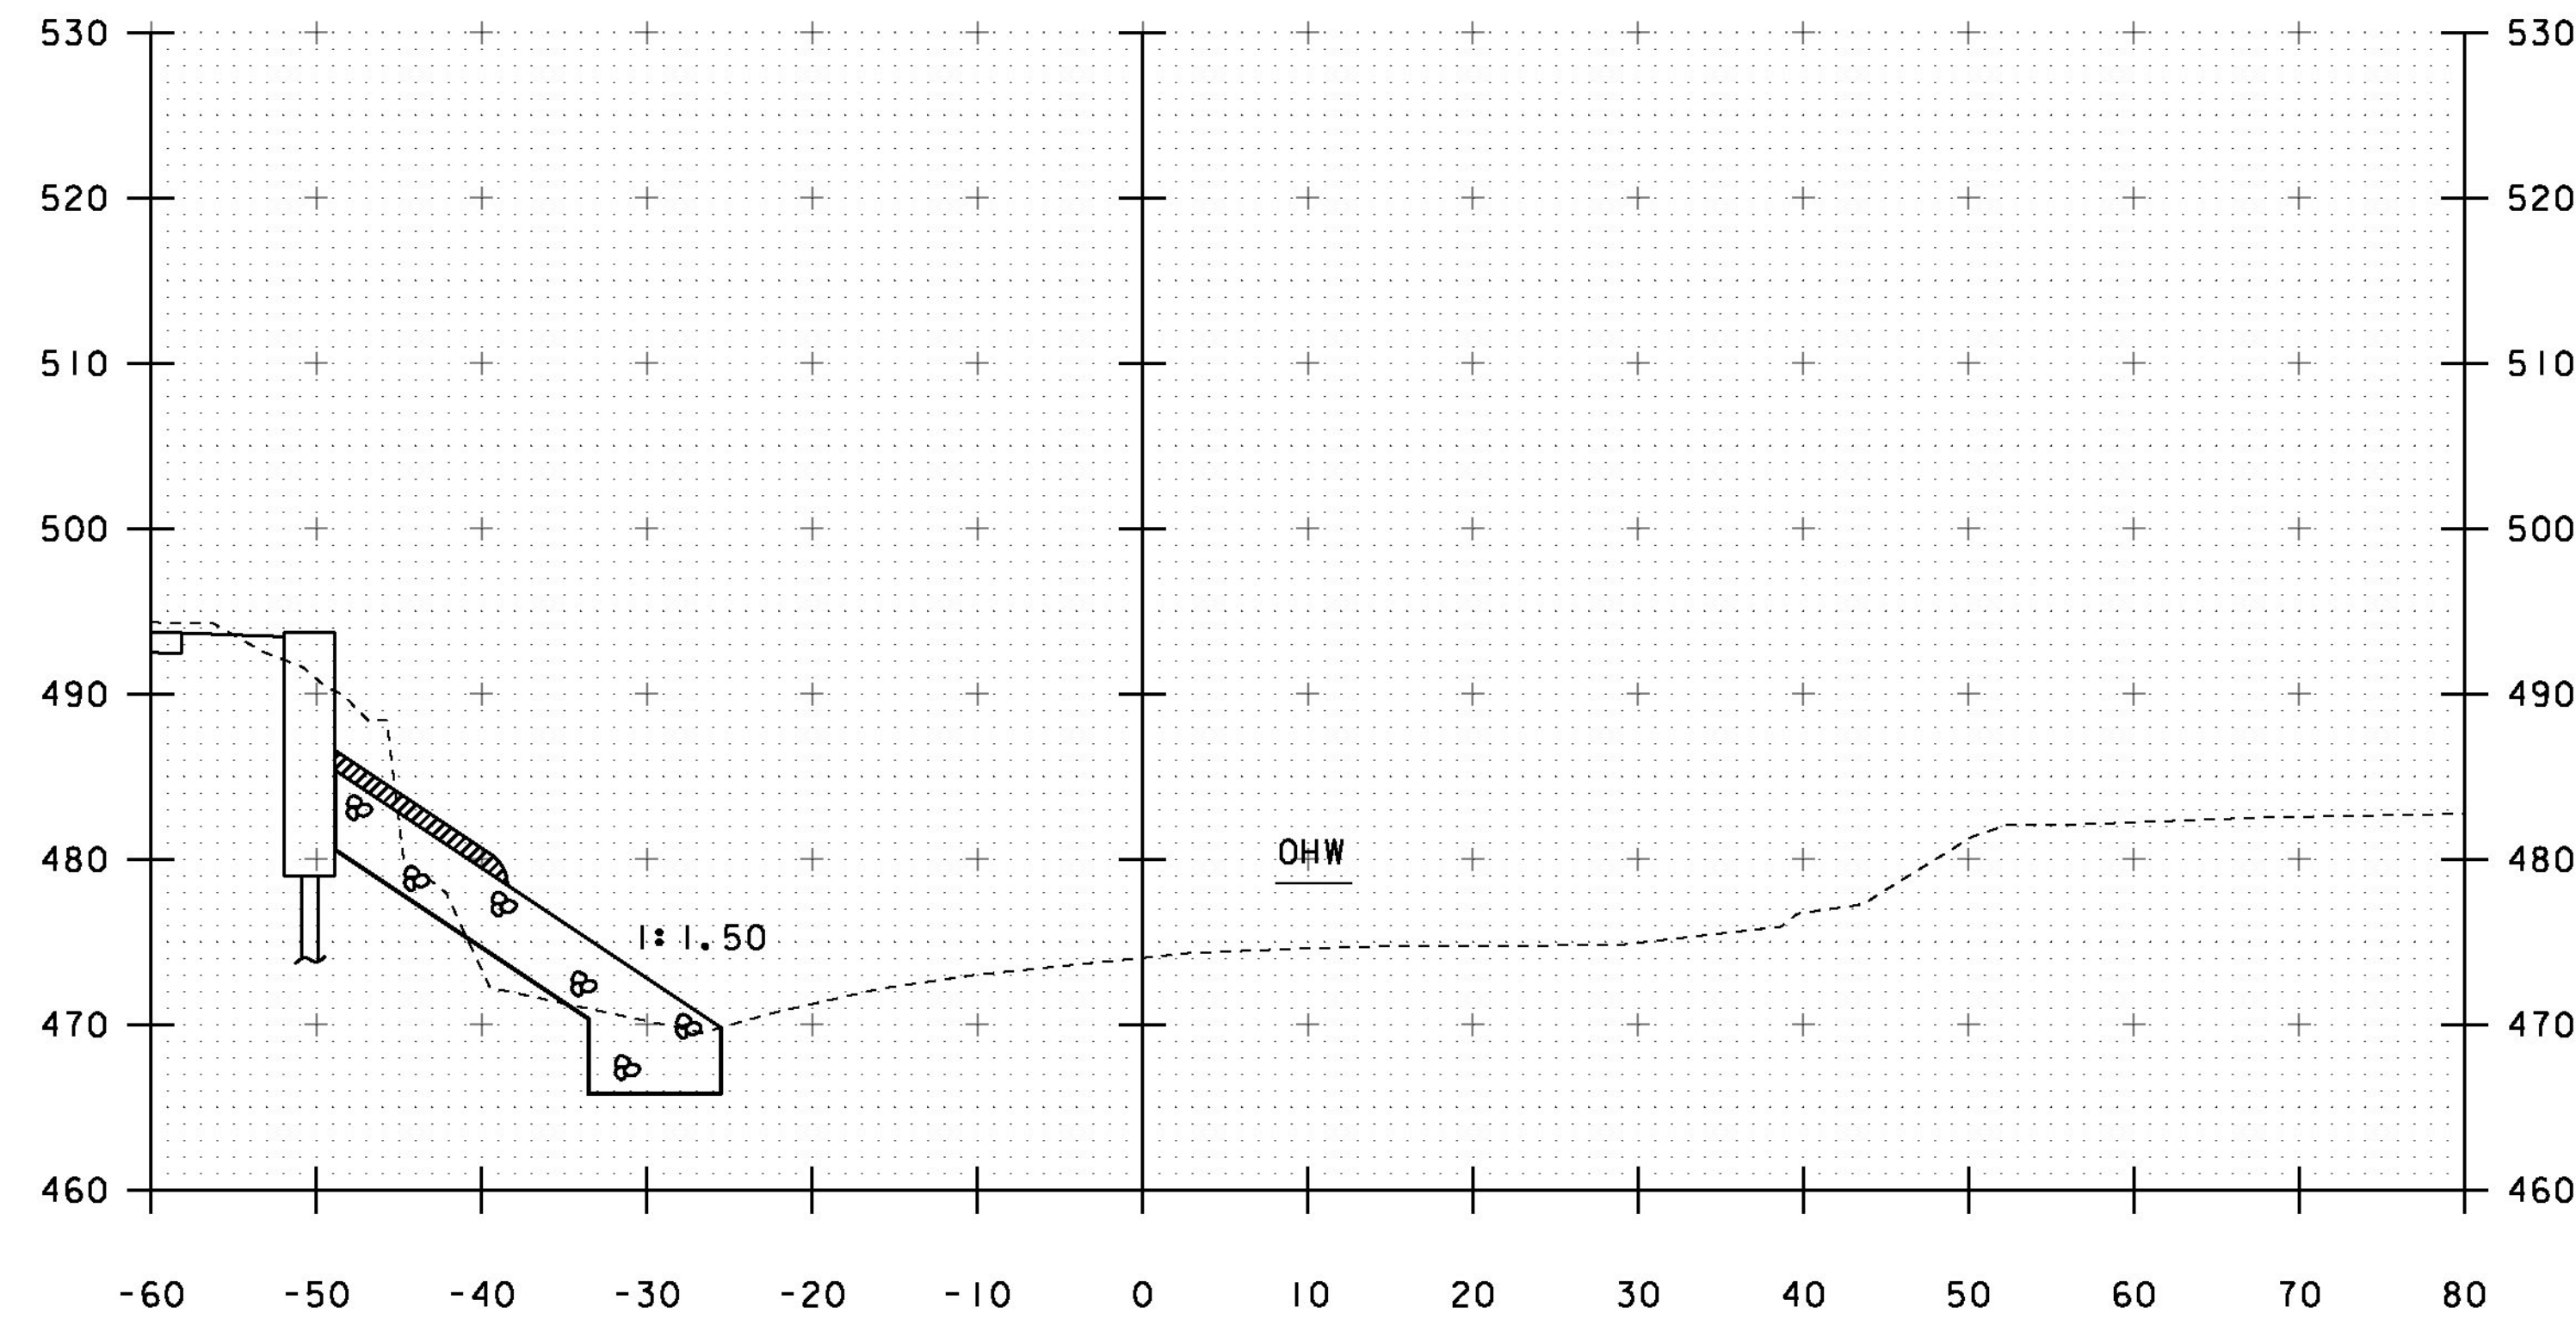

11+40

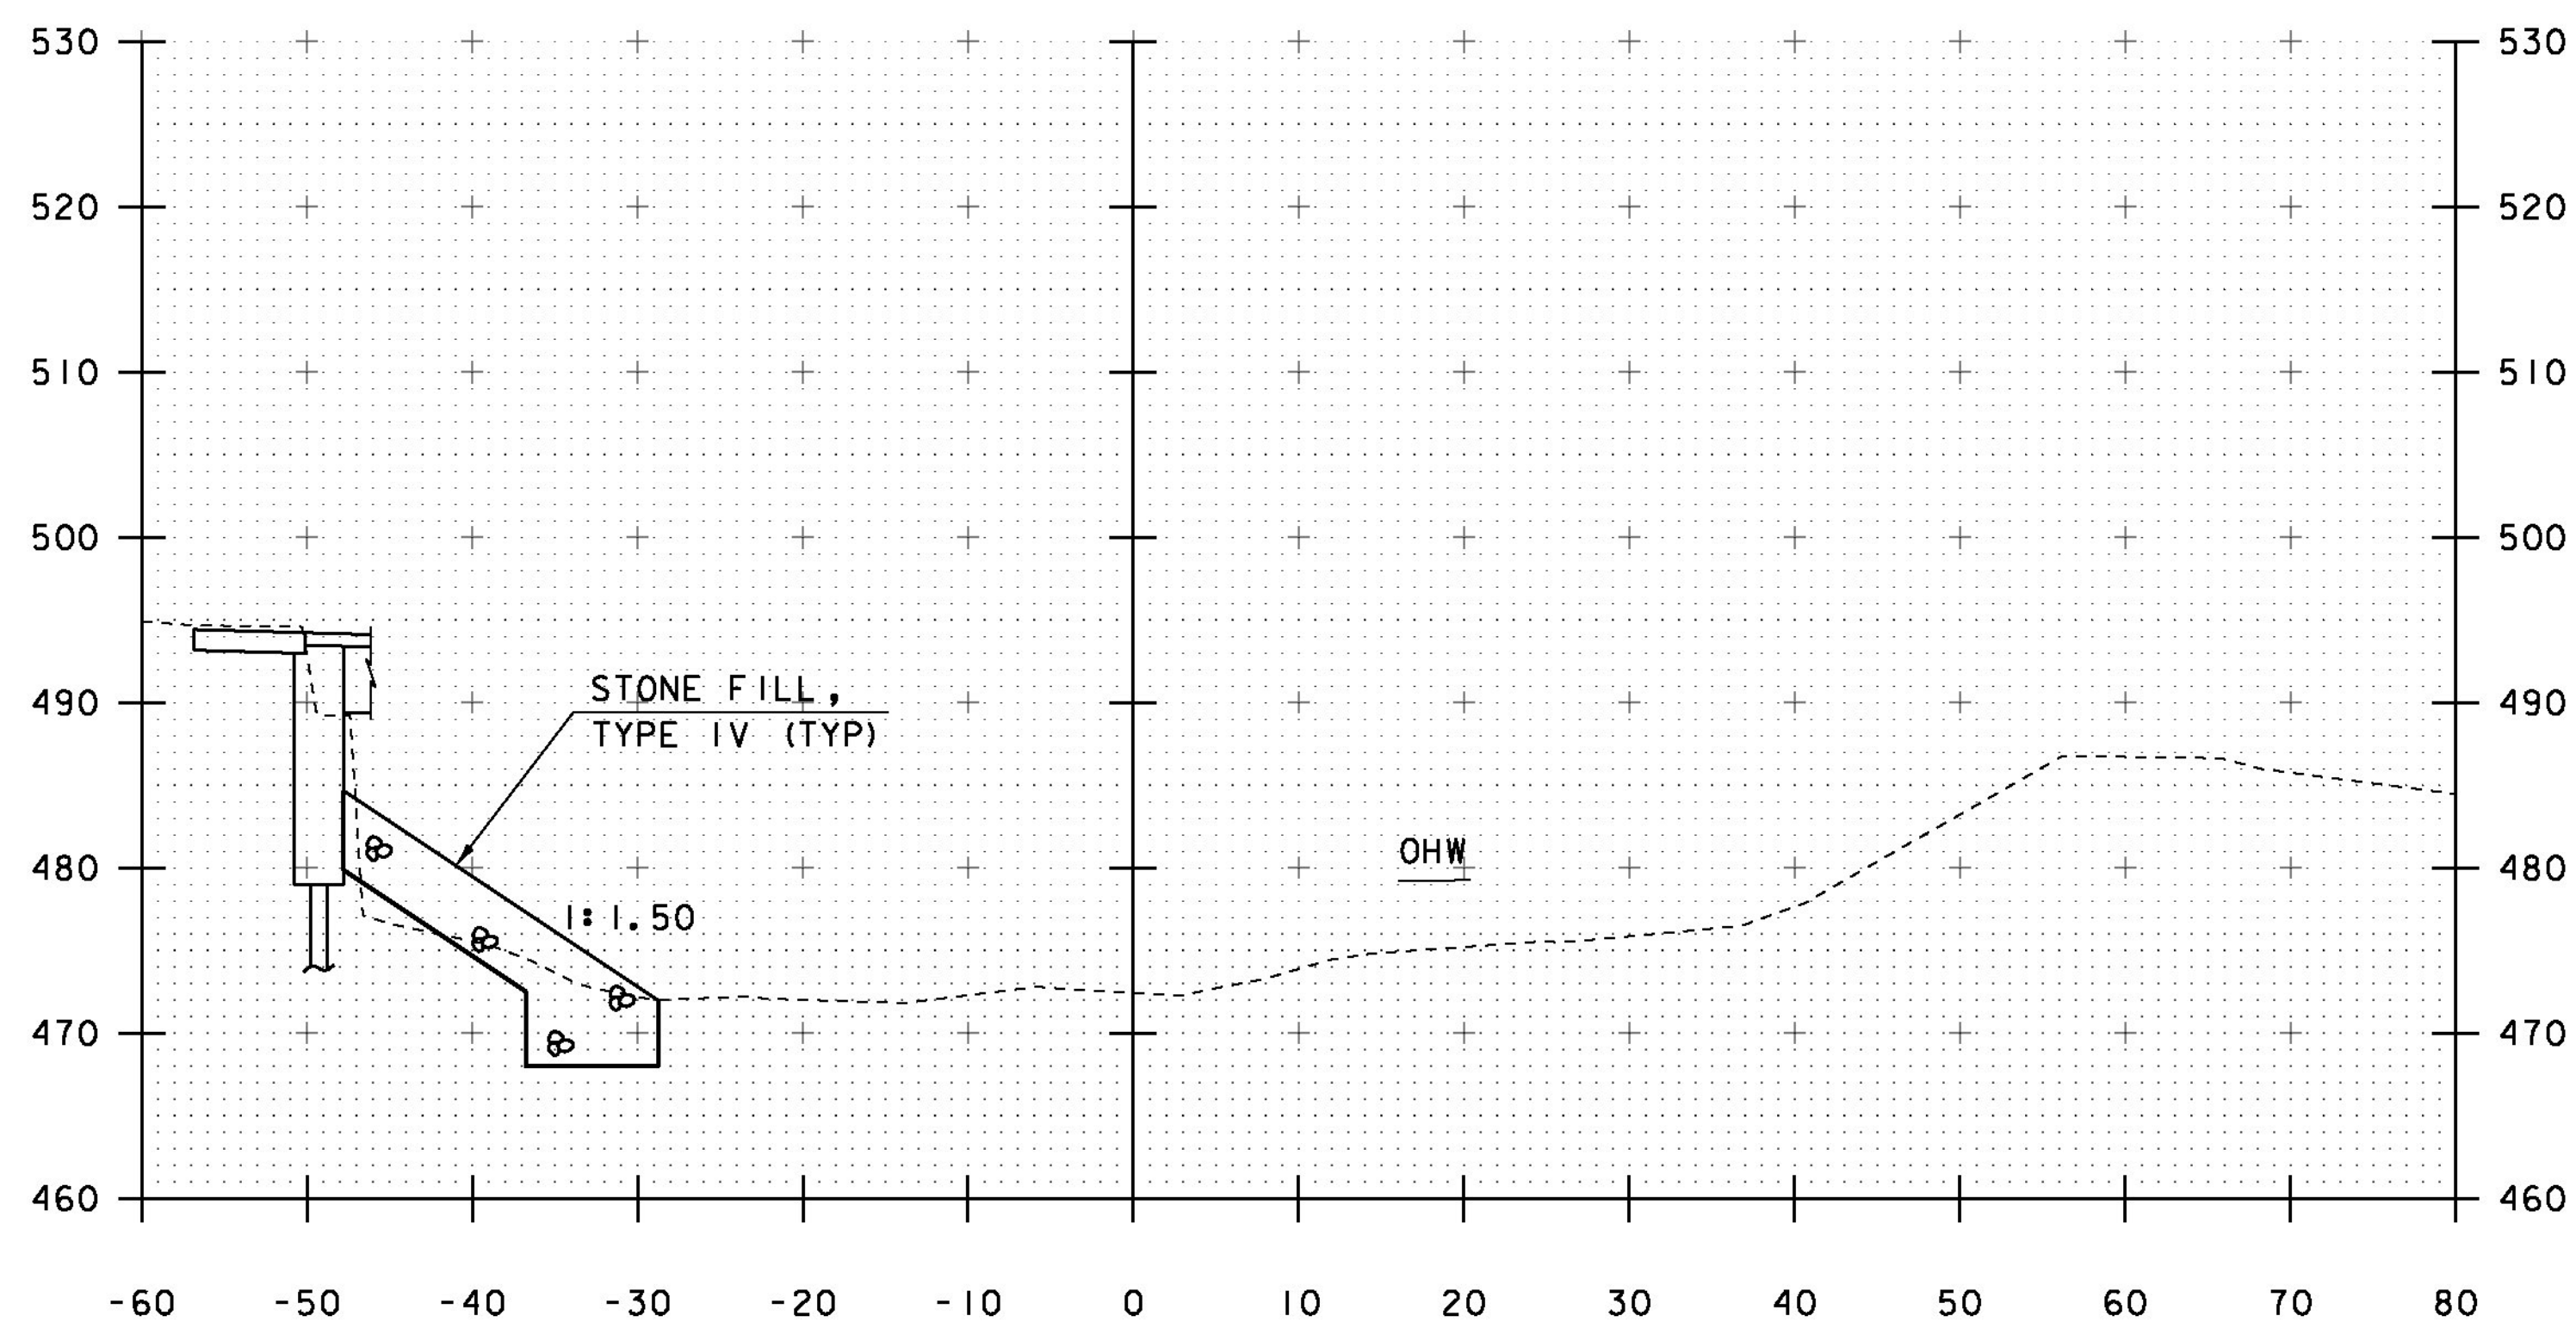

11+10

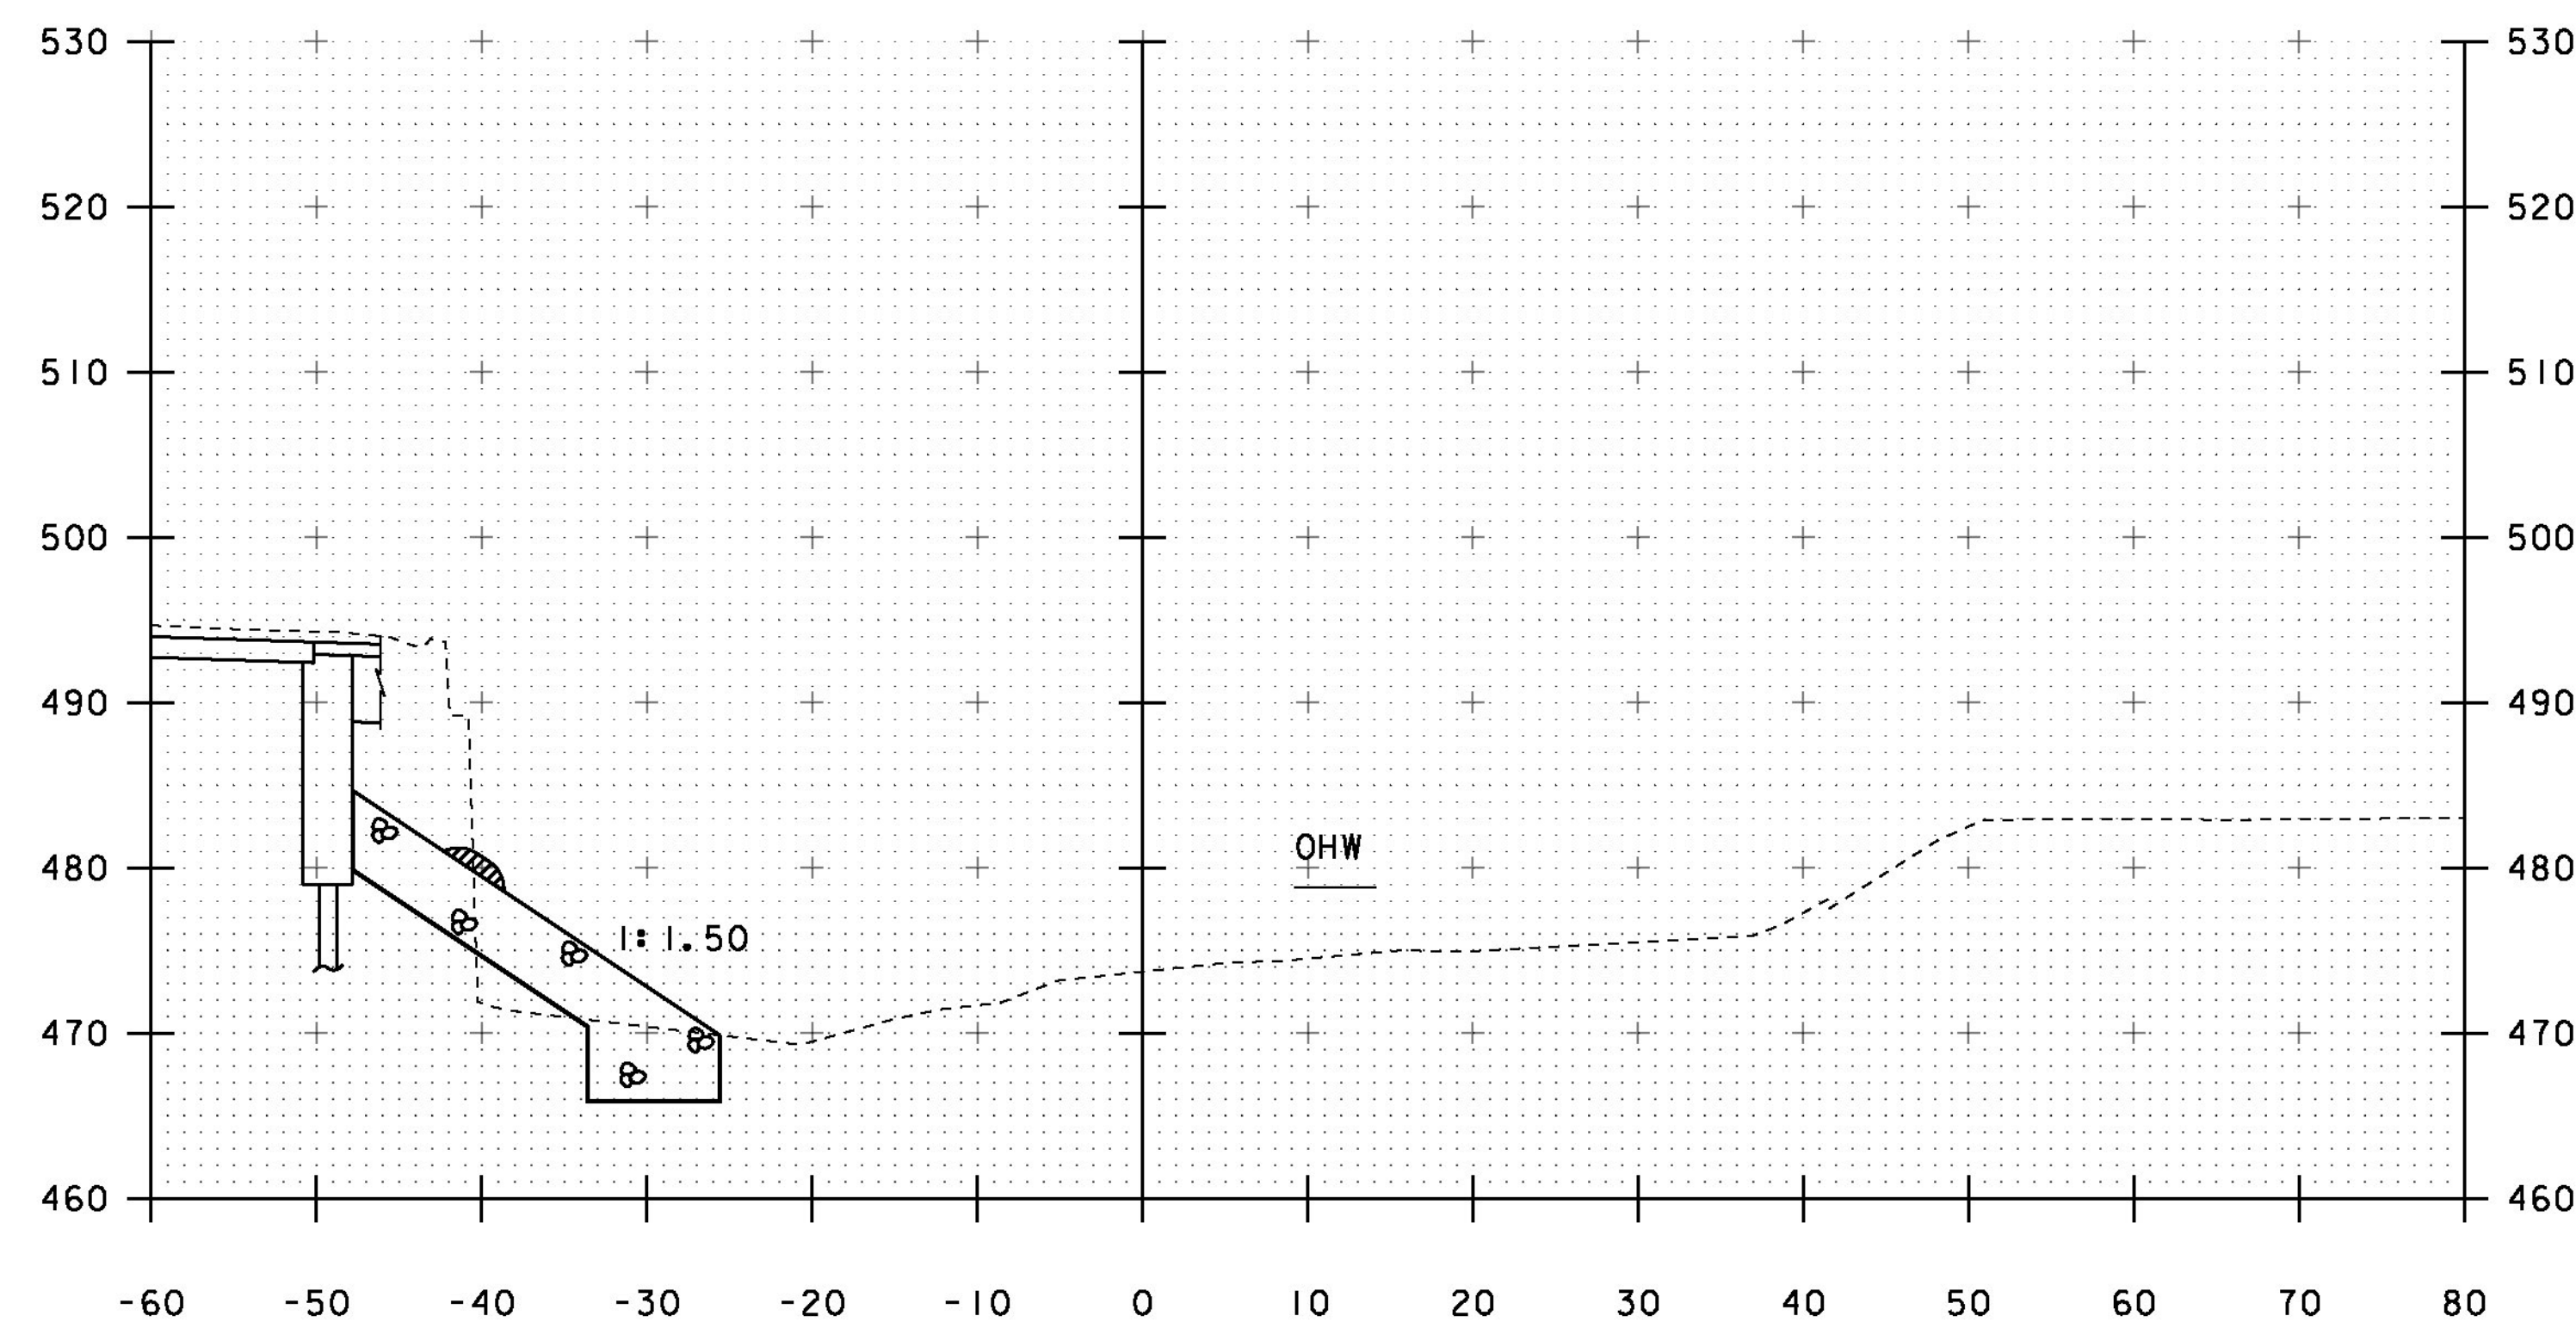

11+30

STA 11+09 RT. (ABUT #2)  
 END UNCLASSIFIED CHANNEL EXCAVATION  
 END STONE FILL, TYPE IV  
 END GEOTEXTILE UNDER STONE FILL  
 END GRUBBING MATERIAL

LT. (ABUT #1)  
 BEGIN GRUBBING MATERIAL 11+23 LT.

STA. 11+10 TO STA. 11+40

PROJECT NAME: BRISTOL  
 PROJECT NUMBER: BRO 1445(32)

FILE NAME: s05j352xs2.dgn  
 PROJECT LEADER: J. LACROIX  
 DESIGNED BY: G. LAROCHE  
 CHANNEL SECTIONS \*3

PLOT DATE: 04-JUN-2013  
 DRAWN BY: R. PELLET  
 CHECKED BY: T. FILLBACH  
 SHEET 59 OF 66