



DWG NO 355 SH 1 REV 0

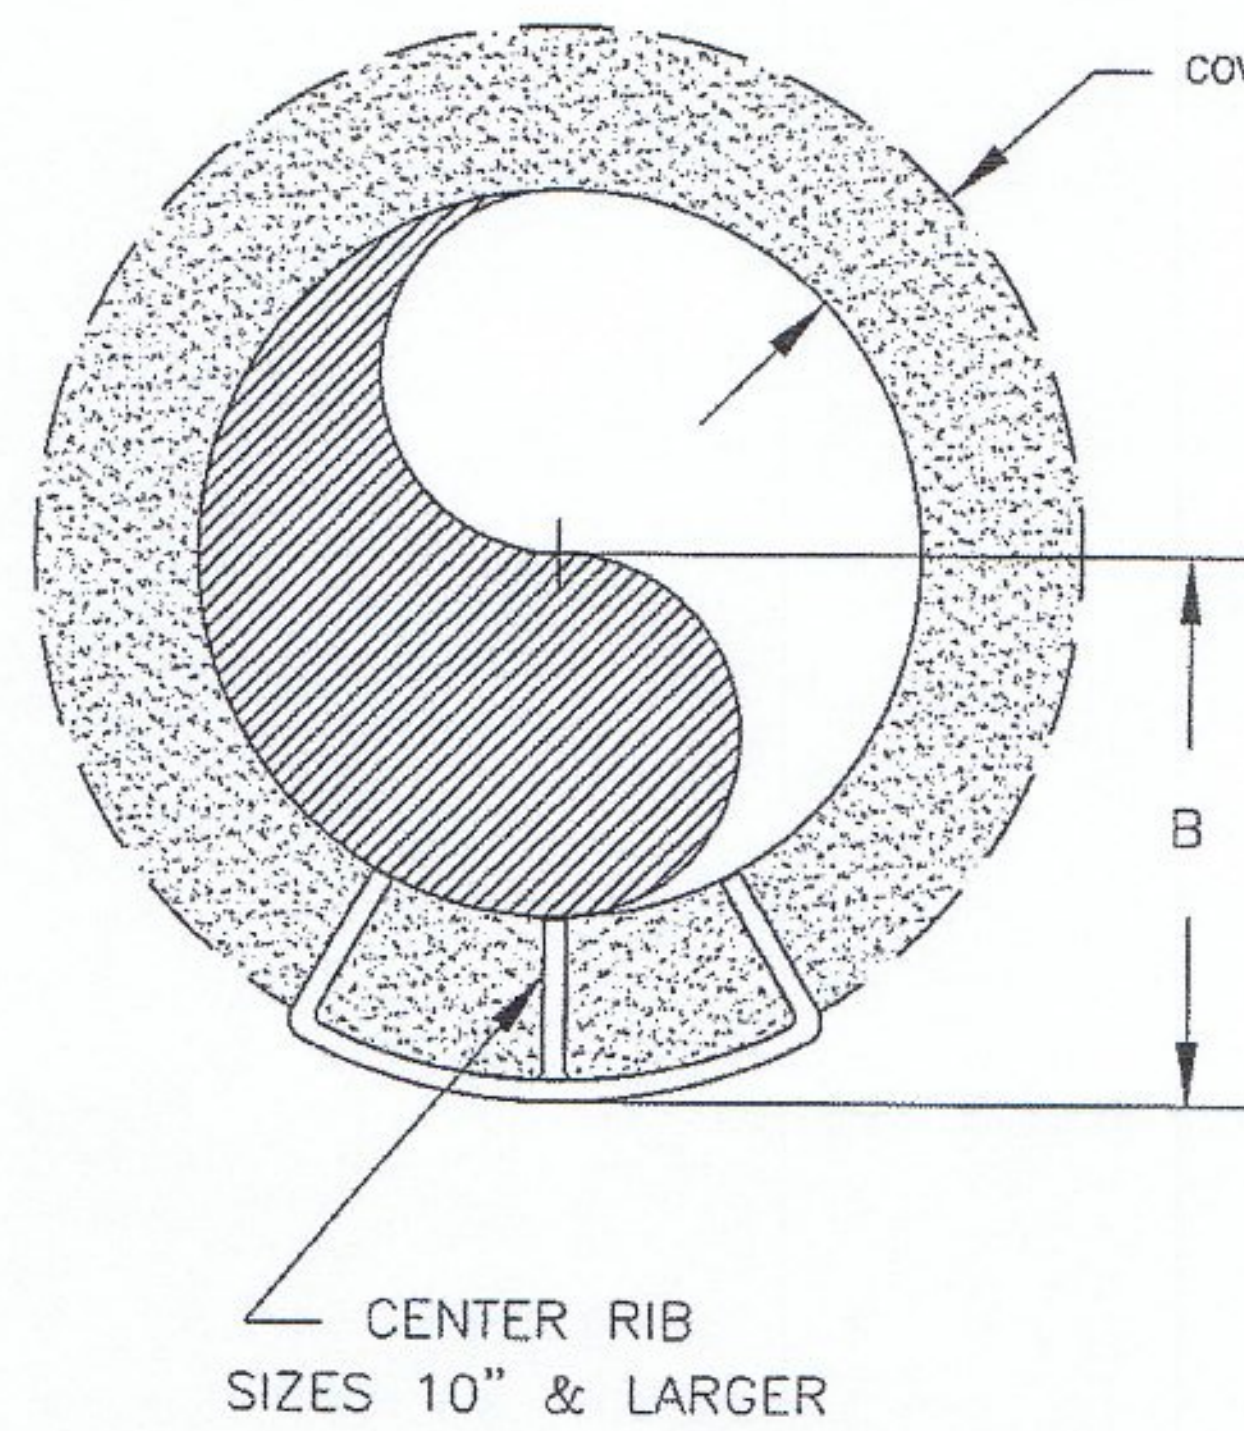

Vermont Agency of Transportation
RECEIVED
 CK'D BY J. LaCroix OK'D BY _____
 November 11, 2013
 RESUBMIT No Approved
 BY J. LaCroix DATE 11/15/2013

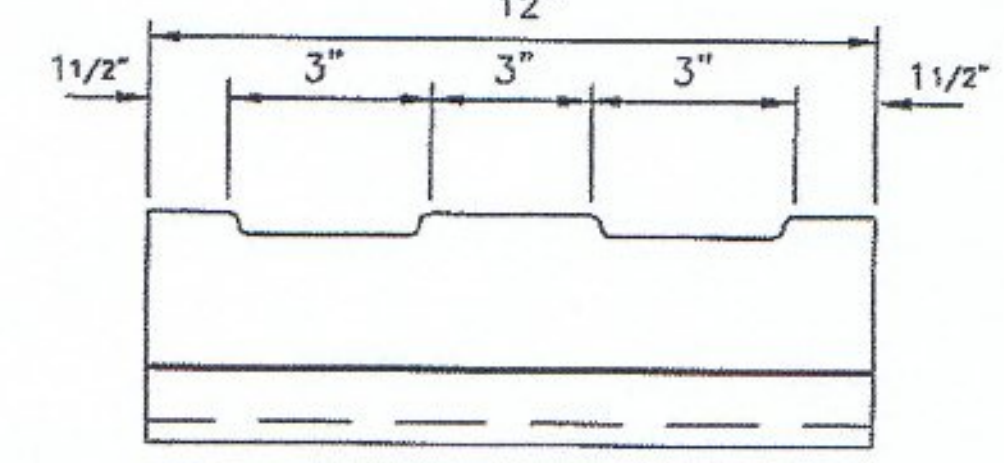

CENTER RIB
 SIZES 10" & LARGER

PIPE SIZE	B	SIZE OF PIPE ROLL				MAX LOAD	UNIT WGT
		FIG. No		FIG. No			
		140	142	17	53		
2	4 5/8	7	7	2	2	1800	4.50
2 1/2	4 7/8	8	7	2	2	1800	4.50
3	5 1/8	10	8	2	2	1800	4.90
3 1/2	5 3/8	10	8	2	2	1800	4.90
4	5 3/4	10	10	2	2	1800	4.90
5	6 1/4	12	10	2	2	1800	4.90
6	6 1/2	12	12	2	2	1800	7.70
8	7	16	12	3	3	1800	7.70
10	8 5/8	16	16	4	4	1800	8.80
12	9 5/8	18	18	4	4	5000	11.40
14	10 3/8	18	18	4	4	5000	11.40
16	11 1/4	24	24	5	5	7200	13.30
18	12 1/4	24	24	5	5	7200	13.30
20	13 1/4	24	24	6	6	7200	13.40
24	15 1/4	30	30	6	6	7200	20.30

LOAD (LBS) · DIMENSIONS (INCHES) · WEIGHT (LBS)

CARPENTER AND PATERSON INC
 WOBURN, MA 01801 / SADDLE BROOK, NJ 07662

SUBMITTAL DRAWING

MATERIAL: CARBON STEEL
 FINISH: HOT DIPPED GALV. PLAIN

DESCRIPTION: PIPE COVERING PROTECTION SADDLE

REV	DATE	DRAWN	CHKD.	APPVD.	DATE	SCALE	SHEET
2		BM	RP	UB	2/94	N/A	1

DWG/FIGURE NO. 355 REV 0

ANVIL 164 EQUIV.