



RECEIVED

CK'D BY J. LaCroix OK'D BY

November 11, 2013

RESUBMIT No Approved

BY J. LaCroix DATE 11/15/2013

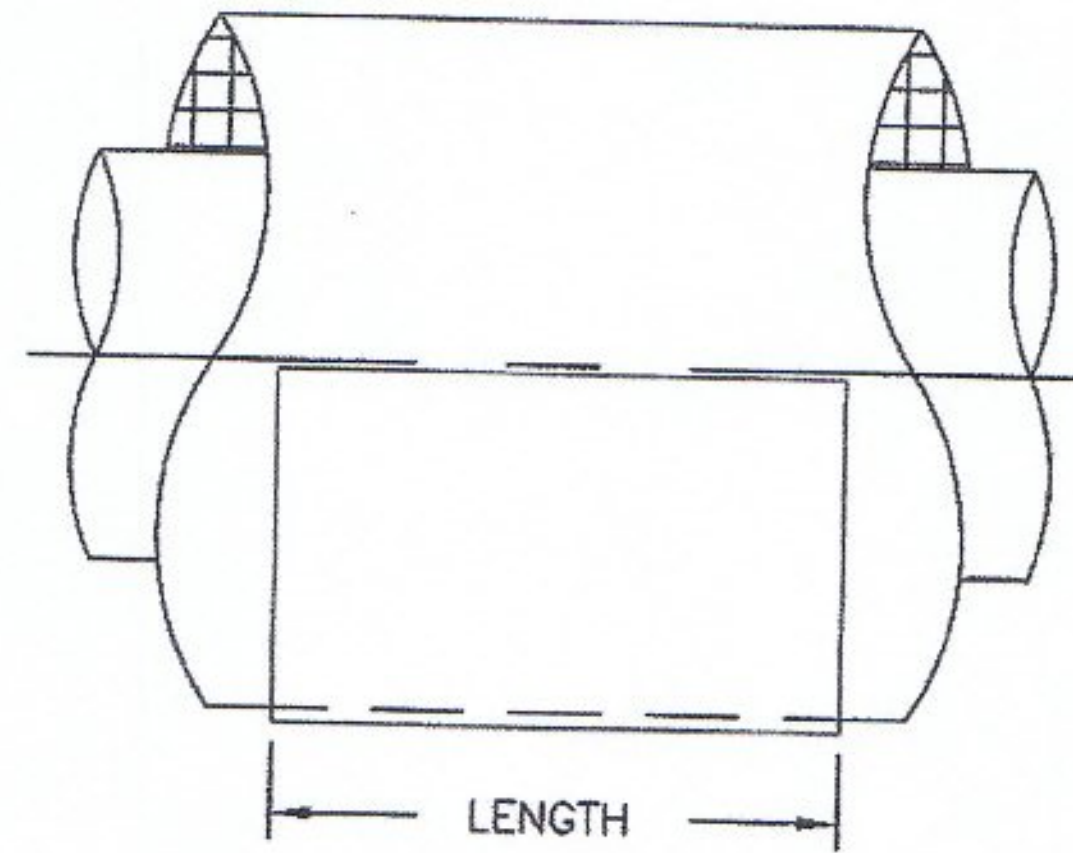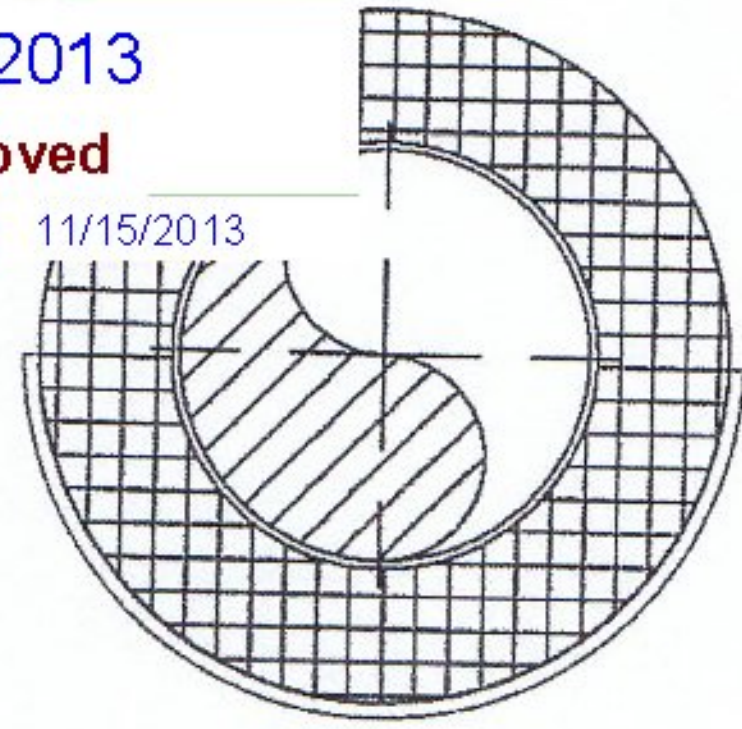

SHIELD TO BE CUSTOM SIZED TO 15" 9.05" O.D + 6" INSULATION

SIZE (I.D.)	HANGER SIZE	LENGTH	GA.	UNIT WGT
2.375	2	12	18	0.70
2.875	2 1/2	12	18	0.80
3.500	3	12	18	1.00
4.000	3 1/2	12	18	1.10
4.500	4	12	18	1.30
5.000	5	12	18	1.40
5.563	5	12	18	1.60
6.000	6	12	18	1.90
6.625	6	12	18	1.90
7.000	7	12	18	2.70
7.625	7	12	18	4.00
8.625	8	12	18	4.30
9.625	10	12	18	5.10
10.750	10	12	18	5.60
11.750	12	12	18	10.20
12.750	12	12	18	11.10
14.000	14	12	16	11.90
15.000	16	12	16	12.70
16.000	16	12	16	13.60
17.000	18	12	16	14.50
18.000	18	12	16	21.20
19.000	20	12	16	22.40
21.000	24	12	16	23.60

LOAD (LBS) • DIMENSIONS (INCHES) • WEIGHT (LBS)

CARPENTER AND PATERSON INC
WOBURN, MA 01801 / SADDLE BROOK, NJ 07663

SUBMITTAL DRAWING

MATERIAL: CARBON STEEL
FINISH: PRE-GALV.

DESCRIPTION: INSULATION SHIELD

DRAWN: BM
CHKD: RP
APPVD: UB
DATE: 12/93
SCALE: N/A
SHEET: 1

DWG/FIGURE NO. 265P
REV 0

REV	DATE	DESCRIPTION	APP
6			
5			
4			
3			
2			
1			