


PLAN VIEW OF ASSEMBLY
 ABUT 1 TO ABUT 2 - LINES 2 & 3

		LINE 2				LINE 3			
		POINT	OFFSET	ALONG BL	ELEV	POINT	OFFSET	ALONG BL	ELEV
ABUT 1		53	0	0	1'-4 ⁵ / ₁₆	52	8'-0	2'-10 ⁹ / ₁₆	1'-7 ¹¹ / ₁₆
		65	0	24'-4 ¹⁵ / ₁₆	1'-5 ¹³ / ₁₆	64	8'-0	27'-3 ⁷ / ₈	1'-9 ³ / ₁₆
		69	0	48'-4 ³ / ₄	1'-5 ¹¹ / ₁₆	68	8'-0	51'-3 ¹¹ / ₁₆	1'-9
		73	0	72'-1 ¹ / ₂	1'-2 ⁷ / ₁₆	72	8'-0	75'-0 ⁷ / ₁₆	1'-5 ⁸ / ₁₆
		77	0	96'-1 ⁵ / ₁₆	8 ¹ / ₈	76	8'-0	99'-0 ¹ / ₄	11 ⁷ / ₁₆
ABUT 2		57	0	120'-6 ¹ / ₄	0	56	8'-0	123'-5 ³ / ₁₆	3 ³ / ₈

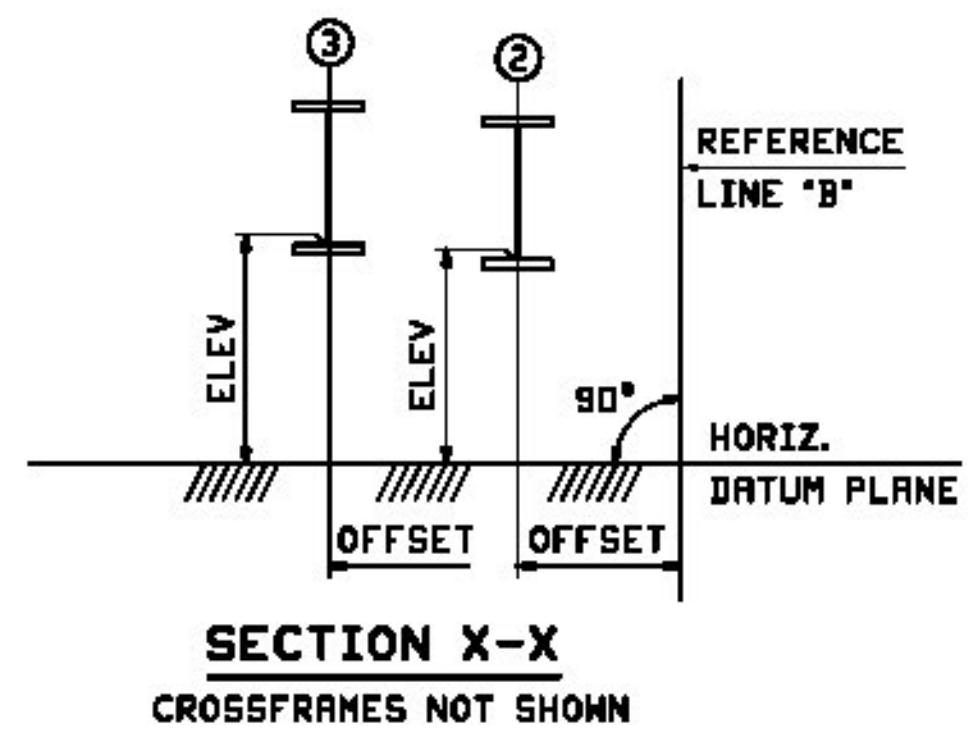

SECTION X-X
 CROSSFRAMES NOT SHOWN

- PLAN VIEW ASSEMBLY NOTES:**
1. FOR GENERAL NOTES SEE DRAWING GNL.
 2. ALL LONGITUDINAL EXTENSION DIMENSIONS (ALONG BL) ARE GIVEN FROM REFERENCE LINE "A".
 3. ALL TRANSVERSE EXTENSION DIMENSIONS (OFFSET) ARE GIVEN FROM REFERENCE LINE "B".
 4. ALL ELEVATIONS (ELEV) ARE GIVEN TO THE BOTTOM OF WEB TO A HORIZONTAL DATUM PLANE.

Approved Revise and Resubmit
 Approved as Noted (Permit by record) Rejected (Per Revising + 1st)

Hoyle, Tanner & Associates, Inc. Project No. 824226

Approval is only for general conformance with the design concept to the Project and the information given in the Contract Documents. Contractor is responsible for all dimensions to be confirmed and corrected at the job site. Information that pertains solely to the fabrication process or to the nature and methods of construction construction of the work of art, and other details of work in a site and substructure. This approval does not modify Contractor's duty of compliance with contract.

Reviewed By: AAS Date: 11/2/13
 Approved By: JAC Date: 11/2/13

REV.	DATE	REMARKS	DWN	CHK	APVL	SHOP
0						
MATERIAL:		SURFACE PREP. & PAINT:		HOLES:		SHOP BOLTS:
DESCRIPTION: SHOP ASSEMBLY						
CASCO BAY STEEL STRUCTURES, INC. 1 WALLACE AVE. PHONE (207) 780-6722 SOUTH PORTLAND, ME 04106 FAX. (207) 780-6726						
STRUCTURE: BRISTOL - BRIDGE NO. 31 VT ROUTE NO. TH 5 (SOUTH STREET) OVER NEW HAVEN RIVER				DRAWN: JTB	DATE: 10/19	
				CHKD: DBH	DATE: 10/21	
LOCATION: TOWN OF BRISTOL, VT (ADDISON COUNTY)				JOB NO.		DWG NO.
PROJ NO. BRO 1445 (32)				534		SA1
CUSTOMER: BLOM AND COTE						REV. <input type="checkbox"/>