
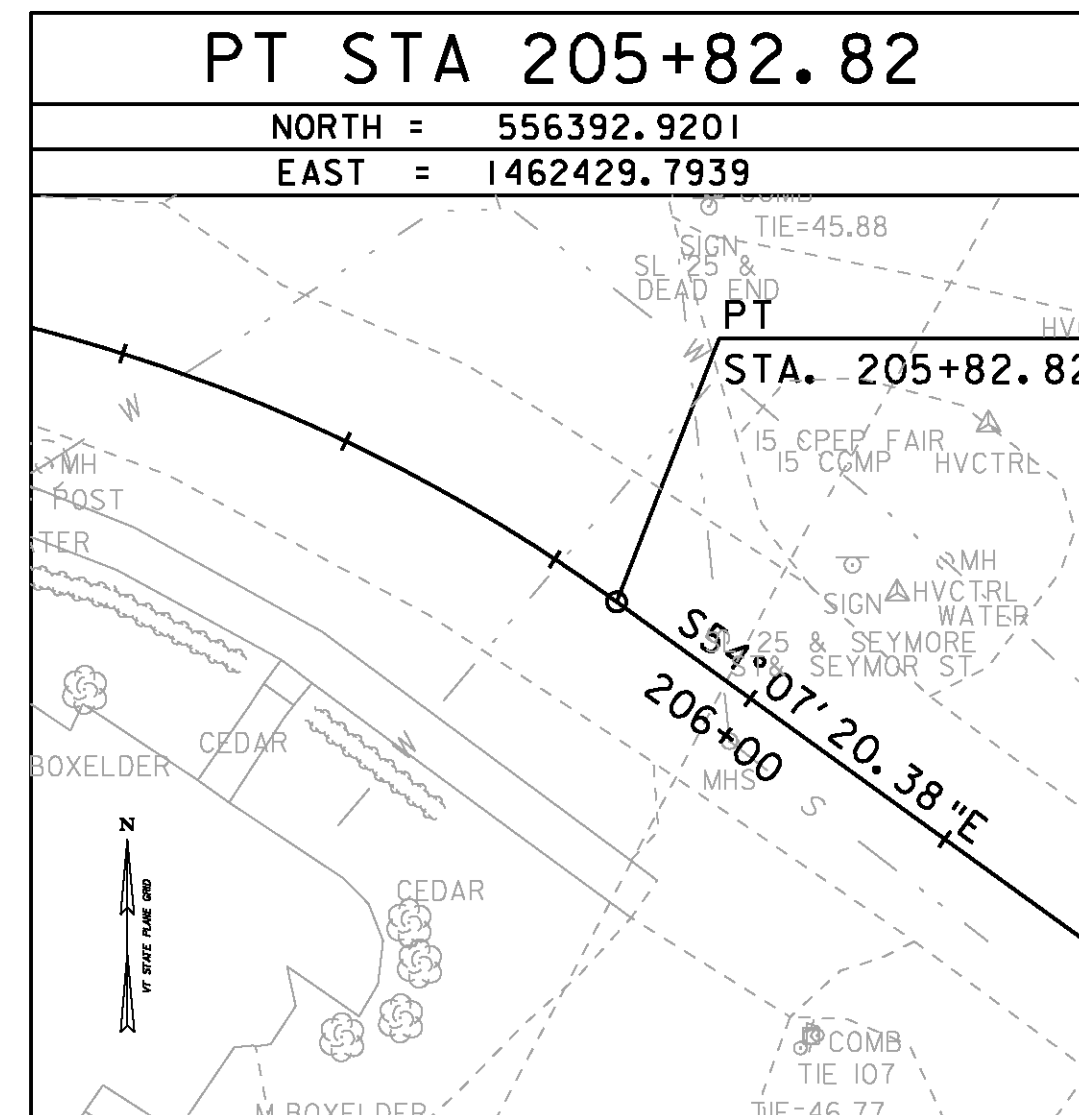
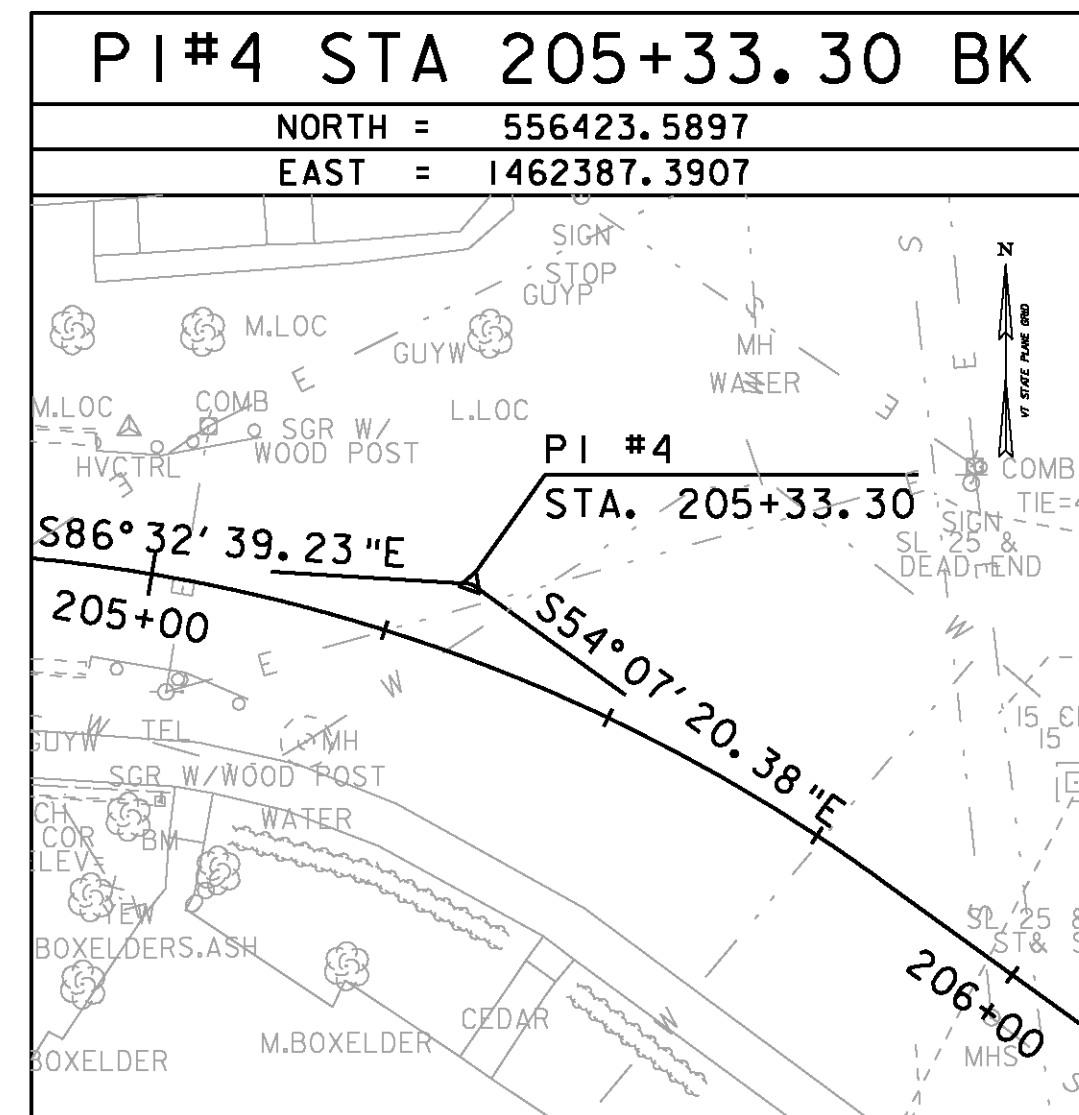
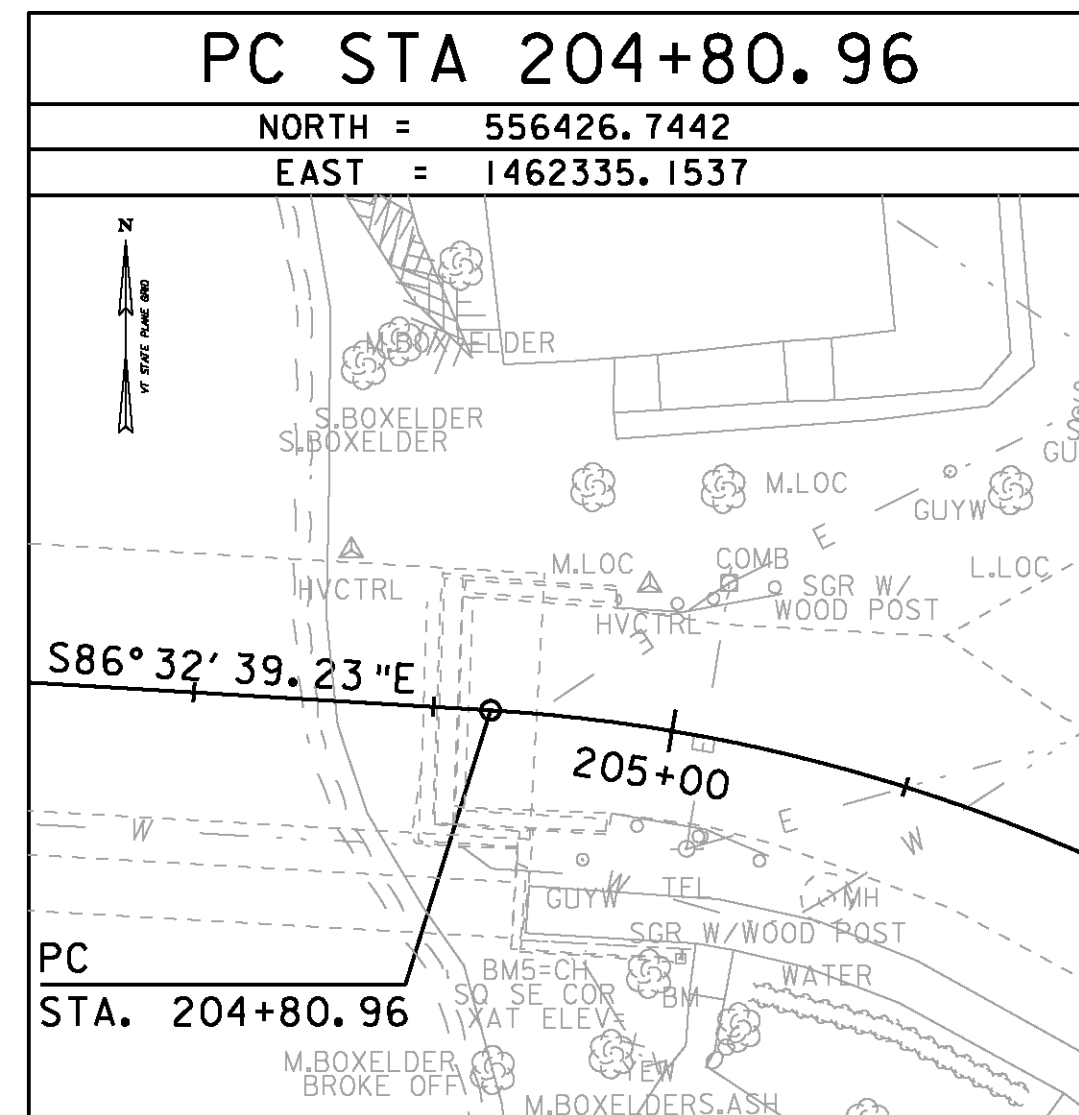
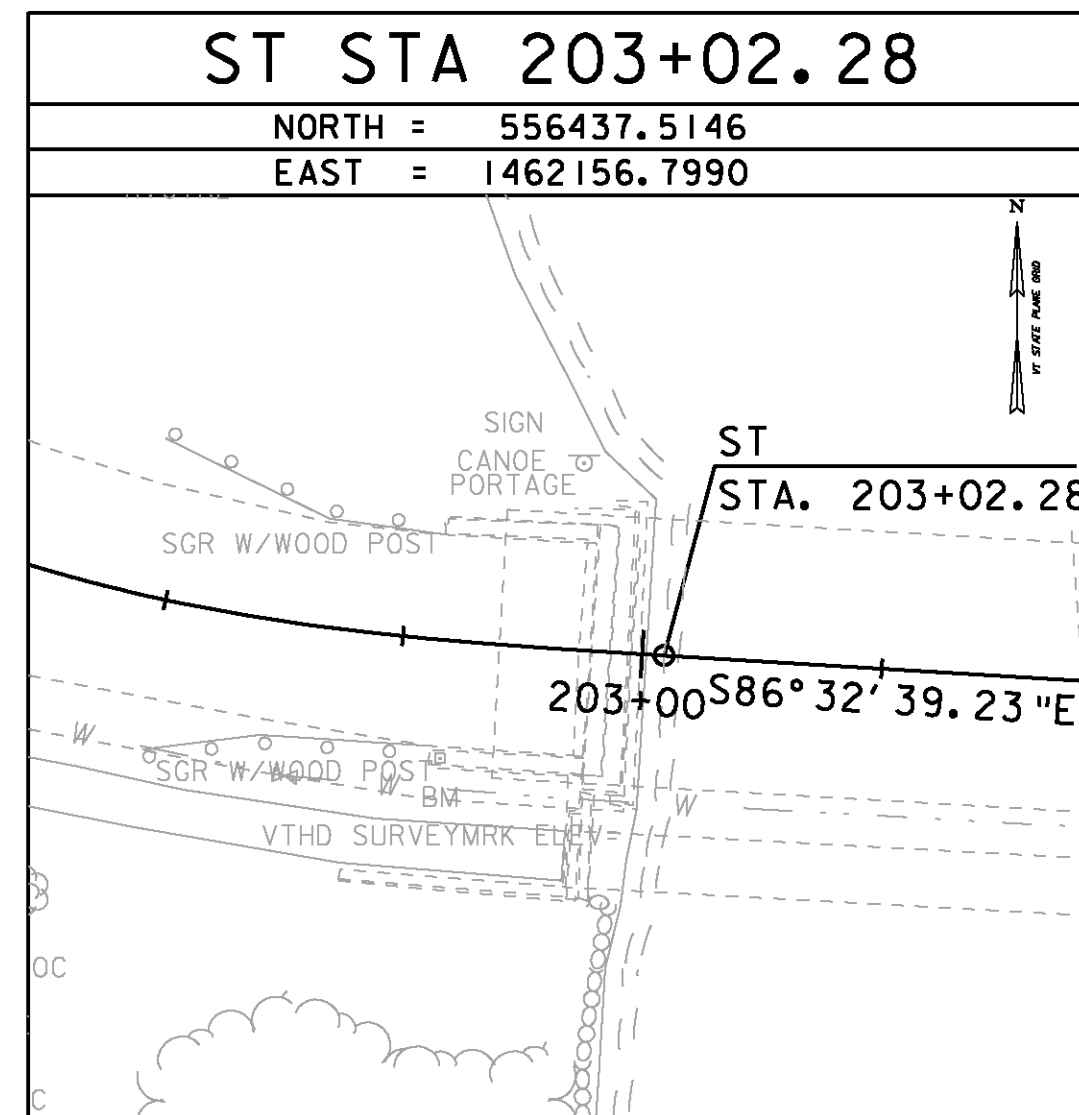
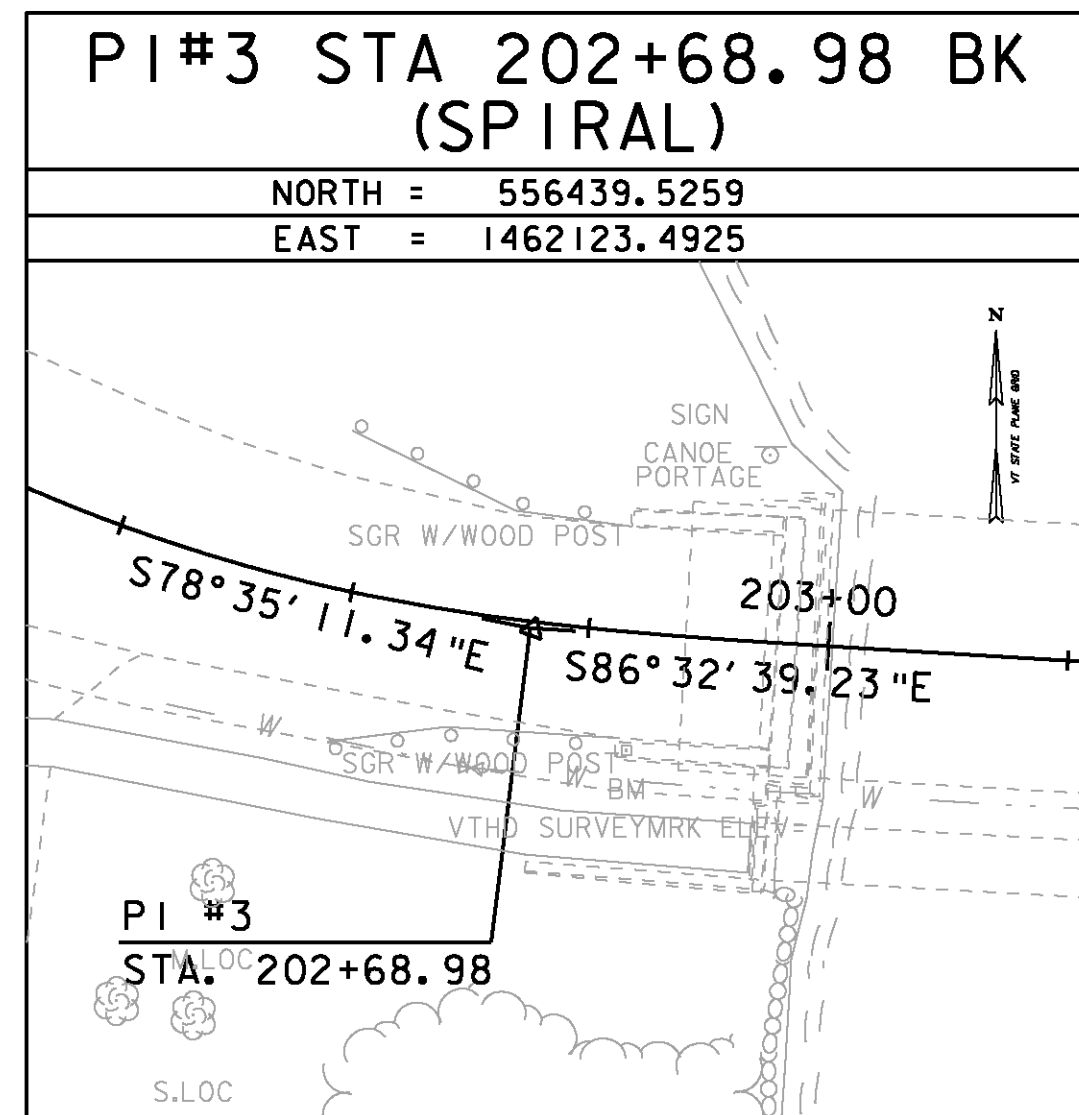
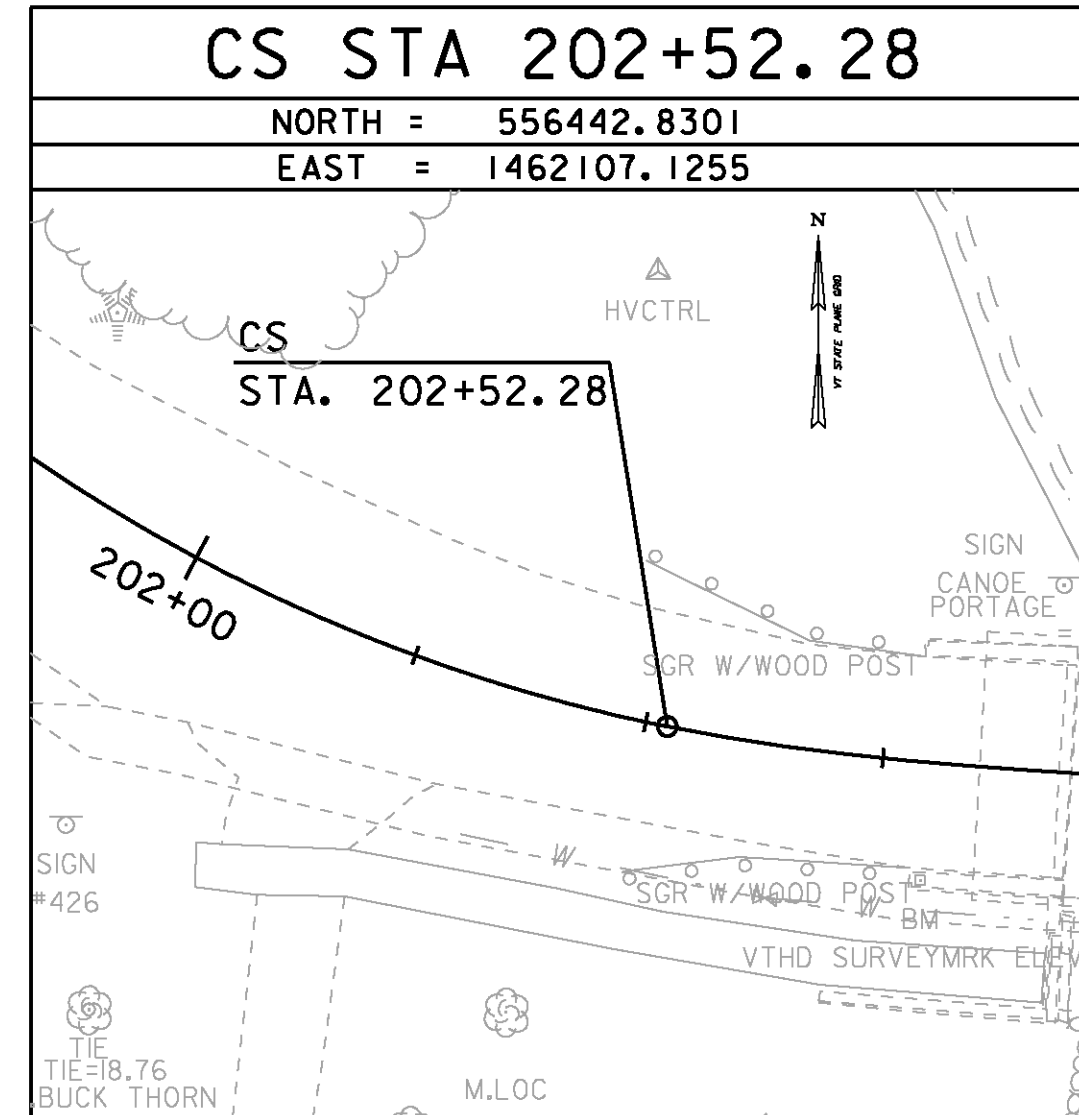
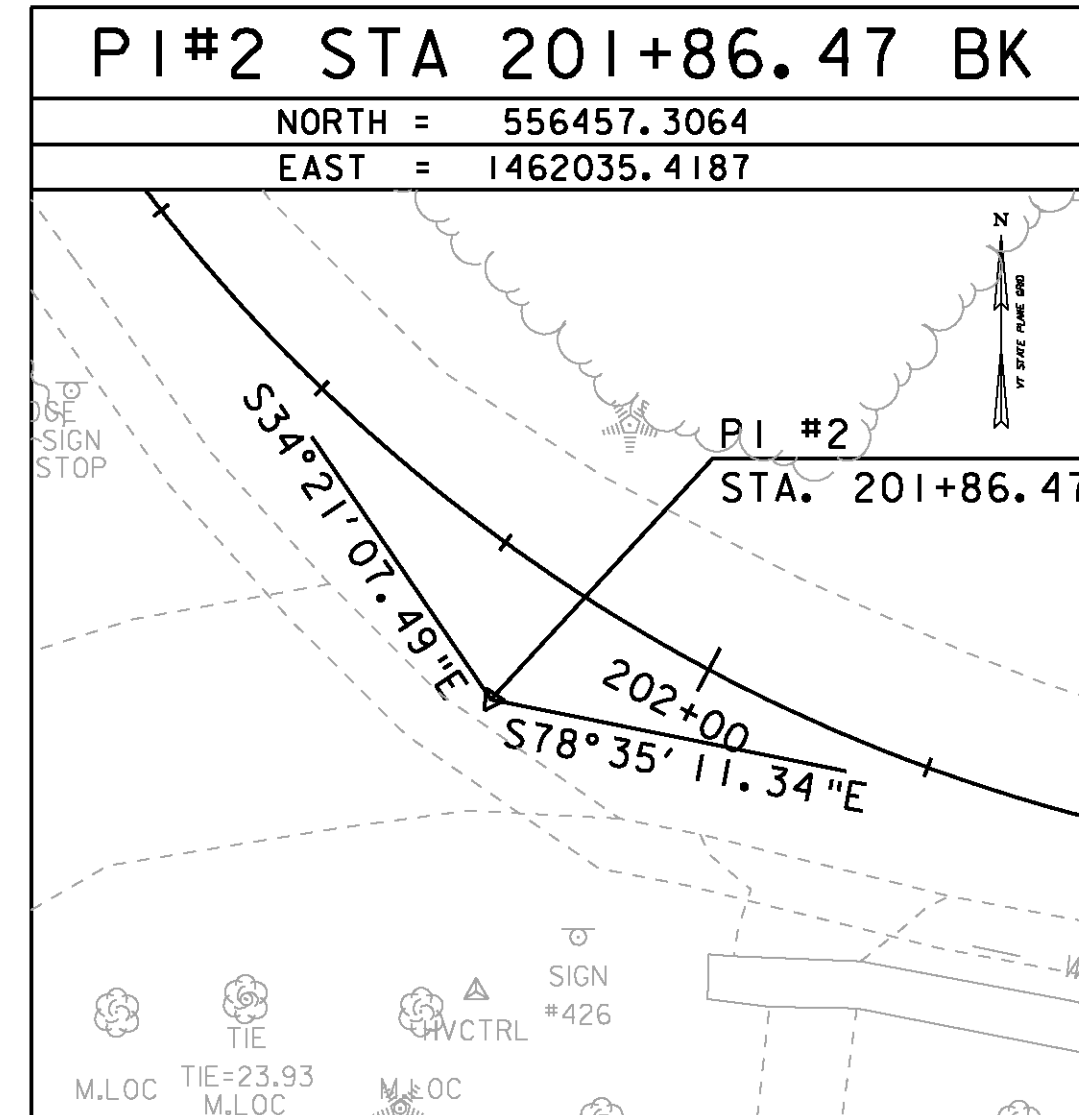
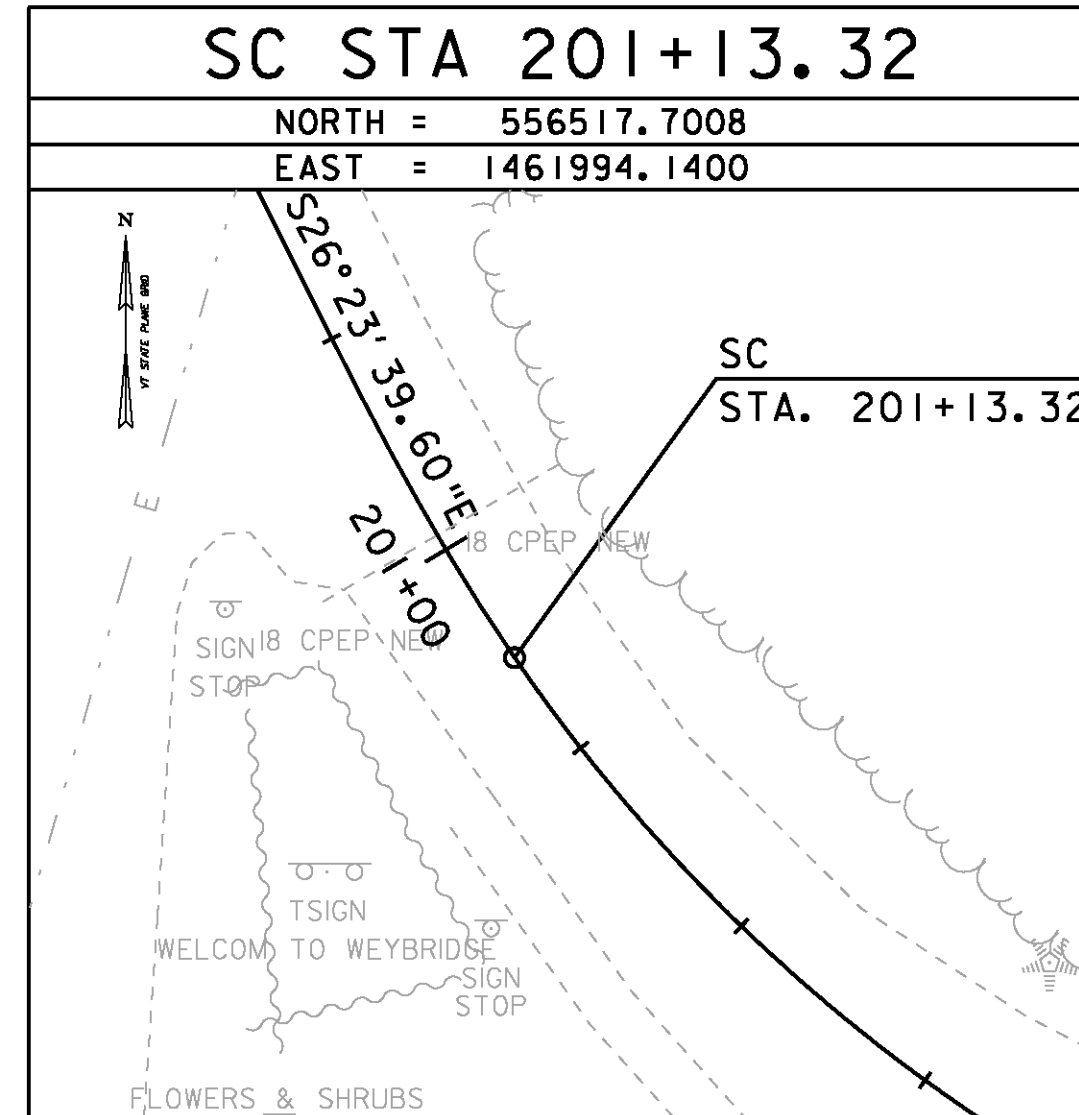
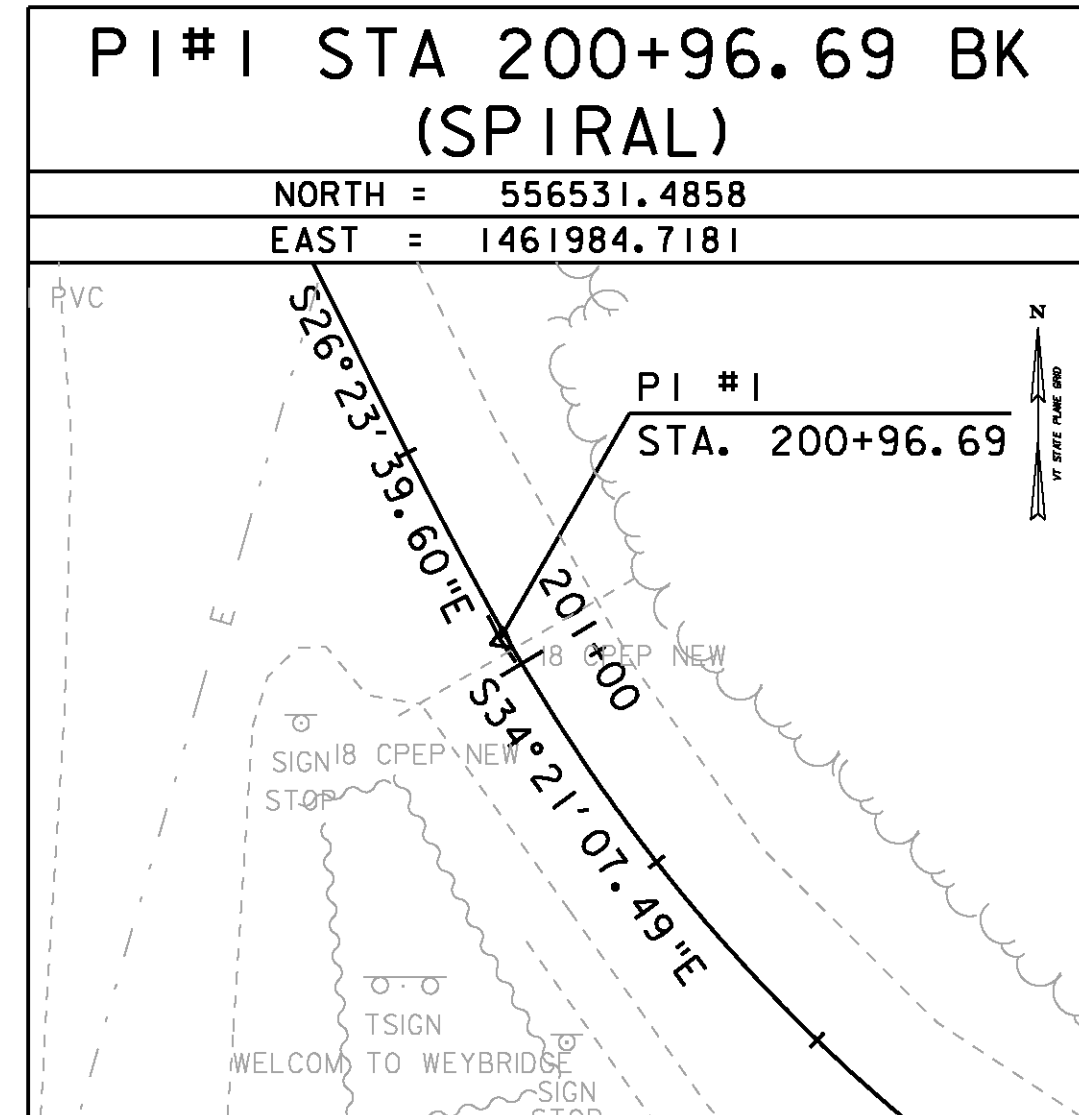


NEW ALIGNMENT TIE INFORMATION

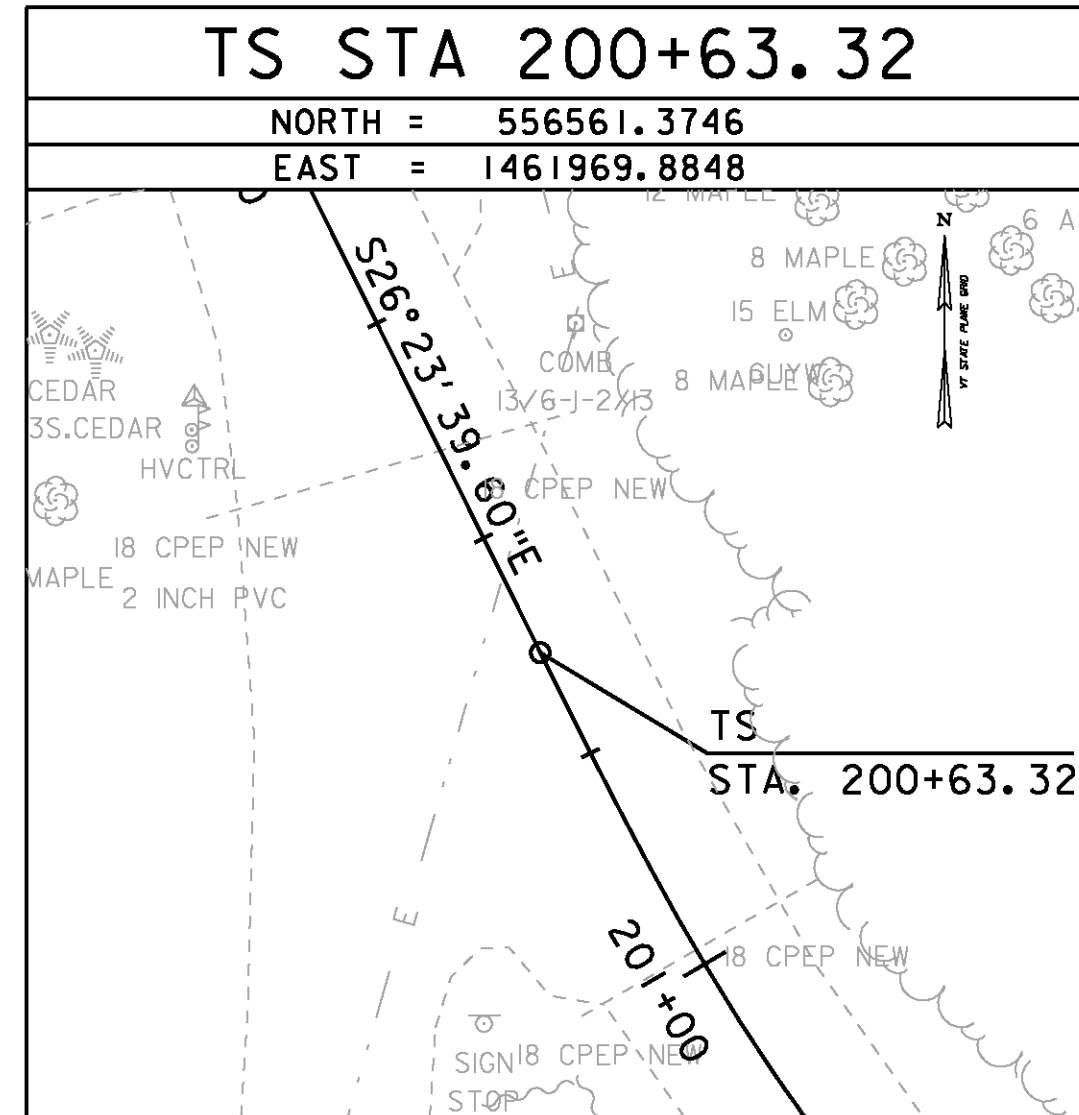

DATUM	
VERTICAL	NAVD 88
HORIZONTAL	NAD 83 (96)
ADJUSTMENT	COMPASS

Hoyle, Tanner & Associates, Inc.

HTA PROJECT NO. 90427	MODEL Alignment
--------------------------	--------------------

PROJECT NAME: MIDDLEBURY-WEYBRIDGE

PROJECT NUMBER: BHO 1445(33)

FILE NAME: z06j086t1.dgn
 PROJECT LEADER: M.D.SARGENT
 DESIGNED BY: J.BICJA
TIE SHEET

PLOT DATE: 9/20/2011
 DRAWN BY: J.B.McQUAD
 CHECKED BY: S.T.JAMES
 SHEET 12 OF 66