
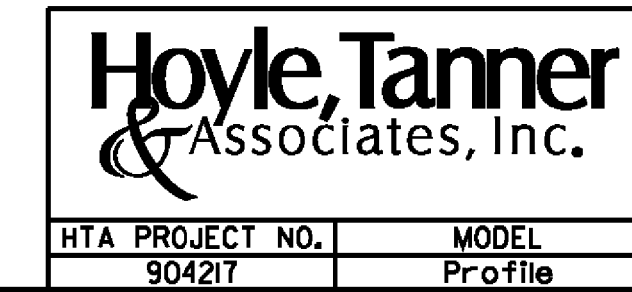


PROFILE ALONG T.H. NOS. 3 & 5

NOTE: GRADES SHOWN TO THE NEAREST TENTH REPRESENT EXISTING GROUND ELEVATION ALONG THE PROPOSED ALIGNMENT. GRADES SHOWN TO THE NEAREST HUNDREDTH REPRESENT FINISH GRADE ELEVATION ALONG THE PROPOSED ALIGNMENT.

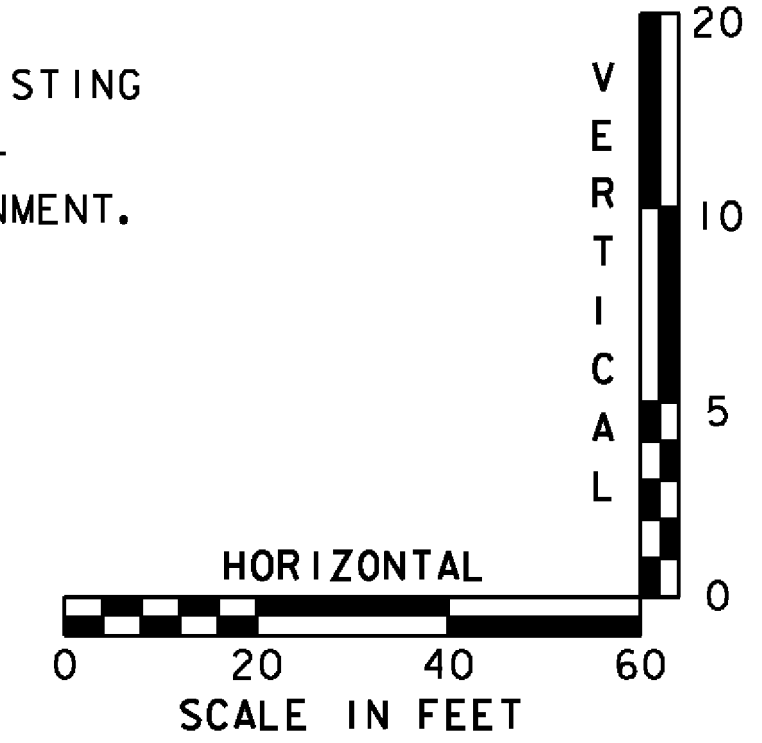

PROJECT NAME: MIDDLEBURY-WEYBRIDGE	
PROJECT NUMBER: BHO 1445(33)	
FILE NAME: z06j086pro2.dgn	PLOT DATE: 9/20/2011
PROJECT LEADER: M.D.SARGENT	DRAWN BY: J.B.McQUAID
DESIGNED BY: J.BICJA	CHECKED BY: S.T.JAMES
T.H. NOS. 3 & 5 ROADWAY PROFILE	
SHEET 14 OF 66	

HTA PROJECT NO.	MODEL
904217	Profile