

TOP CHORD PLAN


SCALE: 1/4" = 1'-0"

SOUTH TRUSS INSIDE ELEVATION (LOOKING SOUTH/UPSTREAM)

SCALE: 1/4" = 1'-0"

TYPICAL TRUSS SECTION

SCALE: 1/4" = 1'-0"

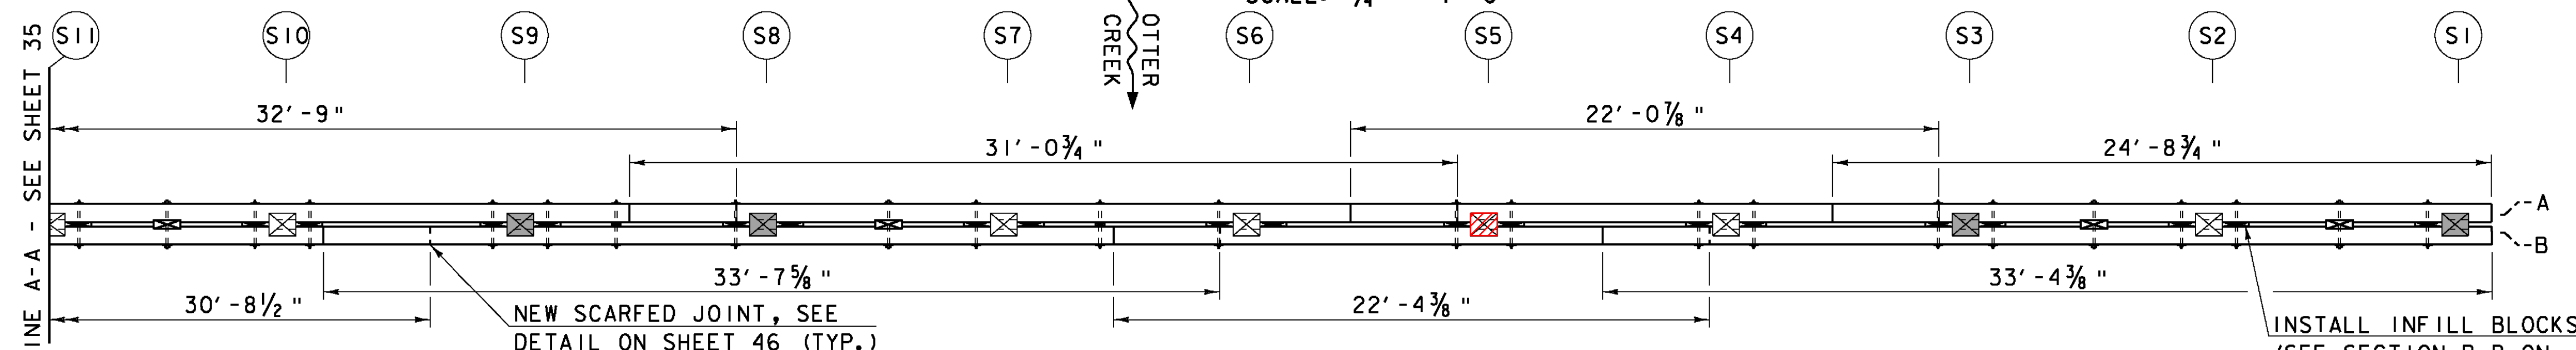


BOTTOM CHORD PLAN

SCALE: 1/4" = 1'-0"

*NOTE: BOTTOM CHORD IS TO BE REPLACED IN ITS ENTIRETY AND IT IS NOT SHOWN SHADED FOR CLARITY.

LEGEND:

- (XXX) TRUSS NODE LOCATION
- PREDETERMINED MEMBER TO BE REPLACED
- ▨ NEW MEMBER
- 1 REPLACE THROUGH BOLT & PLATE (SEE DETAIL ON SHEET 48)
- 2 INSTALL SHEAR BLOCK (SEE DETAIL ON SHEET 46)
- 3 INSTALL THROUGH BOLT (SEE SCARFED JOINT DETAIL ON SHEET 46)
- 4 INSTALL THROUGH BOLT (SEE DETAILS ON SHEET 51 OR 54)

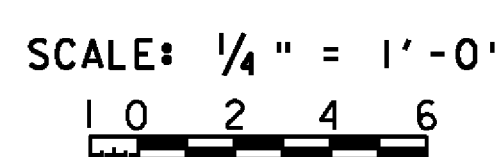

Hoyle, Tanner & Associates, Inc.

HTA PROJECT NO. 904217 MODEL truss south 2

PROJECT NAME:	MIDDLEBURY-WEYBRIDGE	FILE NAME:	z06j086sup.dgn	PLOT DATE:	9/20/2011
PROJECT NUMBER:	BHO 1445(33)	PROJECT LEADER:	M.D.SARGENT	DRAWN BY:	J.B.McQUAID
		DESIGNED BY:	J.BICJA	CHECKED BY:	S.T.JAMES
		SOUTH TRUSS ELEV. & PLAN (2 OF 2)			SHEET 36 OF 66