


**NORTH INTERIOR ARCH INSIDE ELEVATION
(LOOKING SOUTH/UPSTREAM)**


SCALE: HORIZ. 1/8" = 1'-0"
VERT. 1/4" = 1'-0"

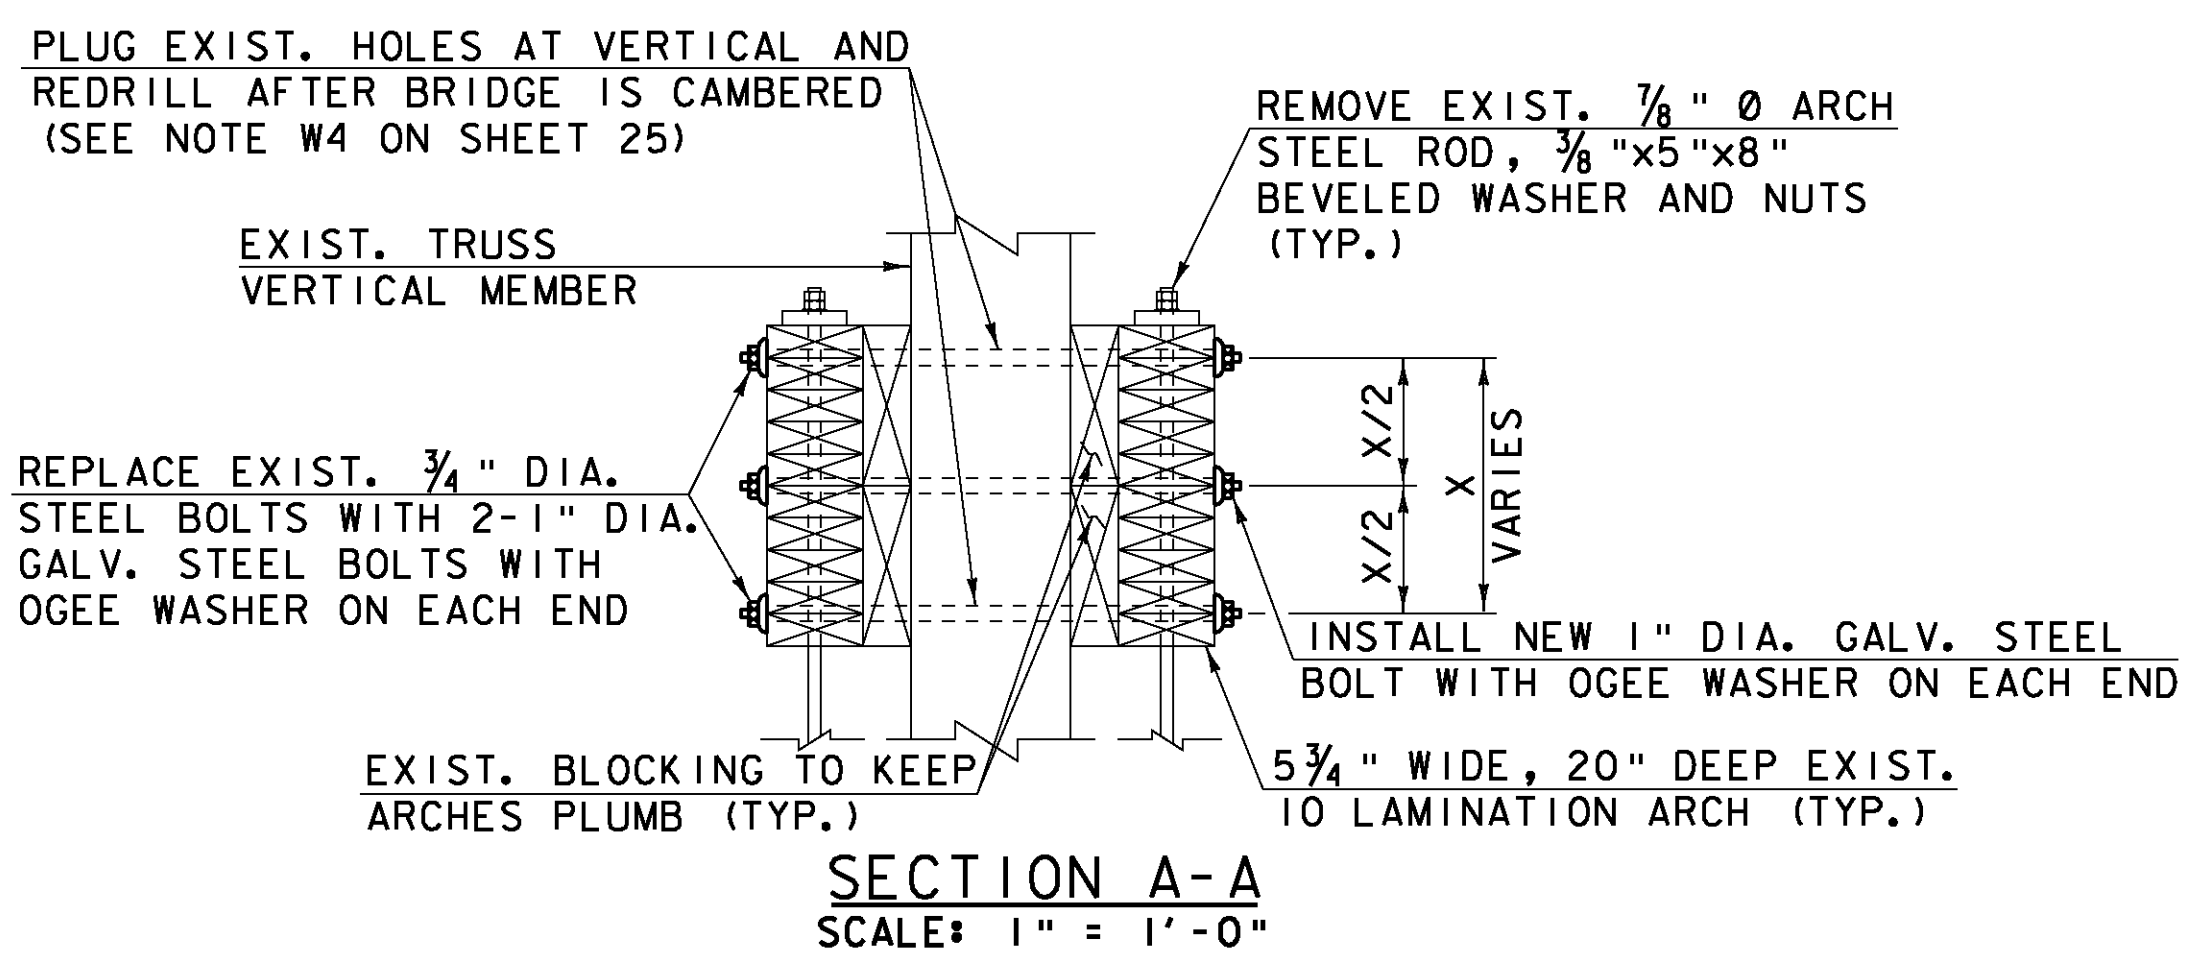

SECTION A-A
SCALE: 1" = 1'-0"

LEGEND:

⊙ TRUSS NODE LOCATION

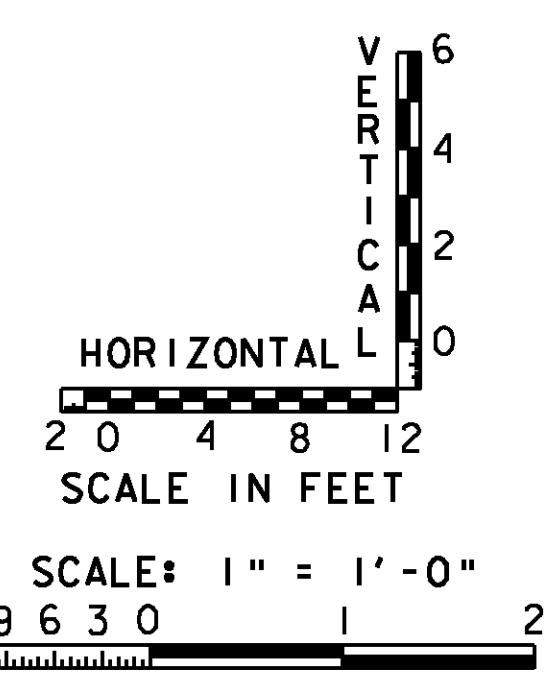

HTA PROJECT NO. 90427 MODEL Int north elev

PROJECT NAME:	MIDDLEBURY-WEYBRIDGE	FILE NAME:	z06j086sup6.dgn	PLOT DATE:	9/20/2011
PROJECT NUMBER:	BHO 1445(33)	PROJECT LEADER:	M.D.SARGENT	DRAWN BY:	J.B.McQUAID
		DESIGNED BY:	J.BICJA	CHECKED BY:	S.T.JAMES
N. INTERIOR ARCH ELEVATION & DETAILS			SHEET 38 OF 66		