


STATIONING
SOUTH INTERIOR ARCH INSIDE ELEVATION
 (LOOKING NORTH/DOWNSTREAM)

SCALE: HORIZ. 1/8" = 1'-0"
 VERT. 1/4" = 1'-0"

GALV. STEEL PLATES BOLTED AT ARCH AND ABUT. NO. 2.
 CLEAN AND PAINT ARCH THROUGH BOLTS & ANCHOR BOLTS
 WITH A ZINC RICH PAINT. APPLY TWO (2) COATS OF
 COAL TAR EPOXY (SEE NOTE S-4 ON SHEET 25)

LEGEND:

(XXX) TRUSS NODE LOCATION

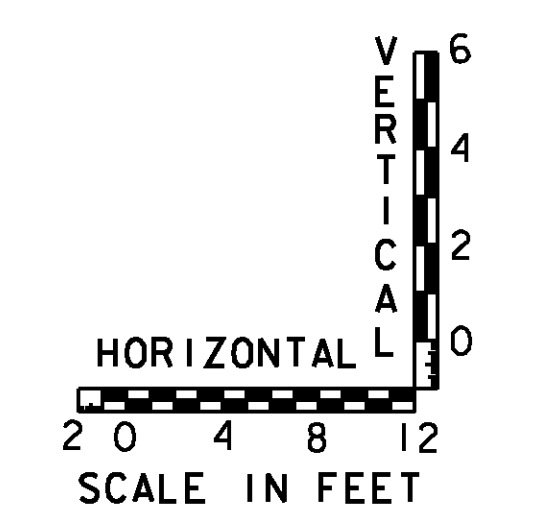

SCALE: 1" = 1'-0"
 1 9 6 3 0 1 2

Hoyle, Tanner
 & Associates, Inc.

HTA PROJECT NO. 90427 MODEL Int south elev

PROJECT NAME:	MIDDLEBURY-WEYBRIDGE
PROJECT NUMBER:	BHO 1445(33)
FILE NAME:	z06j086sup6.dgn
PROJECT LEADER:	M.D.SARGENT
DESIGNED BY:	J.BICJA
S. INTERIOR ARCH ELEVATION & DETAILS	
PLOT DATE:	9/20/2011
DRAWN BY:	J.B.McQUAID
CHECKED BY:	S.T.JAMES
	SHEET 39 OF 66