
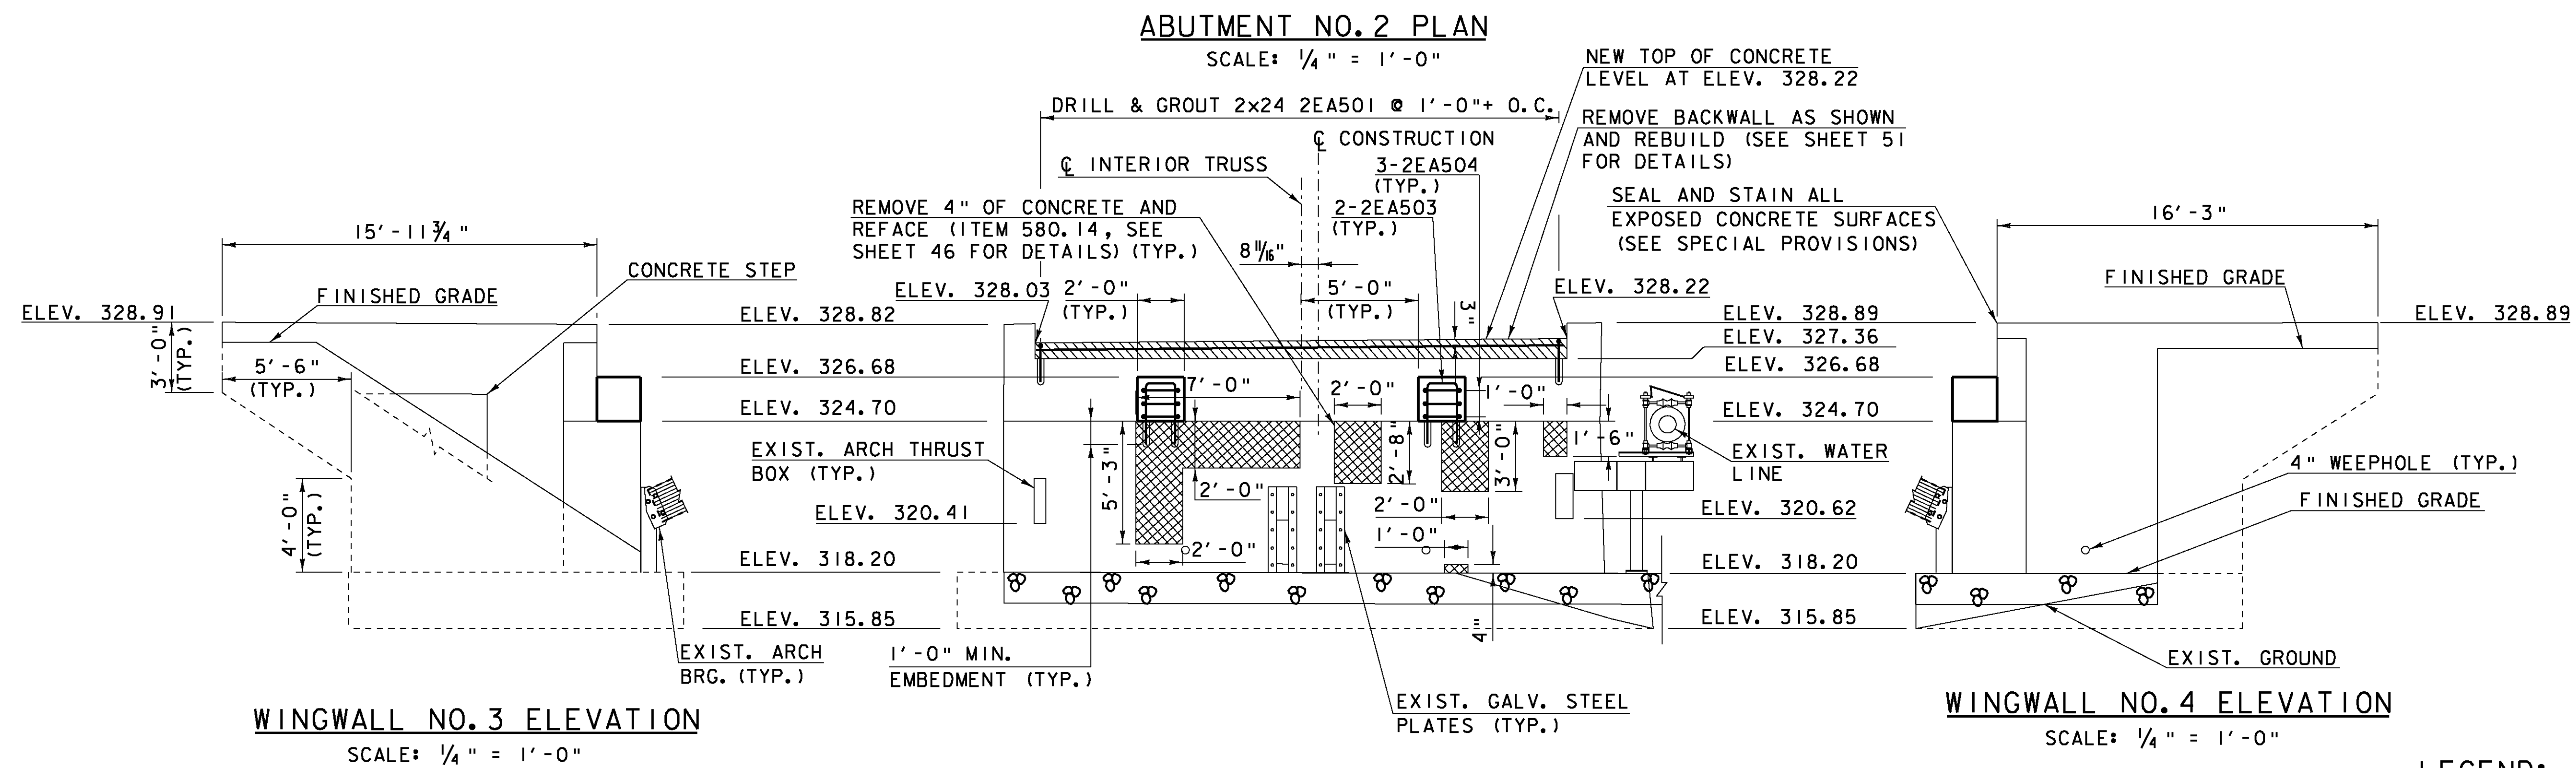


**SHEET NOTES:**

- SEE SHEET 51 FOR DETAILS THAT APPLY TO THIS SHEET.
- APPROACH WORK DETAILS (GUARDRAIL, EDGE OF TRAVELWAY, ETC.) AND BRIDGE SUPERSTRUCTURE ARE NOT SHOWN FOR CLARITY.

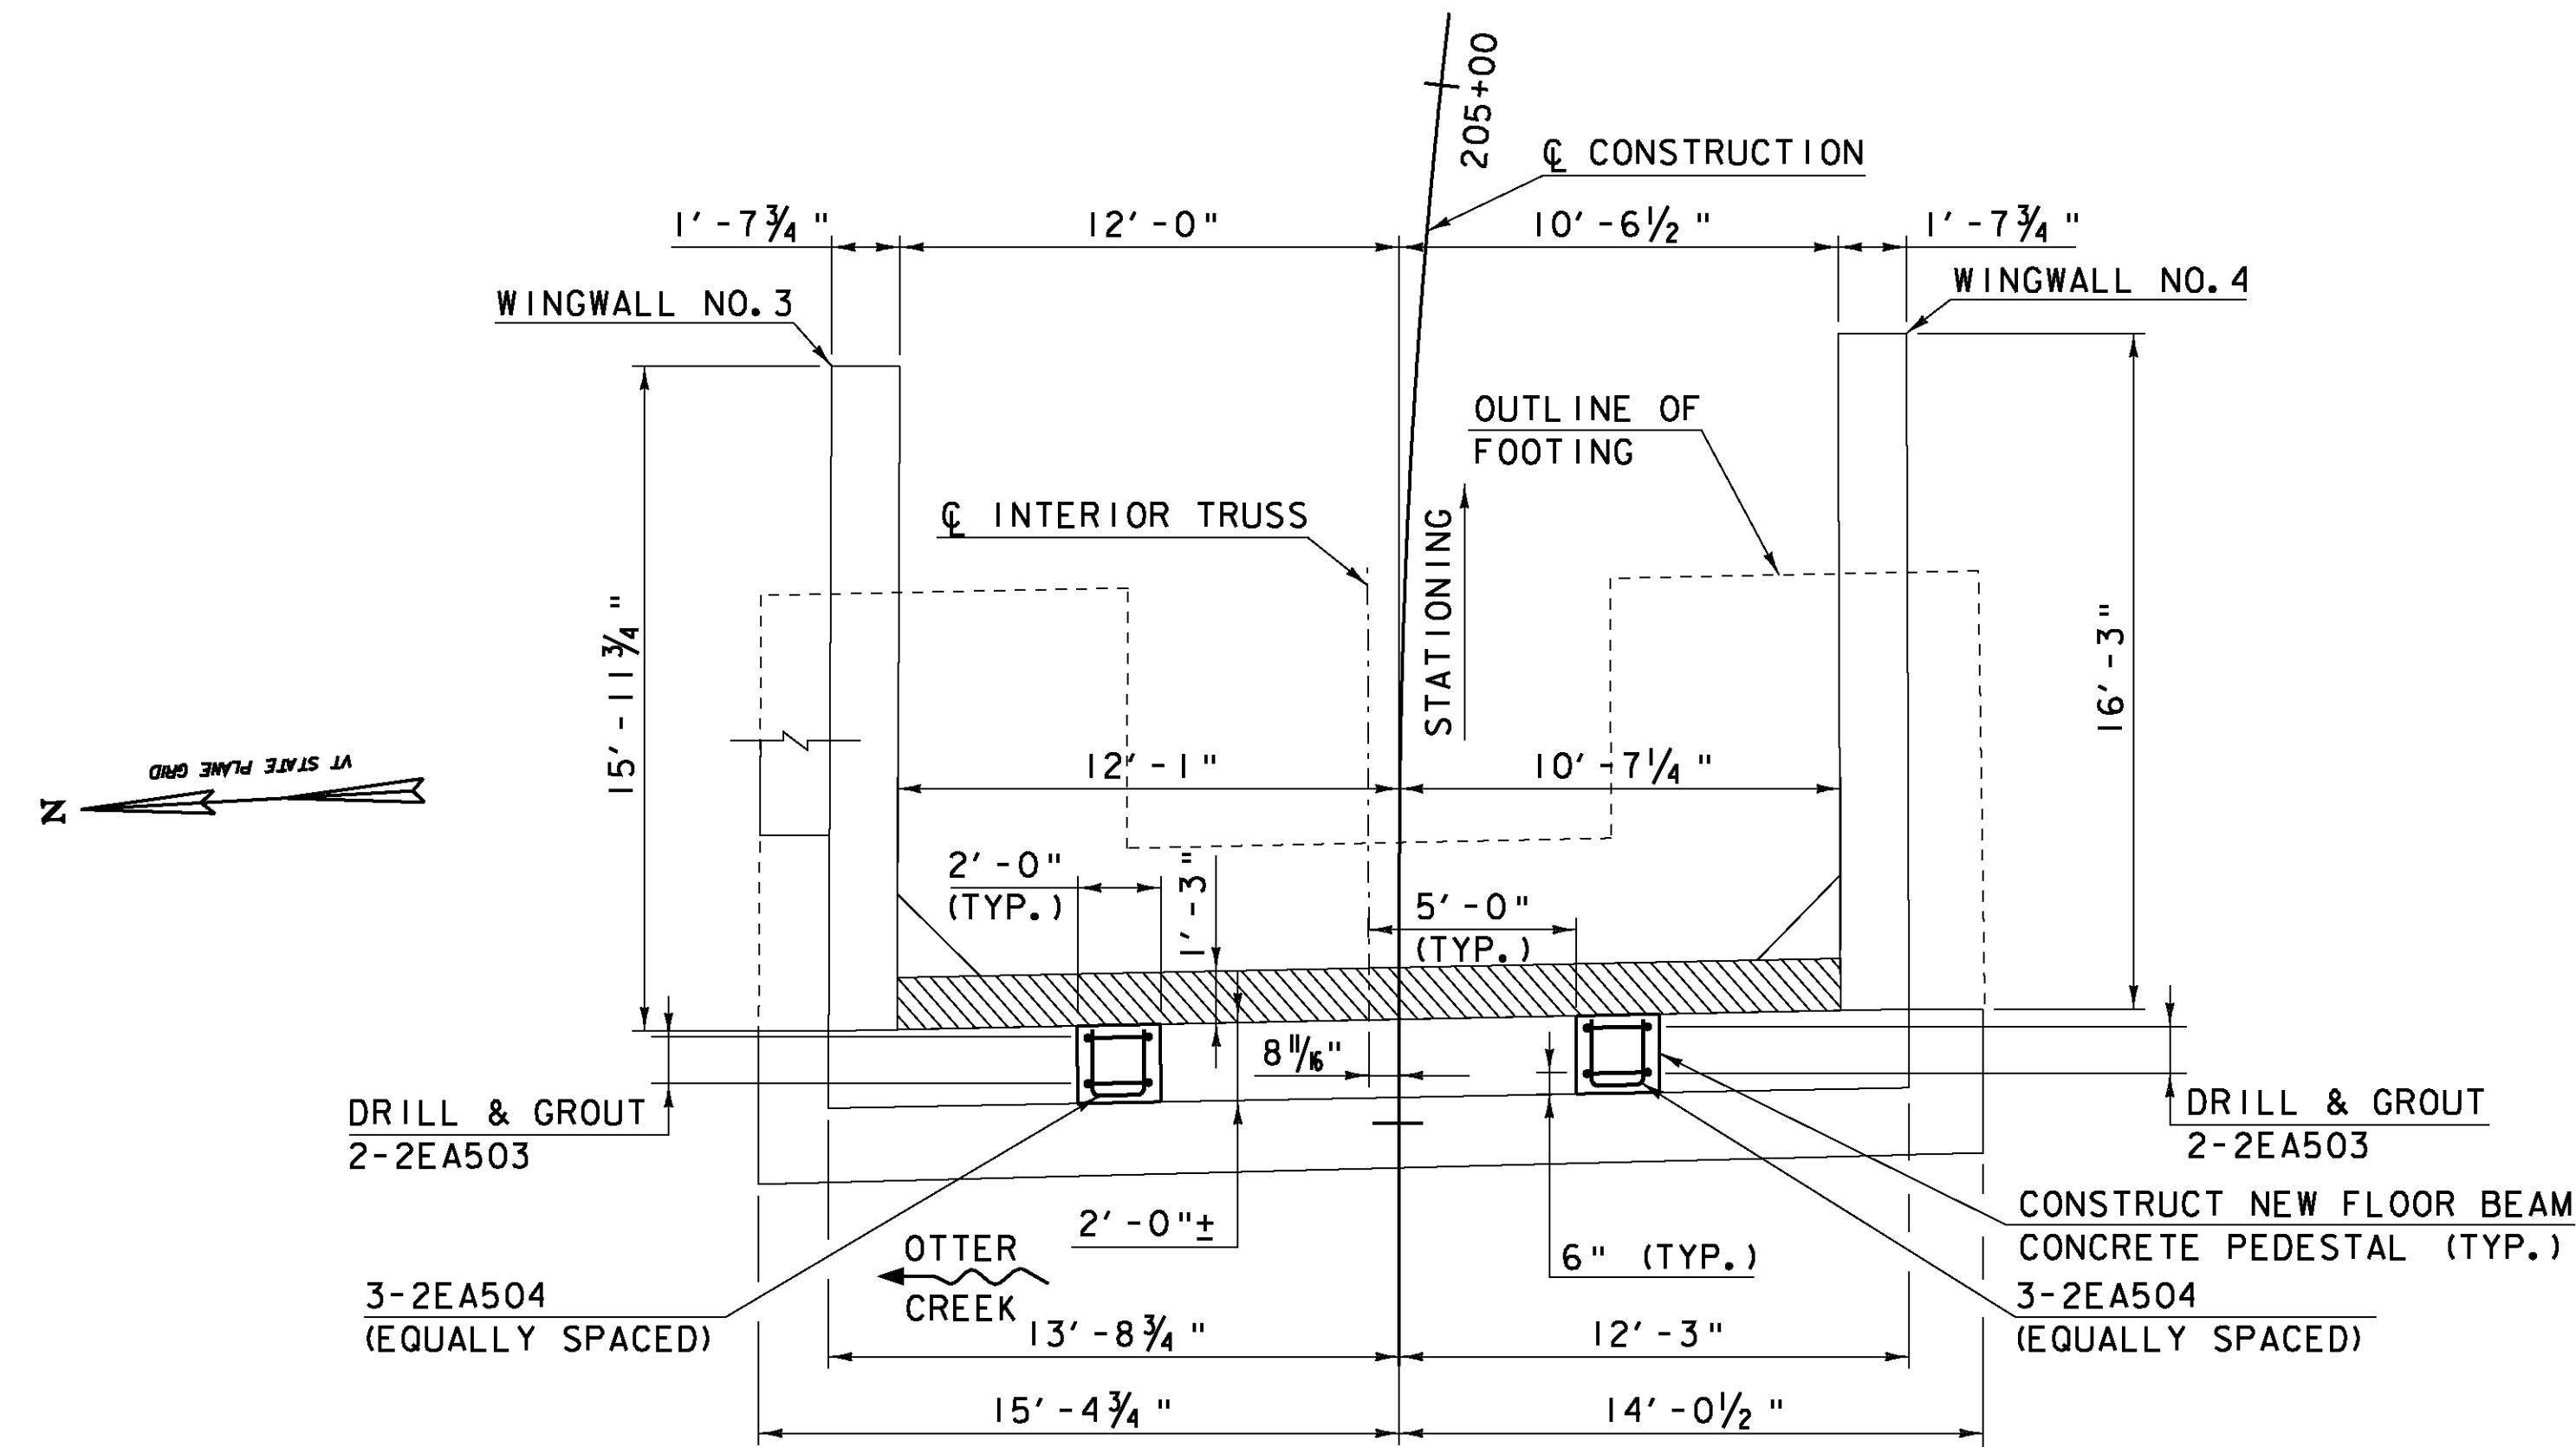

**LEGEND:**

- DENOTES LIMITS OF CLASS II VERTICAL CONCRETE REPAIR
- DENOTES CONCRETE REMOVAL

SCALE: 1/4" = 1'-0"



**Hoyle, Tanner & Associates, Inc.**

HTA PROJECT NO. 90427 MODEL abut B

PROJECT NAME: MIDDLEBURY-WEYBRIDGE

PROJECT NUMBER: BHO 1445(33)

FILE NAME: z06j086sub2.dgn

PROJECT LEADER: M.D.SARGENT

DESIGNED BY: J.BICJA

**ABUTMENT NO.2 PLAN & ELEVATION**

PLOT DATE: 9/20/2011

DRAWN BY: J.B.McQUAAD

CHECKED BY: S.T.JAMES

SHEET 50 OF 66