



\* DISTANCE VARIES TO AVOID CONFLICT WITH FLOOR BEAMS, SEE SHEETS 31-36.

**PIER BEARING TYPICAL DETAIL**


SCALE: 1" = 1'-0"

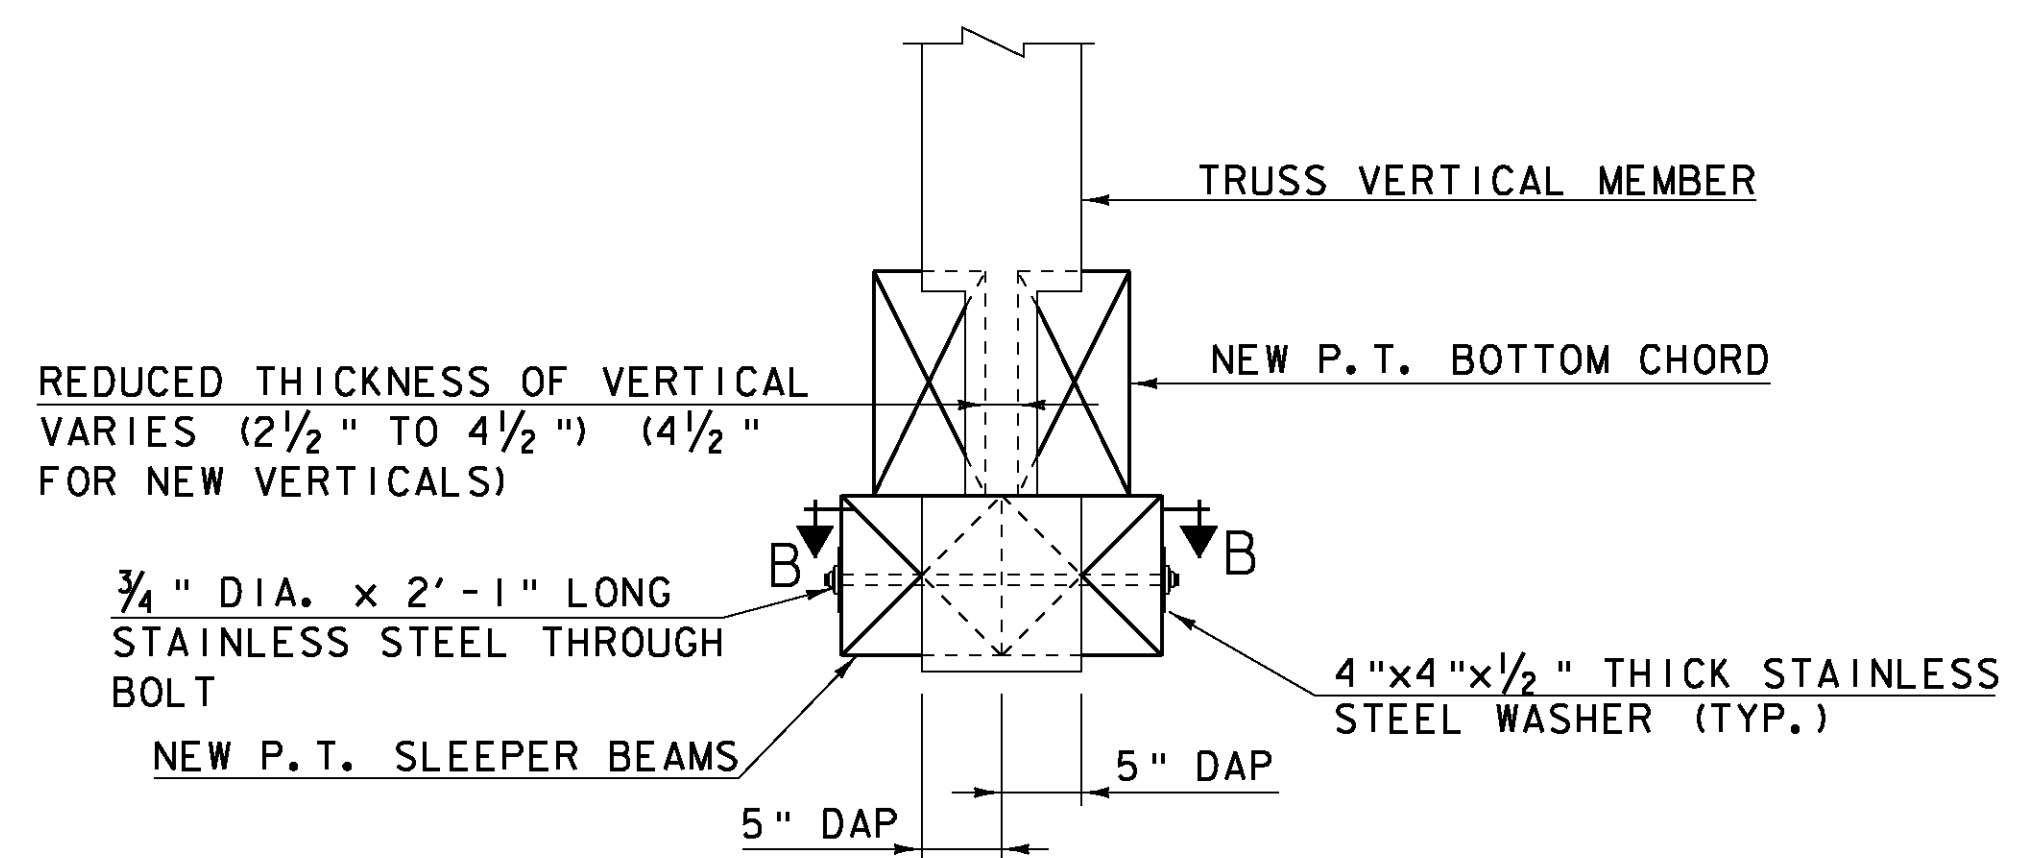

**SECTION A-A**  
SCALE: 1" = 1'-0"

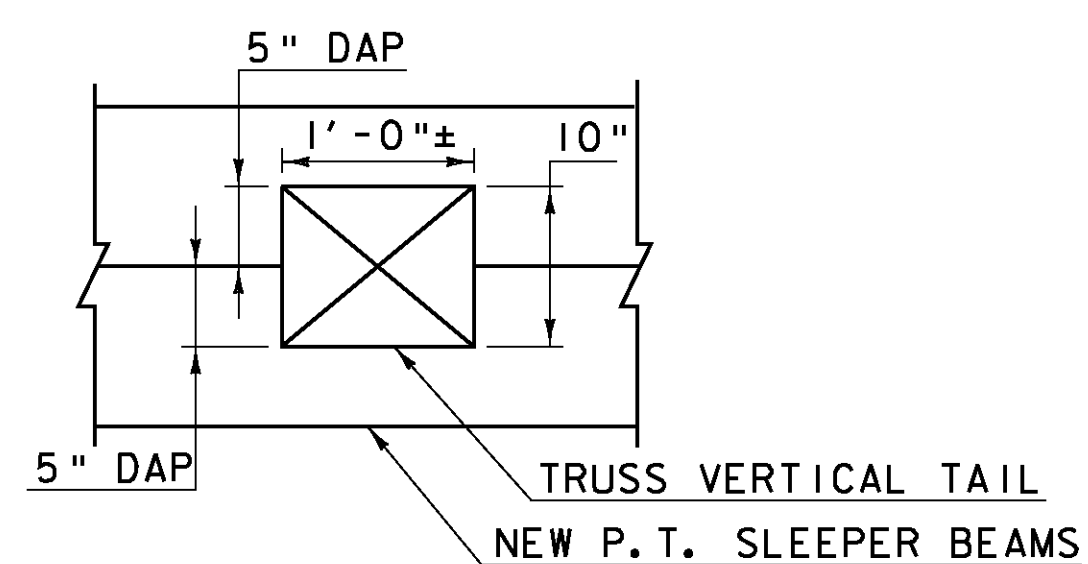

**SECTION B-B**  
SCALE: 1" = 1'-0"

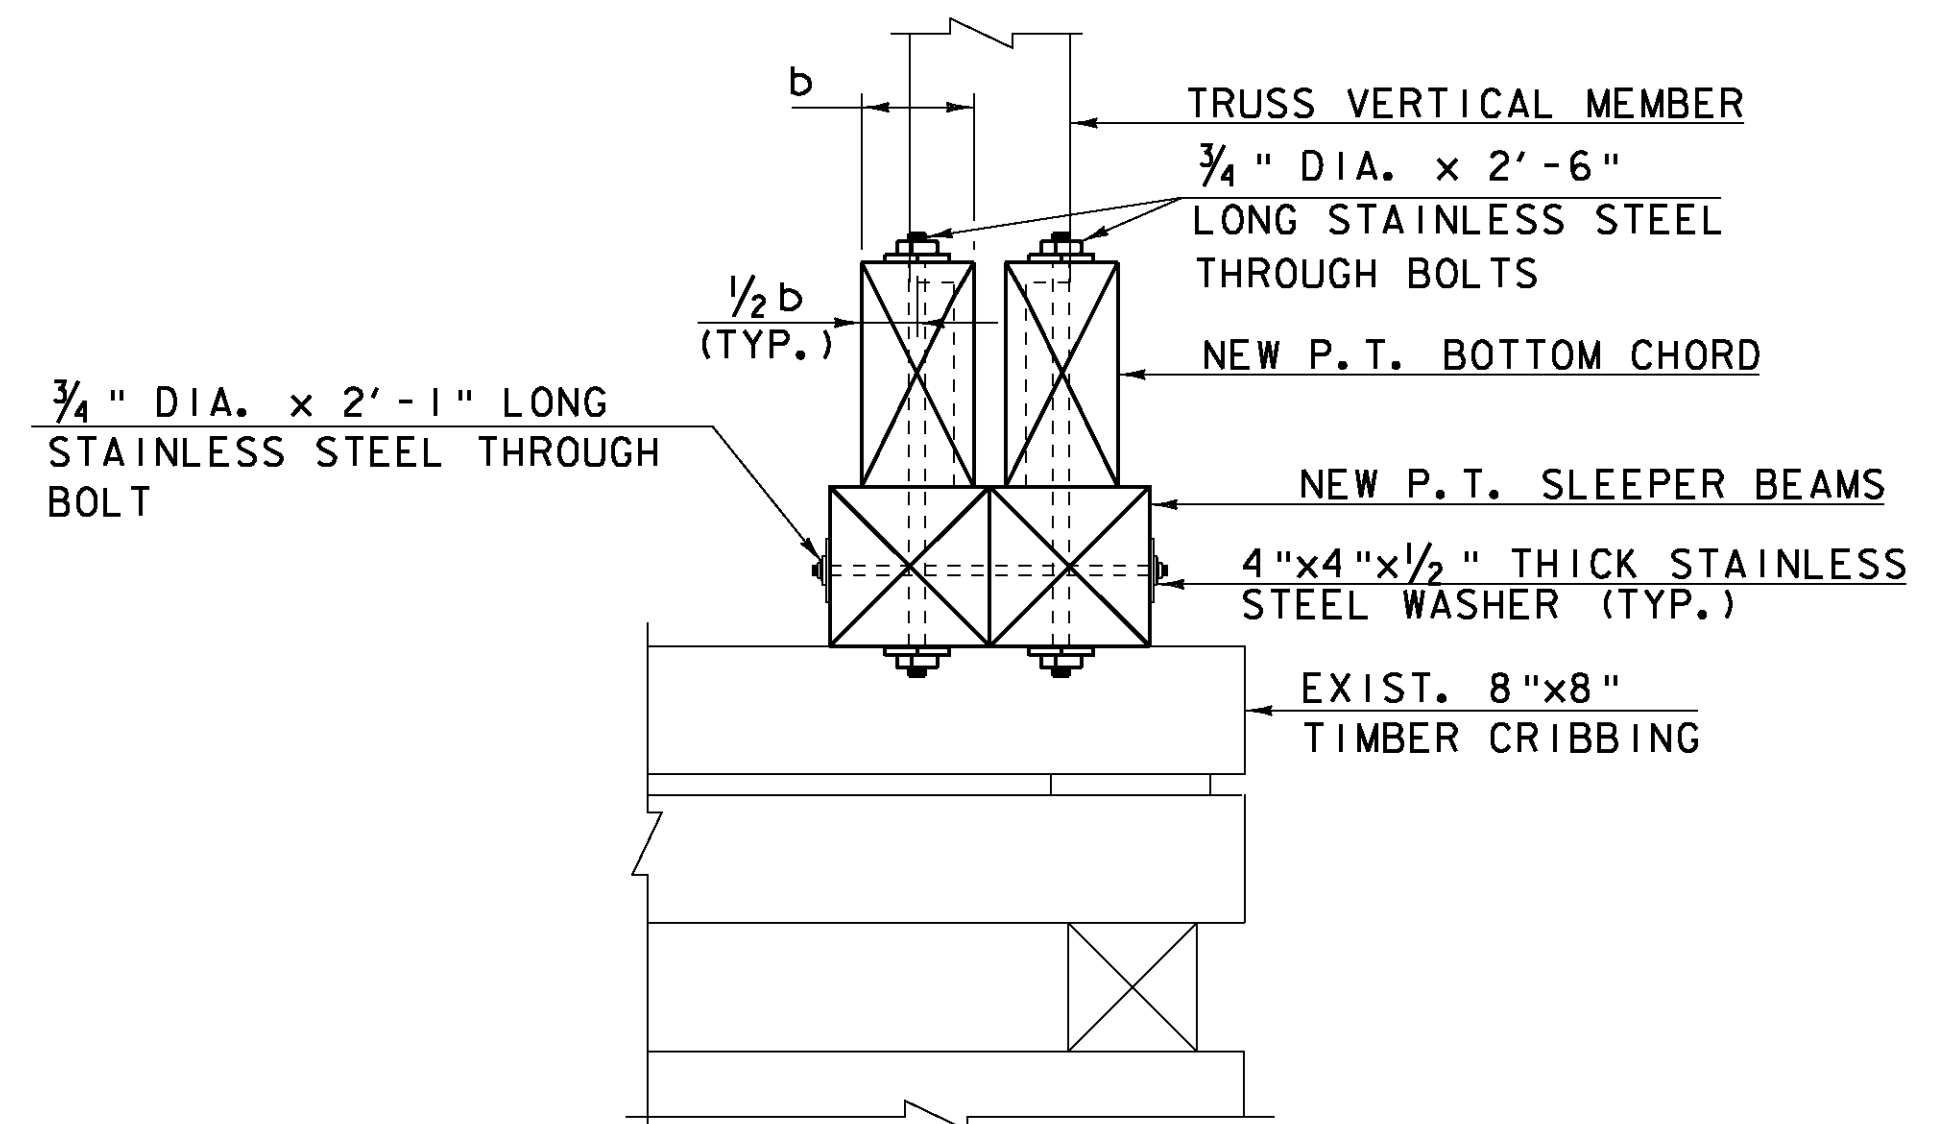

**SECTION C-C**  
SCALE: 1" = 1'-0"

SCALE: 1" = 1'-0"  
1 9 6 3 0

**Hoyle, Tanner & Associates, Inc.**  
HTA PROJECT NO. 90427 MODEL DETAILS

PROJECT NAME: MIDDLEBURY-WEYBRIDGE

PROJECT NUMBER: BHO 1445(33)

FILE NAME: z06j086sup9.dgn

PROJECT LEADER: M.D.SARGENT

DESIGNED BY: J.BICJA

**PIER TYPICAL SECTIONS & DETAILS**

PLOT DATE: 9/20/2011

DRAWN BY: J.B.McQUAID

CHECKED BY: S.T.JAMES

SHEET 54 OF 66