



20+50

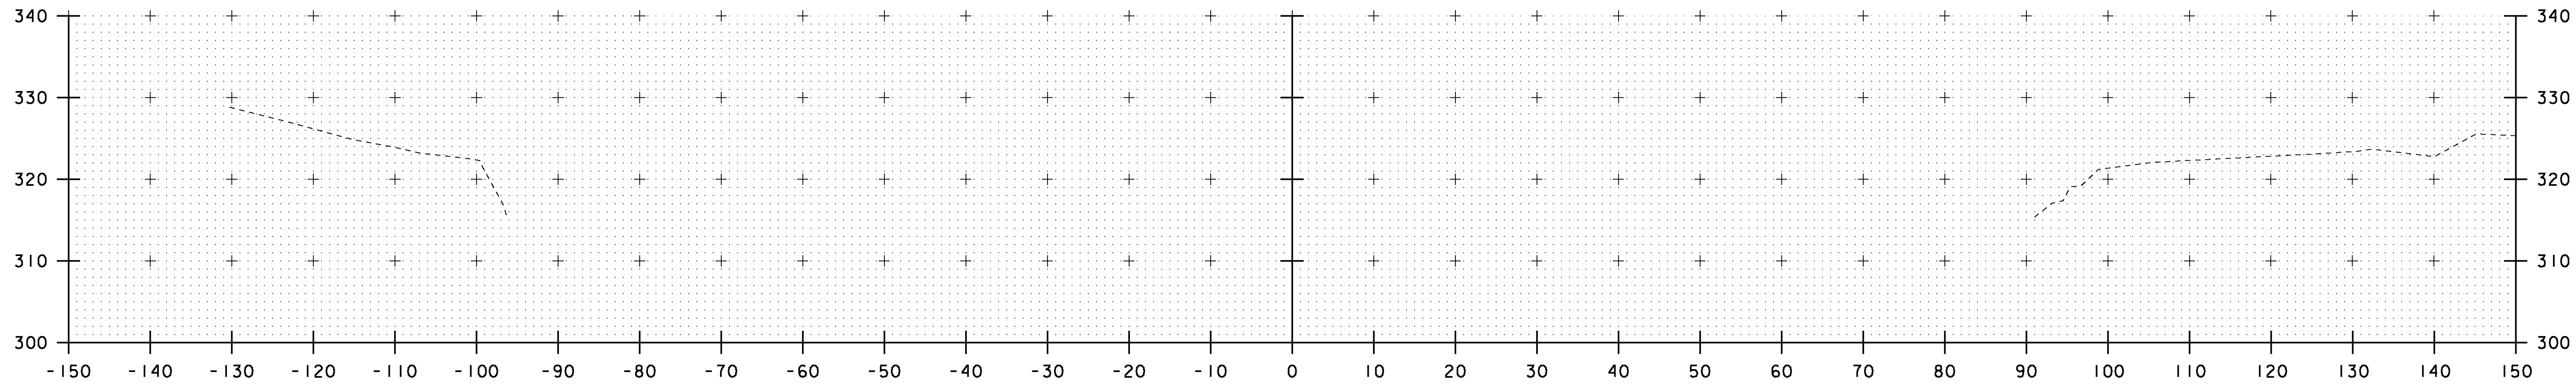

20+25

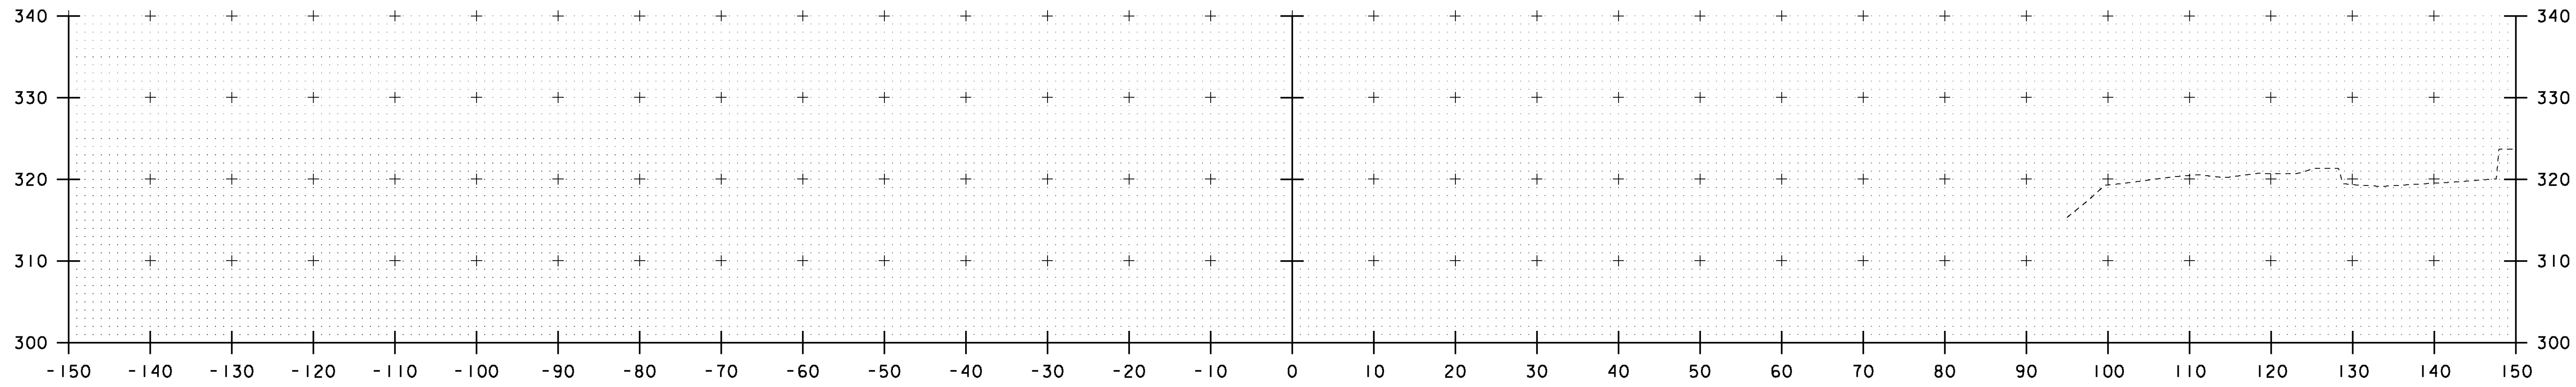

20+00

STA. 20+00 TO STA. 20+50

PROJECT NAME: MIDDLEBURY-WEYBRIDGE

PROJECT NUMBER: BHO 1445(33)

FILE NAME: z06j086xs3.dgn
 PROJECT LEADER: M.D.SARGENT
 DESIGNED BY: J.BICJA

CHANNEL CROSS SECTIONS (1 OF 4)
 PLOT DATE: 9/20/2011
 DRAWN BY: J.B.McQUAID
 CHECKED BY: S.T.JAMES
 SHEET 63 OF 66

SCALE: 1" = 10'-0"
 10 0 10

Hoyle, Tanner
 & Associates, Inc.
 HTA PROJECT NO. 90427
 MODEL XSI