



EARTHWORK SECTION @ ABUT #1
(NOT TO SCALE)

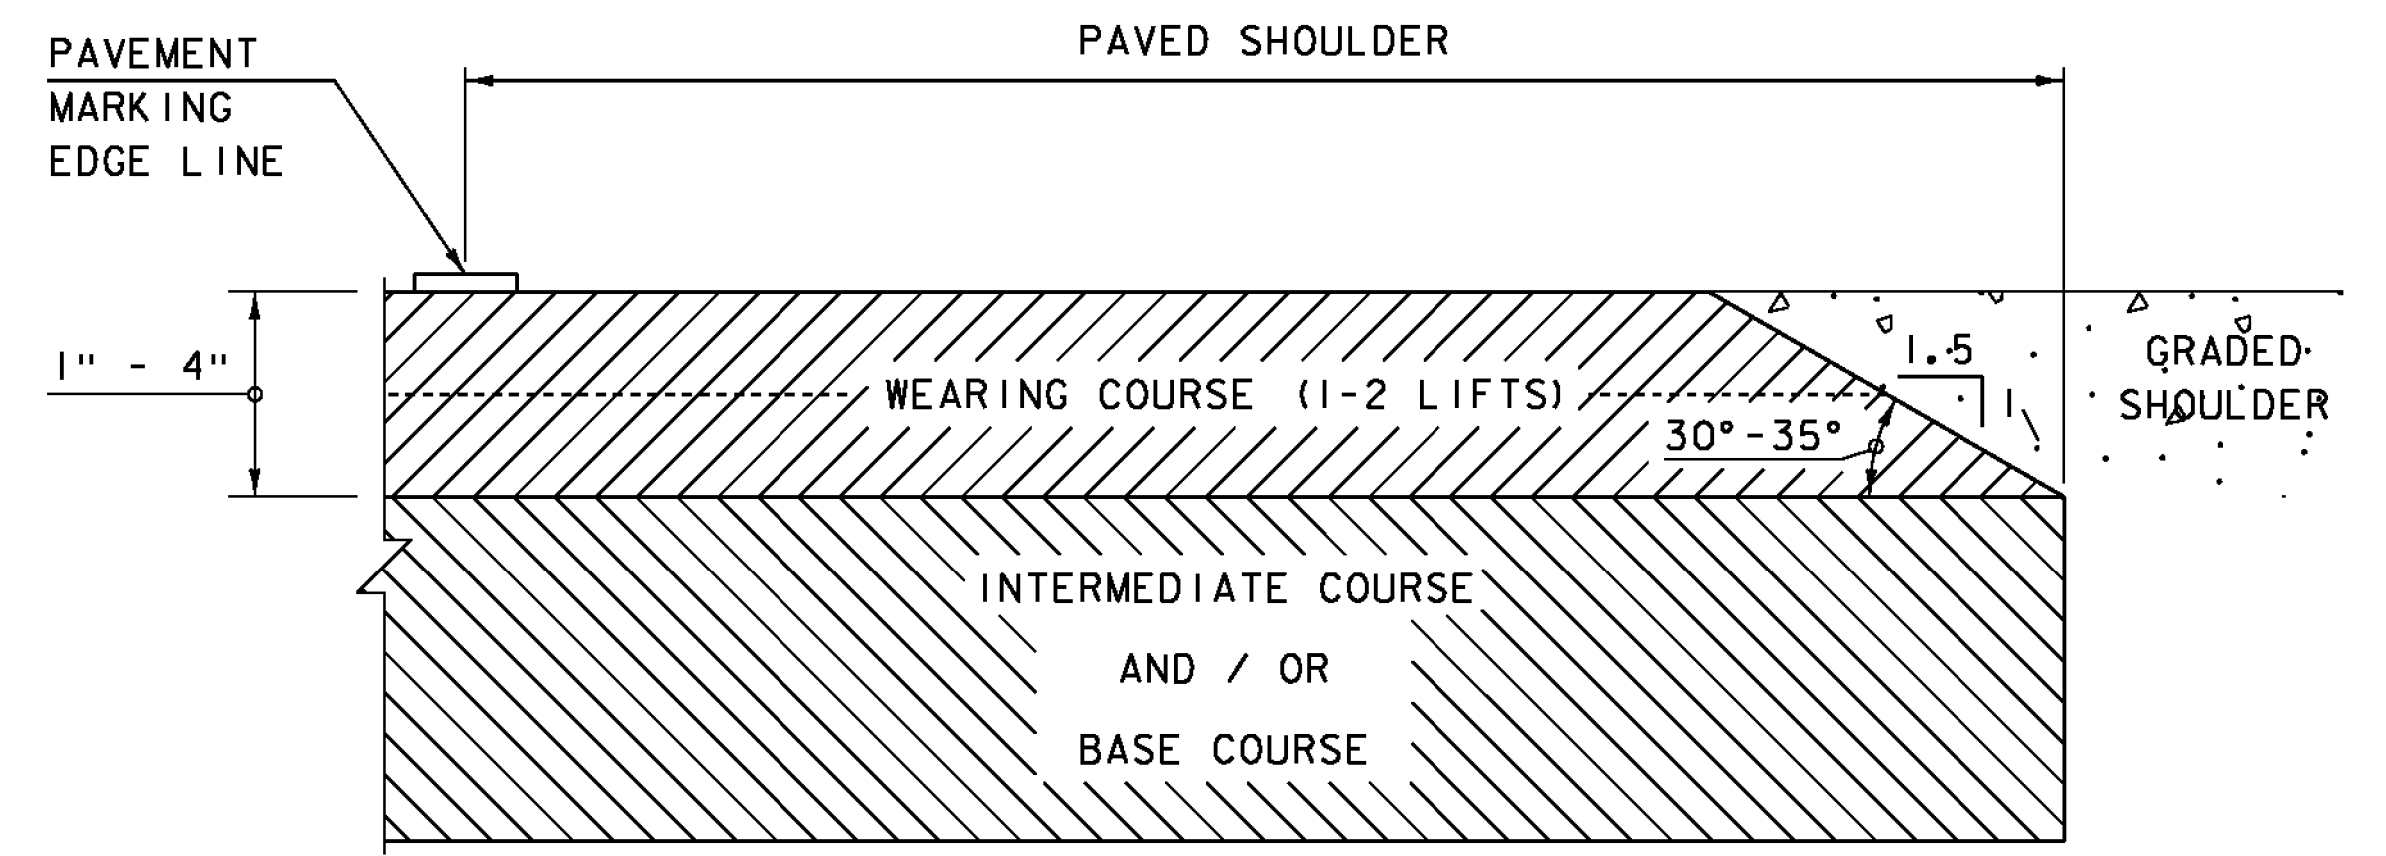

SAFETY EDGE DETAIL
NOT TO SCALE

NOTE: LEVELING COURSE MAY INCLUDE THE "SAFETY EDGE" AT THE CONTRACTOR'S CHOICE.

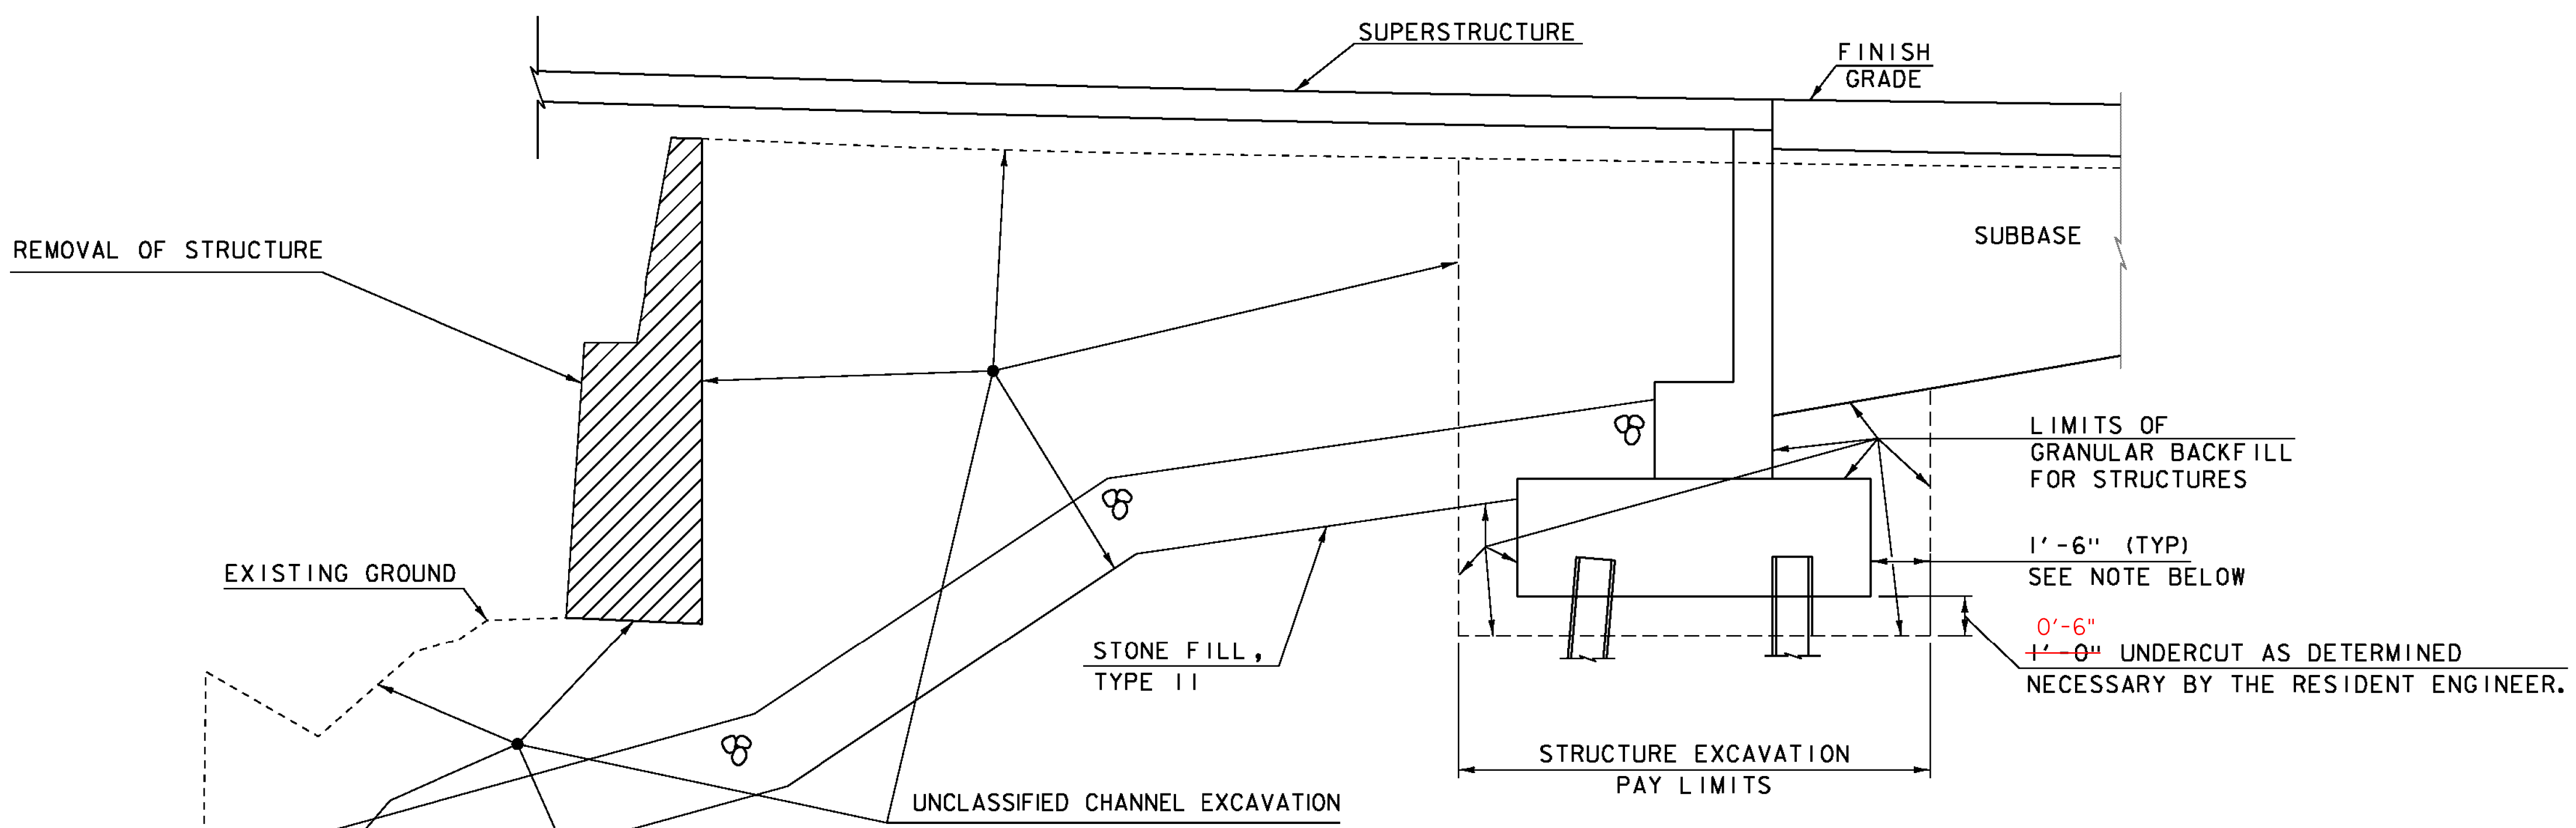

EARTHWORK SECTION @ ABUT #2
(NOT TO SCALE)

NOTE: THE PAY LIMITS OF "STRUCTURE EXCAVATION" SHALL BE NO MORE THAN 1'-6" OUTSIDE THE PERIMETER OF THE FOOTING, UP TO EXISTING GROUND, THE BOTTOM OF SUBBASE, OR OTHER EXCAVATION LIMIT, WHICHEVER IS LOWEST. CONTRADICTS SECTION LIMITS

PROJECT NAME: BARRE TOWN	PLOT DATE: 27-SEP-2012
PROJECT NUMBER: BRF 6100(7)	DRAWN BY: R. PELLETT
FILE NAME: s06j002typ.dgn	DESIGNED BY: T. FILLBACH
PROJECT LEADER: J. LACROIX	CHECKED BY: T. FILLBACH
TYPICAL SECTIONS 2	SHEET 4 OF 70