

24" STOP BAR
 STA. 12+94.80 - 12+98.80 LT
 STA. 14+66.40 - STA. 14+81.00 RT


TRAFFIC SIGN, TYPE A
 STA. 12+93.00 LT
 STA. 14+63.00 LT

REMOVING SIGNS
 STA. 12+78.00 RT
 STA. 13+09.00 LT
 STA. 15+05.00 LT

ERECTING SALVAGED SIGNS
 STA. 12+78.00 RT
 STA. 13+06.00 LT
 STA. 14+63.00 LT

BOLLARDS
 STA. 12+93.97 LT 95.00
 STA. 12+99.15 LT 13+01.00
 STA. 13+04.26 LT 06.00

4" WHITE LINE
 STA. 11+75.00 - STA. 16+00.00 RT
 STA. 11+75.00 - STA. 16+00.00 LT
 15+00 - 16+00 LT
 4" DOUBLE YELLOW LINE
 STA. 11+75.00 - STA. 16+00.00 LT/RT
 14+60
 15+00 - 16+00 LT/RT

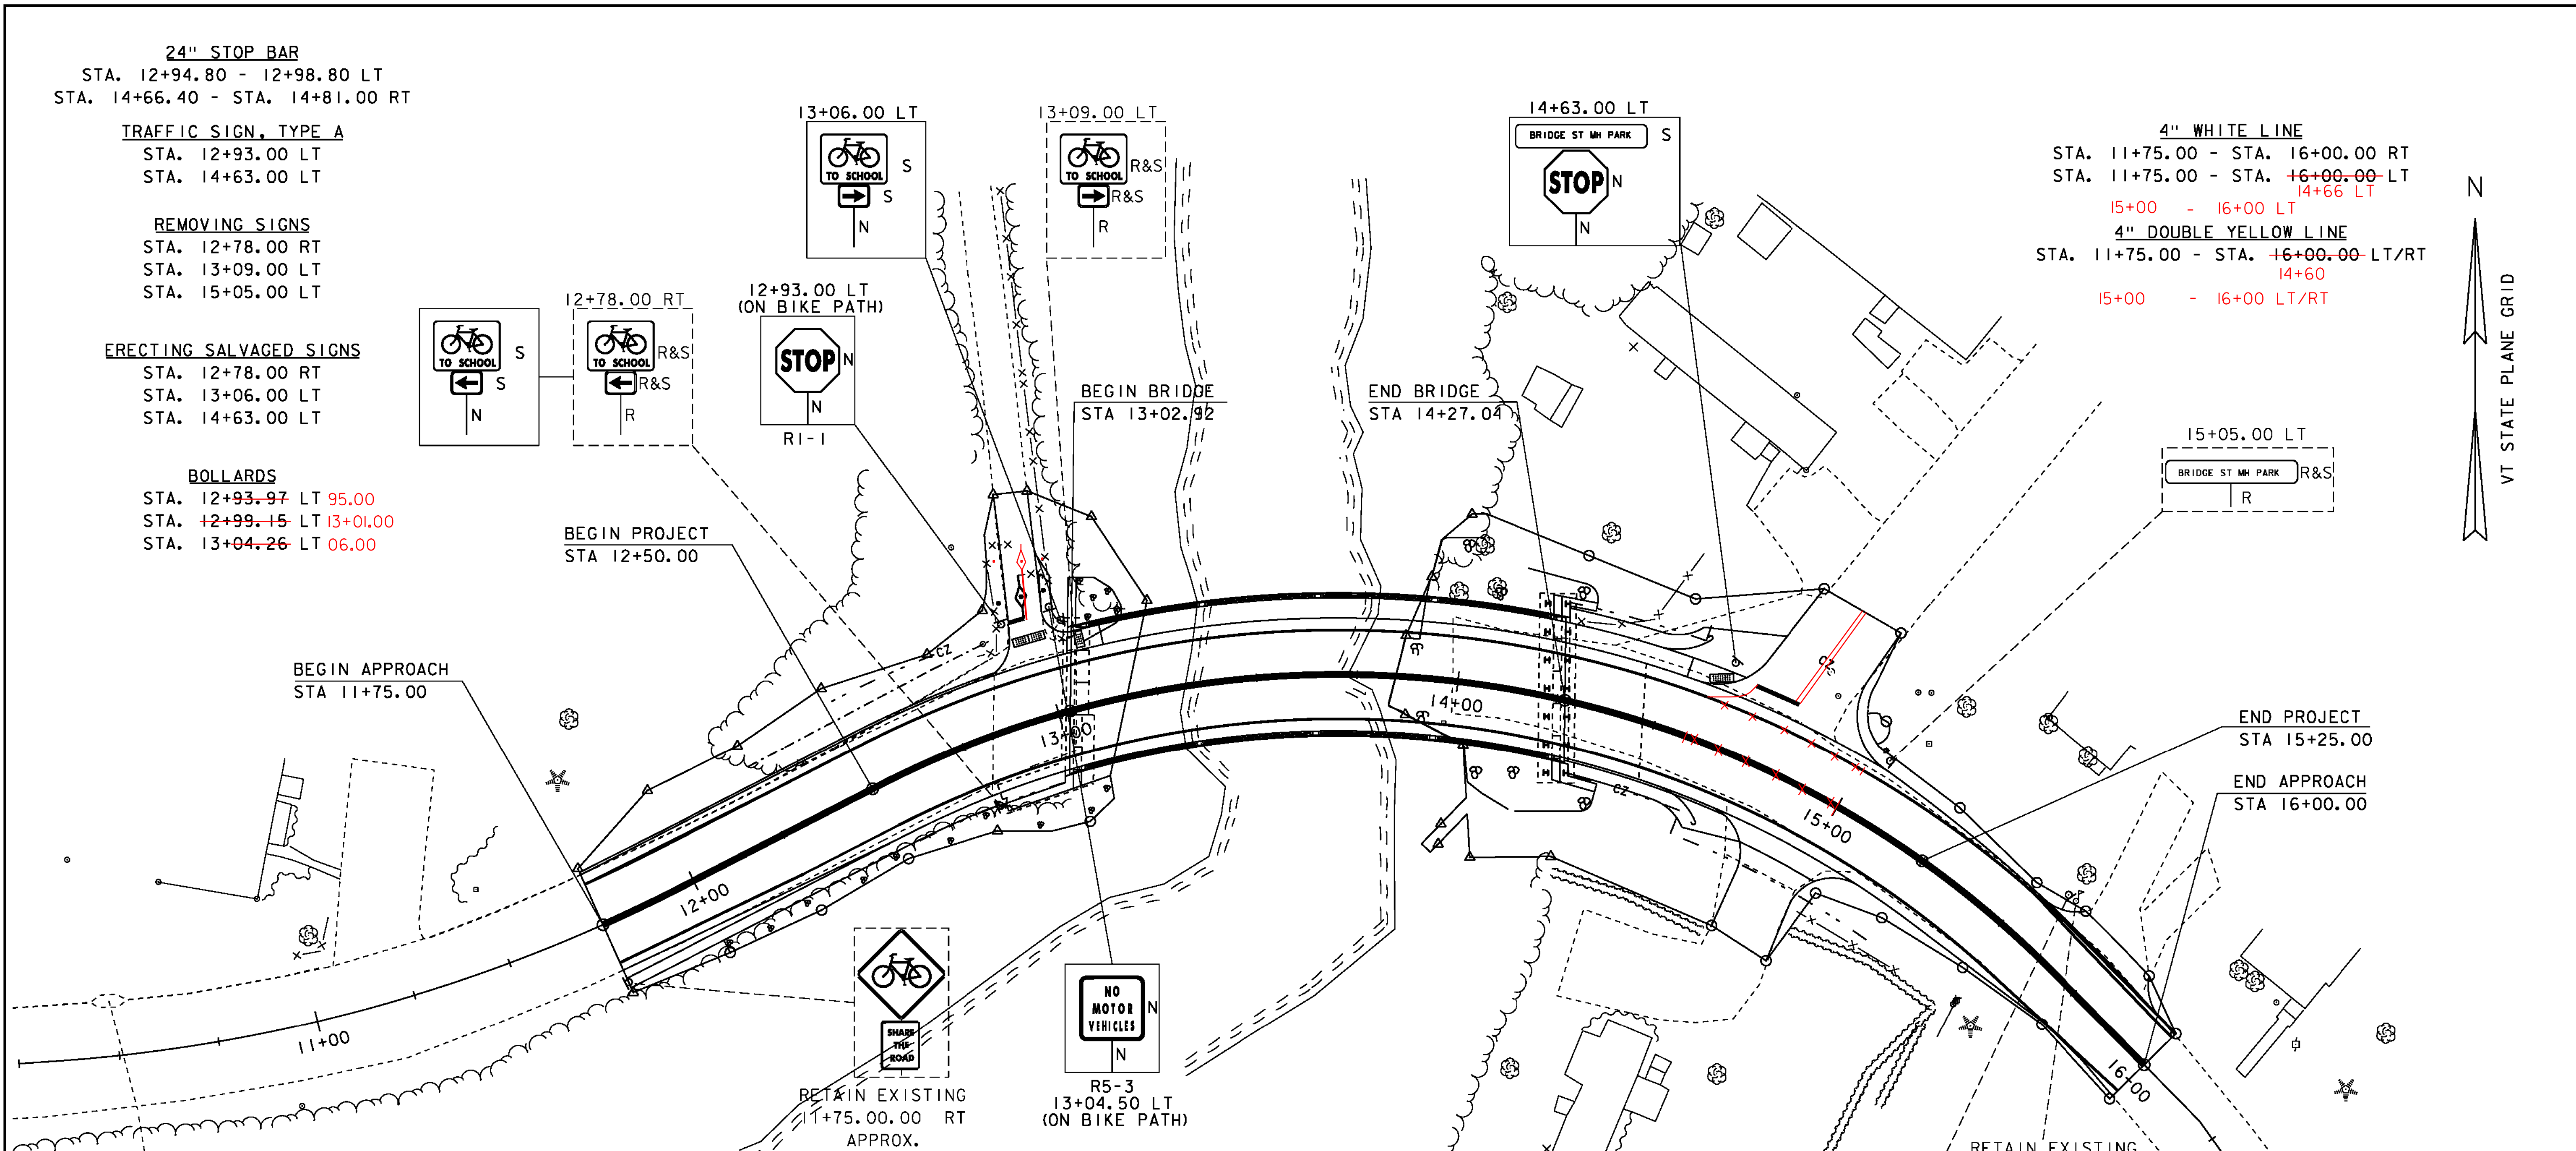

MILEMARKER, STATION, OR SIGN NUMBER	SIGN LEGEND	SIGN DIMENSIONS		NEW SIGN "A"	EXIST. SIGN SALVAGE	NO. OF POSTS	NEW SIGN POSTS SQUARE STEEL (in)			ANCHOR OR SCHEDULE	REMARKS	SIGN DETAIL	
		WIDTH (in)	HEIGHT (in)				lb/ft					DETAIL ON SHEET NUMBER	STD. SHEET NUMBER
							2.0	2.5	3.35				
12+78.00 RT						1	2.16	2.42	3.35	X	SALVAGED SIGNS		
12+93.00 LT		18	18	2.25		1	2.0	2.5	3.35	X	RI-1		SHSM
13+04.50 LT		24	24	4.00		1	2.0	2.5	3.35	X	R5-3		SHSM
13+06.00 LT						1	2.0	2.5	3.35	X	SALVAGED SIGNS		
14+63.00 LT		30	30	6.25		1	2.0	2.5	3.35	X	RI-1		SHSM
TOTALS				SF			FT	EA					
				12.50			70						

FINAL POST LENGTHS ARE TO BE DETERMINED IN THE FIELD. POST SIZES ARE COMPUTED BASED ON INFORMATION FURNISHED ON THE STANDARD SHEETS AND THE VTRANS "SIGN POST DESIGN GUIDELINE."

SHSM = FHWA STANDARD HIGHWAY SIGNS & MARKINGS BOOK

SIGN LAYOUT SHEET

SCALE 1" = 20' - 0"
 20 0 20

SIGN LEGEND

N	=	NEW
R	=	REMOVE
S	=	SALVAGE
R&S	=	REMOVE AND SALVAGE
•	=	BOLLARDS

NOTE:
 ADJUST NEW EDGE LINE TO MATCH EXISTING EDGE LINE AT BEGIN/END APPROACH

PROJECT NAME: BARRE TOWN
 PROJECT NUMBER: BRF 6100(7)

FILE NAME: s06j002sign.dgn
 PROJECT LEADER: J. LACROIX
 DESIGNED BY: J. SALVATORI
 SIGNS AND PAVEMENT MARKINGS

PLOT DATE: 09-OCT-2012
 DRAWN BY: R. PELLETT
 CHECKED BY: J. SALVATORI
 SHEET 22 OF 70