


SEE "SIDEWALK RAMP DETAIL"
THIS SHEET

BRIDGE RAIL ELEVATION LEFT SIDE (INTERIOR FACE)


SCALE: 1" = 5'-0"

NOTE: MEASUREMENTS GIVEN ALONG CENTERLINE OF RAIL AND HORIZONTALLY FROM TOP OF SIDEWALK/CURB.

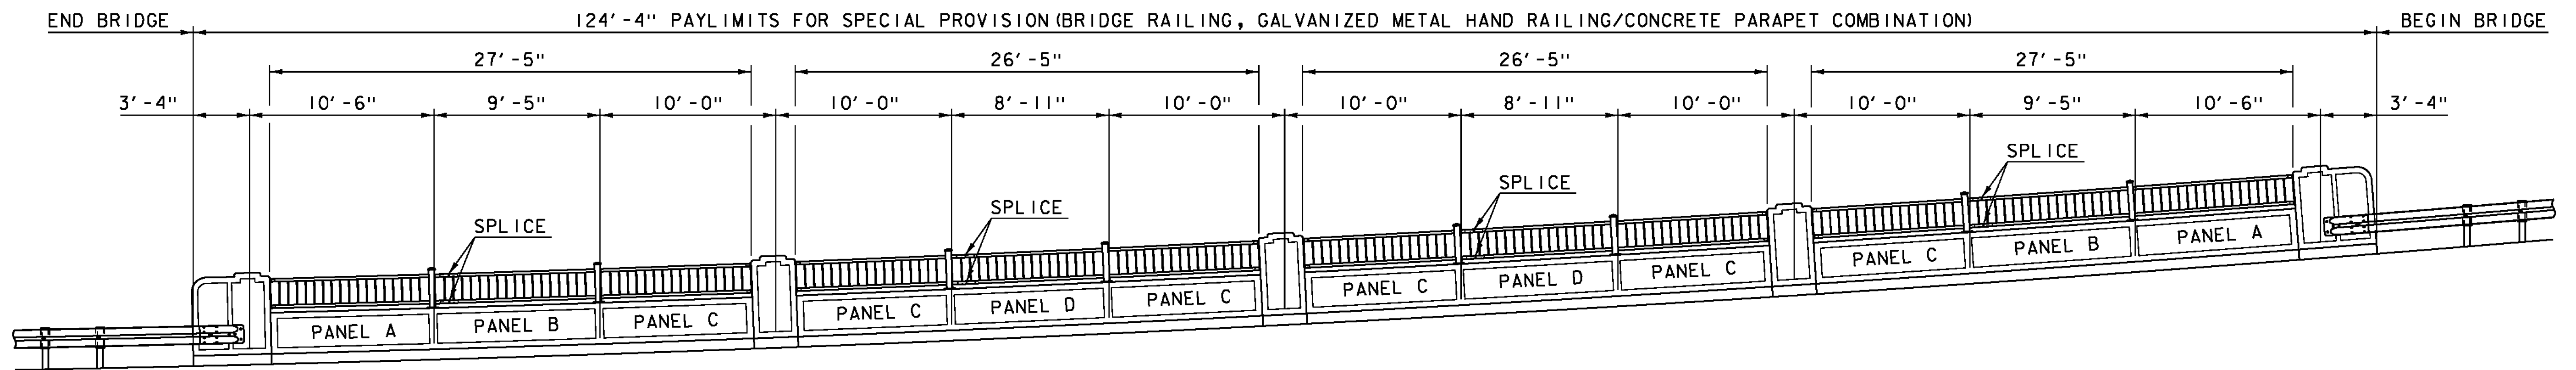


BRIDGE RAIL ELEVATION RIGHT SIDE (INTERIOR FACE)

SCALE: 1" = 5'-0"

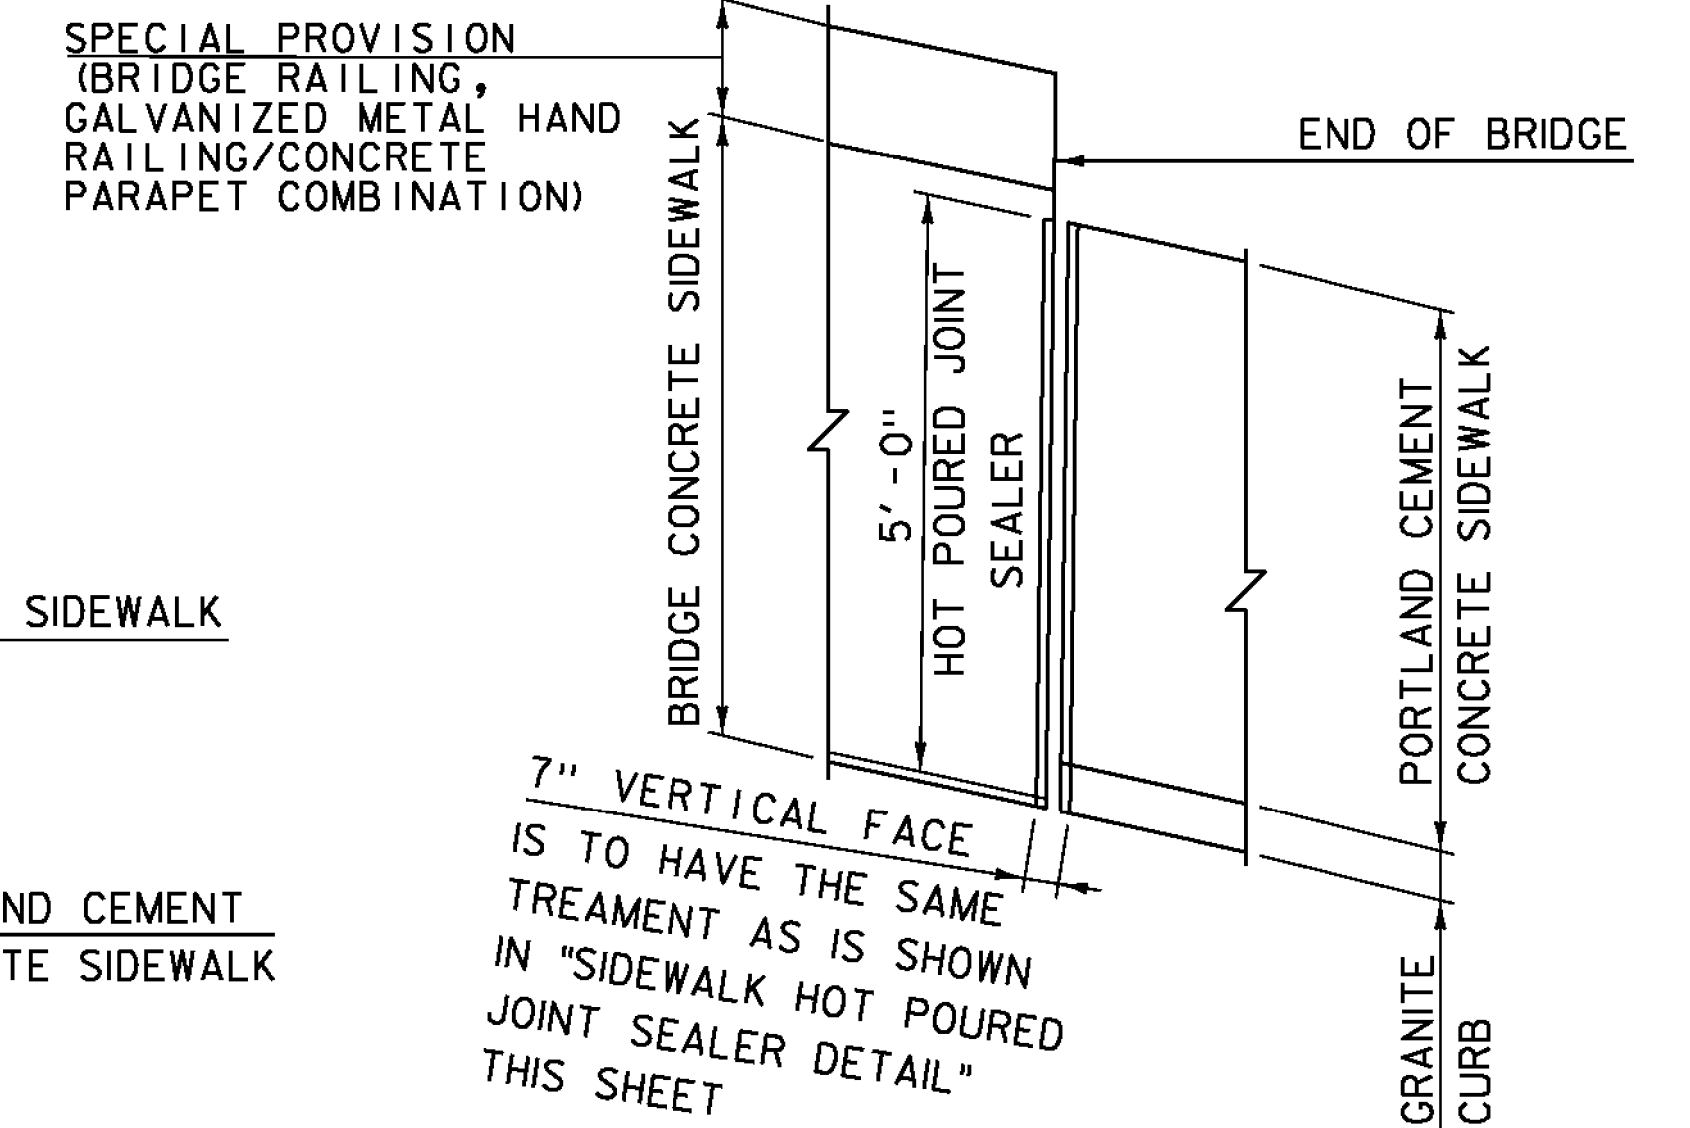


SIDEWALK HOT POURED JOINT SEALER PLAN

NTS

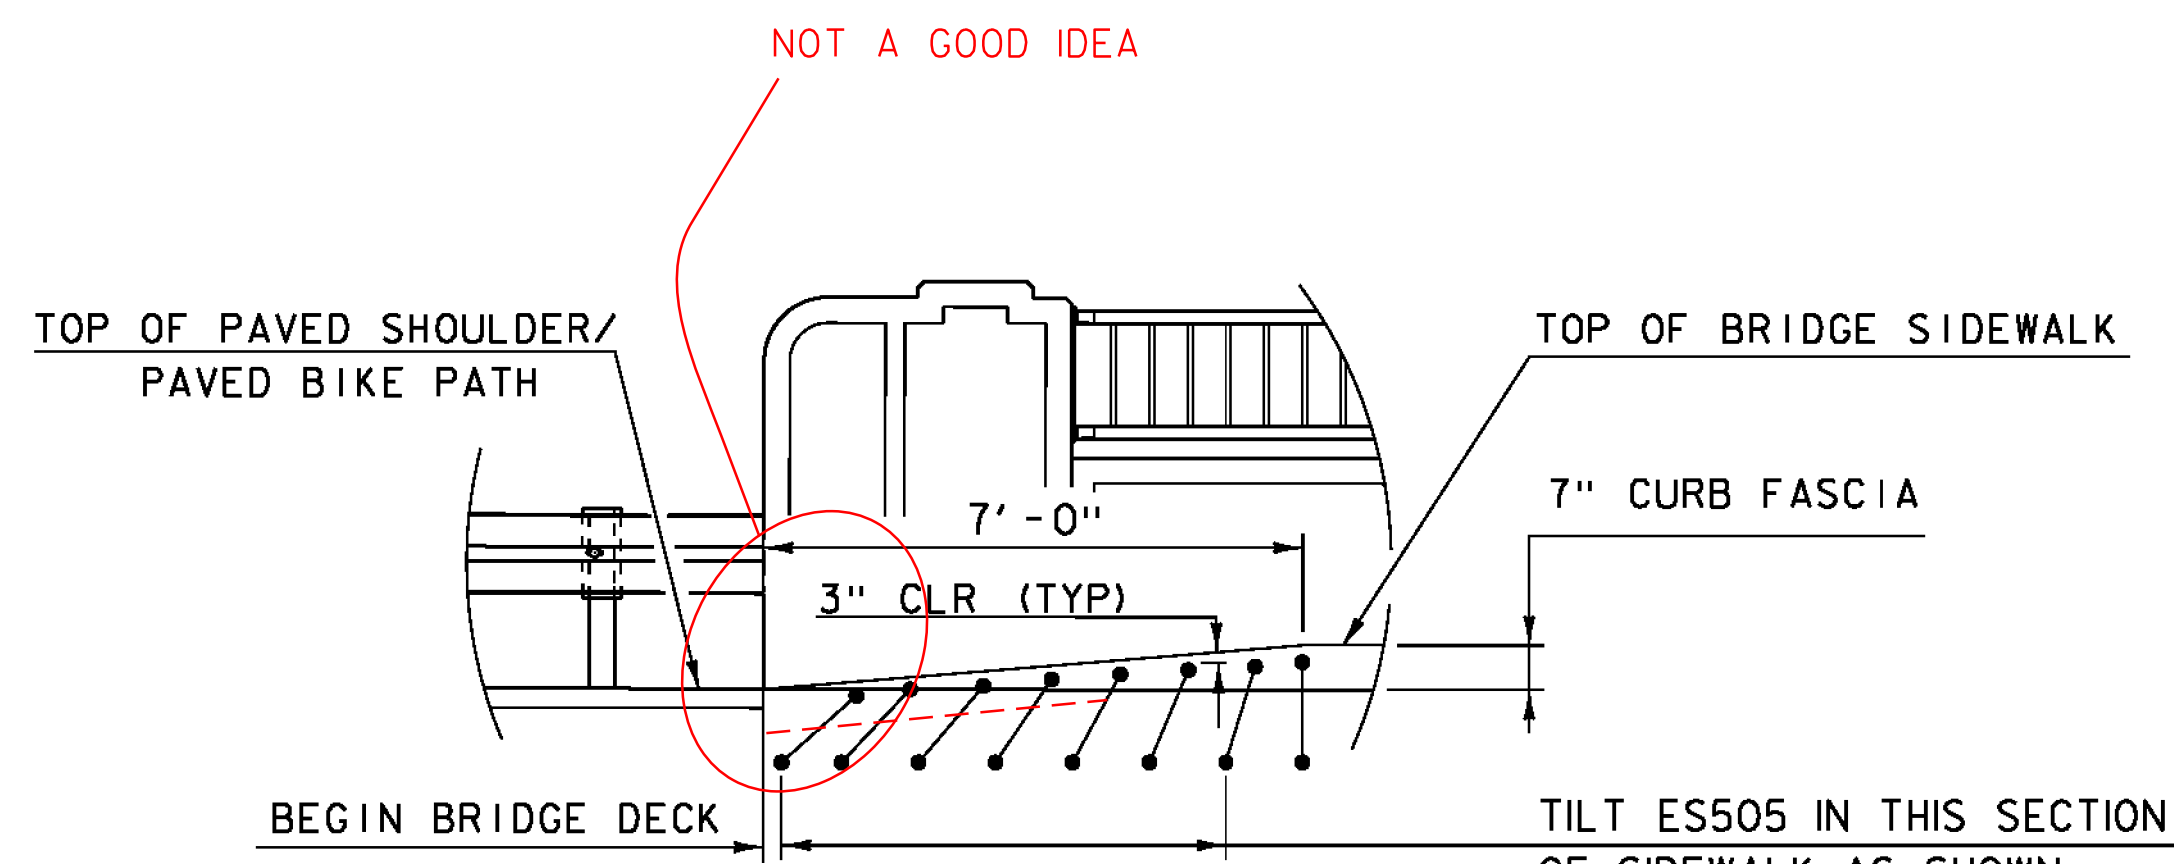

SIDEWALK RAMP DETAIL

NTS

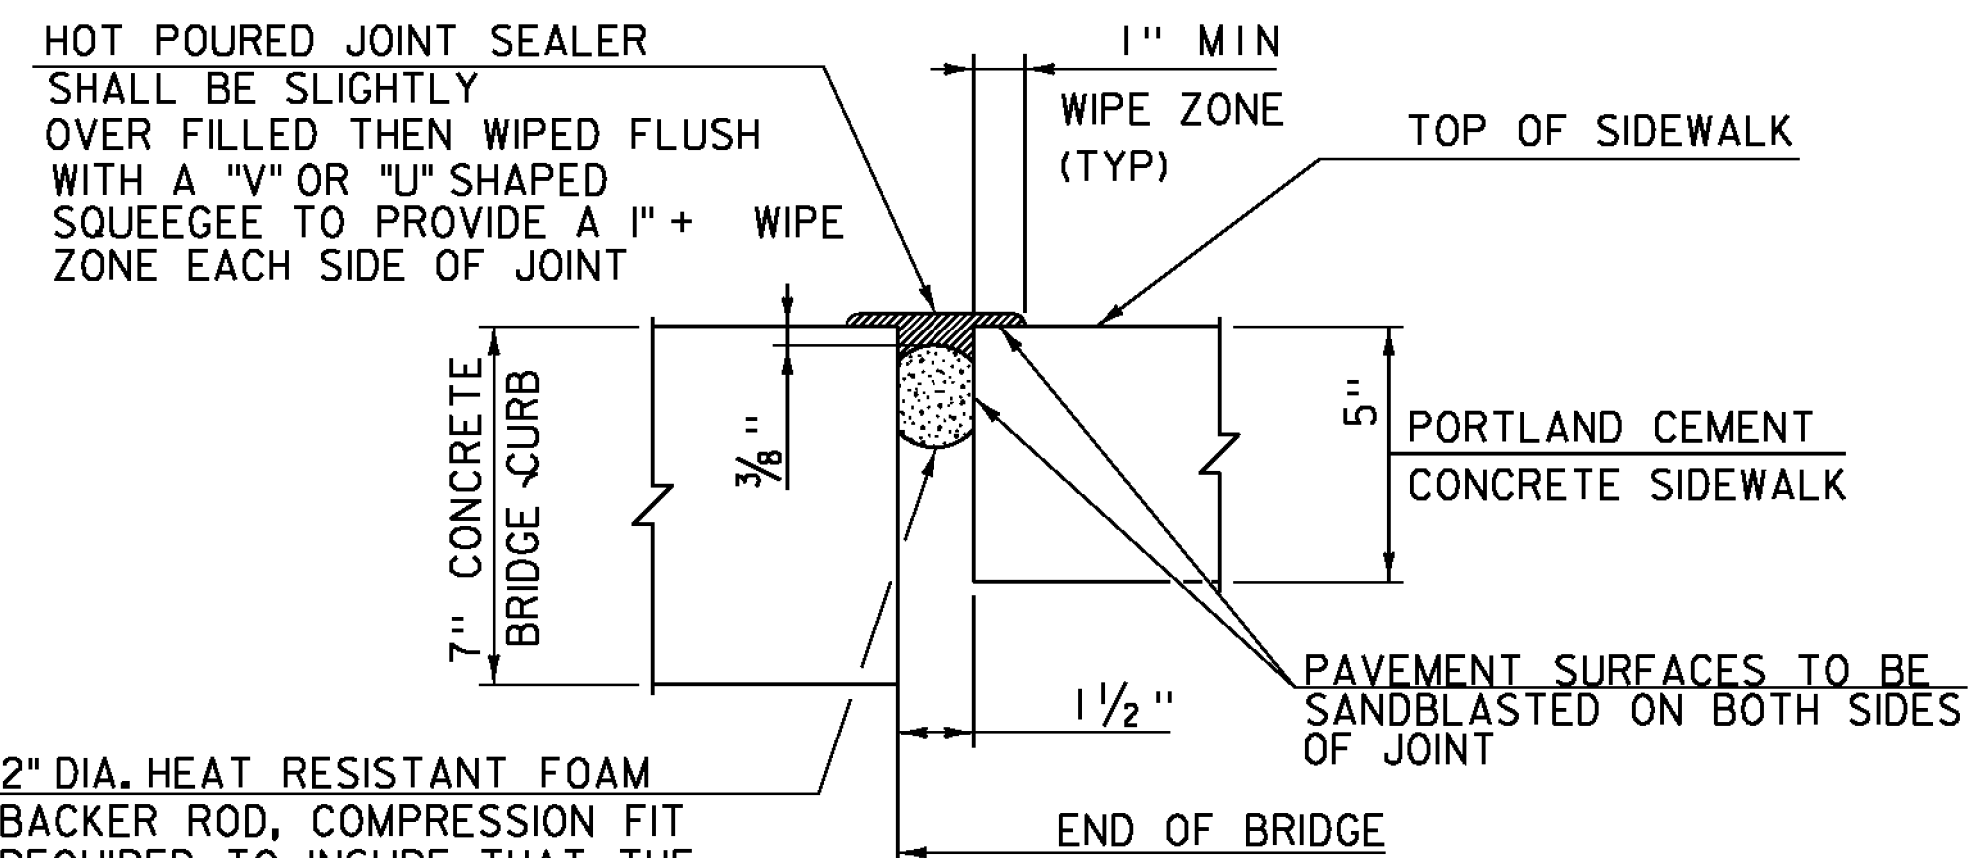

2" DIA. HEAT RESISTANT FOAM BACKER ROD, COMPRESSION FIT REQUIRED TO INSURE THAT THE ROD POSITION IS MAINTAINED DURING FILLING OPERATION. COST TO BE INCLUDED WITH UNIT PRICE BID FOR JOINT SEALER.

SIDEWALK HOT POURED JOINT SEALER DETAIL

NTS

PROJECT NAME: BARRE TOWN
PROJECT NUMBER: BRF 6100(7)

FILE NAME: s06j002raildet.dgn
PROJECT LEADER: J. LACROIX
DESIGNED BY: G. ROY
BRIDGE RAIL ELEVATIONS

PLOT DATE: 27-SEP-2012
DRAWN BY: G. ROY
CHECKED BY: J. SALVATORI
SHEET 30 OF 70