




**TOP FLANGE PLAN  
GIRDERS 1 & 2  
SCALE 1" = 1'-0"**

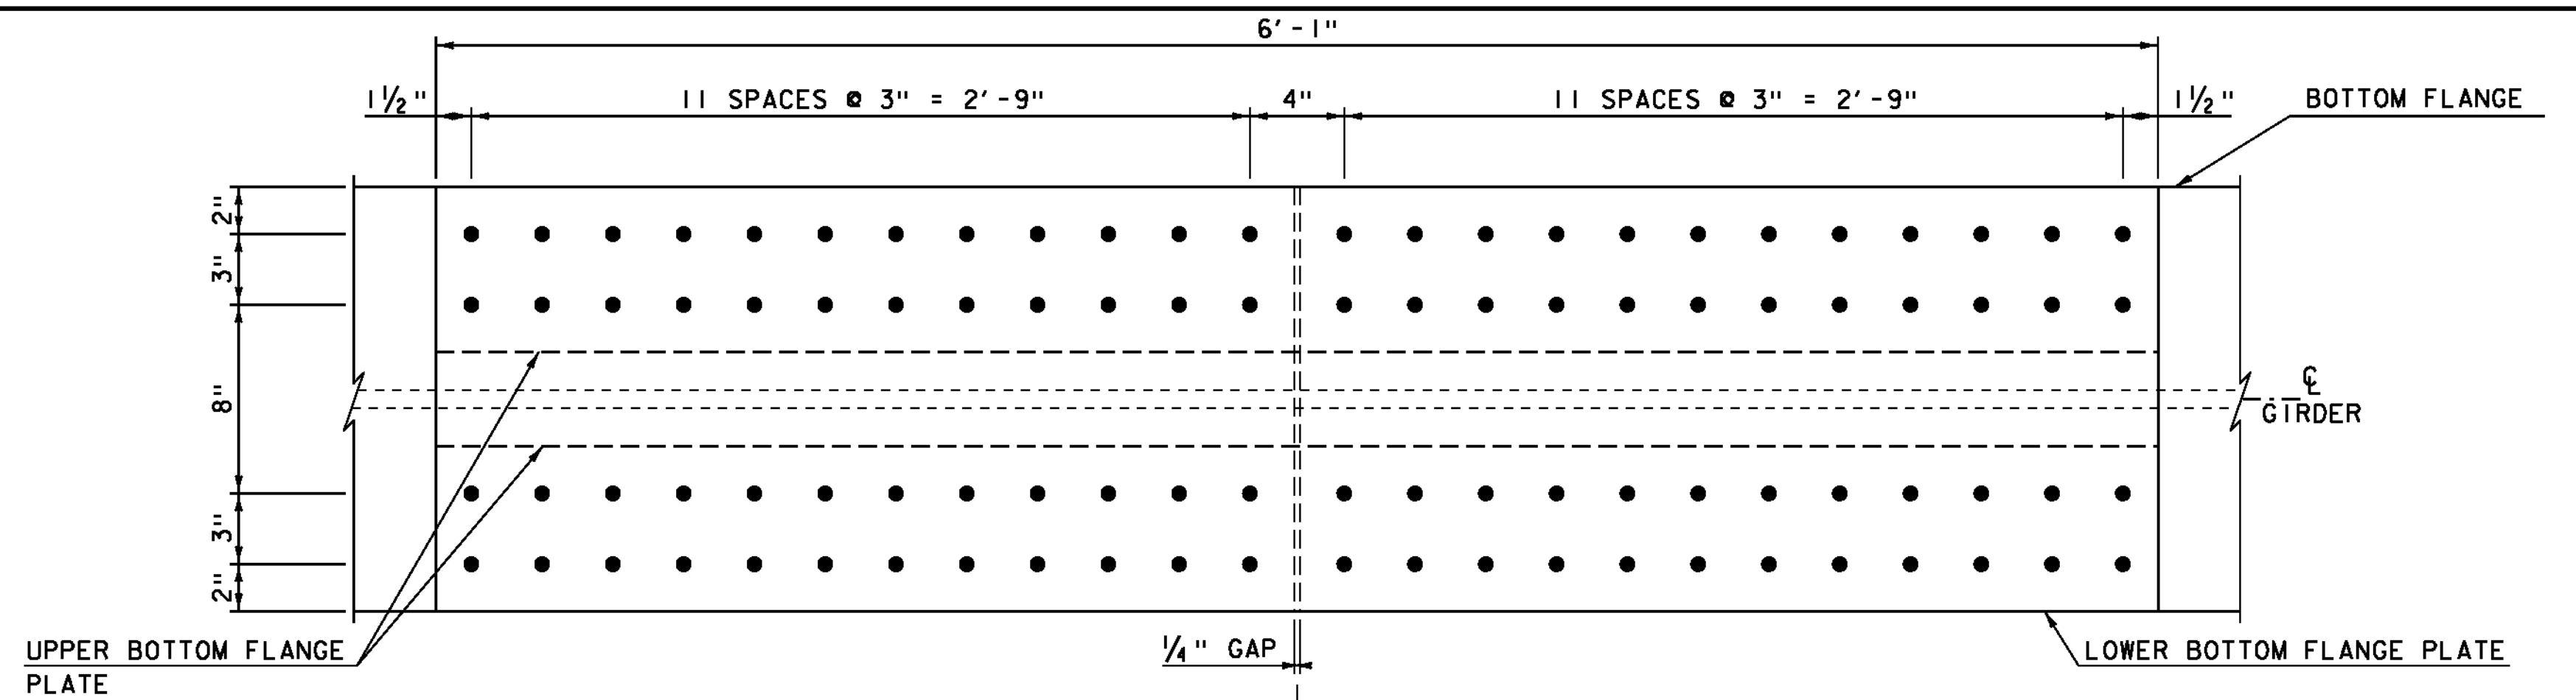

**BOTTOM FLANGE PLAN  
GIRDERS 1 & 2  
SCALE 1" = 1'-0"**

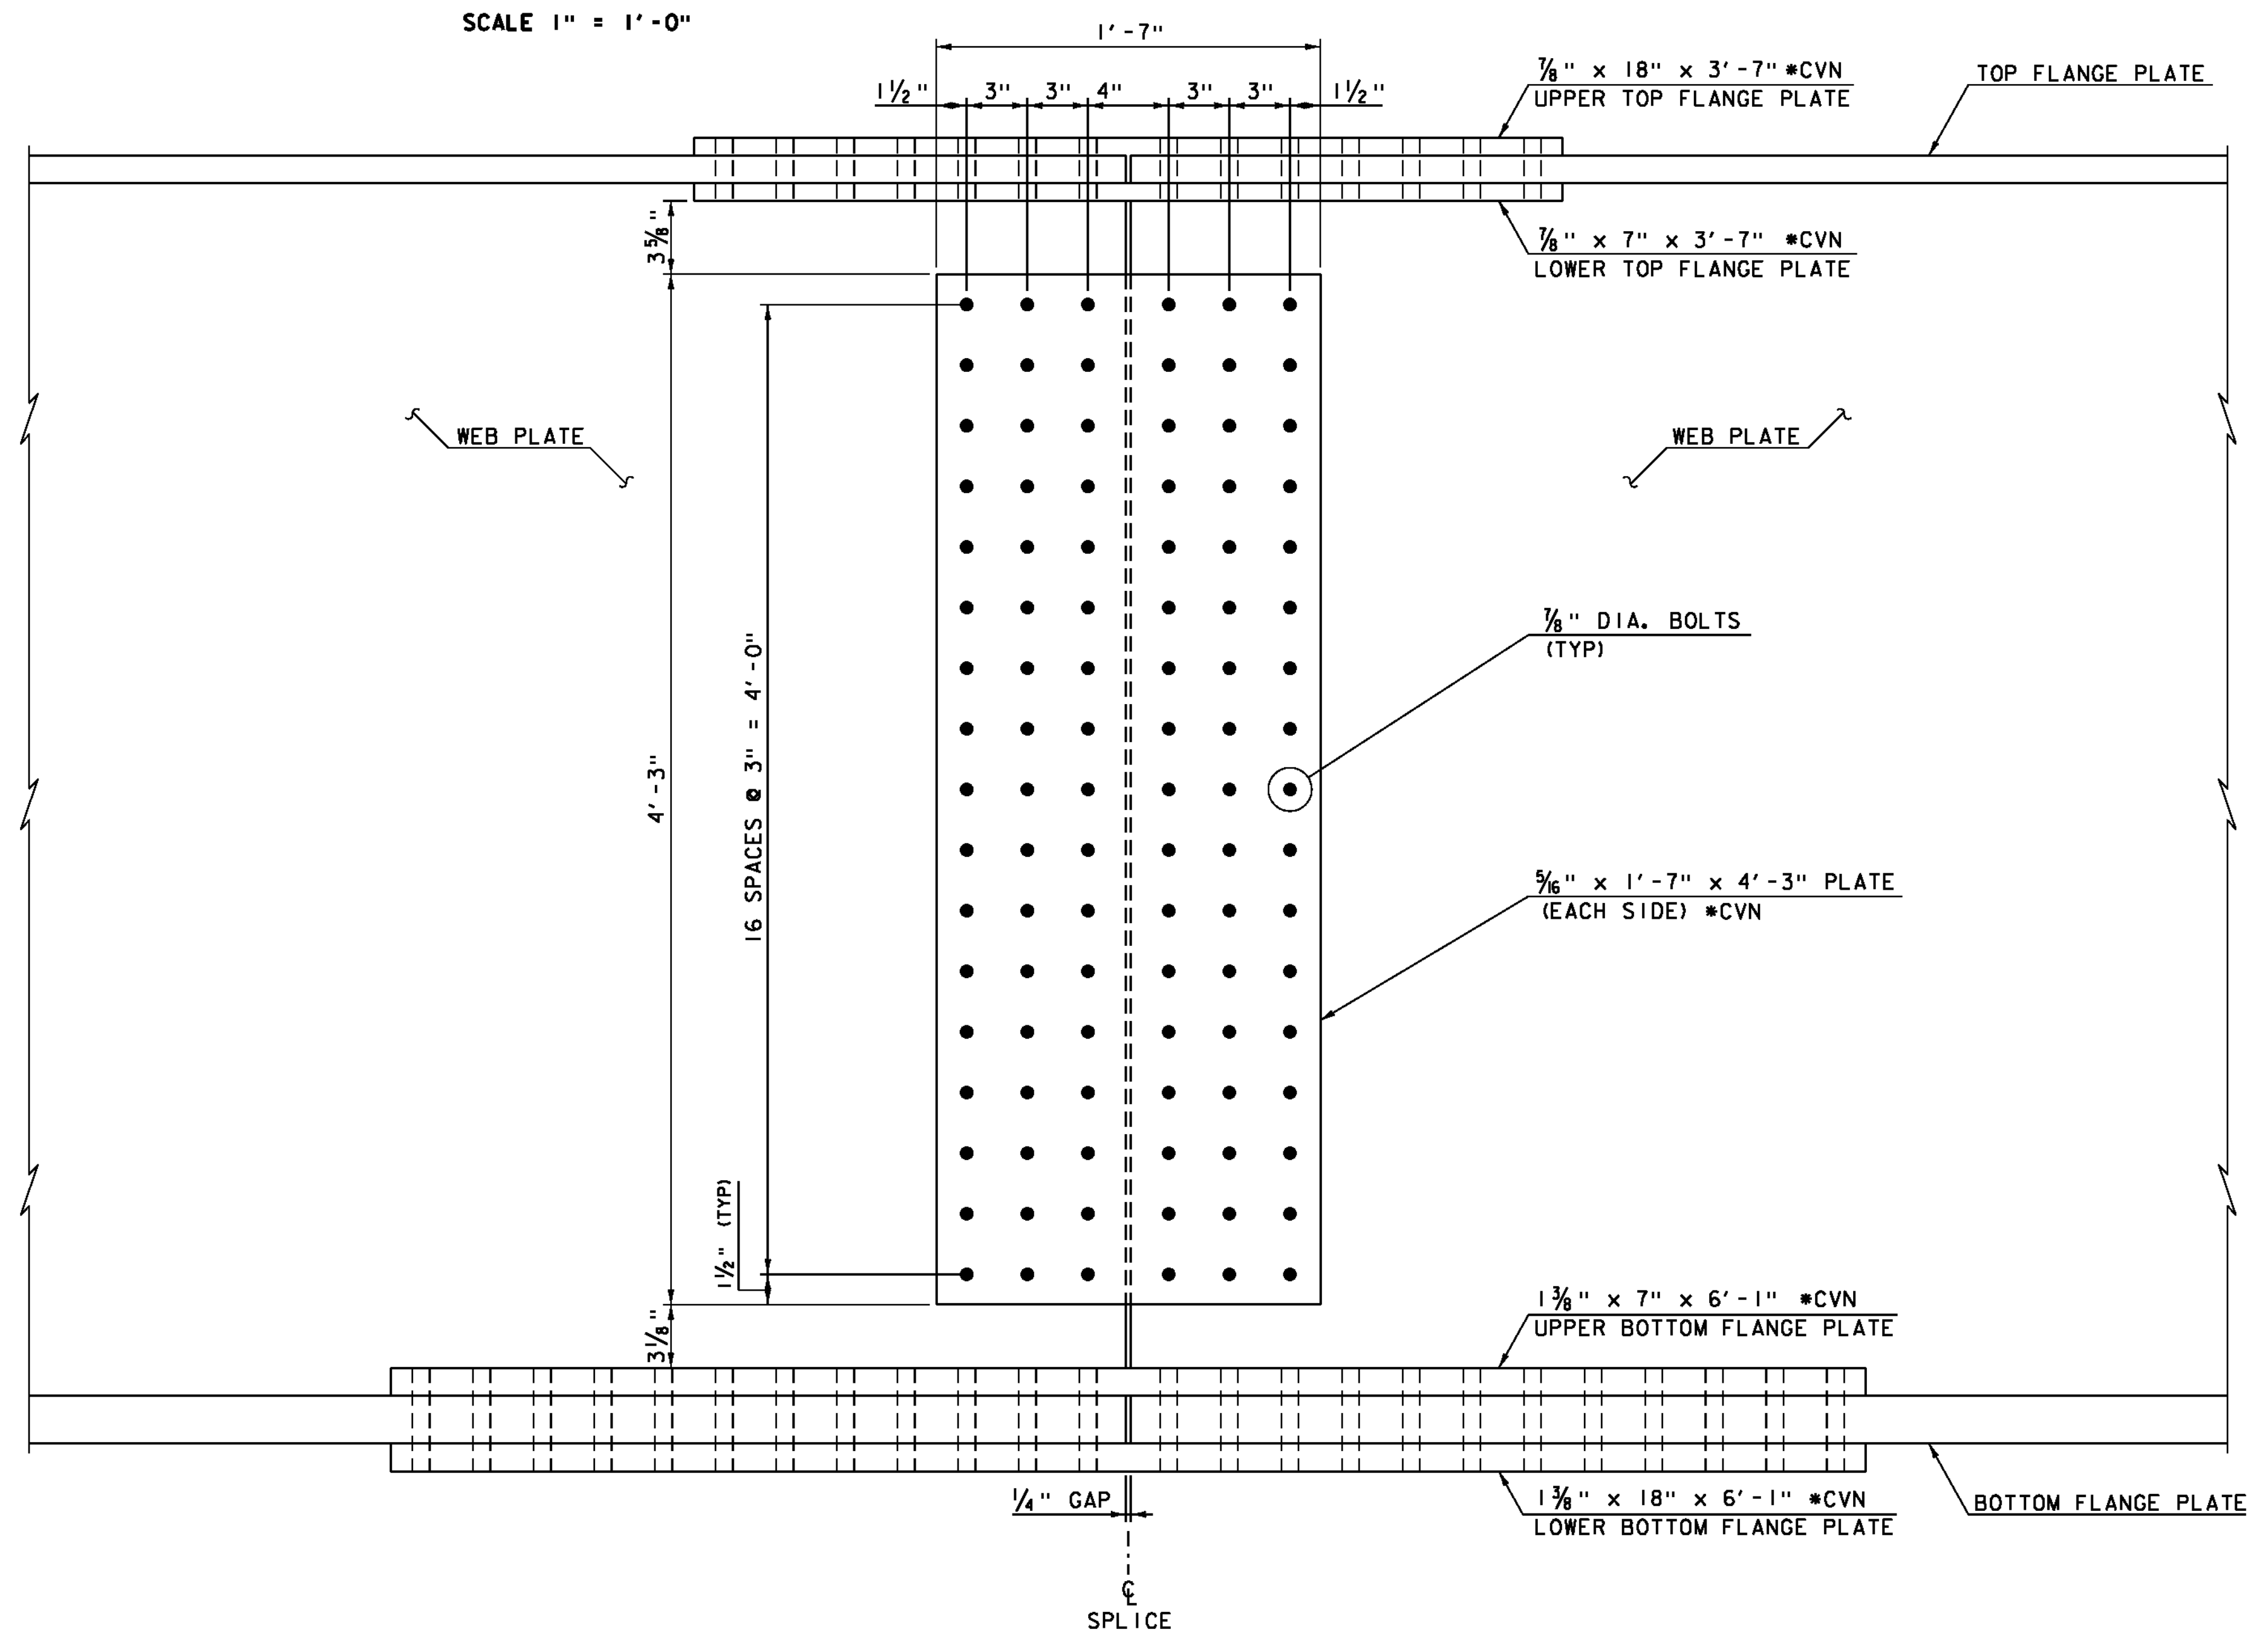

**SPLICE ELEVATION  
GIRDERS 1 & 2  
SCALE 1" = 1'-0"**

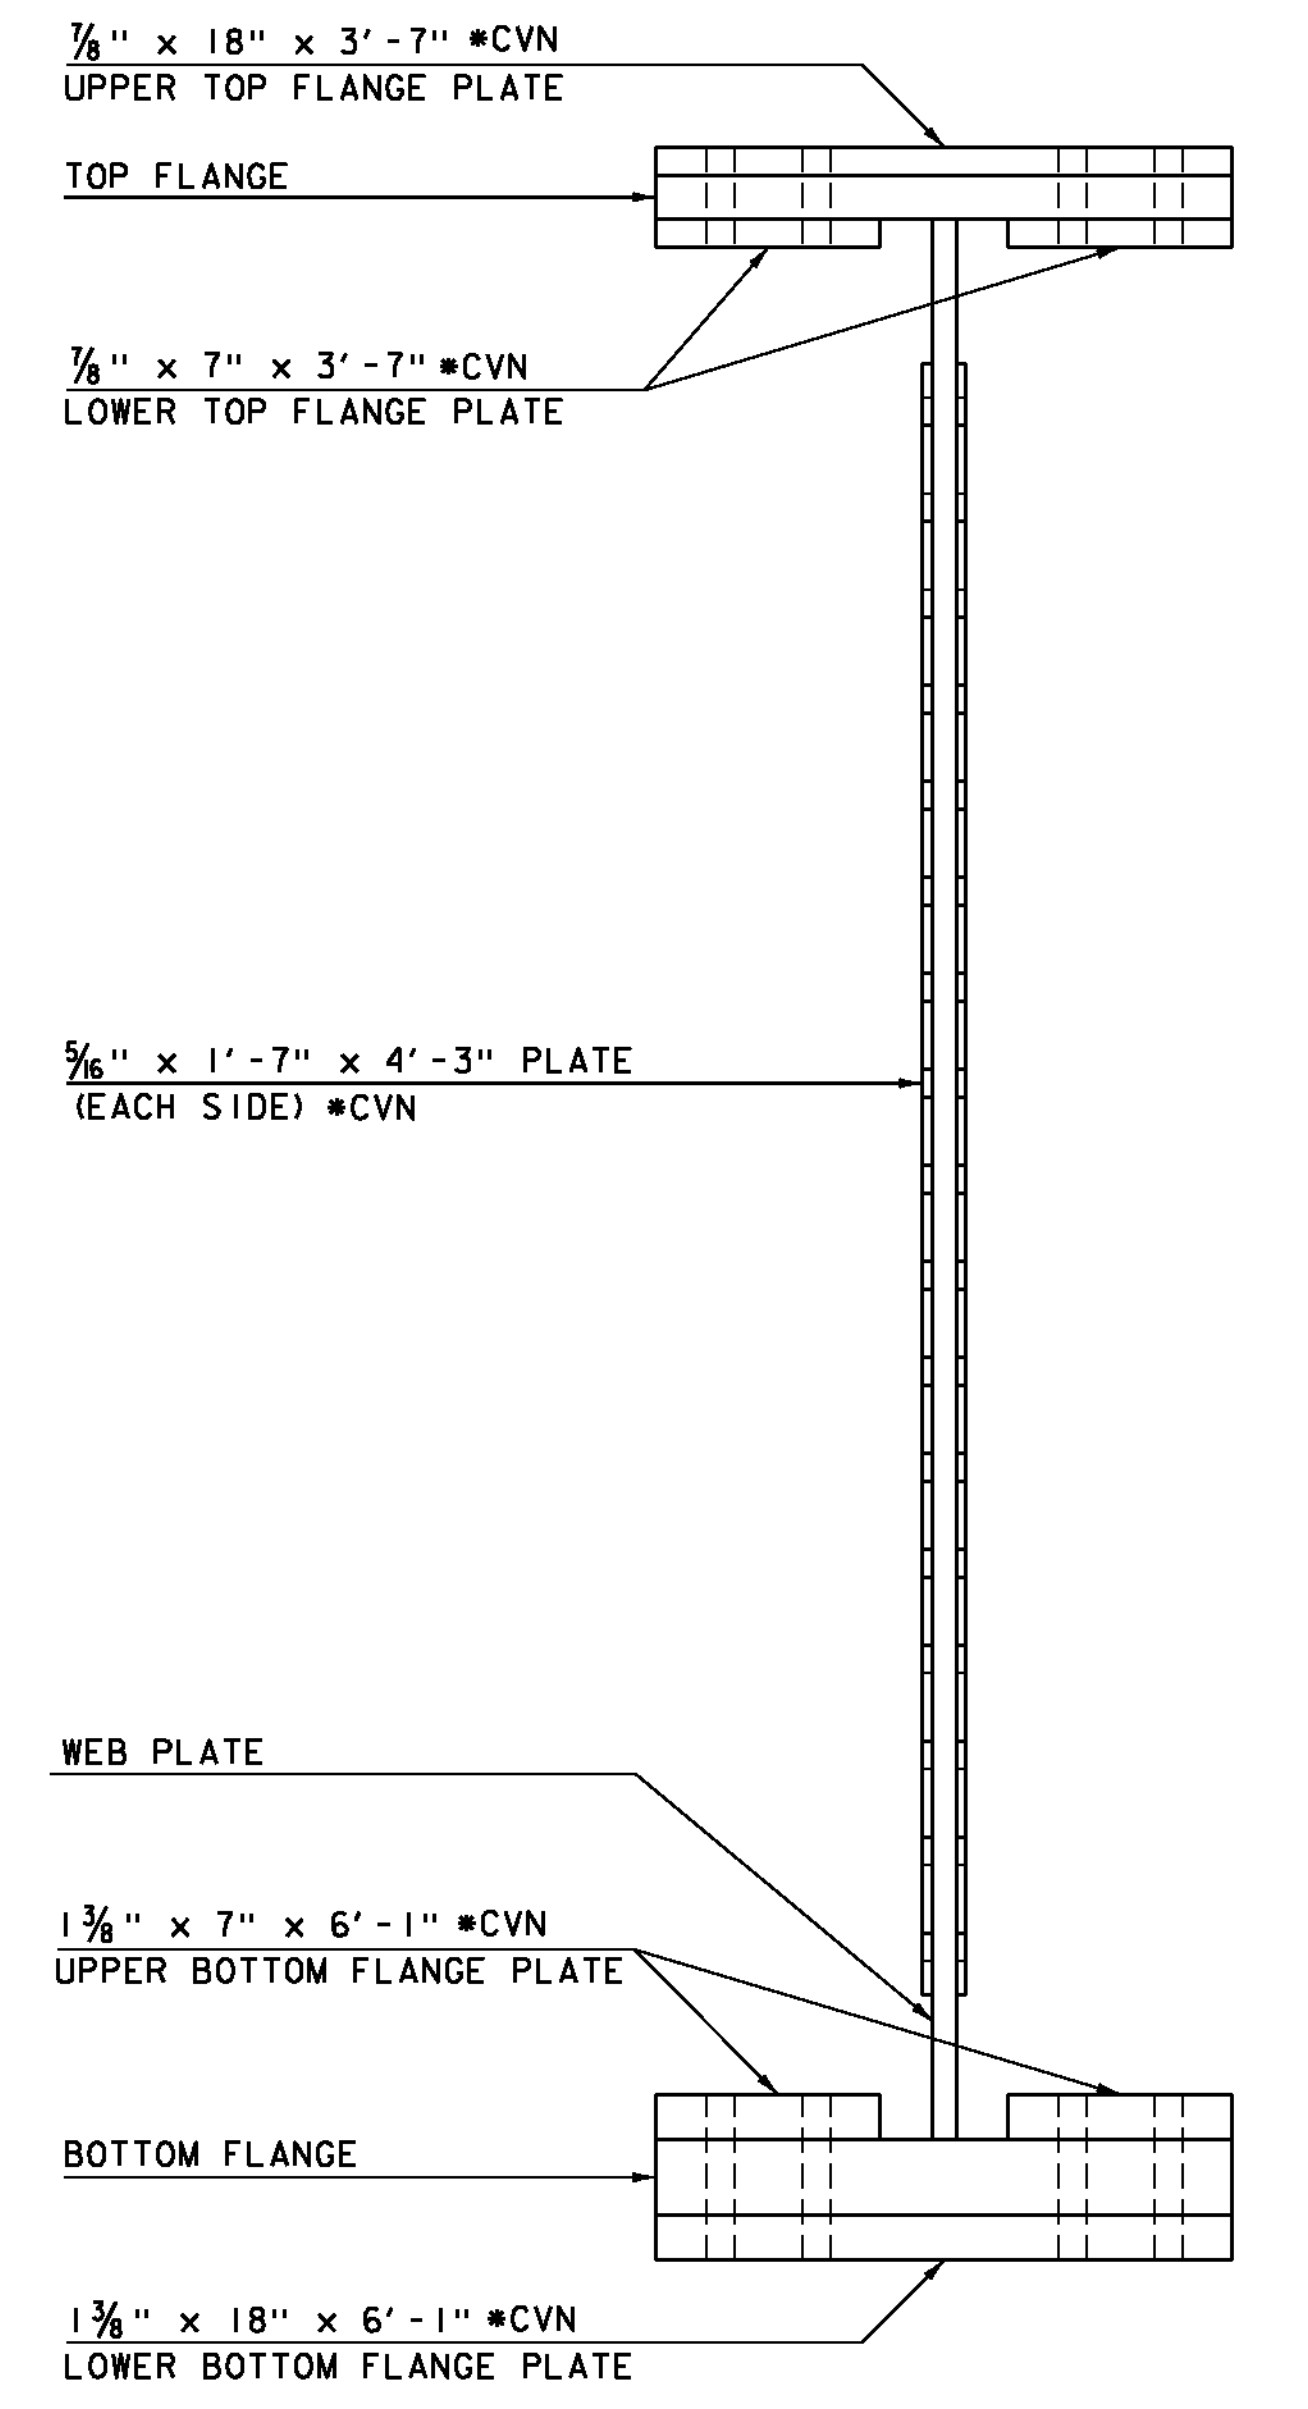

**SPLICE SECTION  
GIRDERS 1 & 2  
SCALE 1" = 1'-0"**

\*CVN DENOTES THAT CHARPY V-NOTCH TEST IS REQUIRED

PROJECT NAME: BARRE TOWN	PLOT DATE: 27-SEP-2012
PROJECT NUMBER: BRF 6100(7)	DRAWN BY: R. PELLETT
FILE NAME: s06j002sup.dgn	CHECKED BY: T. FILLBACH
PROJECT LEADER: J. LACROIX	SHEET 38 OF 70
DESIGNED BY: J. LACROIX	
SPLICE DETAIL I	