



ABUTMENT 2 PLAN
SCALE 1/4" = 1' - 0"

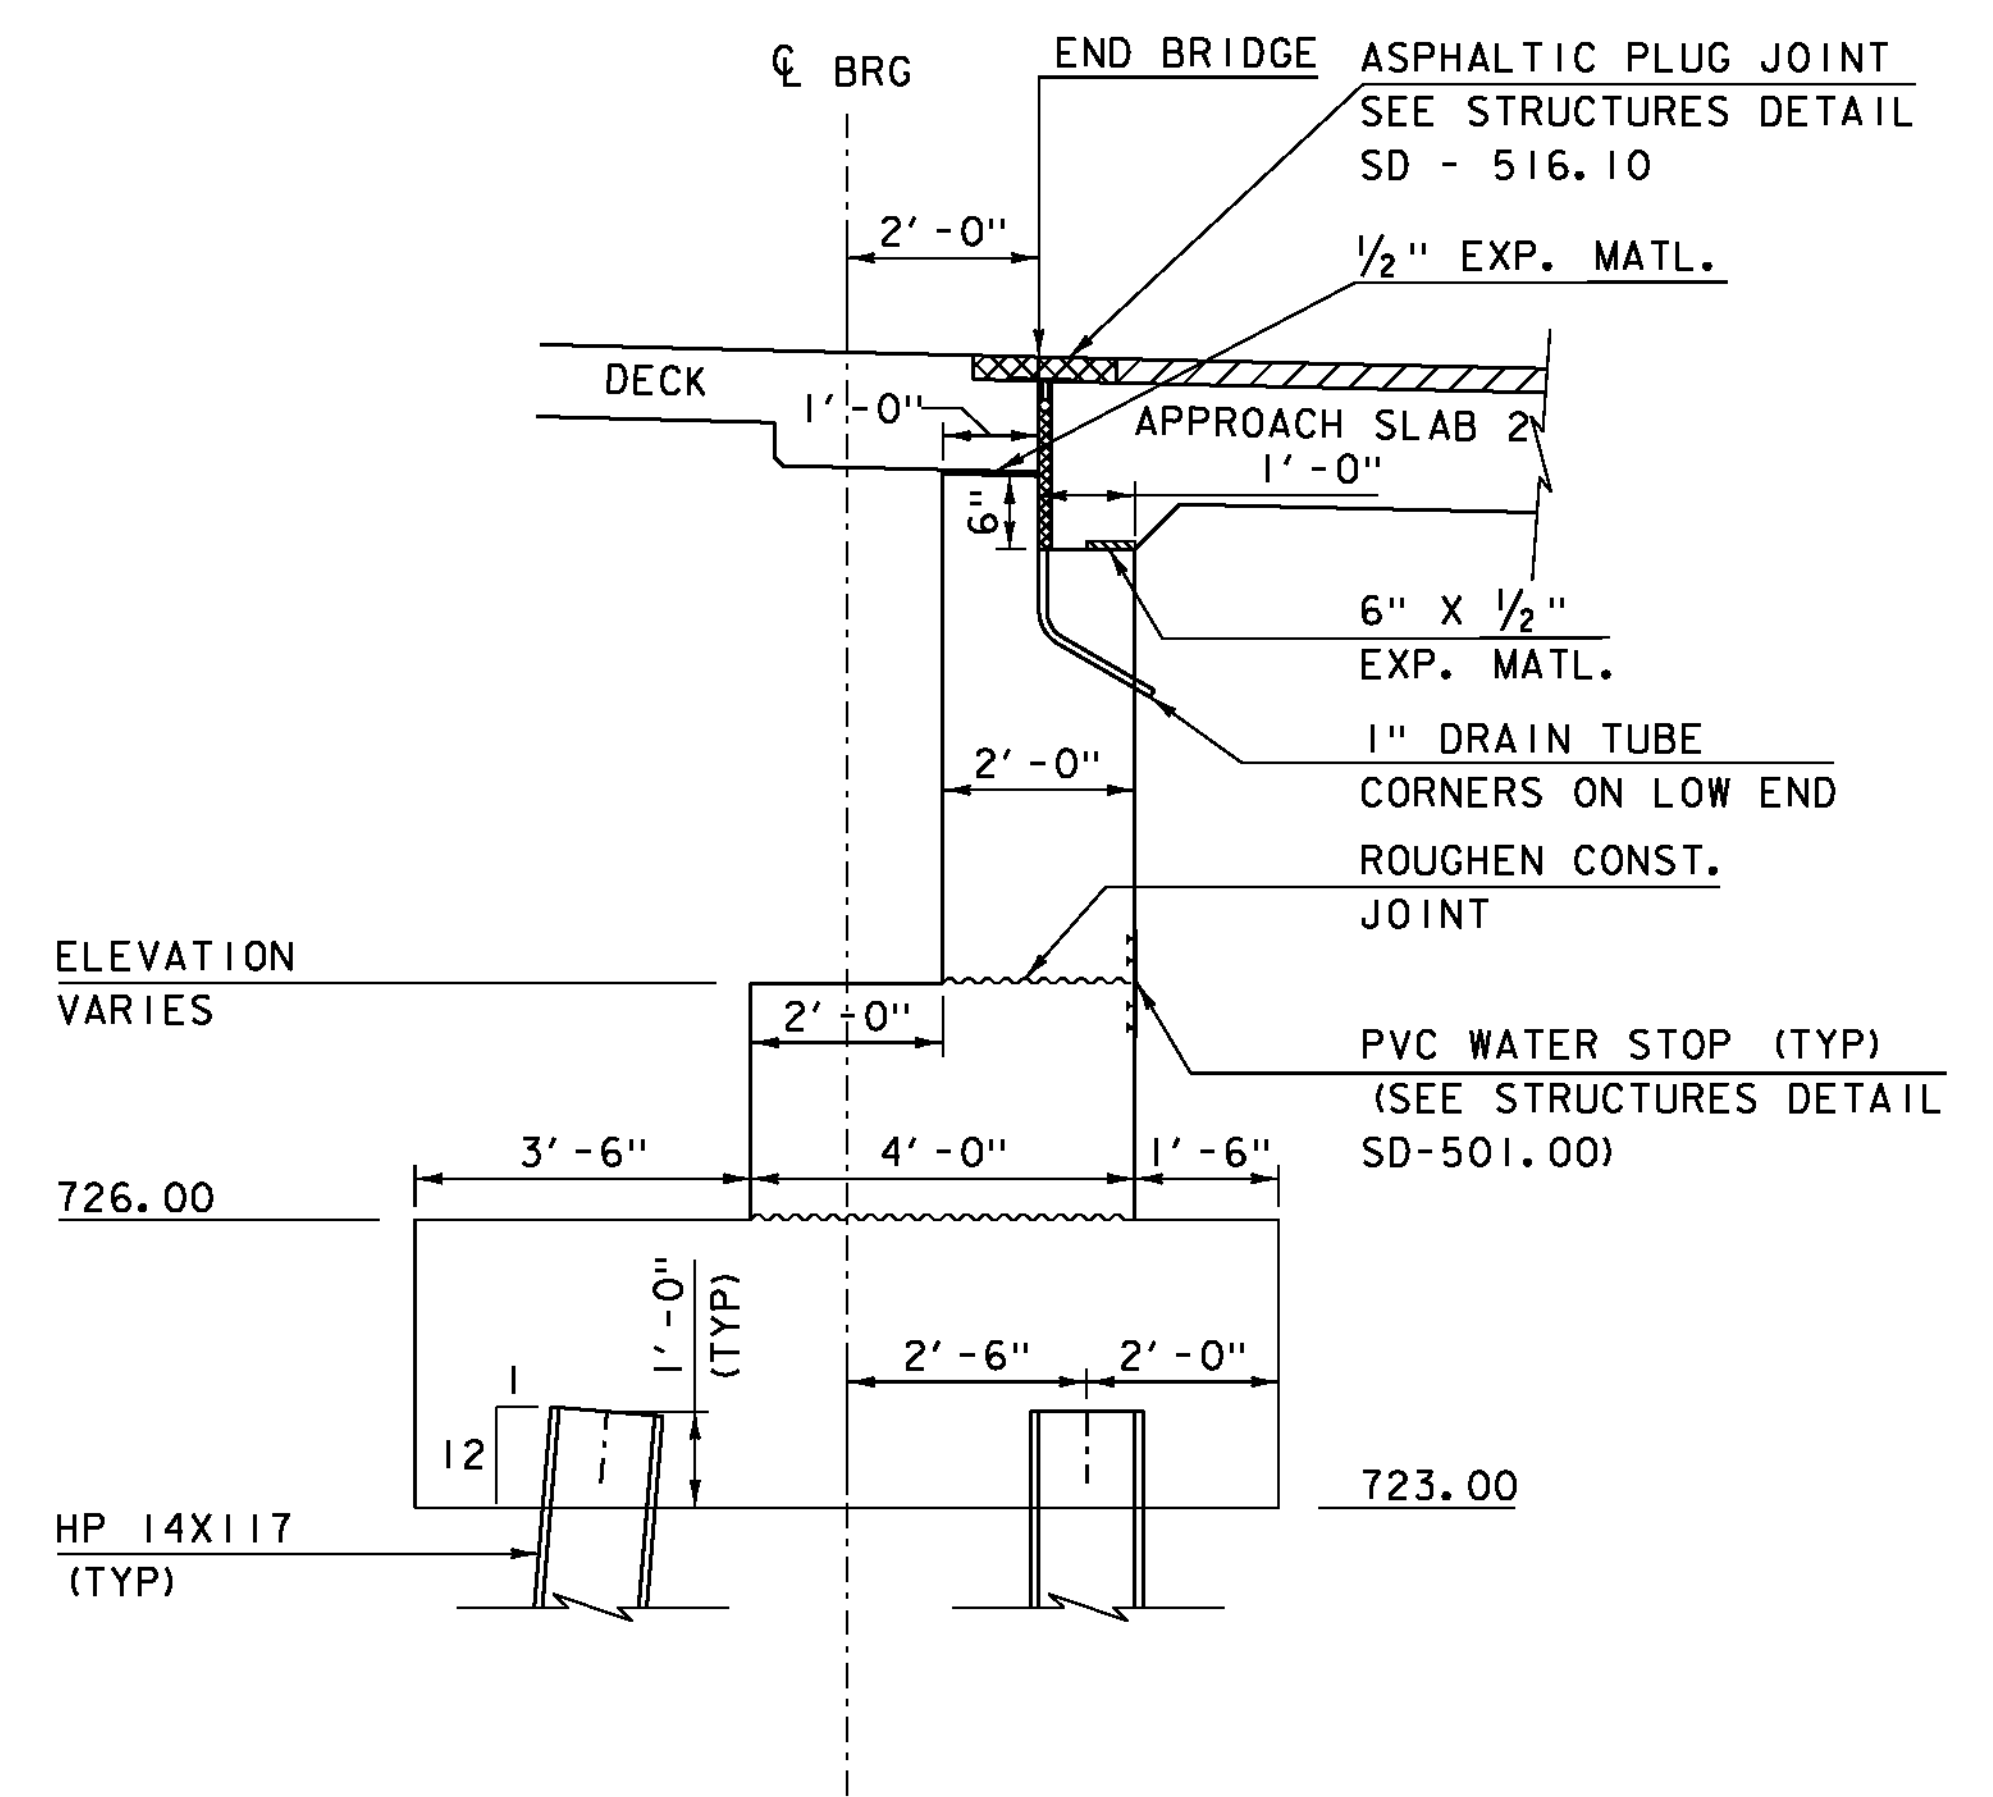

**ABUTMENT 2
BRIDGE END DETAIL SECTION A-A**
SCALE 1/2" = 1' - 0"

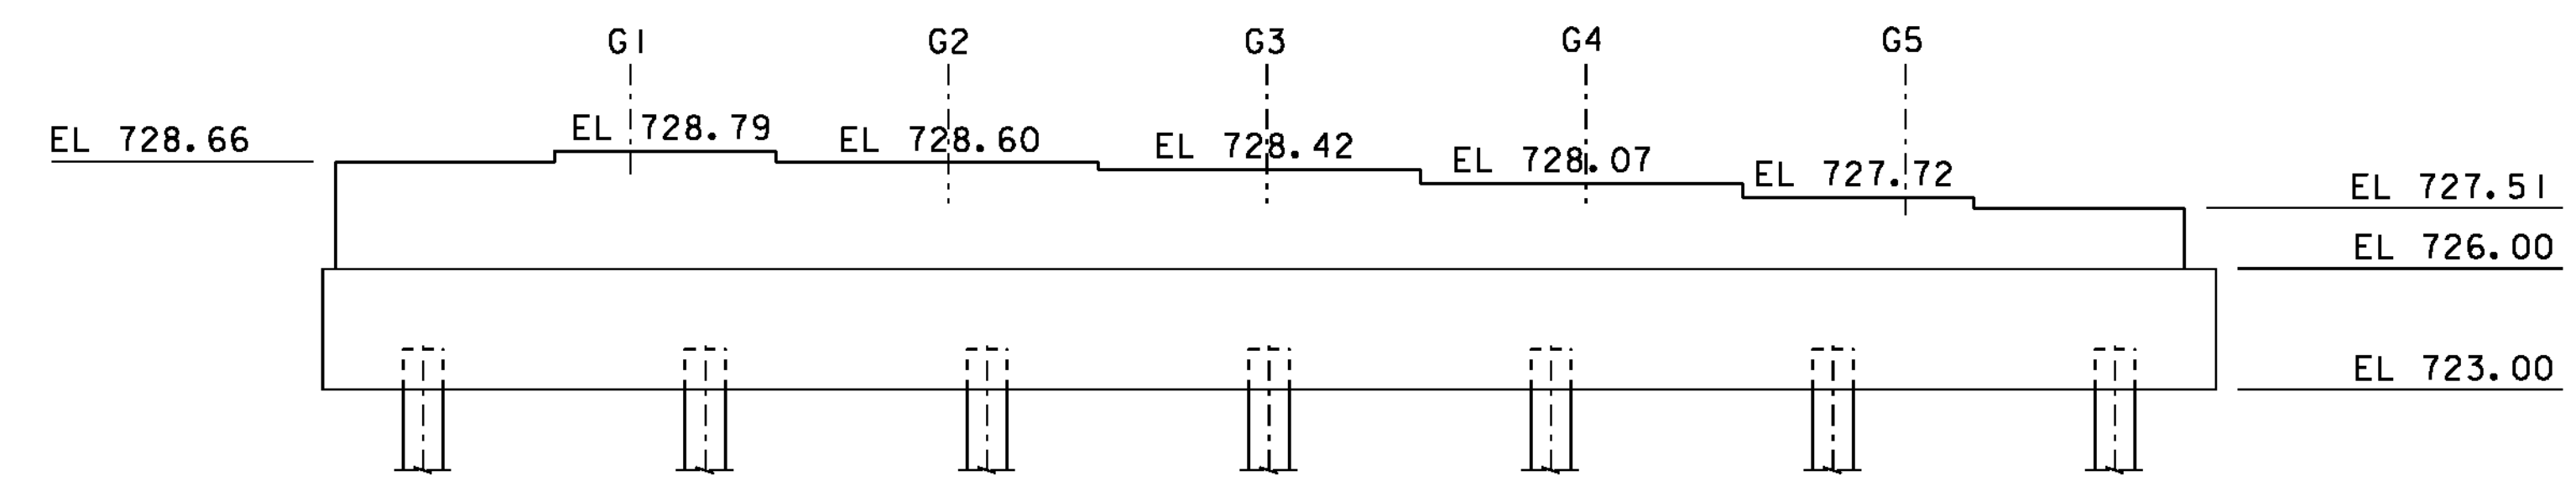

ABUTMENT 2 ELEVATION
SCALE 1/4" = 1' - 0"

NOTE: SEE STRUCTURE DETAILS "SD-501.00" AND "SD-502.00".

NOTE: BACKWALL NOT SHOWN. FOR BACKWALL INFORMATION SEE "ABUTMENT 2 BACKWALL DETAILS"

PROJECT NAME: BARRE TOWN	
PROJECT NUMBER: BRF 6100 (7)	
FILE NAME: s06j002sub2.dgn	PLOT DATE: 09-OCT-2012
PROJECT LEADER: J. LACROIX	DRAWN BY: K.FRIEDLAND
DESIGNED BY: T.FILLBACH	CHECKED BY: J.SALVATORI
ABUTMENT 2	SHEET 48 OF 70