




12+00

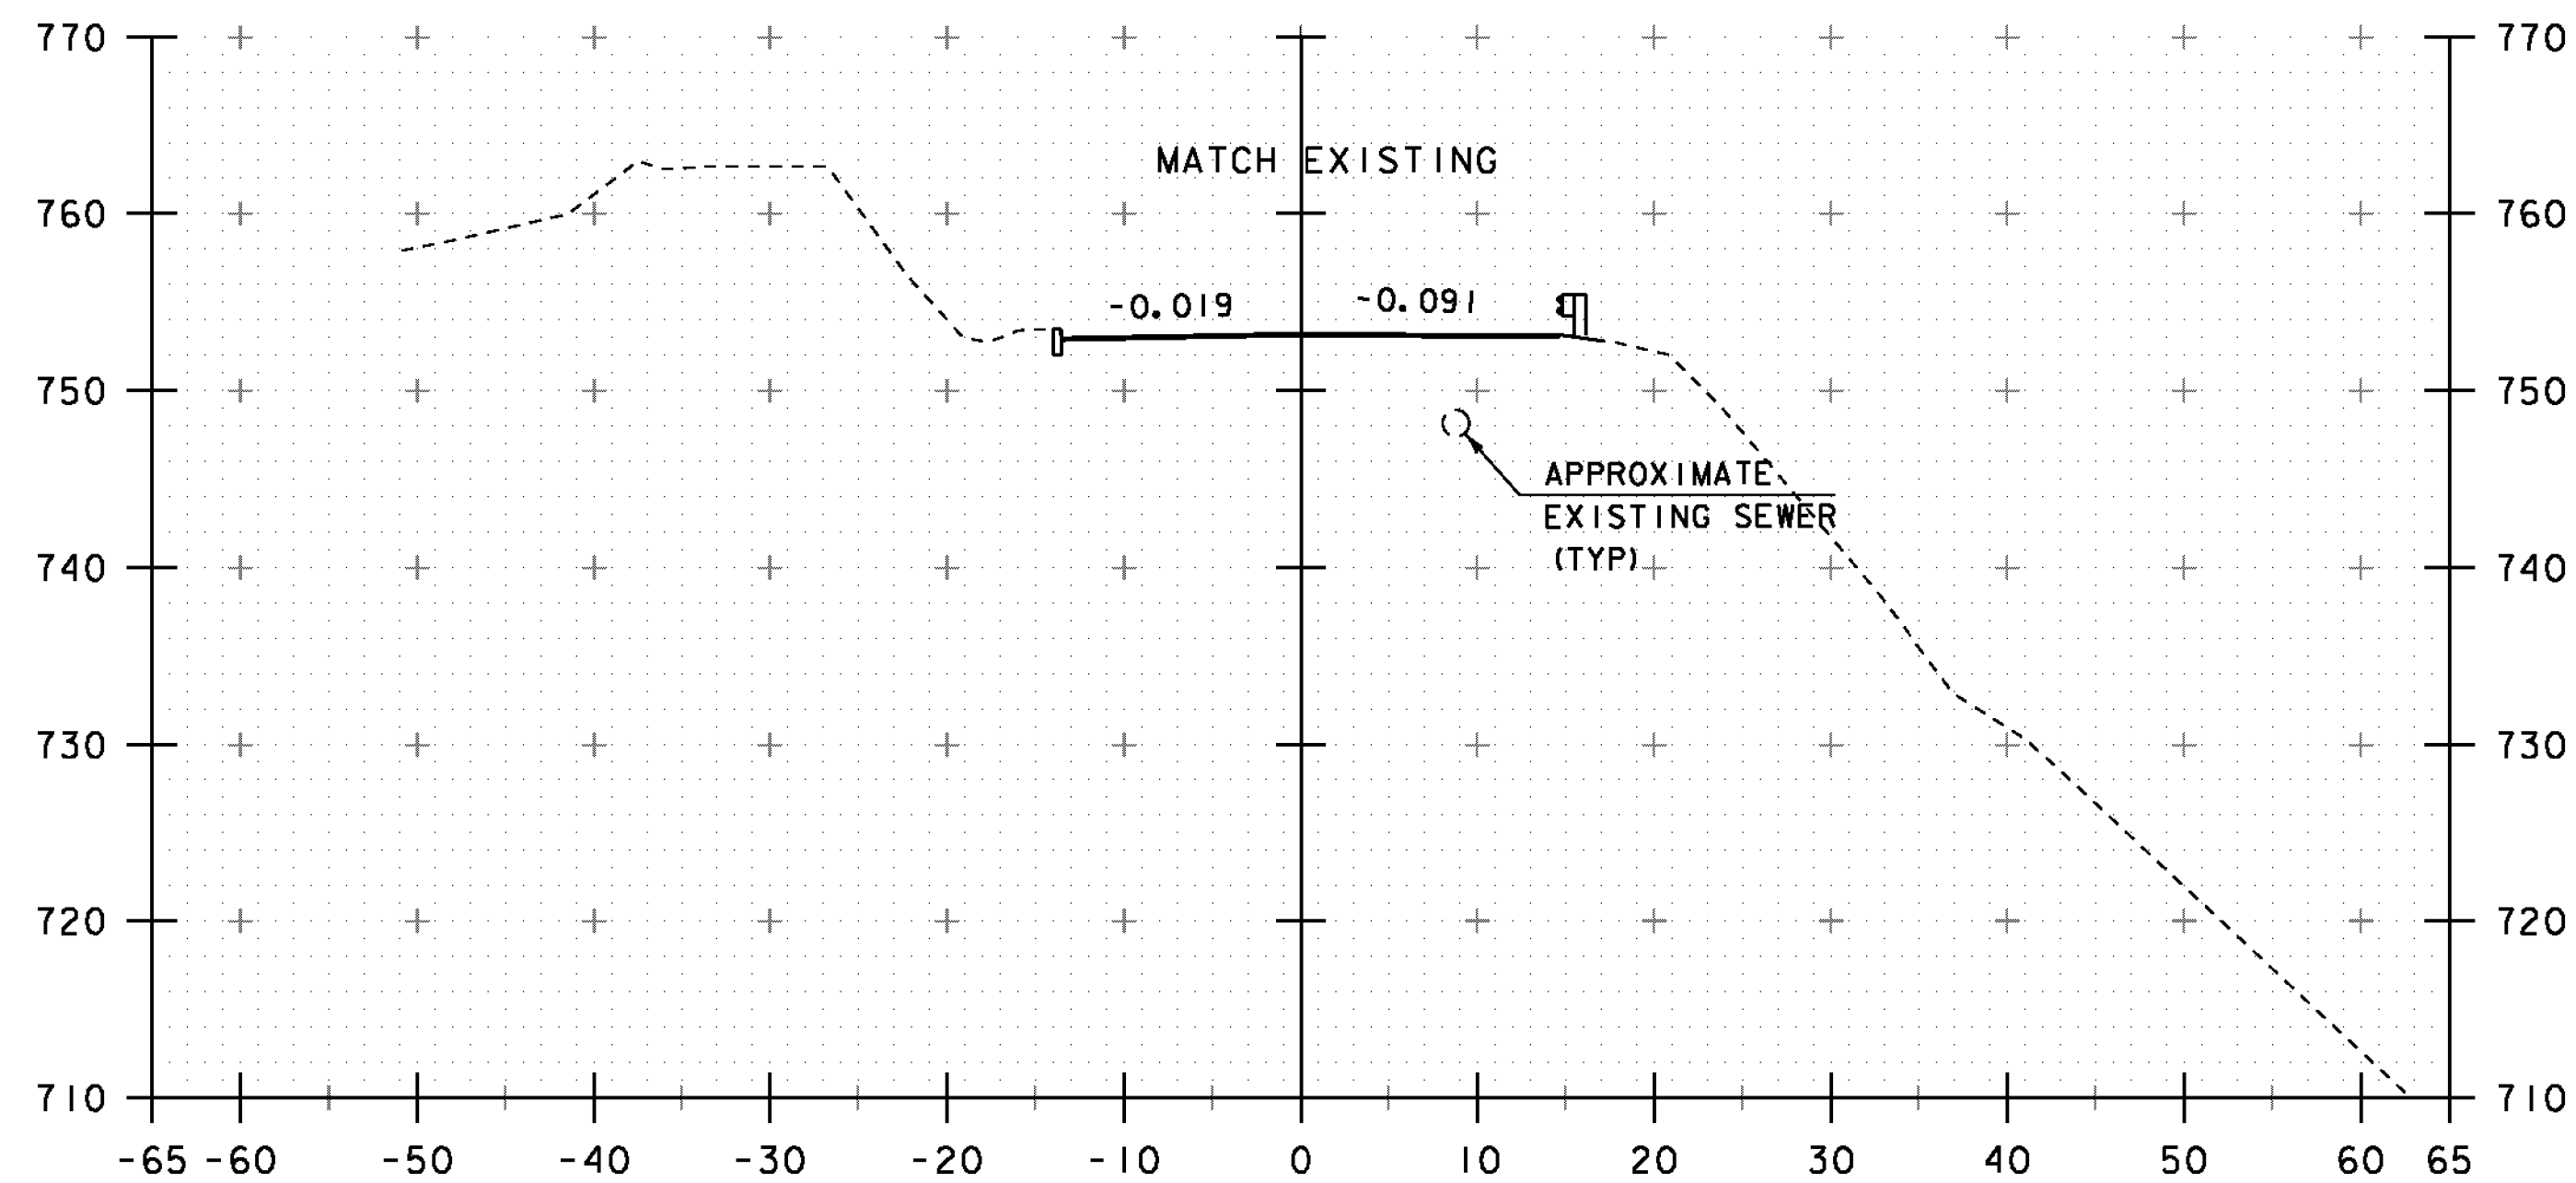

BEGIN APPROACH  
11+75

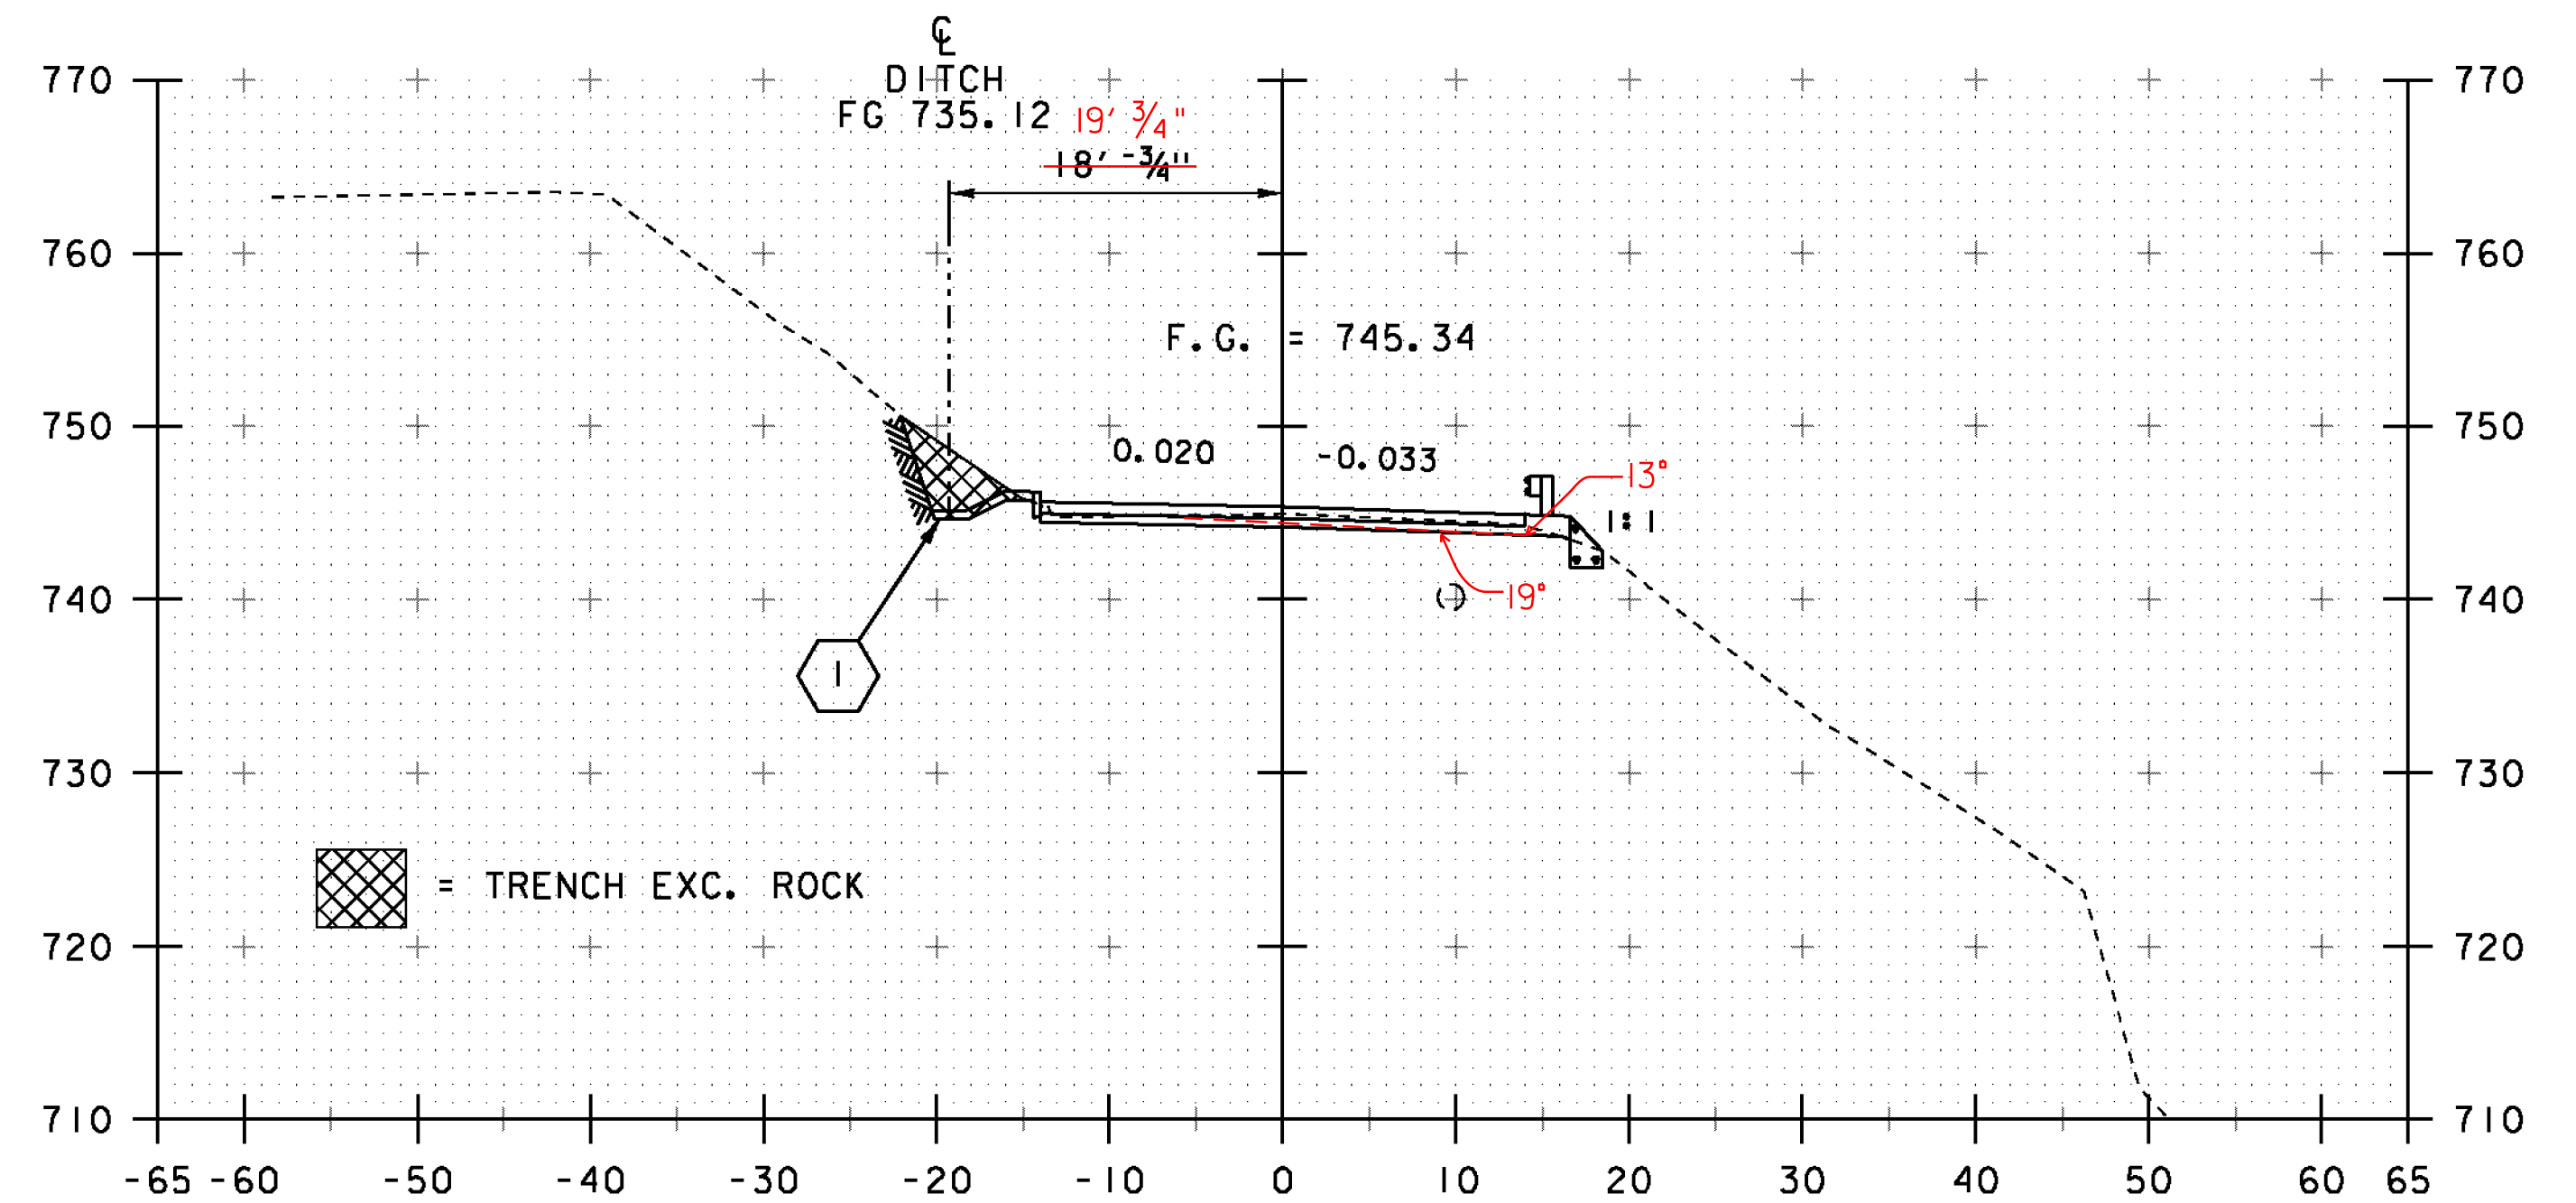

BEGIN PROJECT  
12+50

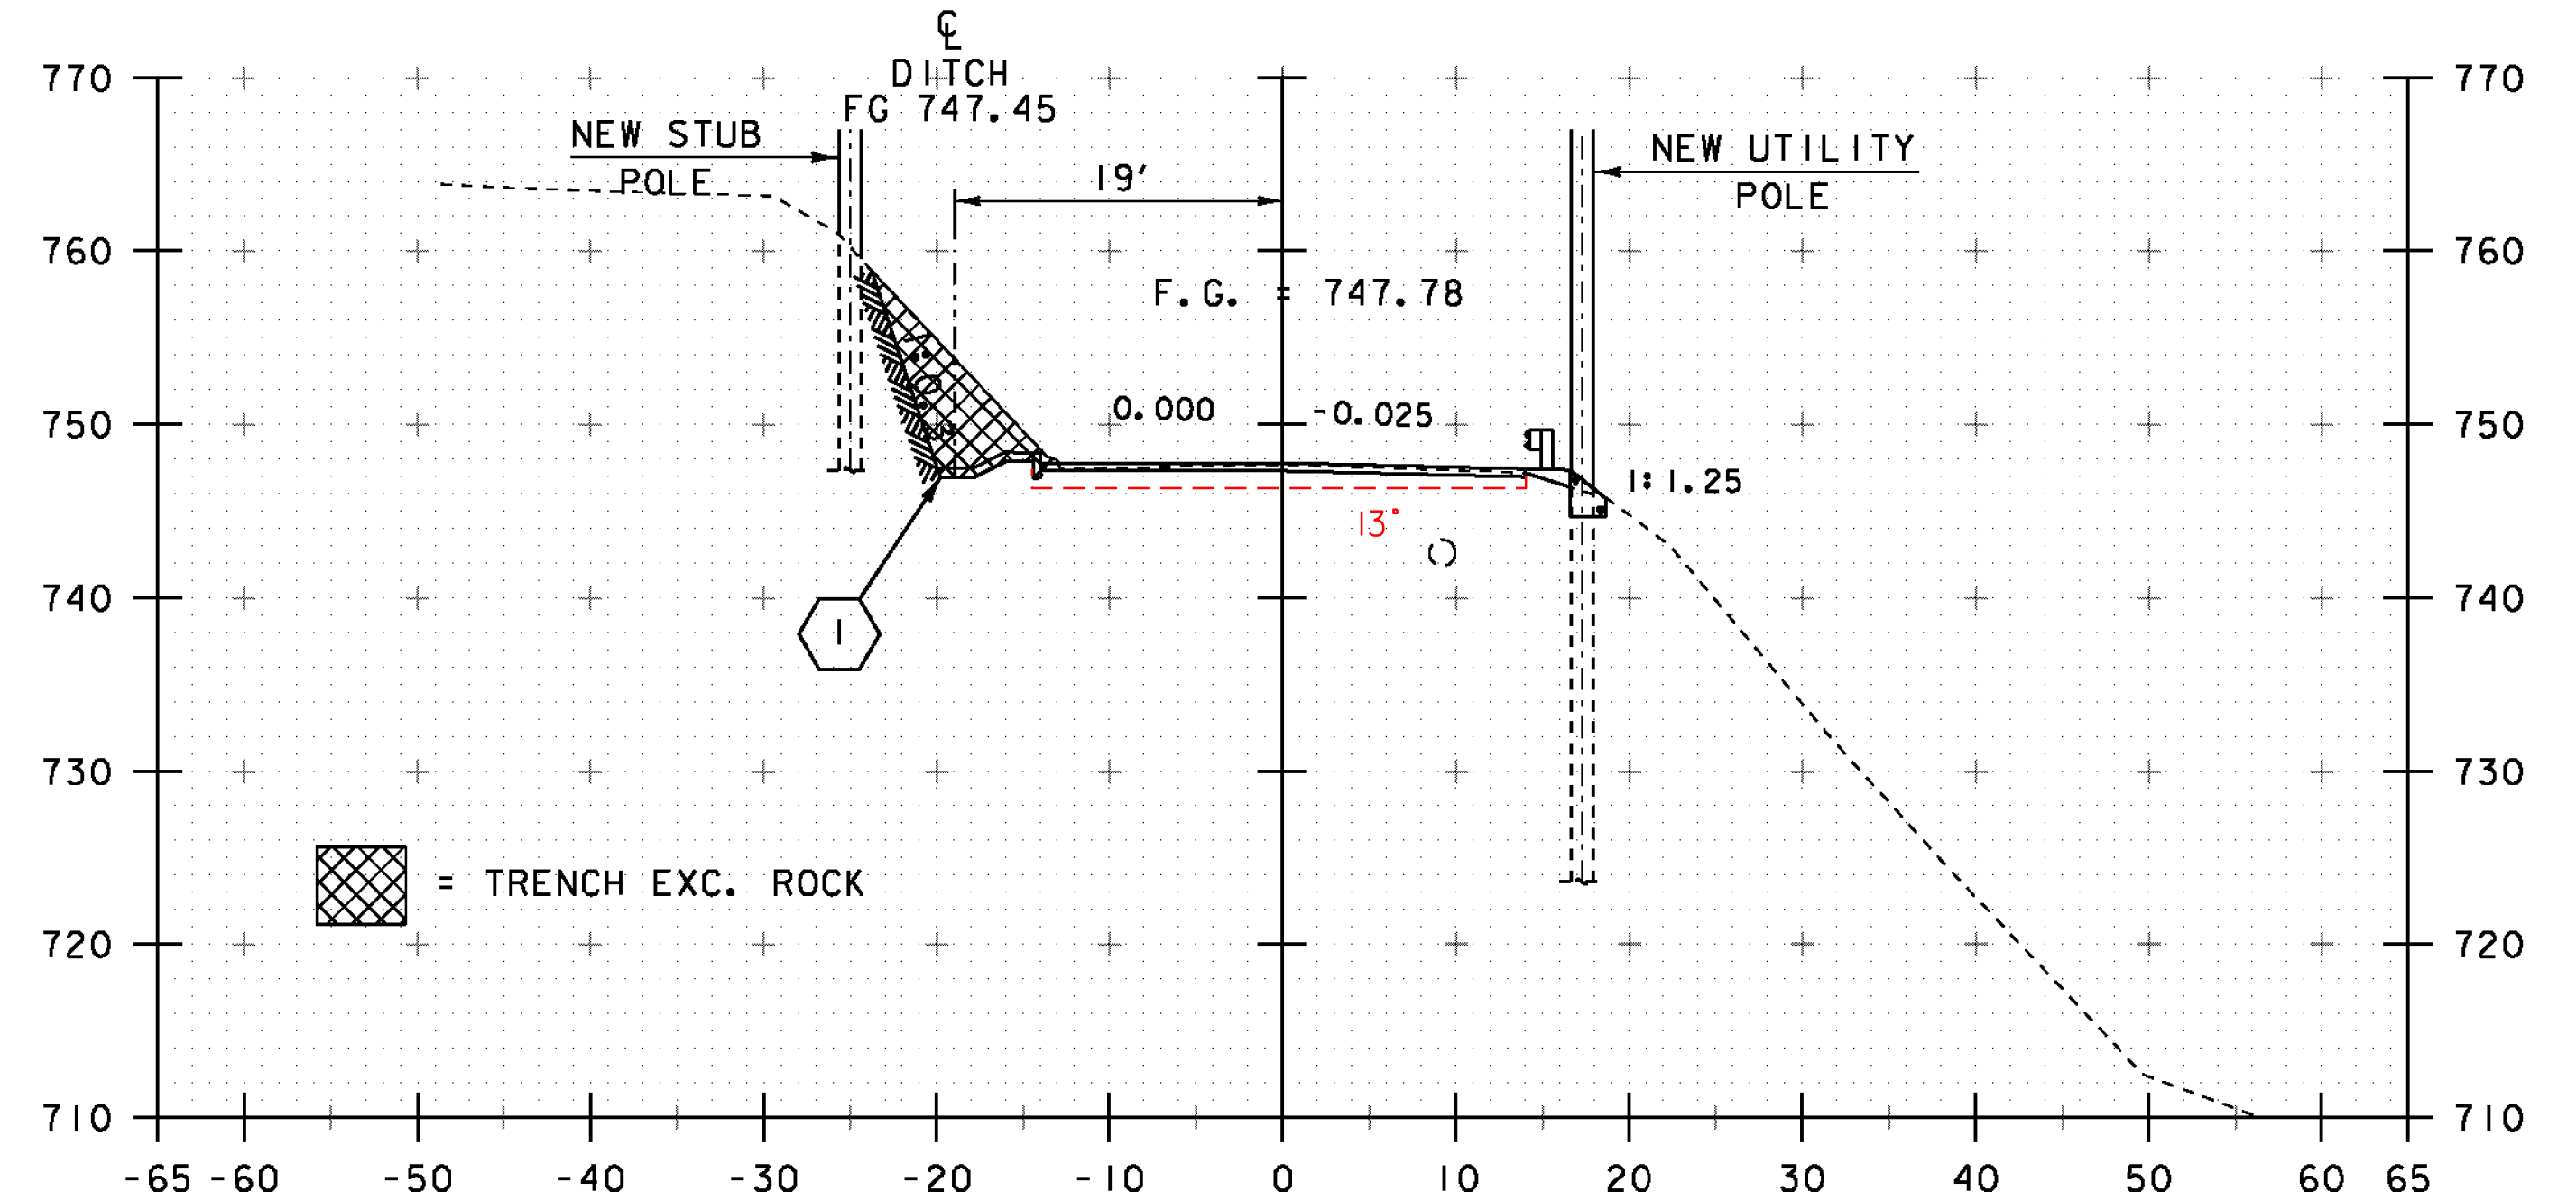

12+25

① DRAINAGE DITCH

STA. 11+75 TO STA. 12+50

PROJECT NAME: BARRE TOWN  
PROJECT NUMBER: BRF 6100(7)

FILE NAME: s06j002xsl.dgn  
PROJECT LEADER: J. LACROIX  
DESIGNED BY: T. FILLBACH  
MAINLINE CROSS SECTIONS 1

PLOT DATE: 27-SEP-2012  
DRAWN BY: R. PELLETT  
CHECKED BY: T. FILLBACH  
SHEET 54 OF 70