



15+75

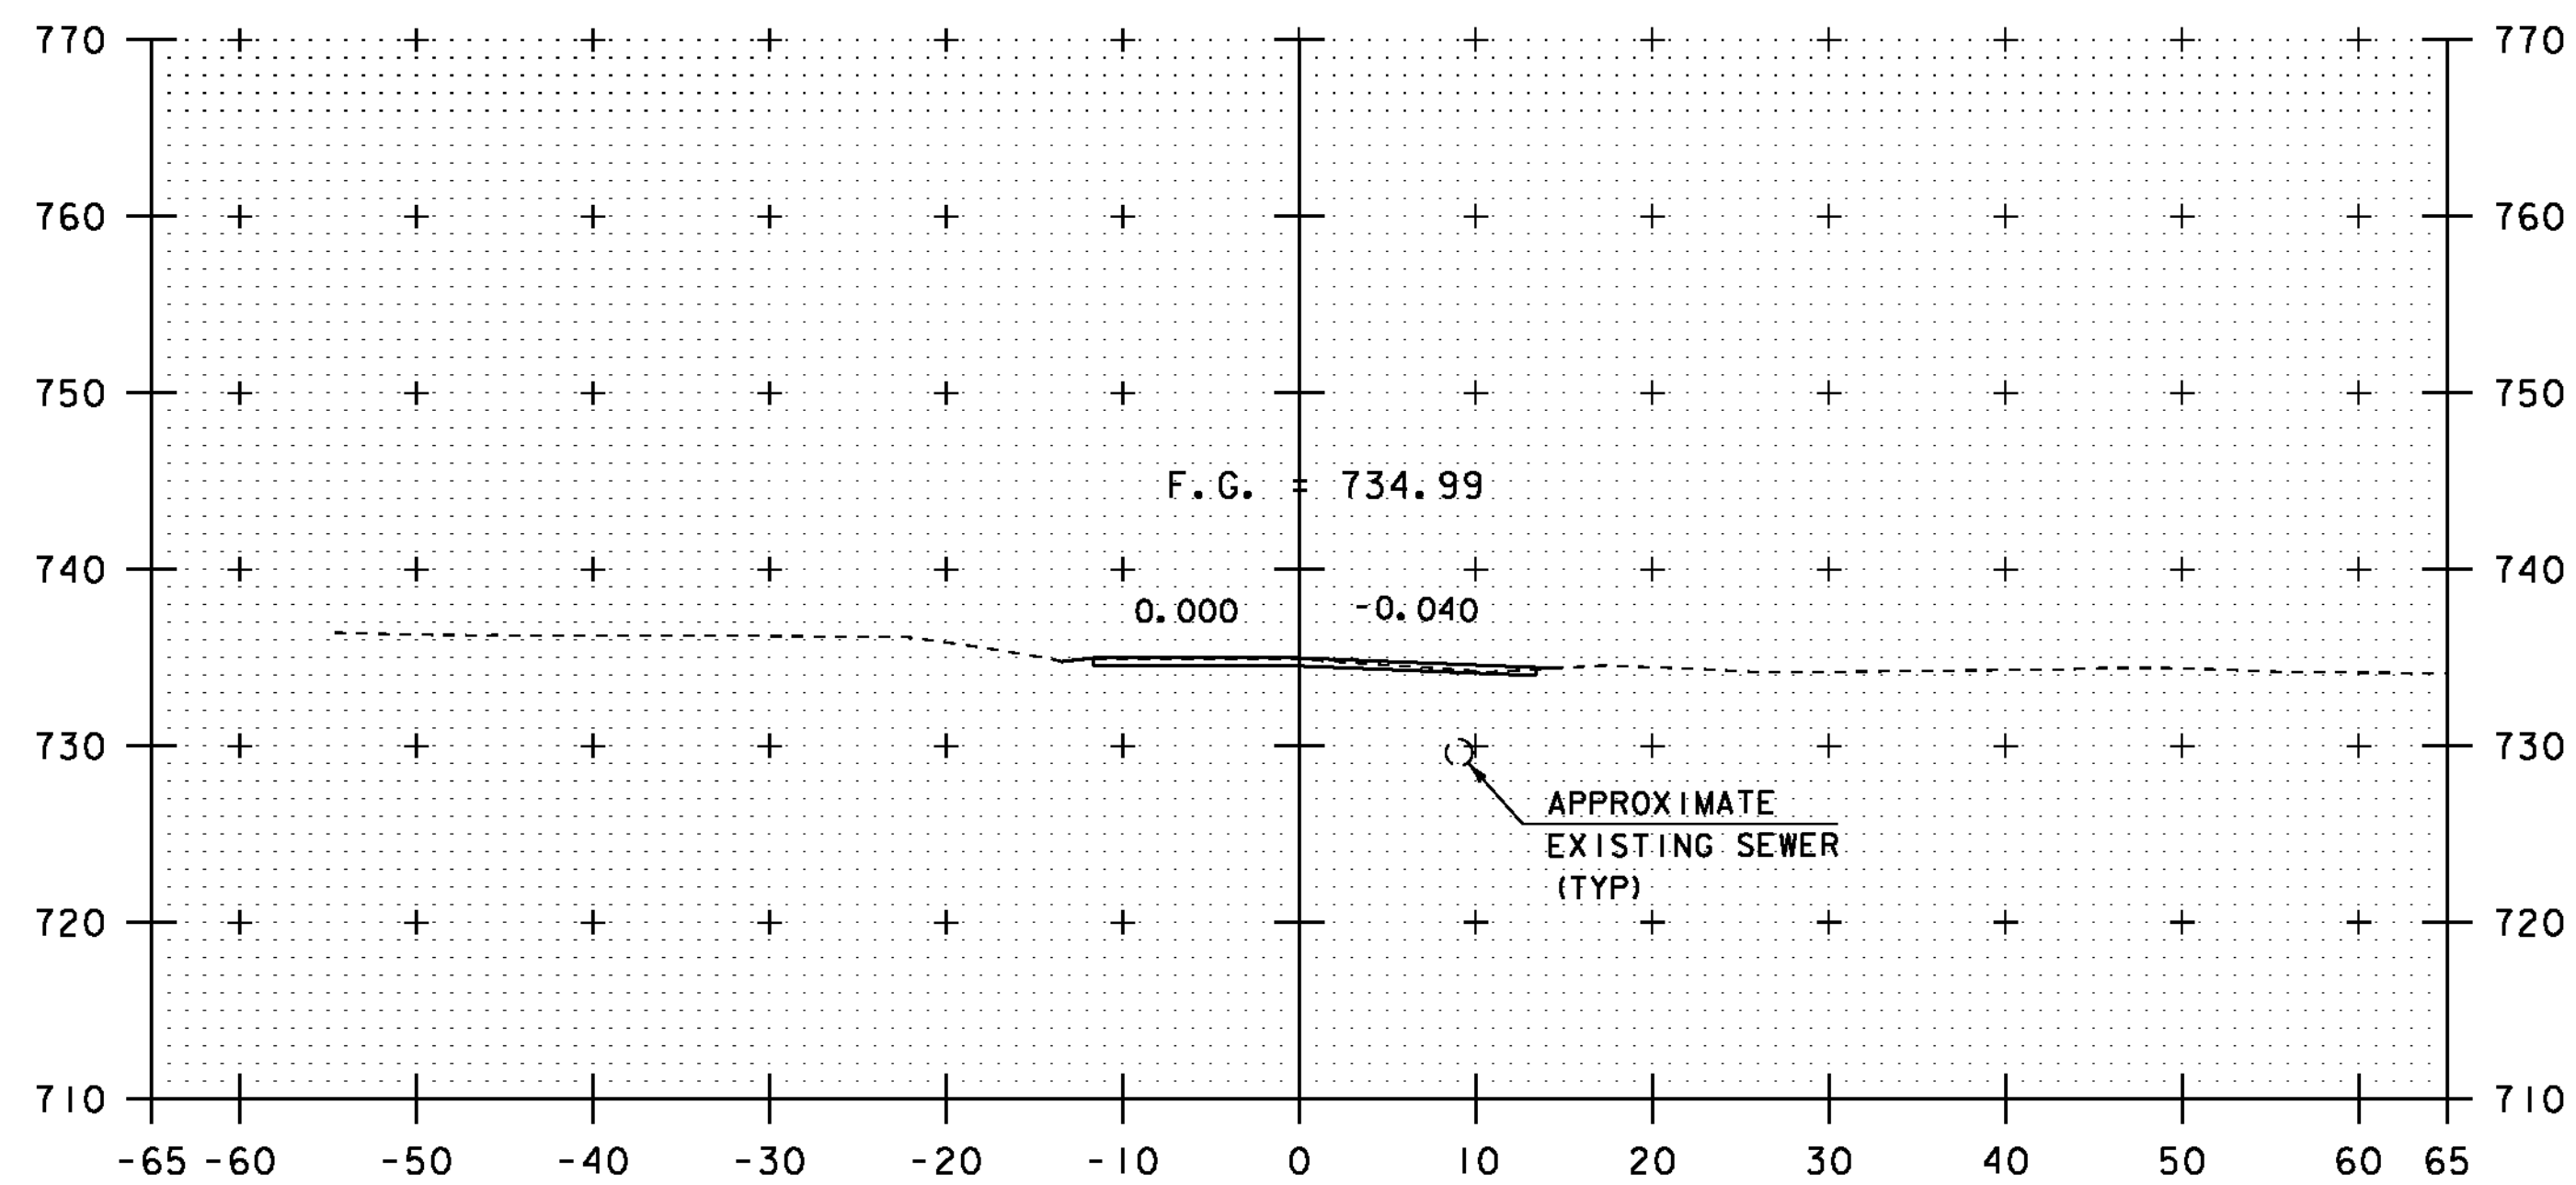

15+50

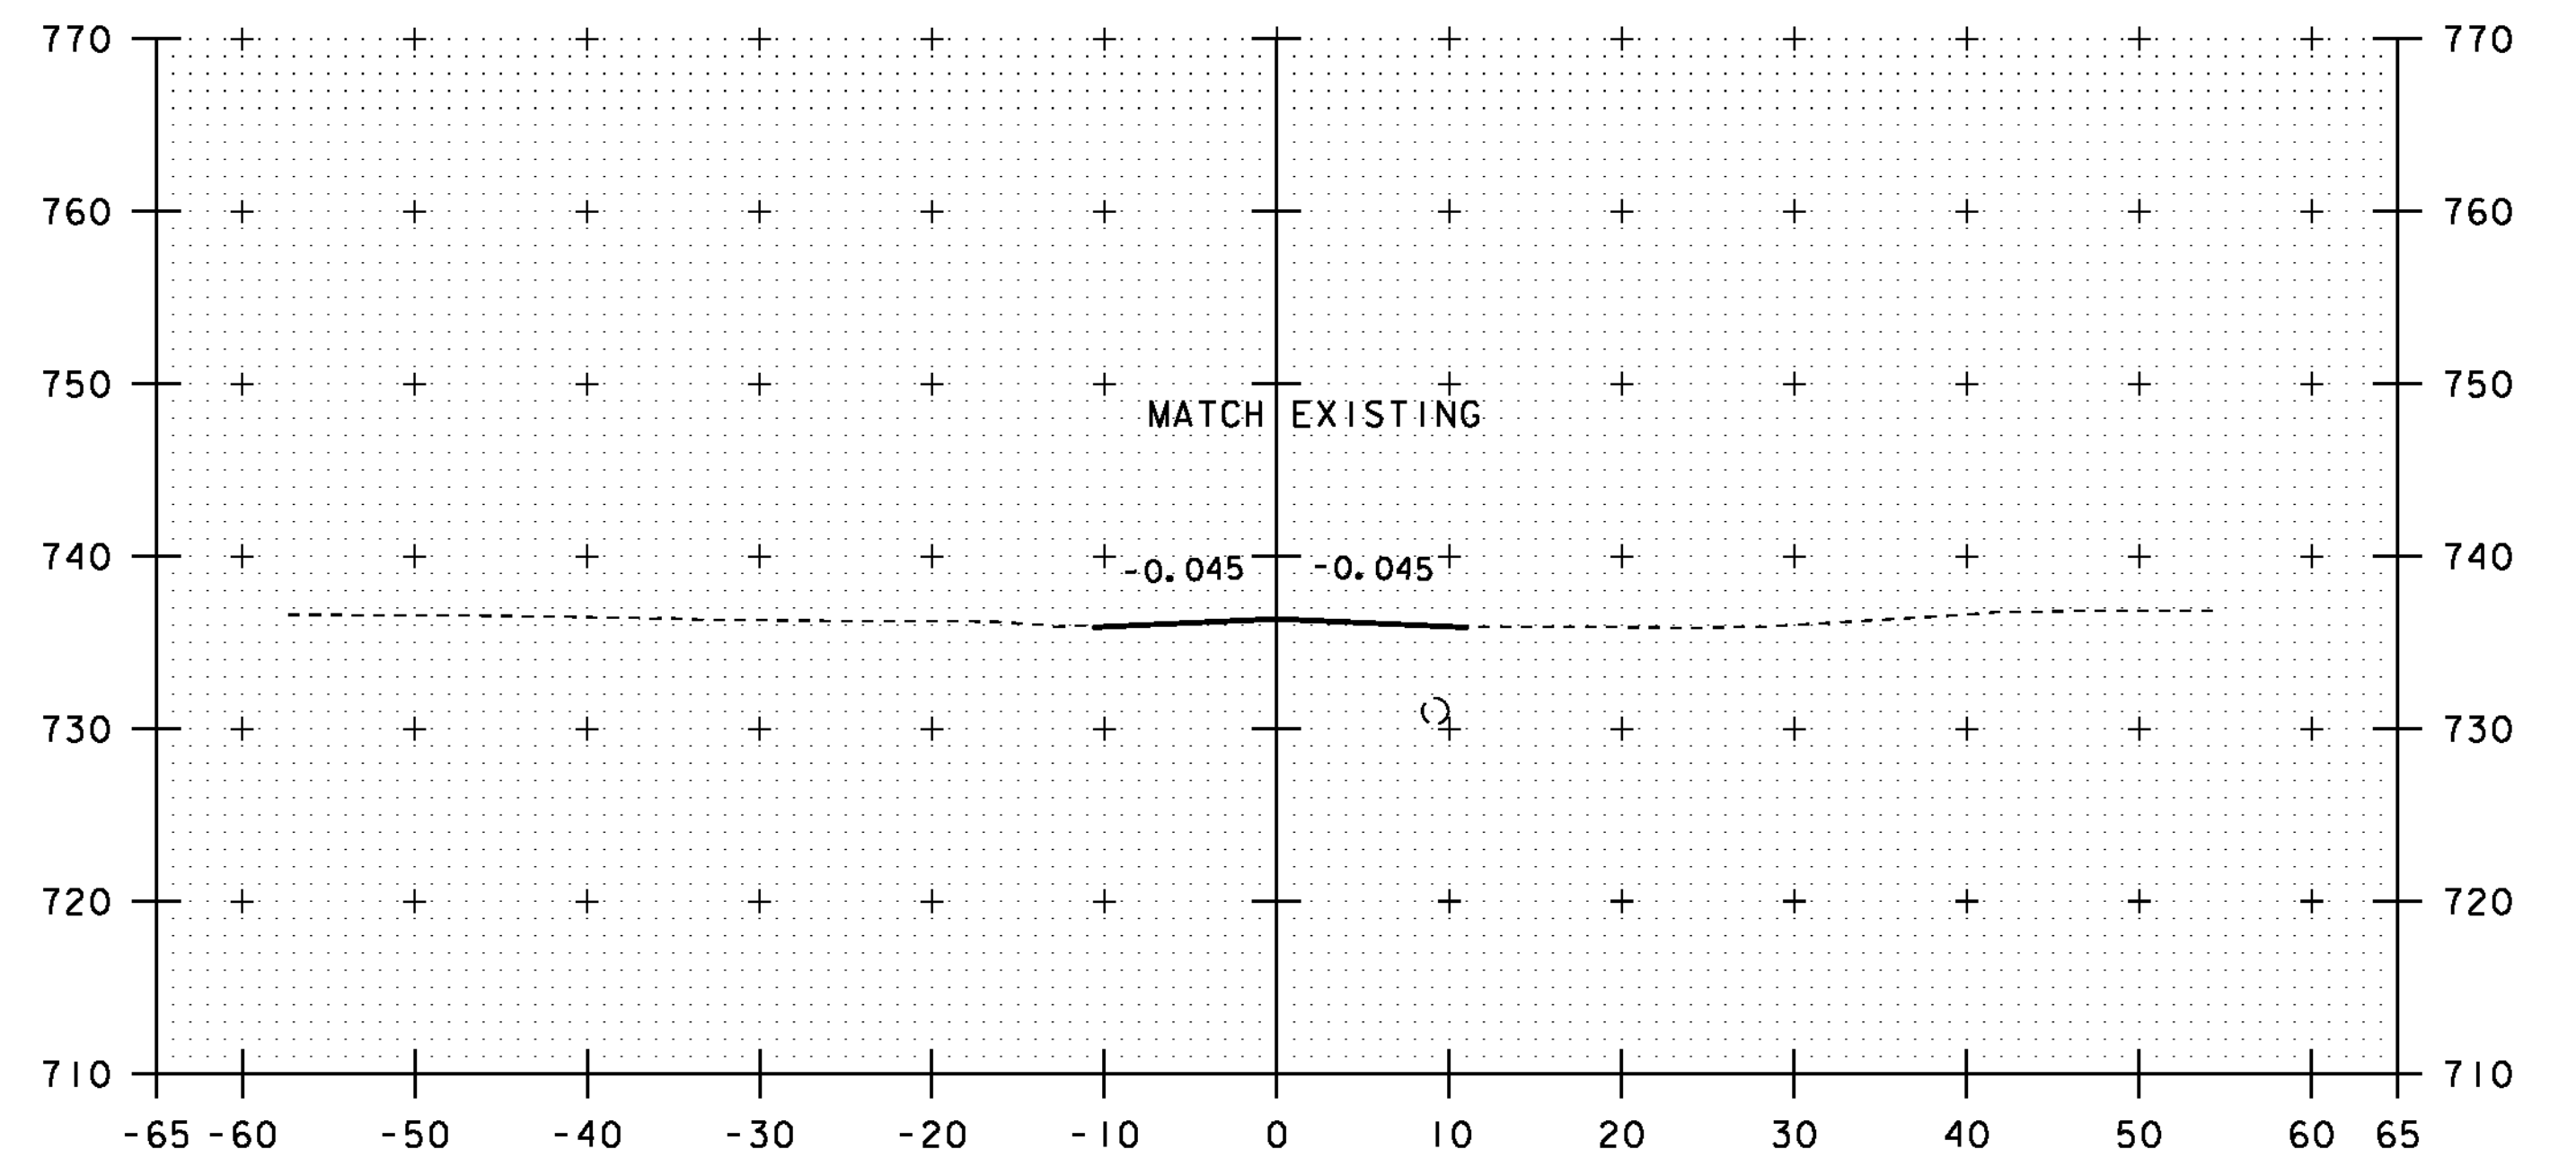

END APPROACH
16+00

STA. 15+25 TO STA. 16+00

PROJECT NAME: BARRE TOWN	PLOT DATE: 27-SEP-2012
PROJECT NUMBER: BRF 6100(7)	DRAWN BY: R. PELLETT
FILE NAME: s06j002xsl.dgn	CHECKED BY: T. FILLBACH
PROJECT LEADER: J. LACROIX	SHEET 58 OF 70
DESIGNED BY: T. FILLBACH	
MAINLINE CROSS SECTIONS 5	