




51+10

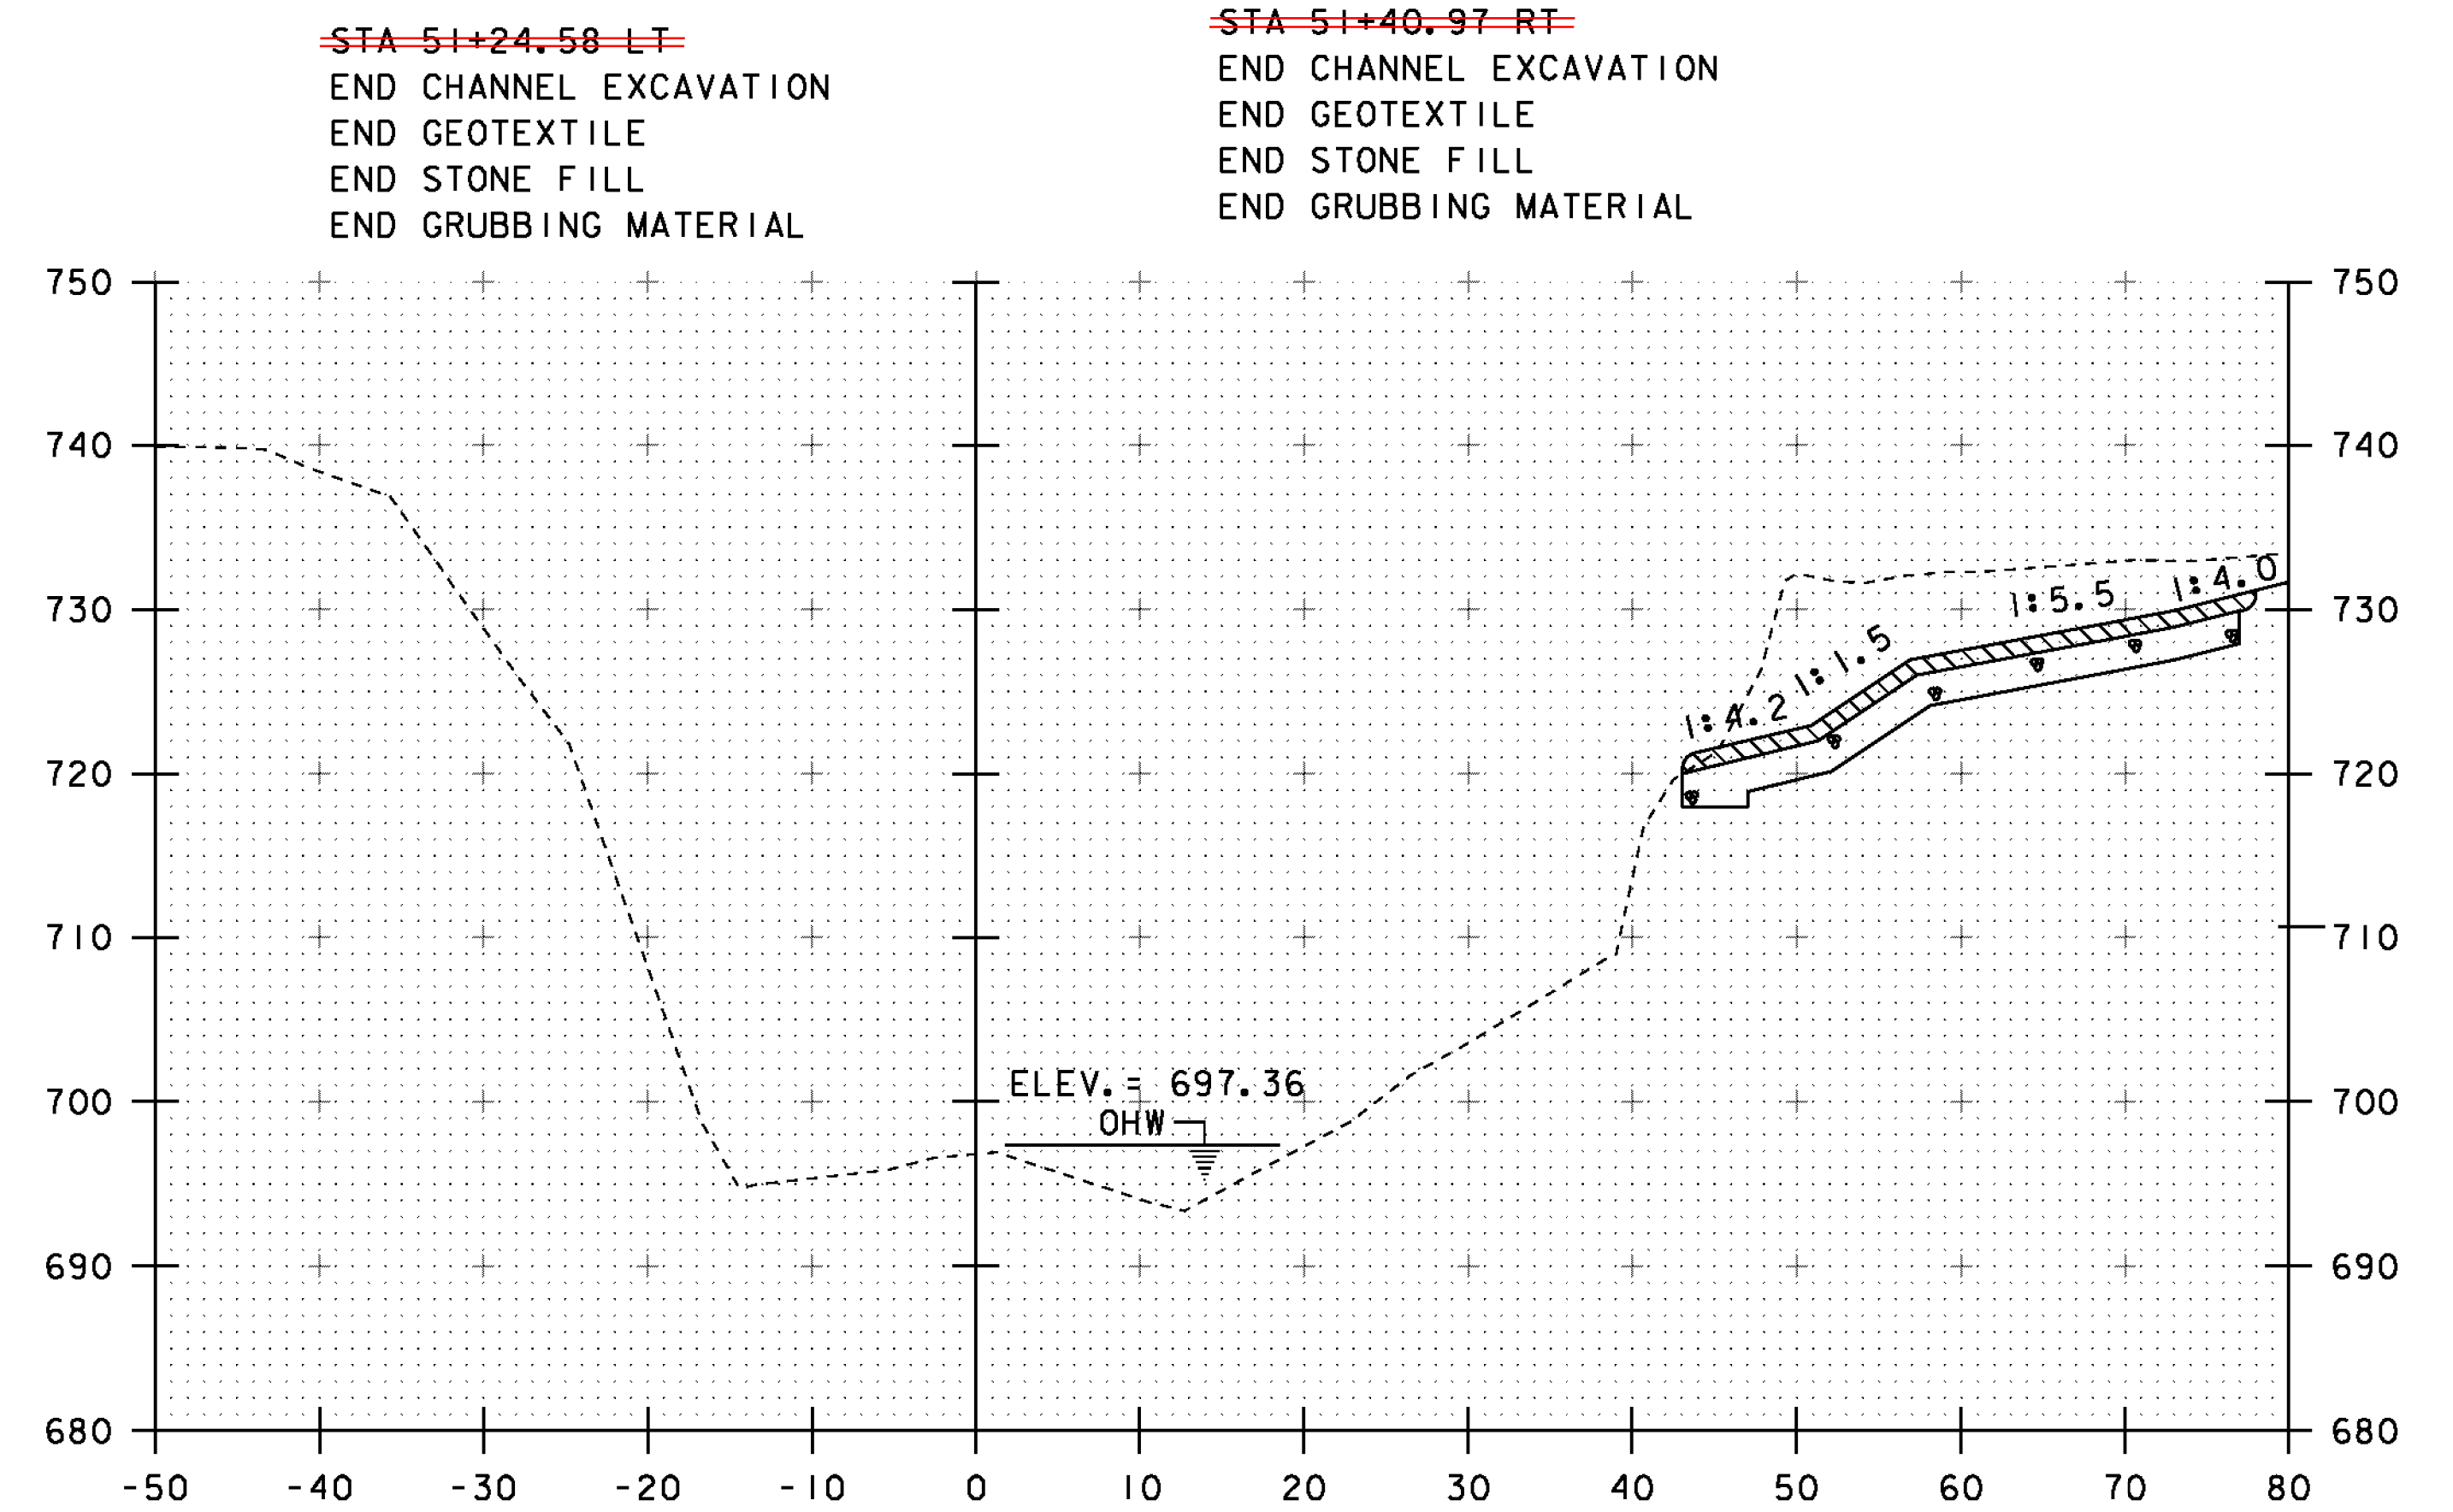

51+25

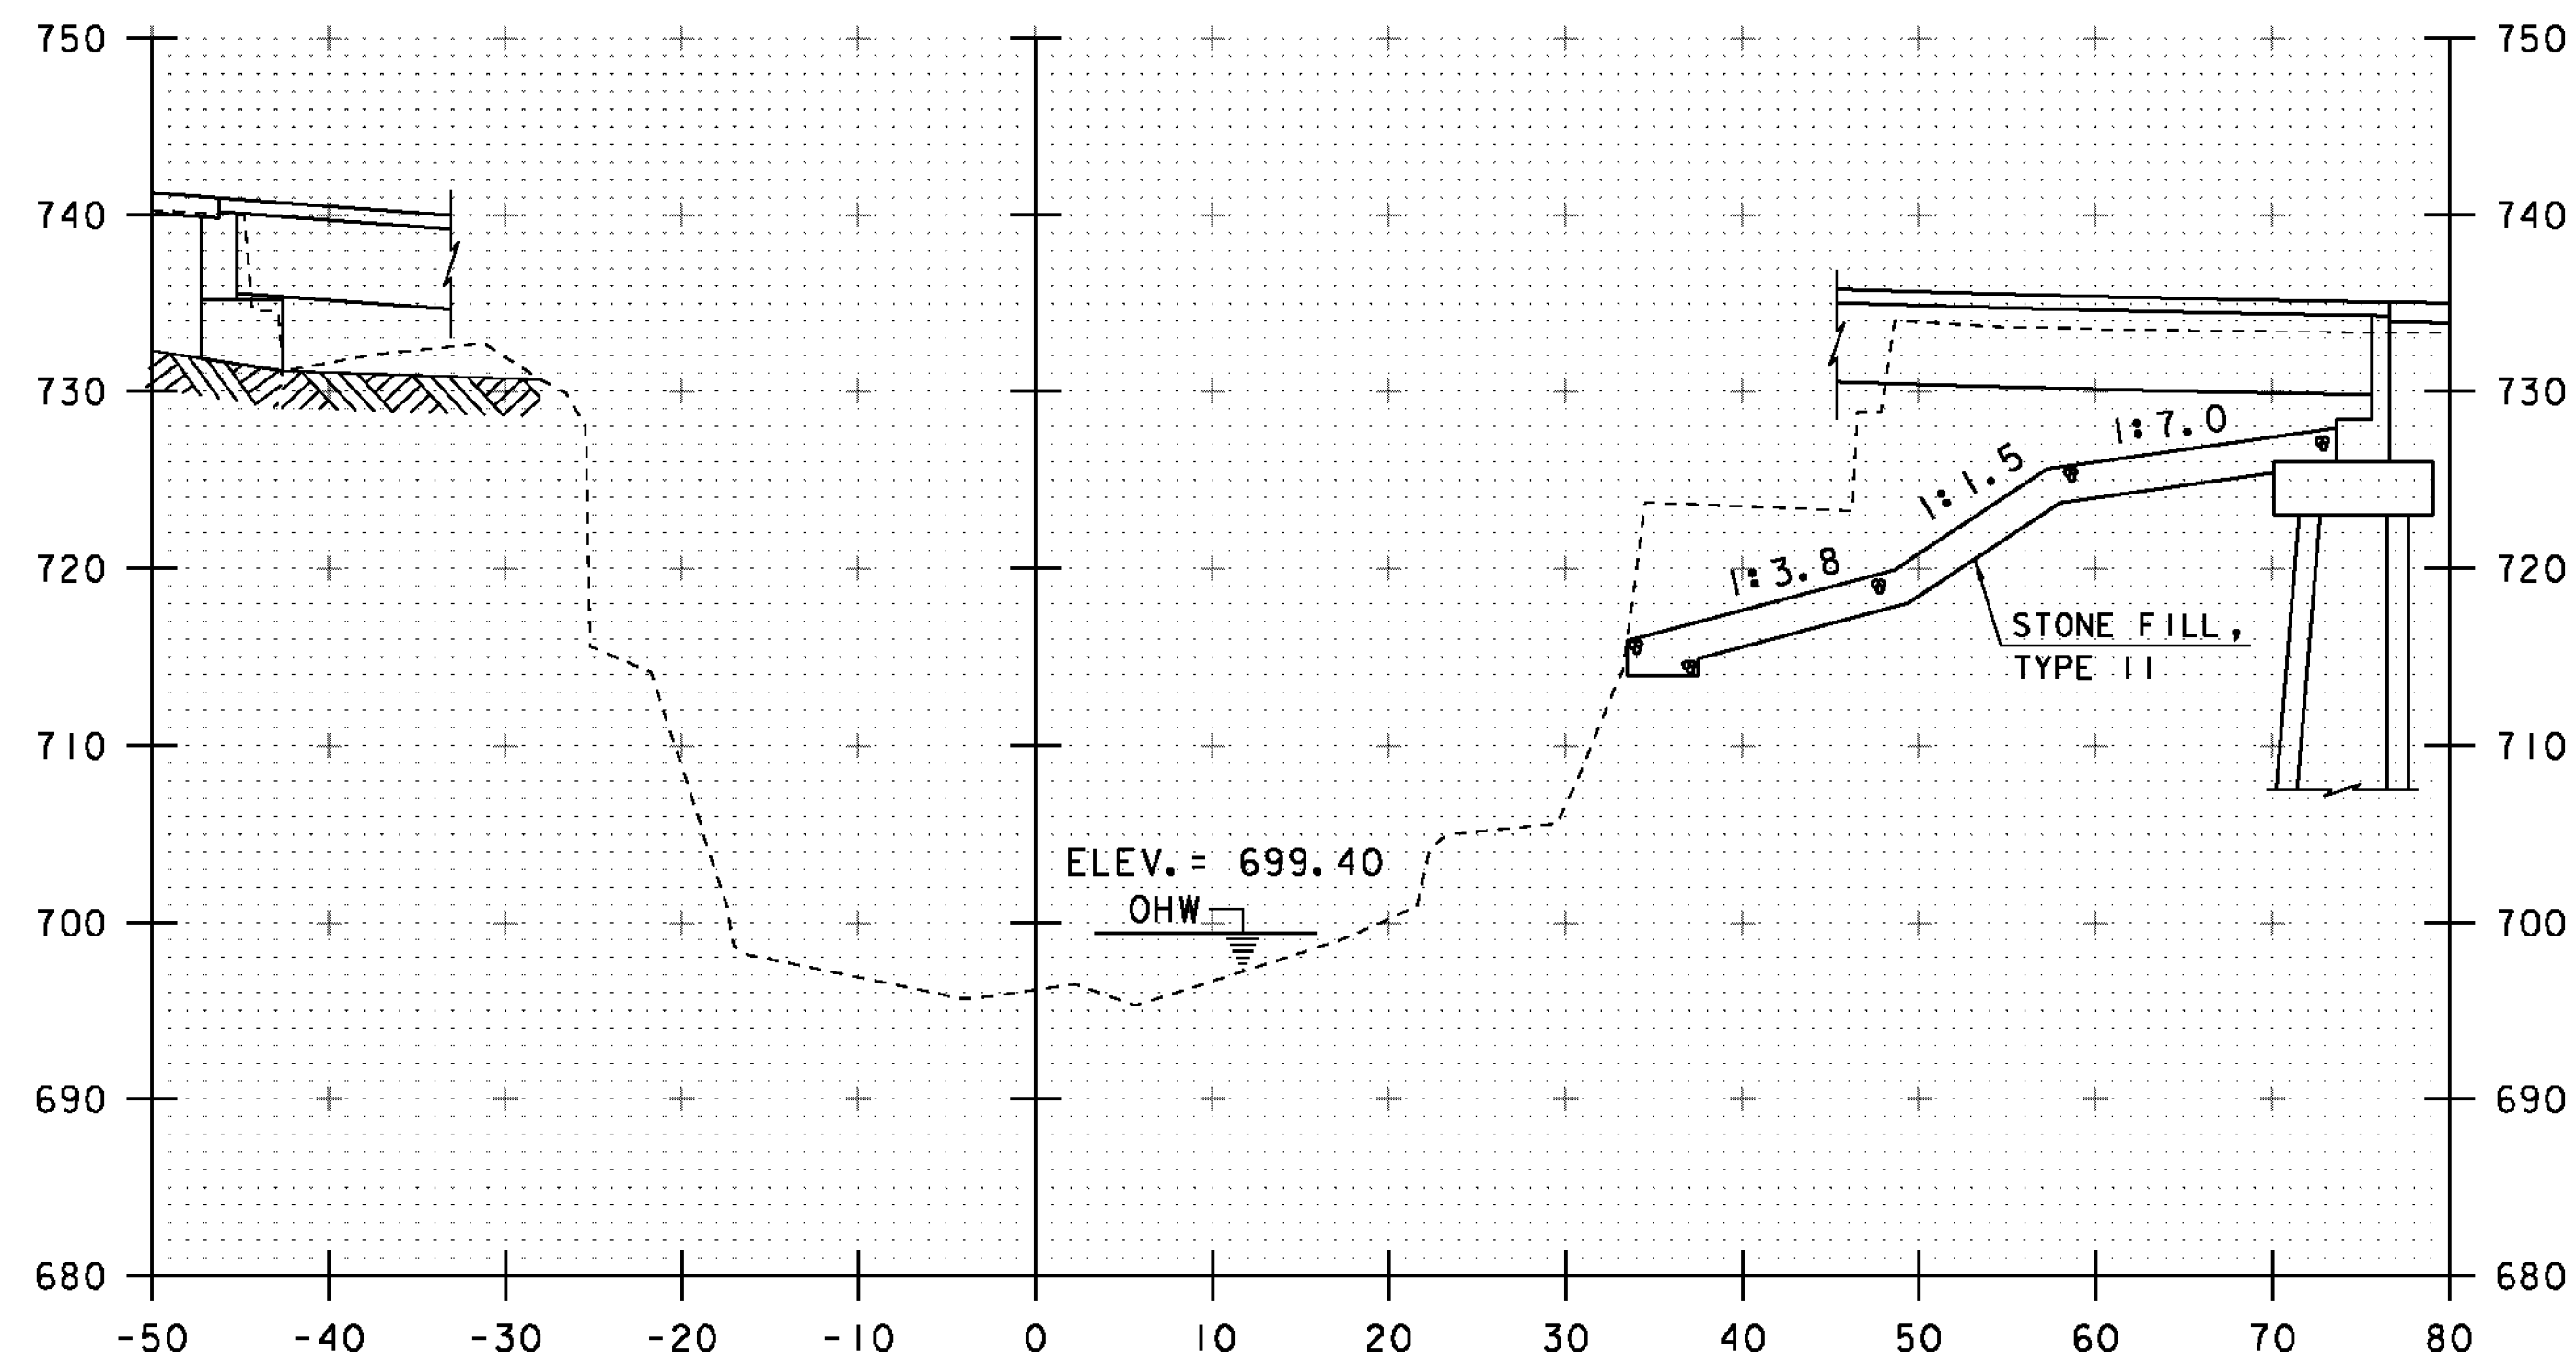

51+00

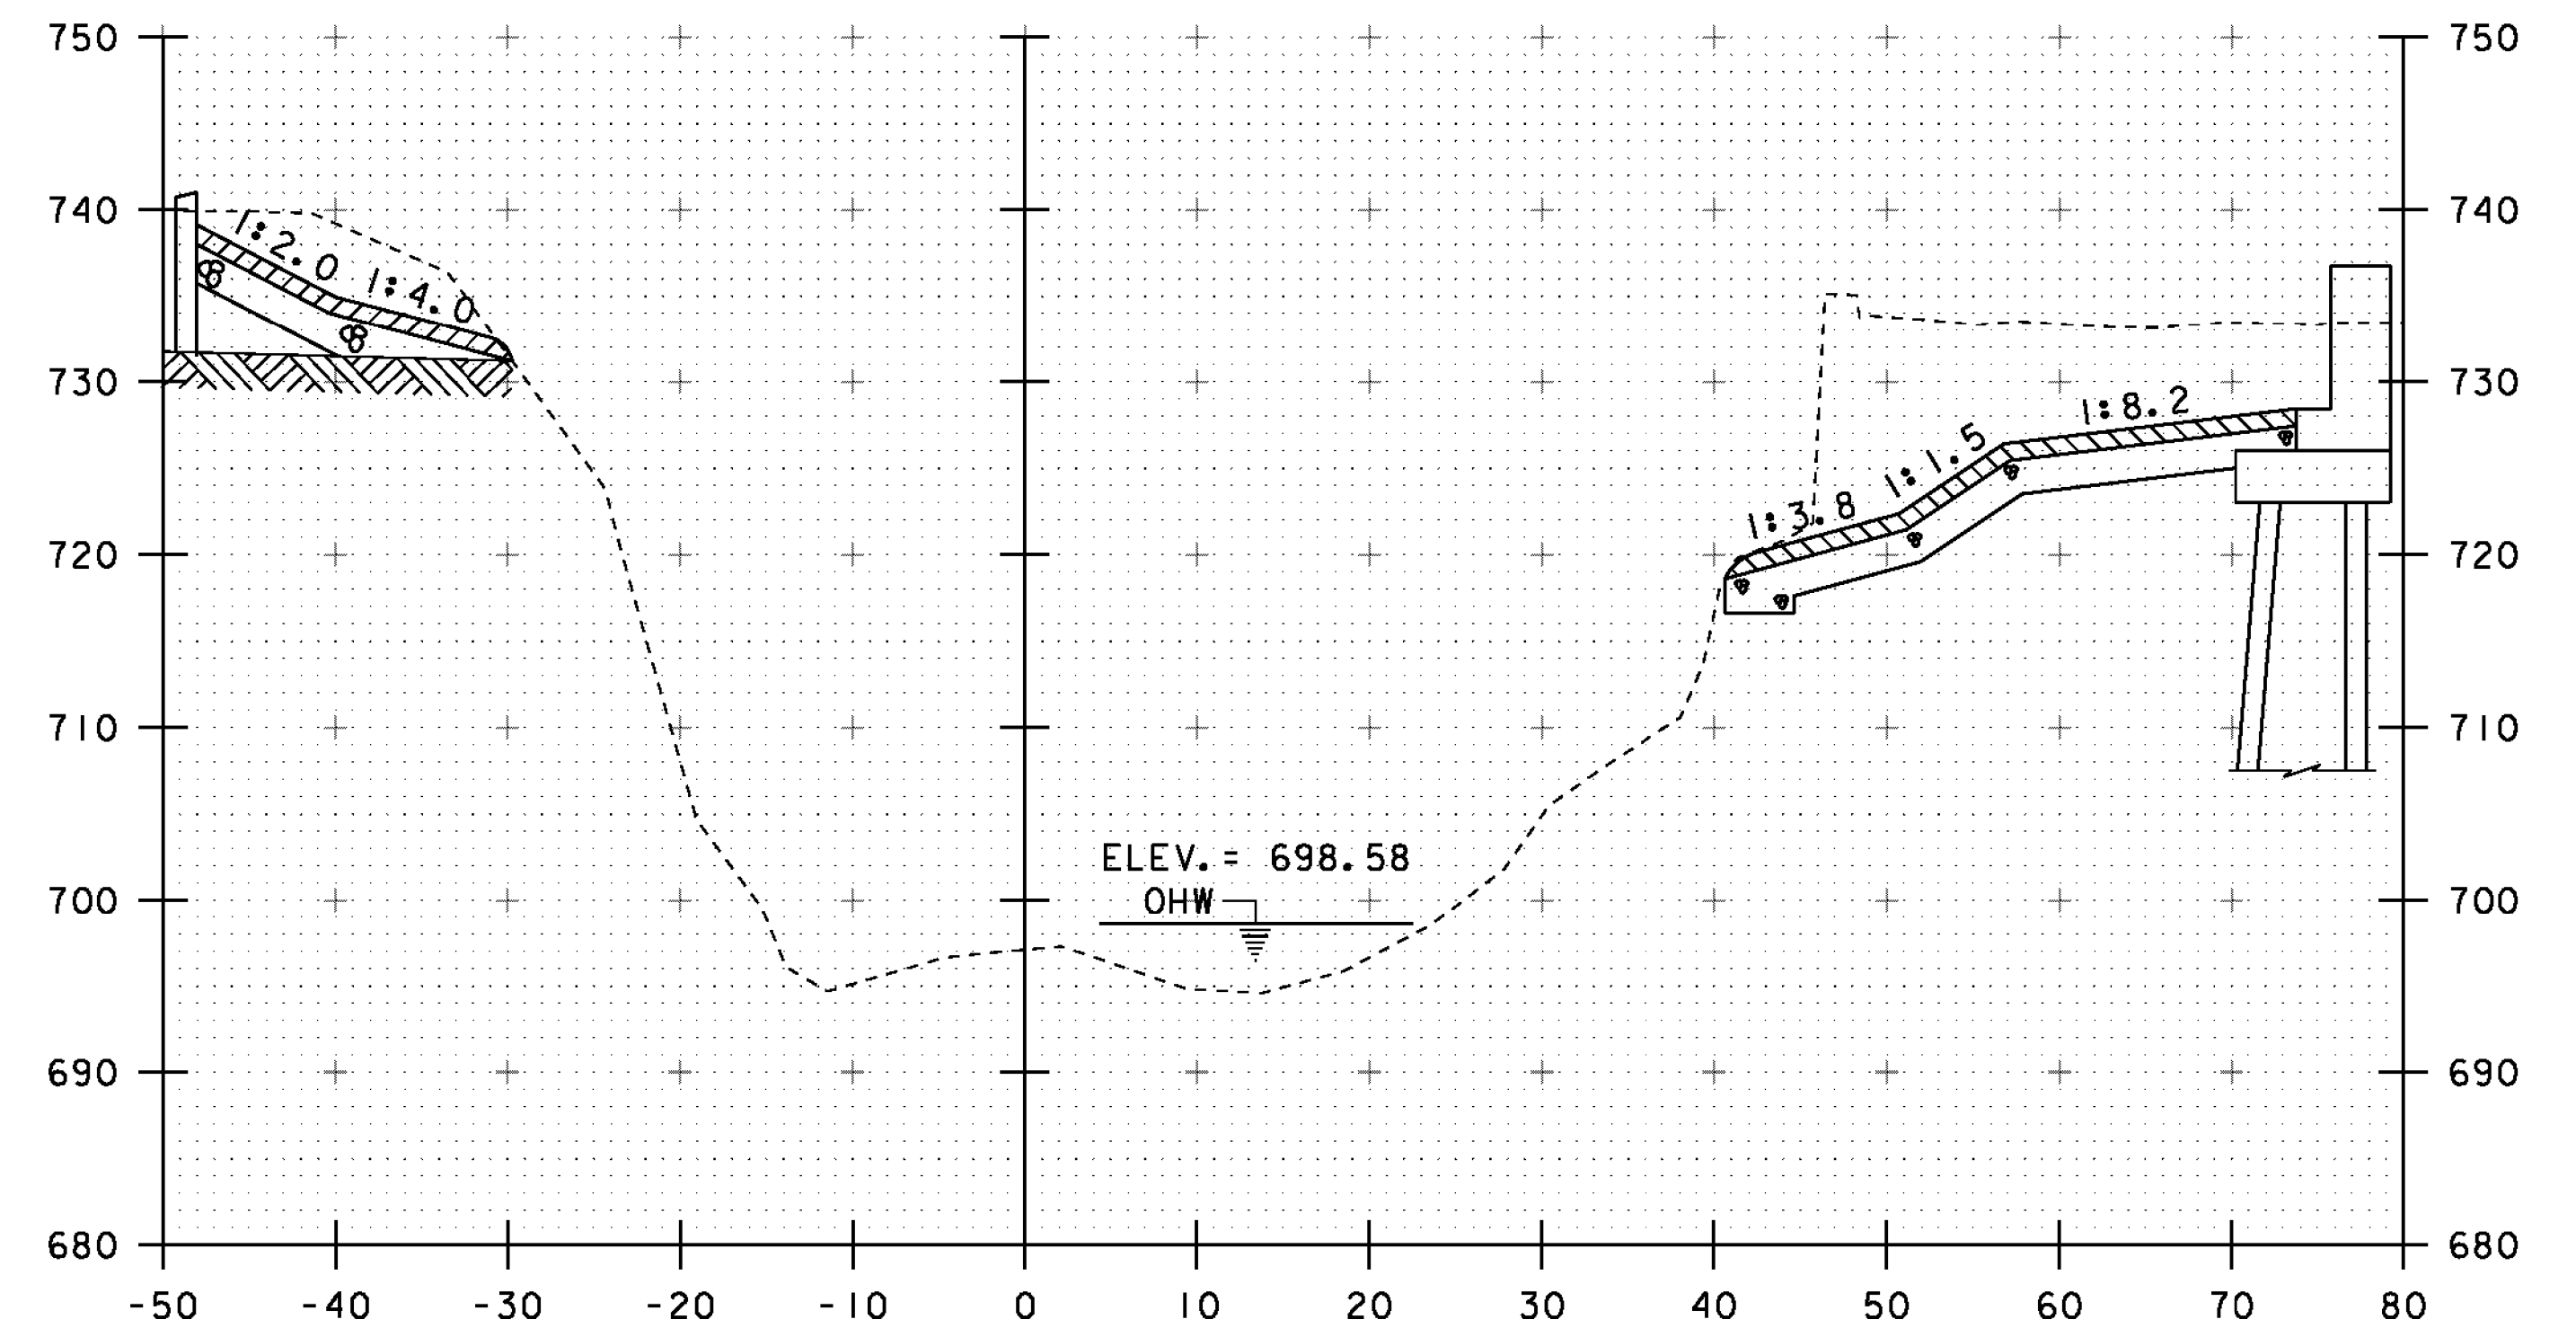

51+20

STA 51+13.75 LT
STA 51+16.80 RT
BEGIN GRUBBING MATERIAL

STA. 51+00 TO STA. 51+25

PROJECT NAME:	BARRE TOWN	PLOT DATE:	27-SEP-2012
PROJECT NUMBER:	BRF 6100(7)	DRAWN BY:	J. SALVATORI
FILE NAME:	s06j002xsl.dgn	CHECKED BY:	T. FILLBACH
PROJECT LEADER:	J. LACROIX	SHEET	61 OF 70
DESIGNED BY:	T. FILLBACH	CHANNEL CROSS SECTIONS	2