


RAIL "C-2"

RAIL "D-2"

BREAK
LINE "B"

NORTH RAILING, FACING NORTH

BREAK
LINE "C"

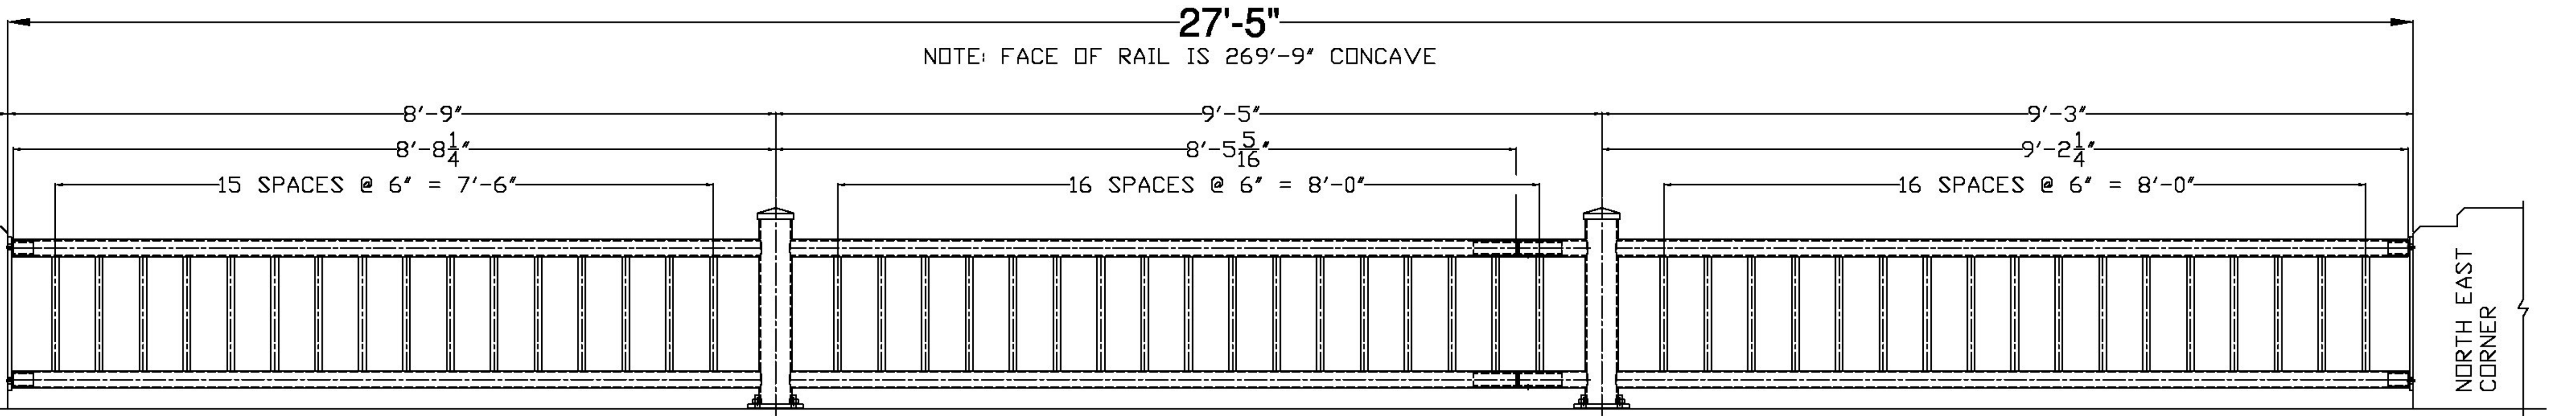

RAIL "E"

RAIL "F-1"

BREAK
LINE "C"

NORTH RAILING, FACING NORTH

Vermont Agency of Transportation
RECEIVED
 CK'D BY JAG OK'D BY JEL
 December 12, 2012
 RESUBMIT NO Approved
 BY J. LACROIX DATE 02/01/13

ITEM #: 900.640 GEN CONTR: F.R. LAFAYETTE SHEET 2 OF 6

APPROVED BY:

BRIDGE RAIL DETAILS SHEET
 BARRE TOWN BR# 6100 (7)
 TOWN OF BARRE, WASHINGTON COUNTY, VT.

R	NO.	DATE	DESCRIPTION	BY	R	NO.	DATE	DESCRIPTION	BY
E					E				
V					V				

ELDERLEE, INC.
 OAKS CORNERS, NEW YORK 14578
 E-Mail: dlong@elderlee.com
 Tel: 315-789-6670 Fax: 315-789-6615

DRAWN E.P. 12/04/12
 CHECKED D.L. 12/04/12
 APPROVED
 SCALE SCHEMATIC
 DRAWING NO. F.R. LAFAYETTE-BARRE