


SOUTH RAILING, FACING SOUTH

BREAK
LINE "A"

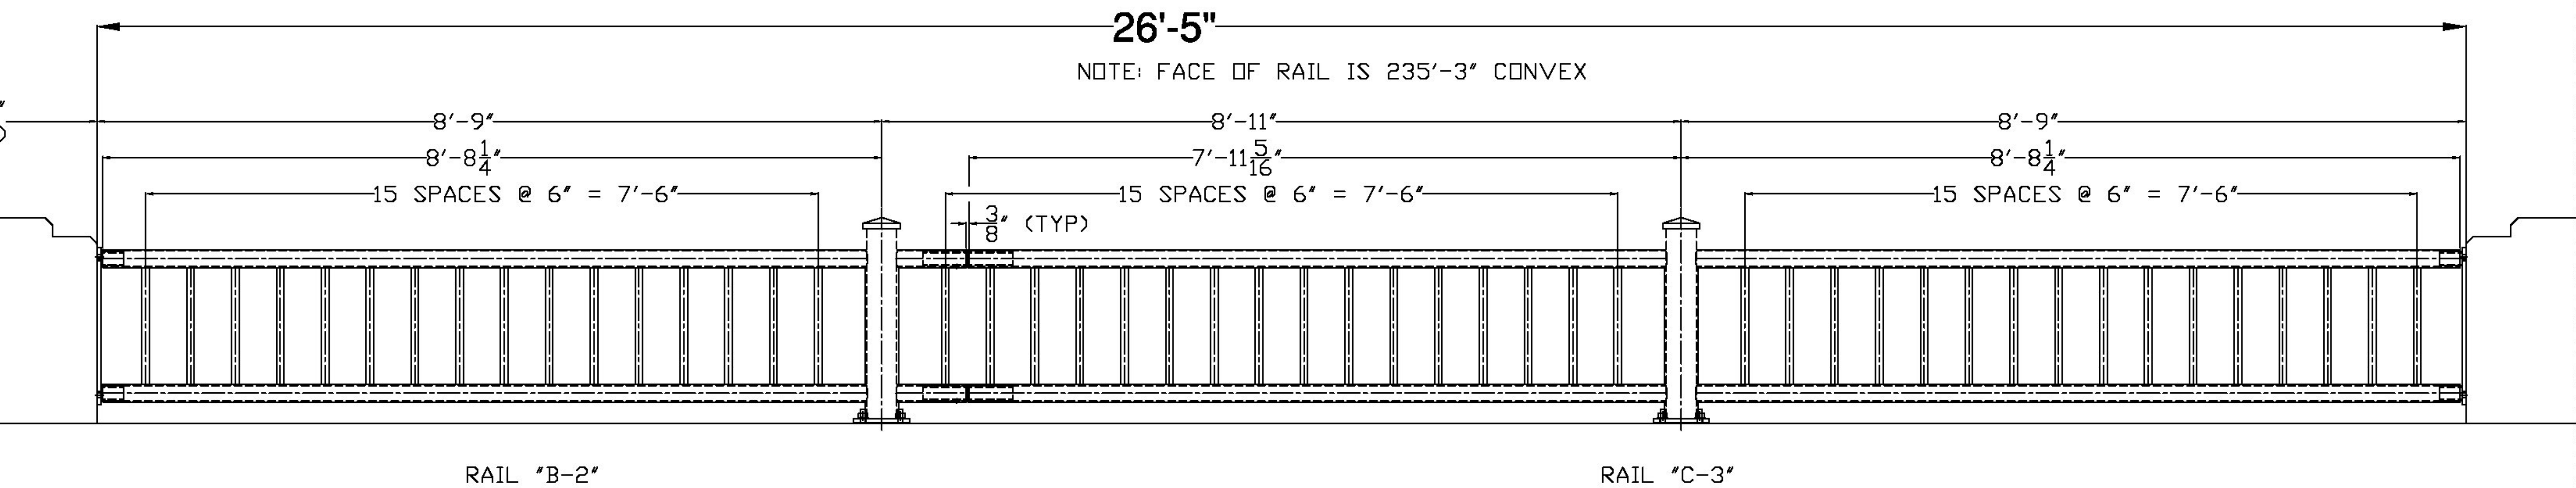

SOUTH RAILING, FACING SOUTH

BREAK
LINE "A"

BREAK
LINE "B"

Vermont Agency of Transportation

RECEIVED

CK'D BY JAG

OK'D BY JEL

December 12, 2012

RESUBMIT NO

Approved

BY J. LACROIX

DATE 02/01/13

ITEM #: 900.640

GEN CONTR: F.R. LAFAYETTE

SHEET 3 OF 6

APPROVED BY:

BRIDGE RAIL DETAILS SHEET

BARRE TOWN BR# 6100 (7)

TOWN OF BARRE, WASHINGTON COUNTY, VT.

REV	NO.	DATE	DESCRIPTION	BY	REV	NO.	DATE	DESCRIPTION	BY



ELDERLEE, INC.

OAKS CORNERS, NEW YORK 14518

E-Mail: dlong@elderlee.com

Tel: 315-789-6670 Fax: 315-789-6615



DRAWN	E.P.	12/04/12
CHECKED	D.L.	12/04/12
APPROVED		
SCALE		SCHMATIC
DRAWING NO. F.R. LAFAYETTE-BARRE		