


26'-5"

NOTE: FACE OF RAIL IS 235'-3" CONVEX

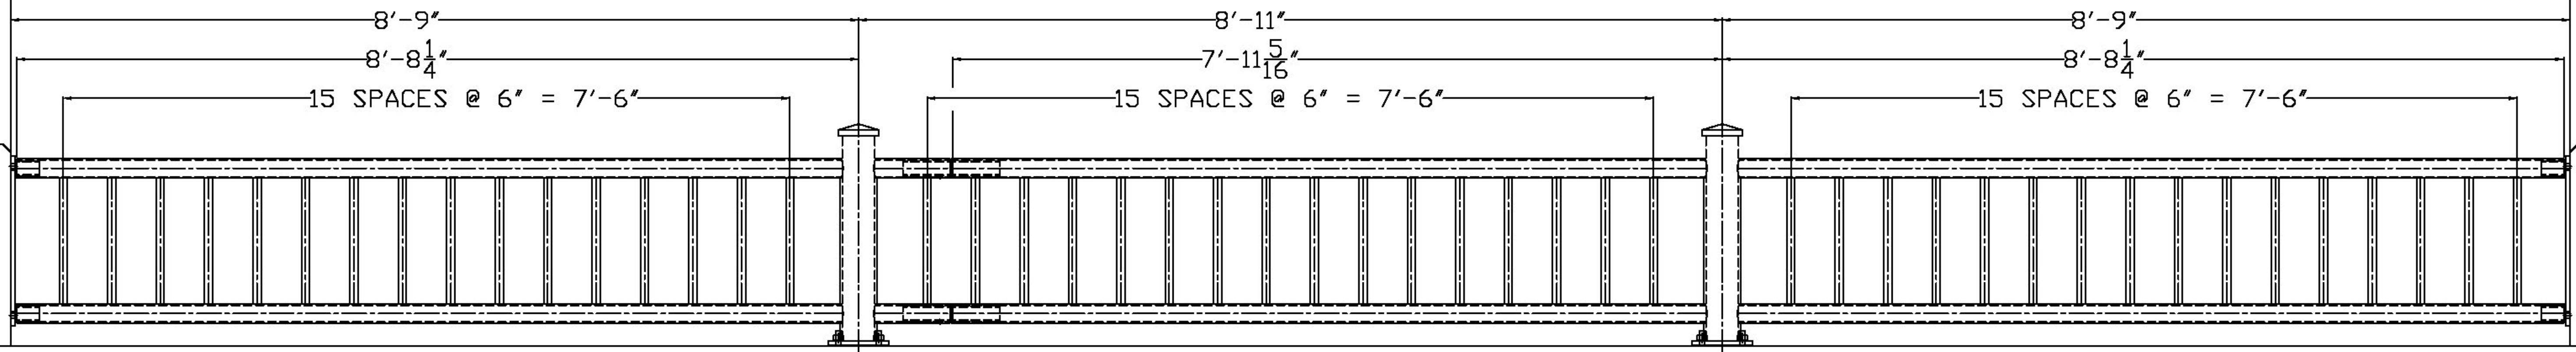

RAIL "B-3"

RAIL "C-4"


BREAK LINE "B"

SOUTH RAILING, FACING SOUTH

BREAK LINE "C"

27'-5"

NOTE: FACE OF RAIL IS 235'-3" CONVEX

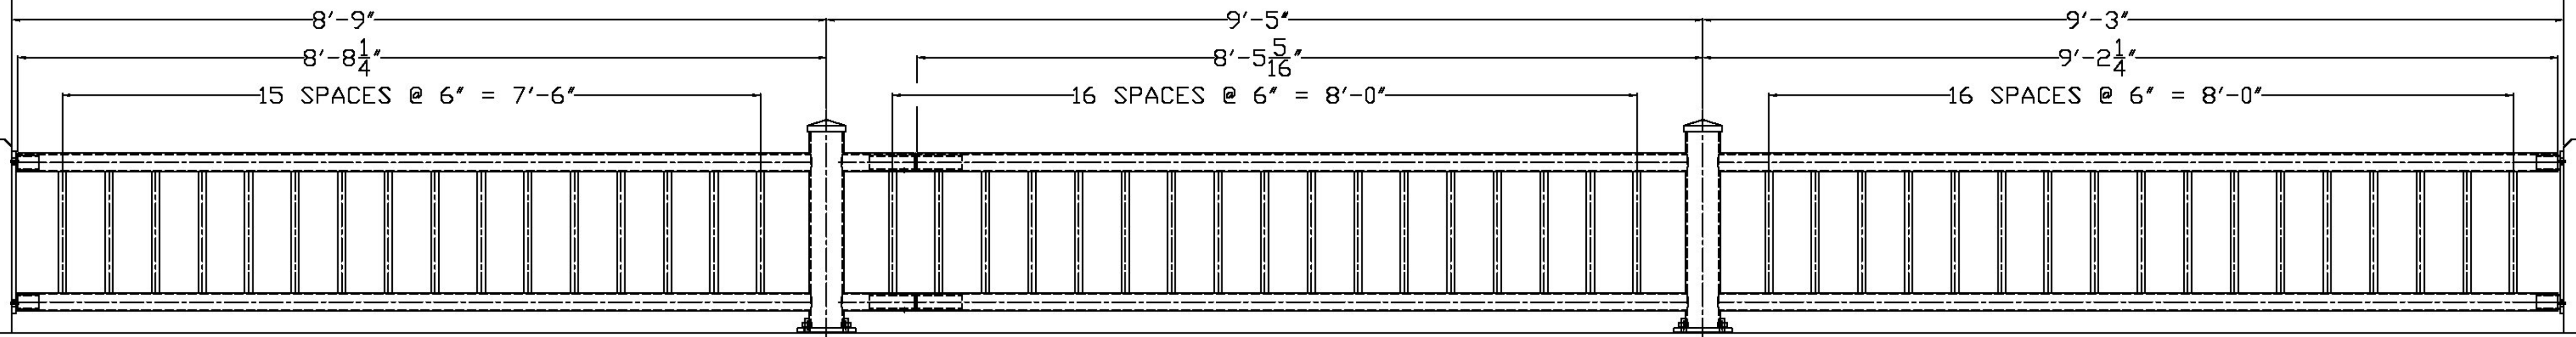

RAIL "B-4"

RAIL "A-2"

BREAK LINE "C"

SOUTH RAILING, FACING SOUTH

Vermont Agency of Transportation

RECEIVED

CK'D BY JAG OK'D BY JEL

December 12, 2012

RESUBMIT NO Approved

BY J. LACROIX DATE 02/01/13

ITEM #: 900.640

GEN CONTR: F.R. LAFAYETTE

SHEET 4 OF 6

APPROVED BY:

BRIDGE RAIL DETAILS SHEET

BARRE TOWN BR# 6100 (7)

TOWN OF BARRE, WASHINGTON COUNTY, VT.

R	NO.	DATE	DESCRIPTION	BY	R	NO.	DATE	DESCRIPTION	BY
E					E				
V					V				



ELDERLEE, INC.

OAKS CORNERS, NEW YORK 14518

E-Mail: dlong@elderlee.com

Tel: 315-789-6670 Fax: 315-789-6615



DRAWN	E.P.	12/04/12
CHECKED	D.L.	12/04/12
APPROVED		
SCALE	SCHEMATIC	
DRAWING NO. F.R. LAFAYETTE-BARRE		