


SHIPMENT : DRAWING : 502527L PROJ: 502527L S-PROJECT: 502527L

PLOTTED: MW/00/YY Hh/mms BY: XXXXXXXX

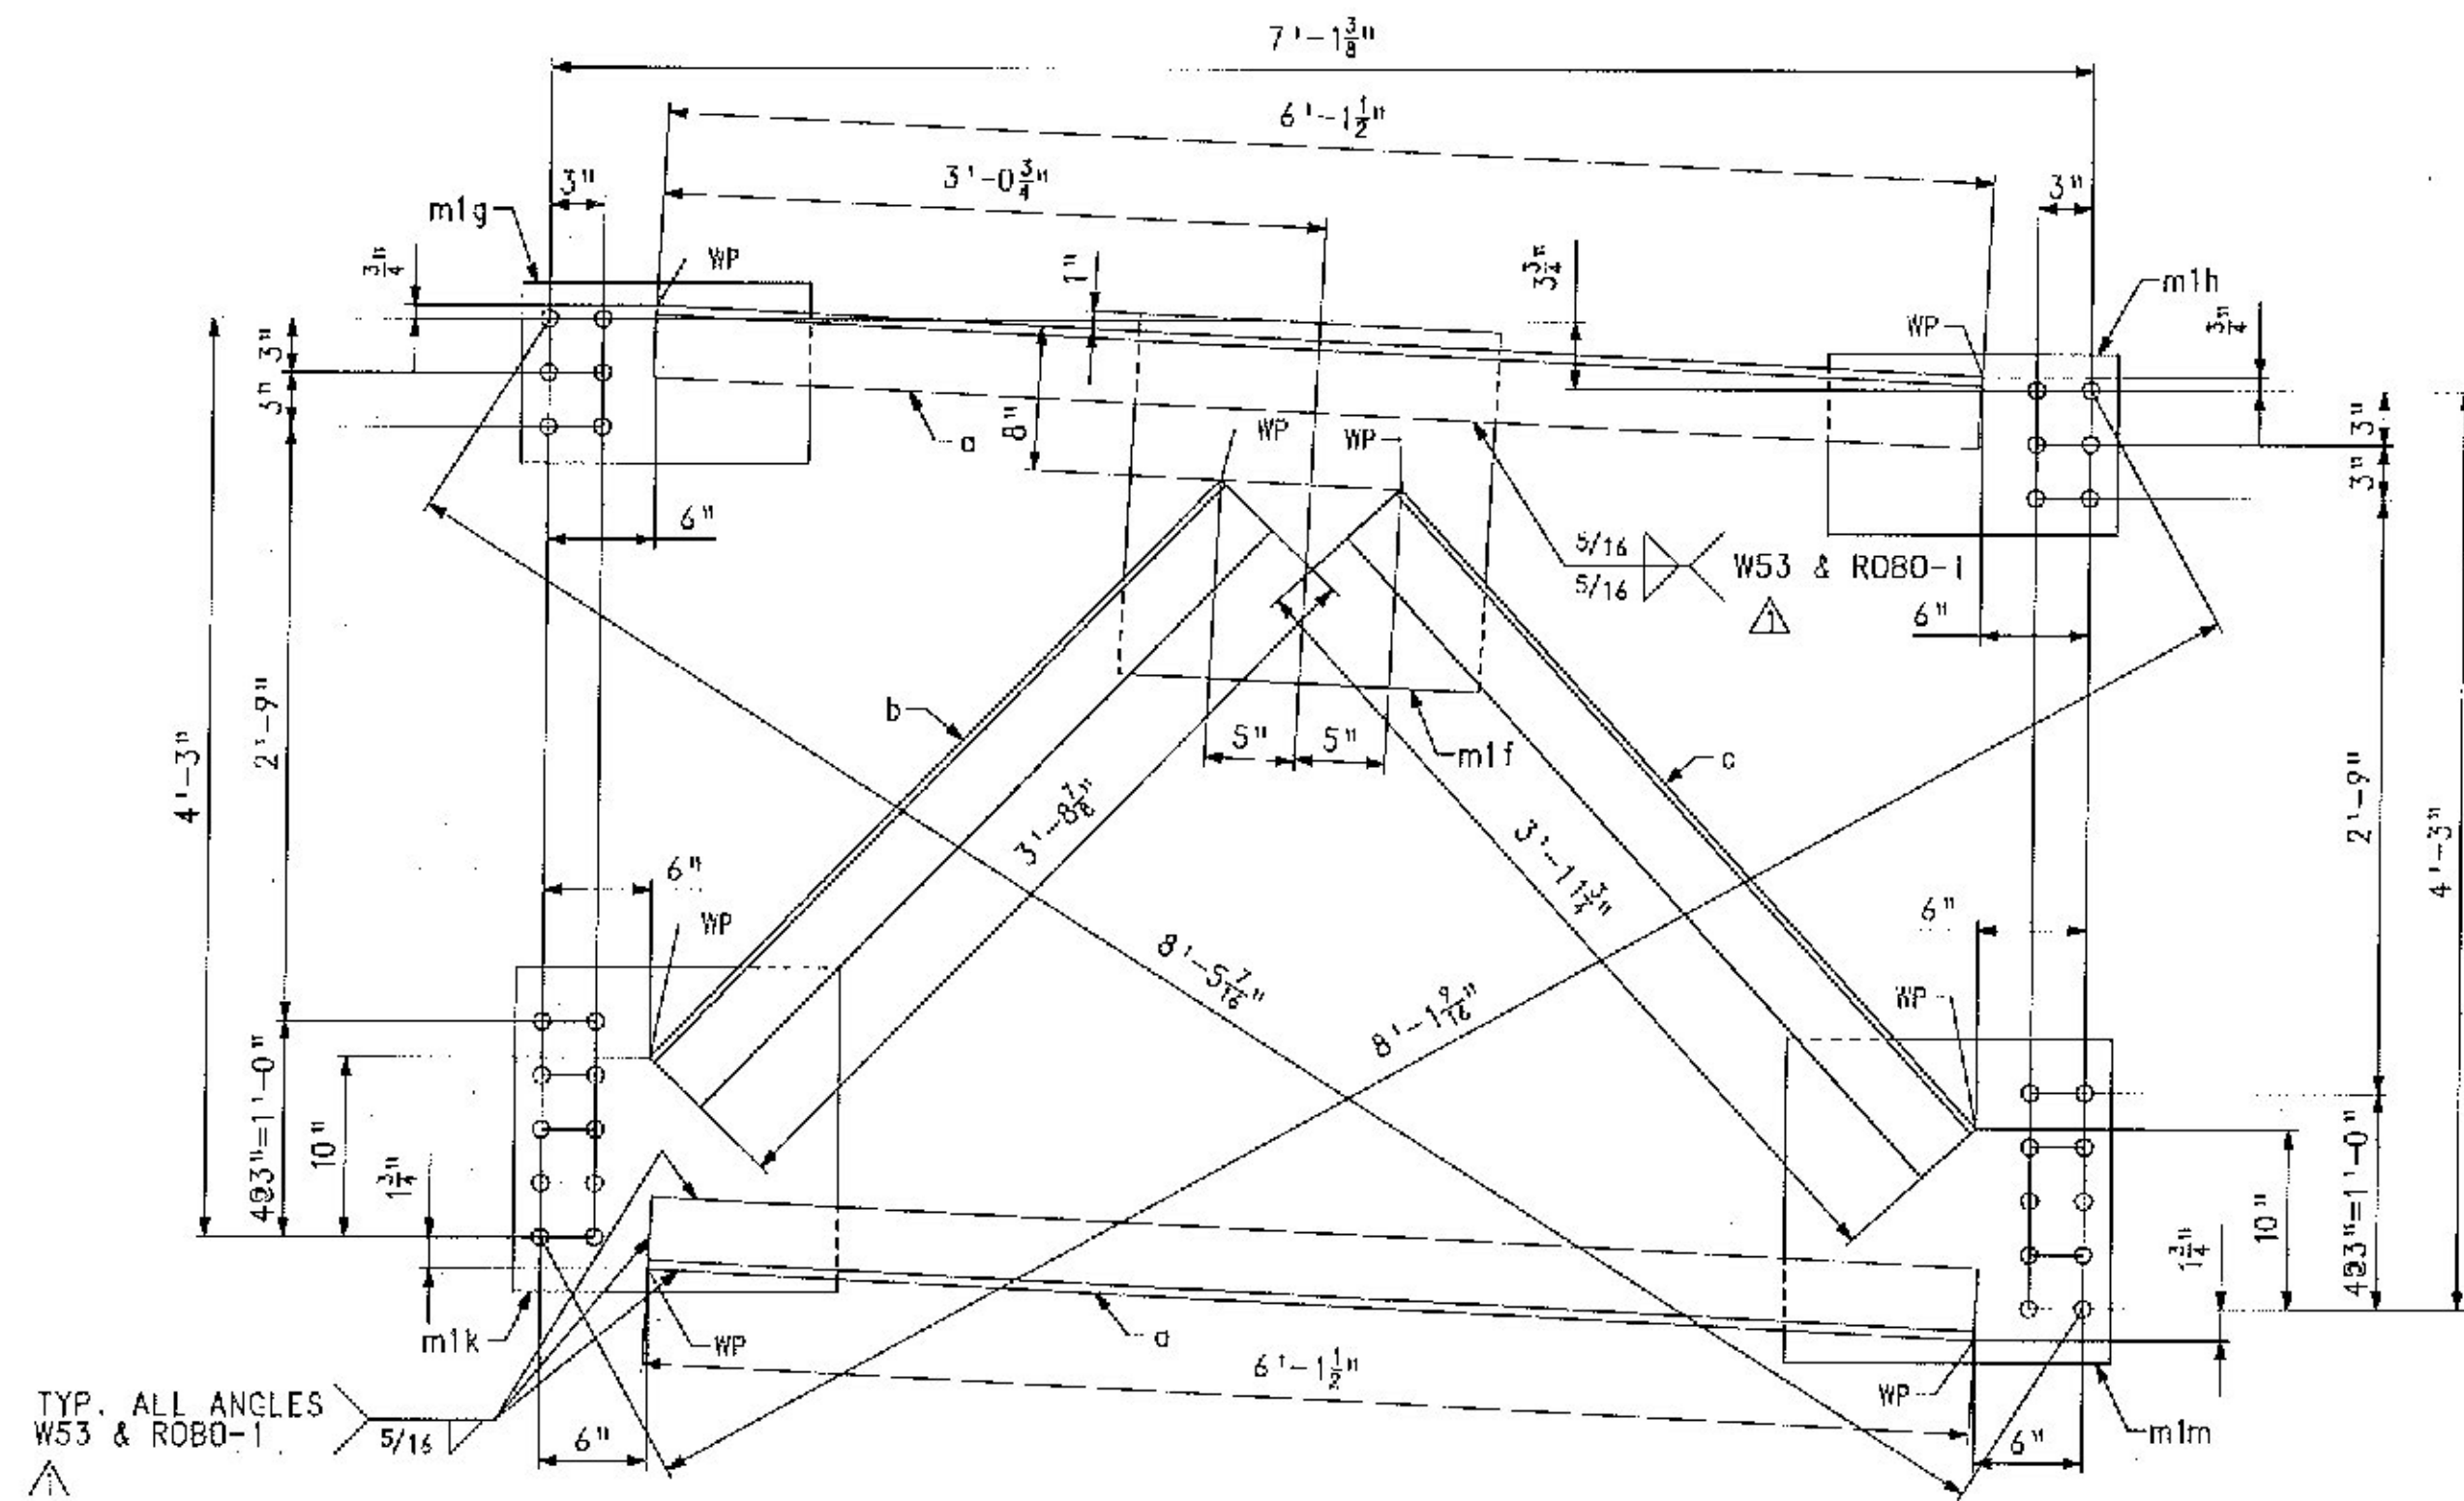

CROSSFRAME MK. CF5

BILL OF MATERIAL

QTY	MARK	COVH.	DESCRIPTION	LENGTH	SPFC	GRADE	TEST	REMARKS	ITEM	WEIGHT P.A. (LBS)
18	CF5		CROSSFRAME							445
2	a	L	4 x 4 x 1/2	6	1 1/2	M270	50W	T	1100	1
1	b	L	4 x 4 x 1/2	3	8 7/8	M270	50W	T	1100	1
1	c	L	4 x 4 x 1/2	3	13 3/4	M270	50W	T	1100	1
1	m1g	PL	1/2 x 10	1	4	V270	50W	T	1100	2
1	m1h	PL	1/2 x 10	1	4	M270	50W	T	1100	2
1	m1k	PL	1/2 x 18	1	6	M270	50W	T	1100	2
1	m1m	PL	1/2 x 18	1	6	M270	50W	T	1100	2
1	m1f	PL	1/2 x 20	1	8	M270	50W	T	1100	2

Vermont Agency of Transportation

**RECEIVED**

OK'D BY J. CLARK OK'D BY J. GRIFFIN

February 12, 2013

RESUBMIT NO Approved

BY J. LACROIX DATE 02/25/2013

△			
△			
△	DETAIL ERROR: REV. WELD DESIGNATION	SSL	MGK 2-5-13
NO.	REVISION	BY	CHK'D DATE
FILES	15/16" ⌀		
SOLTS	NONE		
COATING	NONE		
CODE(S)	63		
SCALE	N.T.S.		
STAT. CONT. OR REF. NO.		FED. AND PROJ. NO.	
GENERAL CONTRACTOR	MILLER CONSTRUCTION, INC.	SSI PROJ. MGR	
DRAWING MANAGER	JOSH MURRY (IH)	MADE BY	CDS
SSI PROJECT MGR	S-1120266A-1	DATE	12/27/12
		DRAWING INSPECTOR	14 OF 14

FOR GENERAL SHOP NOTES, SEE DRAWING GN1.