
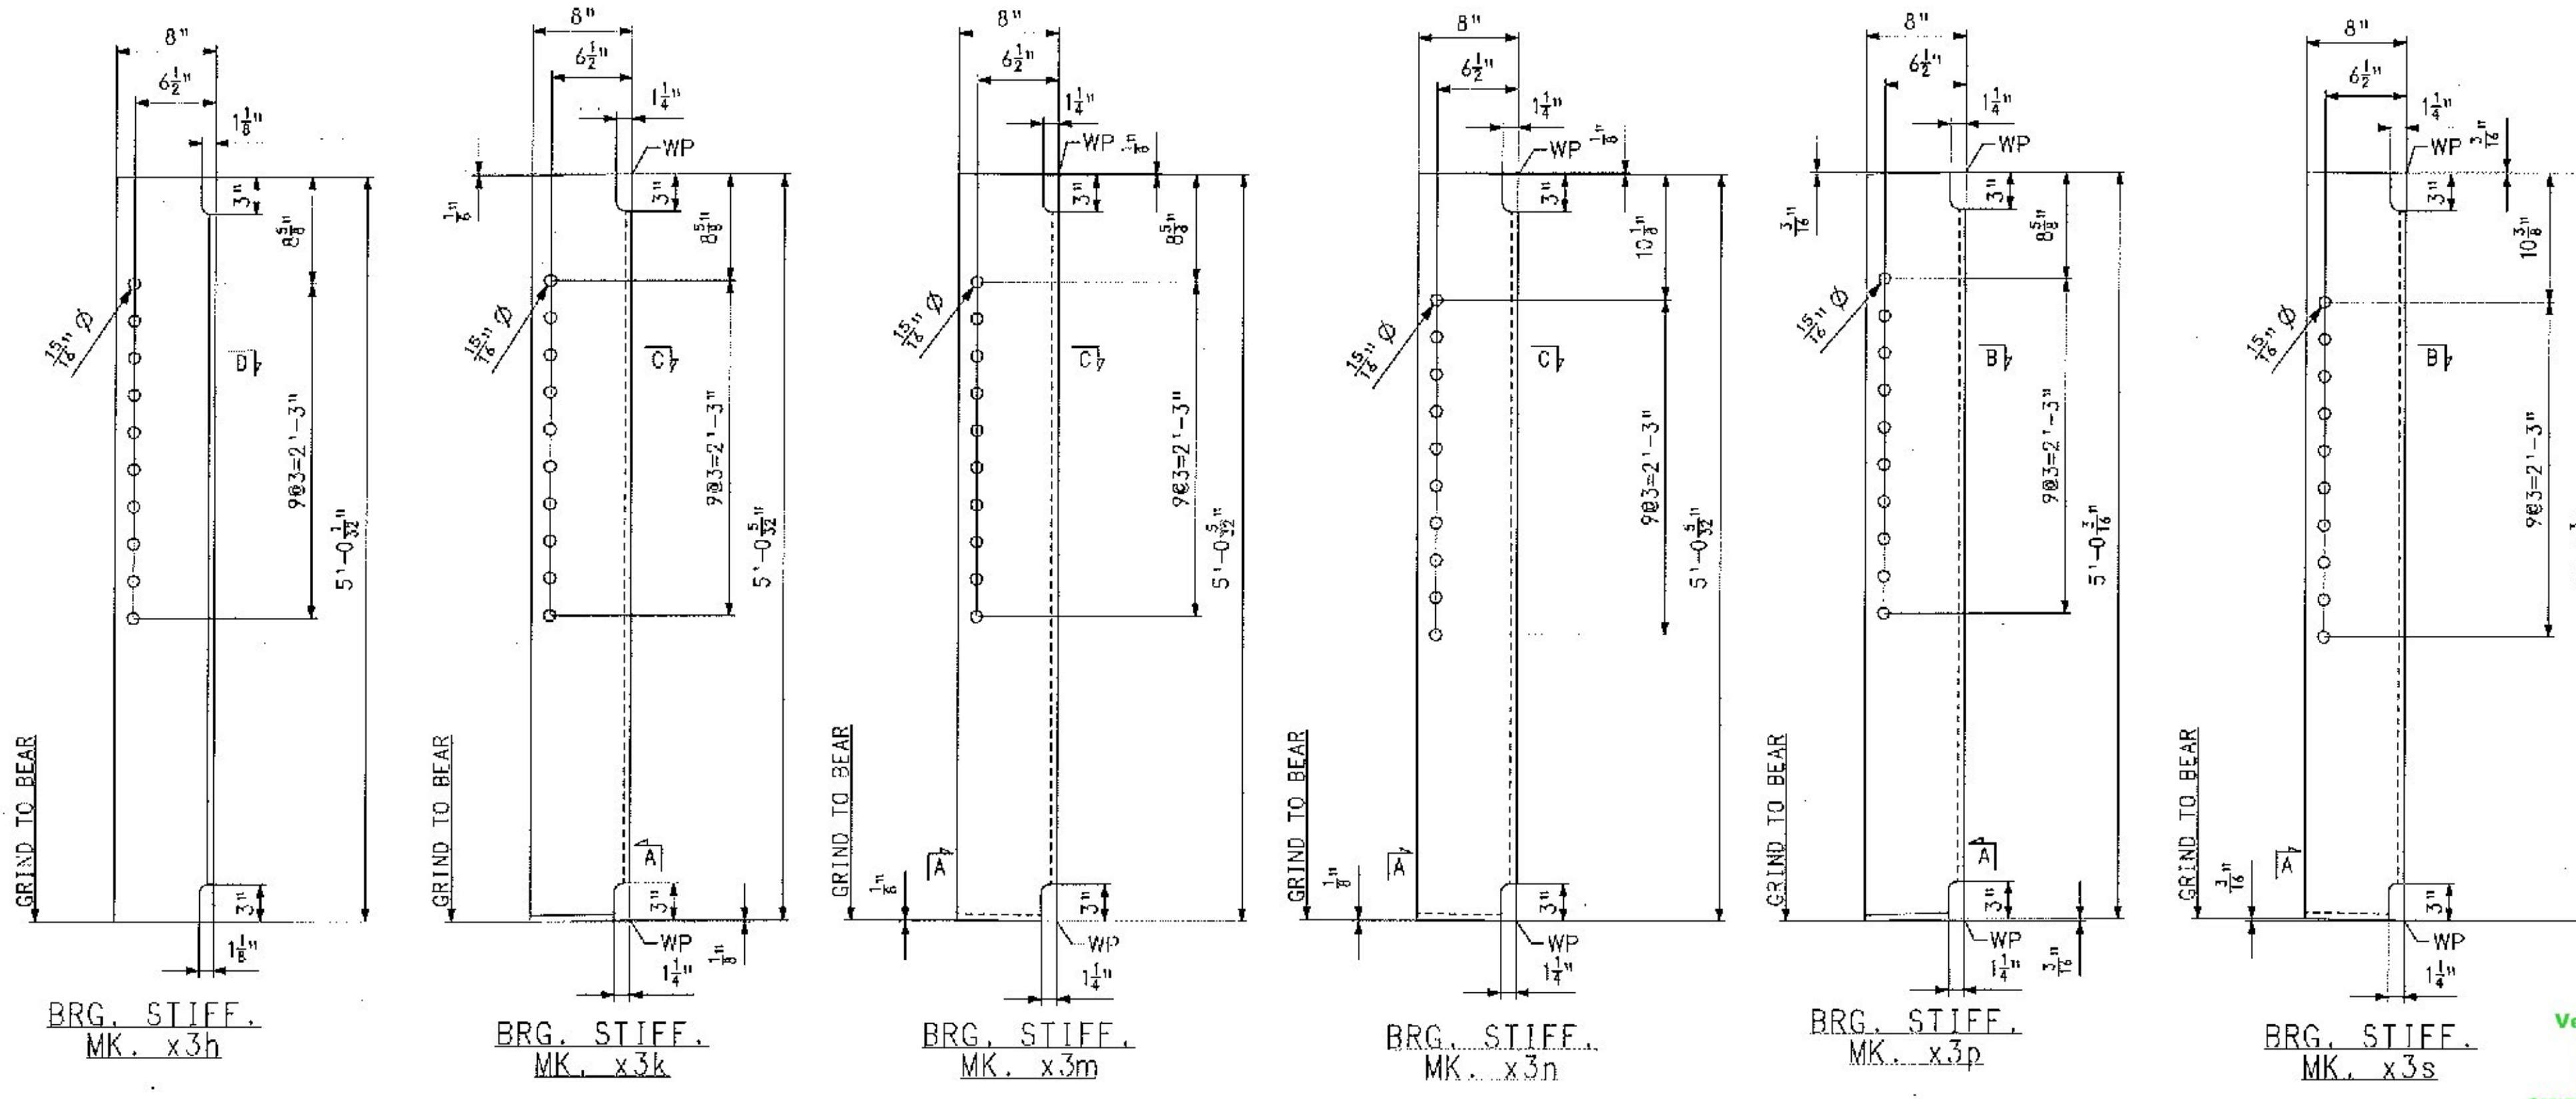



SHIPMENT 1 PAKING: 5025751 PRO: 5025752 SHIP/PACKET: 5025753

BY: XXXXXXXX

PLOTTED: MM/DD/YY H:\mss

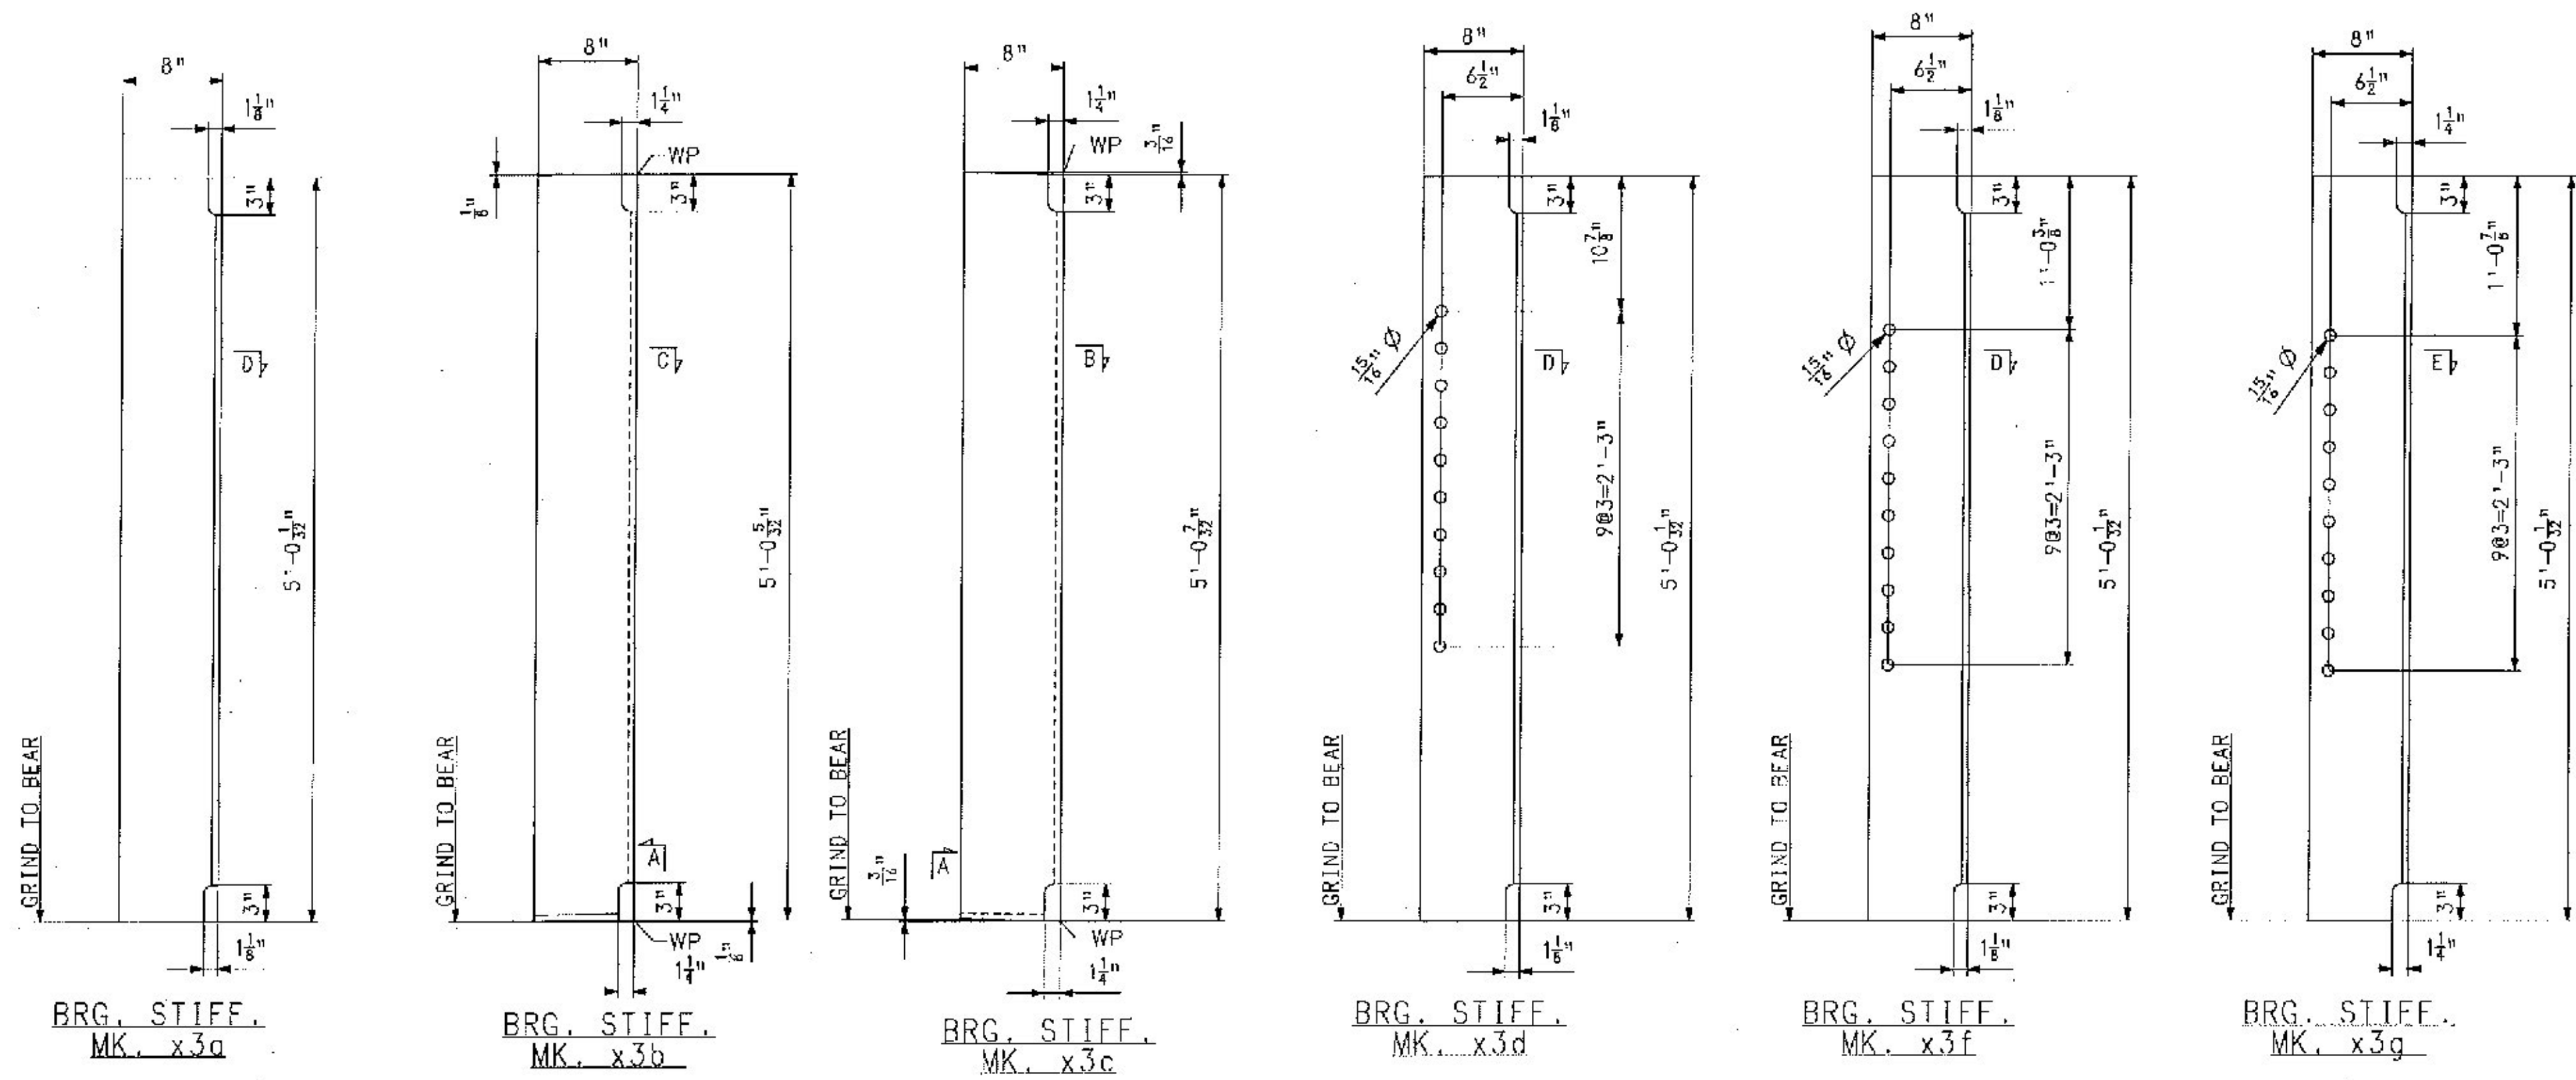

BILL OF MATERIAL											
QTY	MARK	COMM.	DESCRIPTION	LENGTH	SPEC	GRADE	TEST	REMARKS	ITEM	WEIGHT EA. (LBS)	
2	x3a	PL	3/4 x 8	5'-0 1/32"	V270	50W			07001	102	
1	x3b	PL	3/4 x 8	5'-0 9/32"	V270	50W			07001	103	
1	x3c	PL	3/4 x 8	5'-0 3/8"	M270	50W			07001	103	
1	x3d	PL	3/4 x 8	5'-0 1/32"	M270	50W	T		07001	102	
1	x3f	PL	3/4 x 8	5'-0 1/32"	M270	50W	T		07001	102	
1	x3g	PL	3/4 x 8	5'-0 1/32"	M270	50W	T		07001	102	
3	x3h	PL	3/4 x 8	5'-0 1/32"	M270	50W	T		07001	102	
1	x3k	PL	5/4 x 8	5'-0 5/16"	M270	50W	T		07001	103	
1	x3m	PL	3/4 x 8	5'-0 9/32"	M270	50W	T		07001	103	
1	x3n	PL	3/4 x 8	5'-0 5/16"	M270	50W	T		07001	103	
1	x3p	PL	3/4 x 8	5'-0 3/8"	M270	50W	T		07001	103	
1	x3s	PL	3/4 x 8	5'-0 3/8"	V270	50W	T		07001	103	

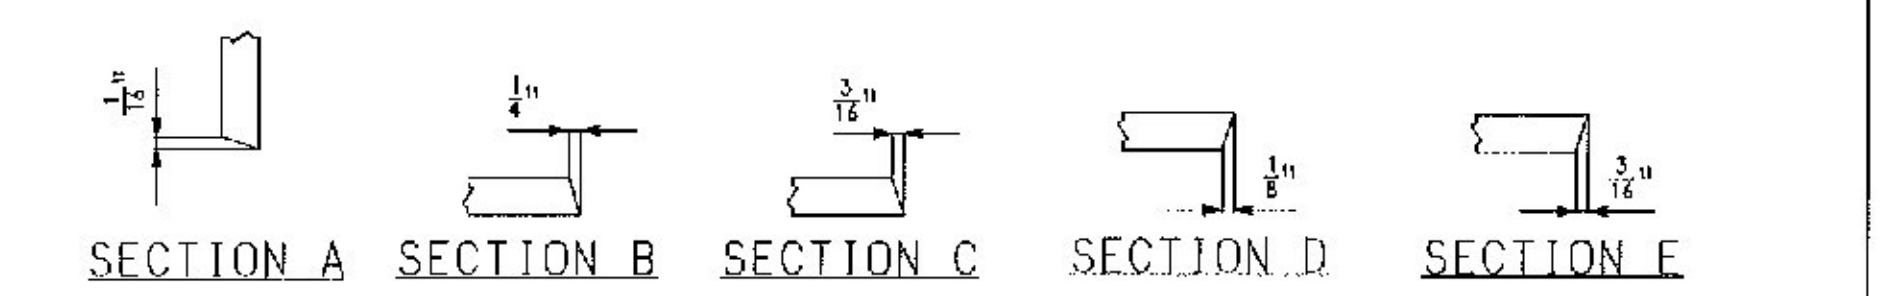

Vermont Agency of Transportation
RECEIVED
 CK'D BY J. CLARK OK'D BY J. GRIFFIN
 February 12, 2013
 RESUBMIT NO Approved
 BY J. LACROIX DATE 02/25/2013

FOR GENERAL SHOP NOTES, SEE DRAWING GN1.

NO.	REVISION	BY	CHK'D	DATE
1				
ROUTE NO. 117 (BRIDGE ST.) OVER STEVENS BRANCH ROUTE NO. 117 STA. 13+05.00 TO STA. 14+25.00 BRIDGE NO. 11, TOWN OF BARRE, COUNTY OF WASHINGTON STATE OF VERMONT AGENCY OF TRANSPORTATION				
STATE CONT. OR ISF. NO.	FED. AID PROJ. NO.	MILLER CONSTRUCTION, INC. 1521 PROJ. VER KEN CLIDDEN		
DRAWING MANAGER	JOSH MURRY (1H)	MADE BY	CDS	CHK'D BY
PROJECT NUMBER	S-1120266A-1	DRAWING NUMBER	X3	DATE
				12/27/12