
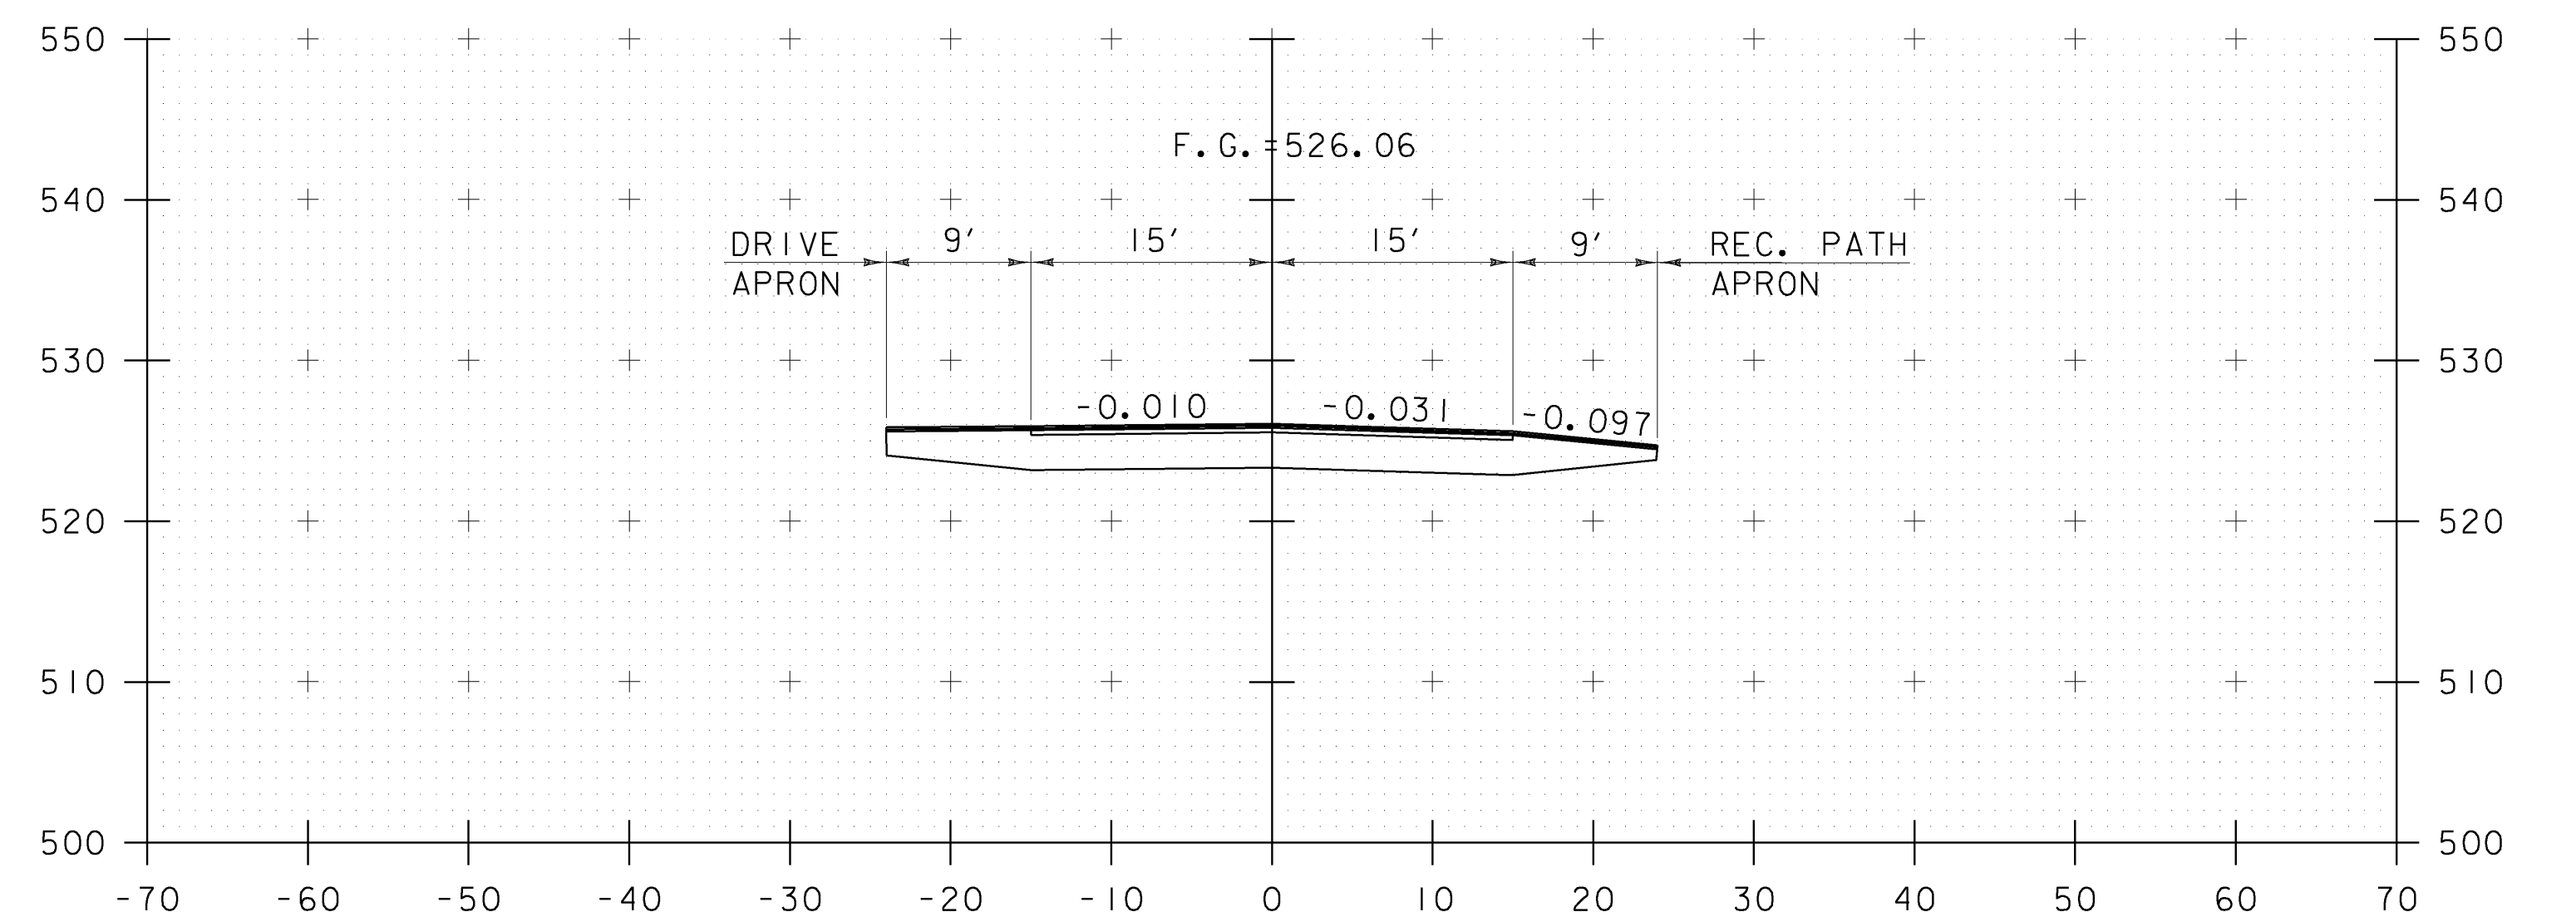
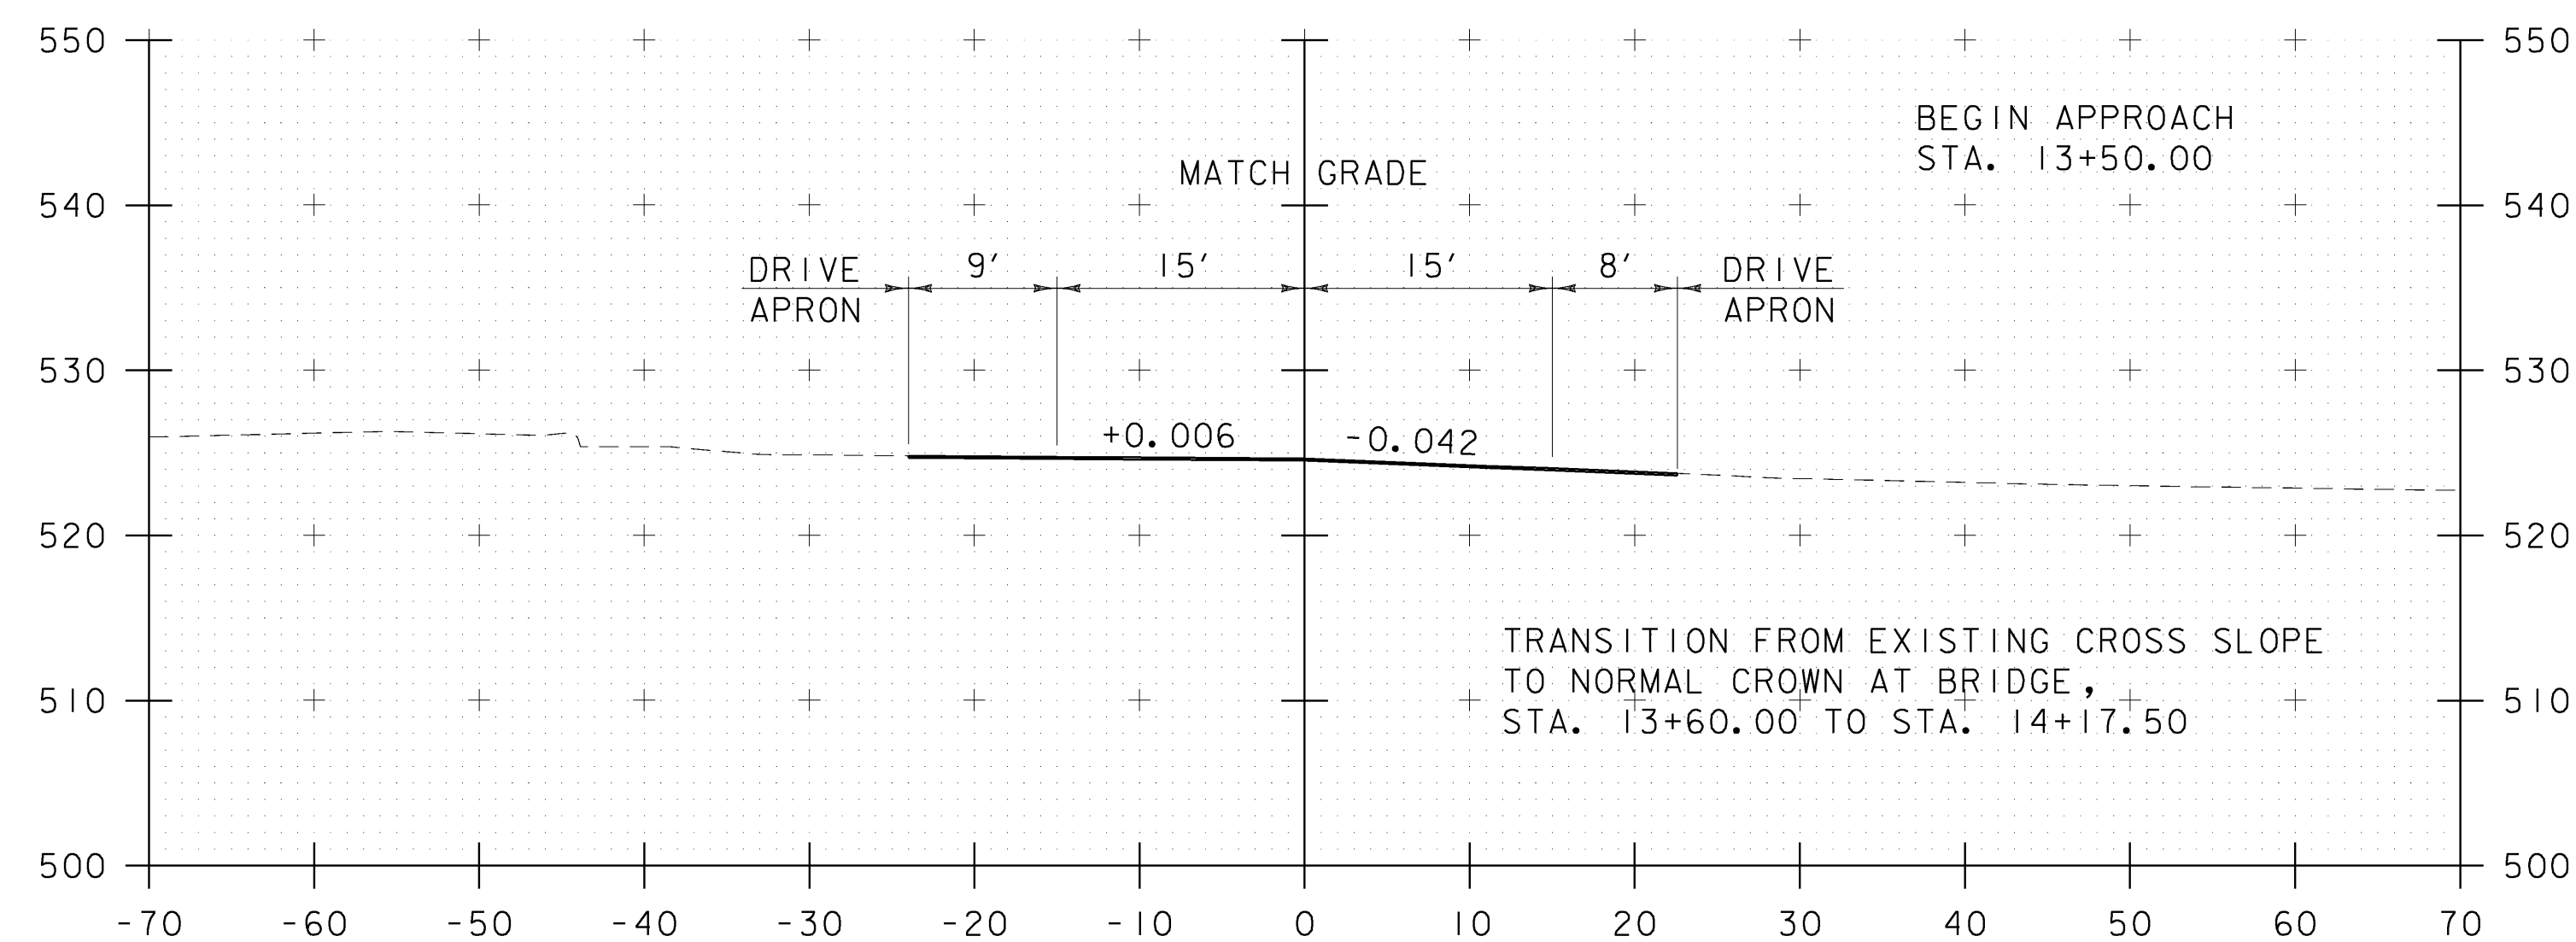
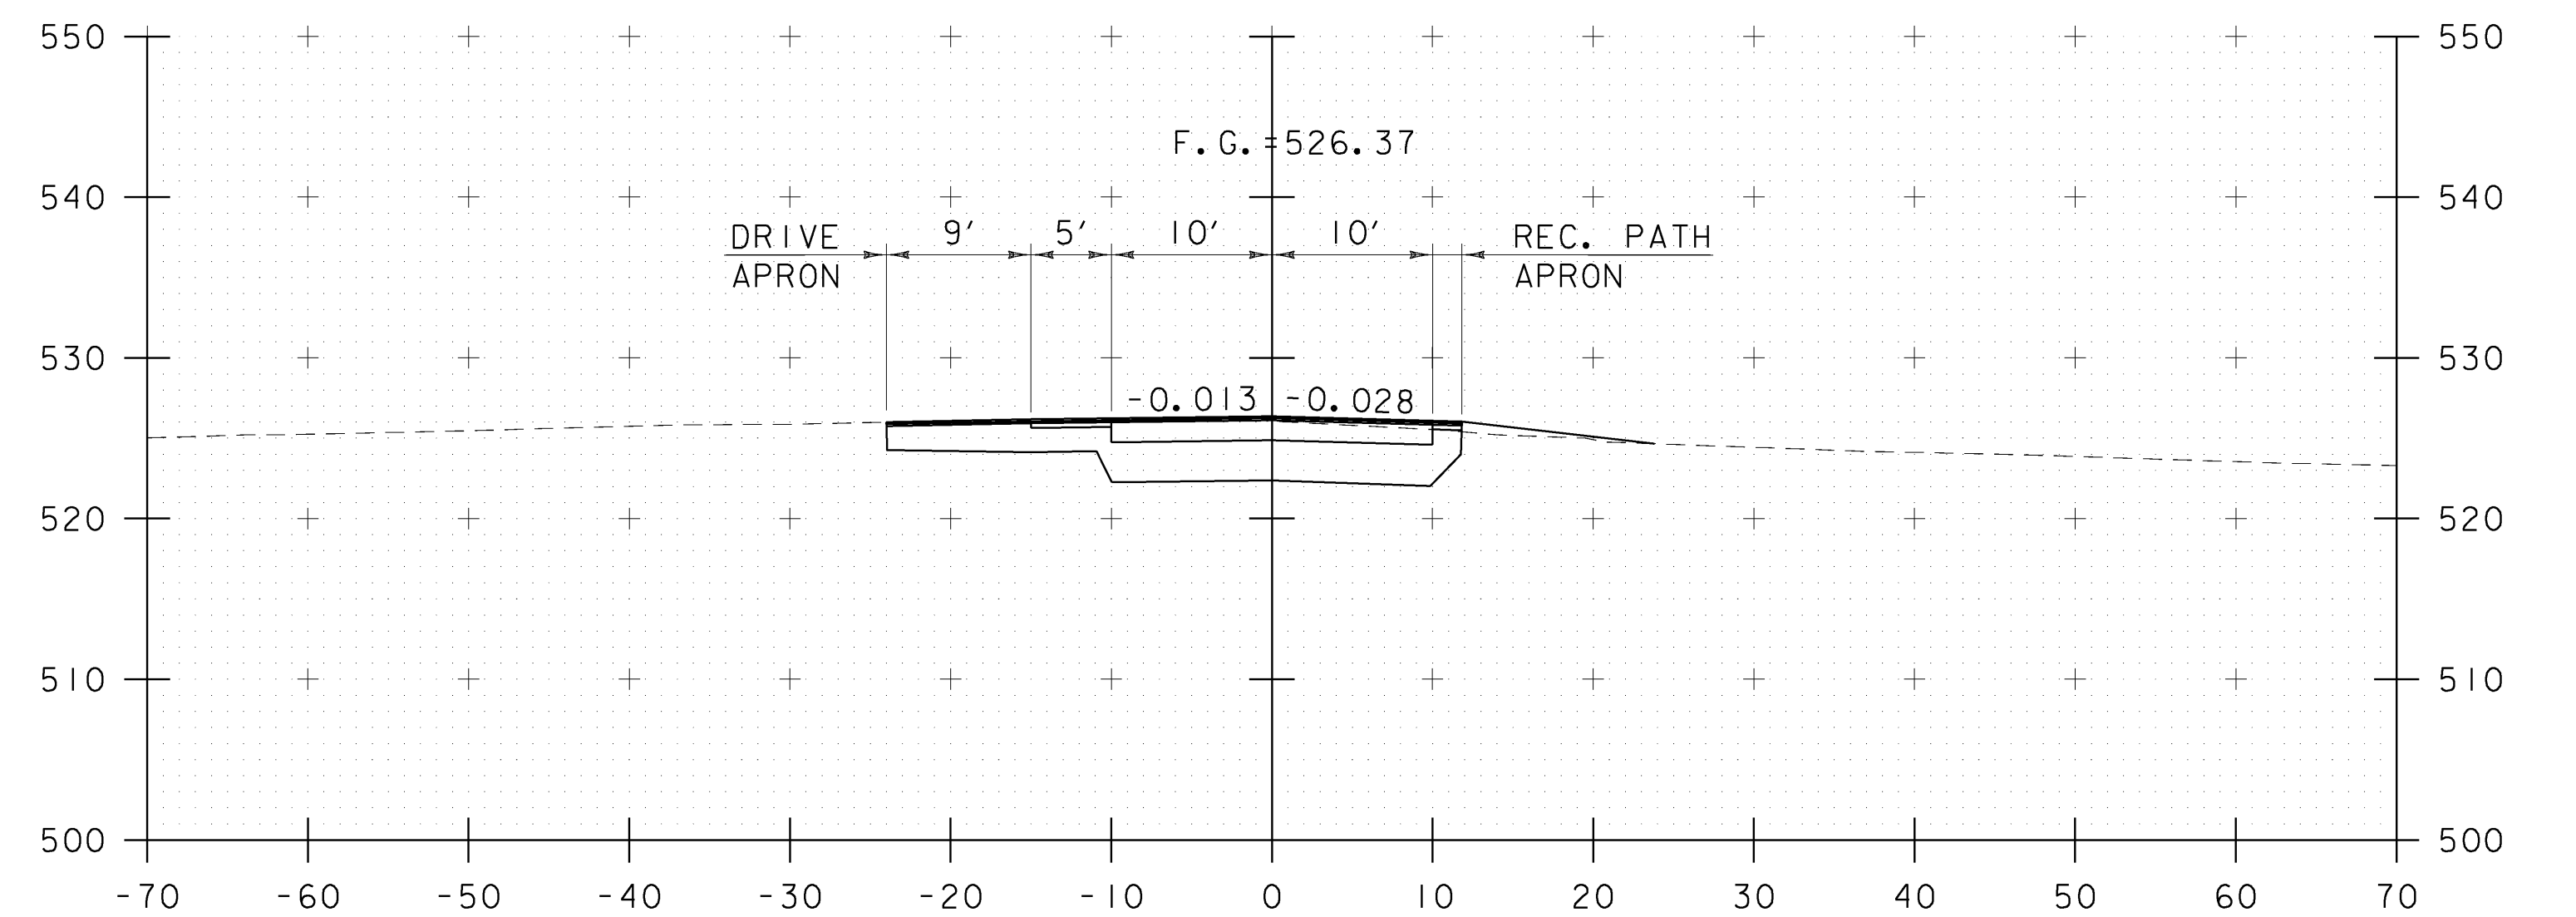


FILE NAME: I:\14595\montpelier\plan\14595_xsc.dgn
DATE/TIME: 10/12/2009
USER: 2552

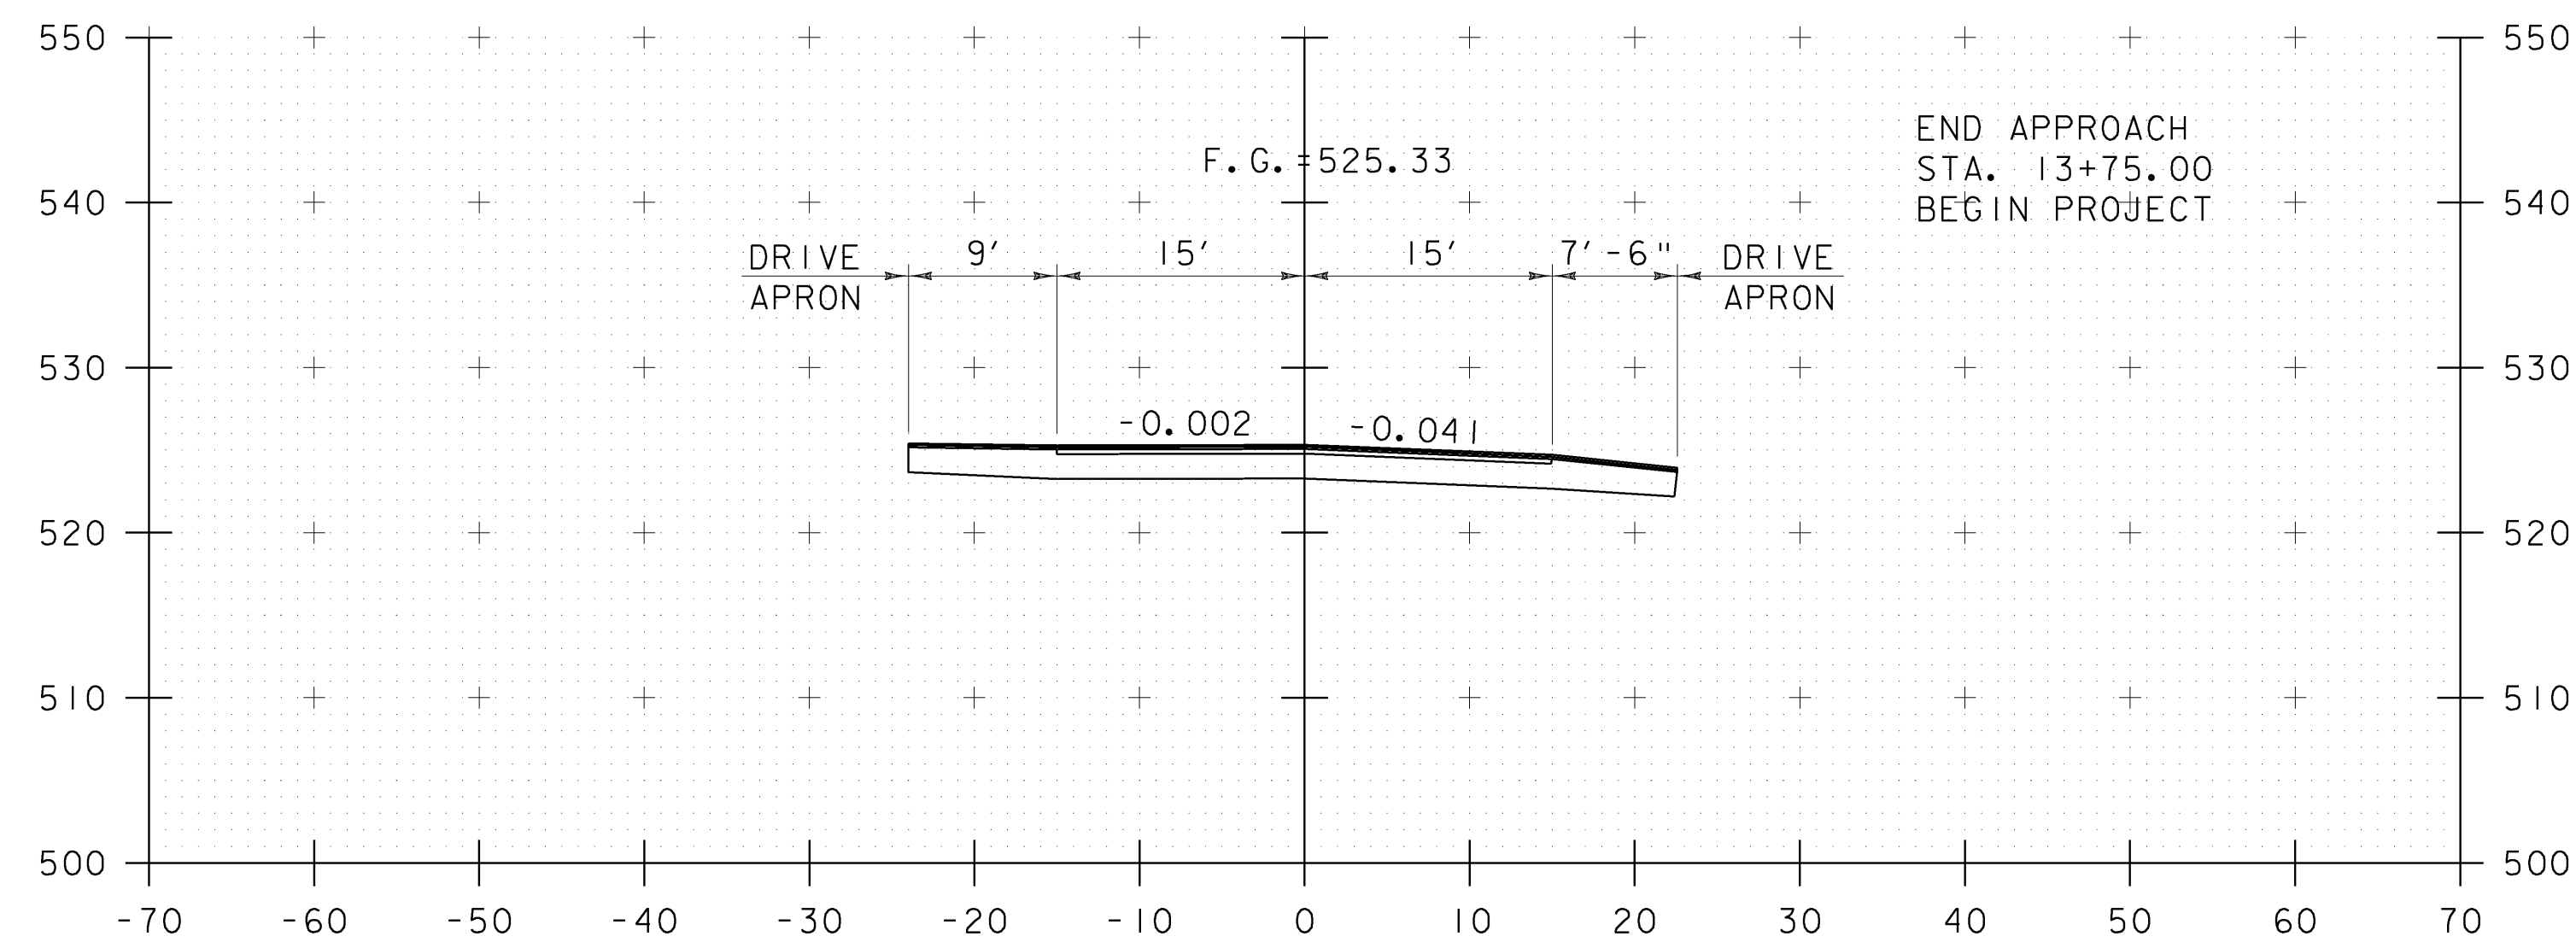

CROSS SECTIONS (I)

PROJECT NAME: MONTPELIER
PROJECT NUMBER: BHF 6400(31)

FILE NAME: \$FILES\$
PROJECT MANAGER: SUSAN SCRIBNER
DESIGNED BY: D. D'AMATO
BRIDGE DESIGN SUPERVISOR: P. HALSTEAD

PLOT DATE: 10/12/2009
DRAWN BY: D. D'AMATO
CHECKED BY: P. PERKINS
SHEET 46 OF 63

SCALE 1" = 10'
10 0 10

