
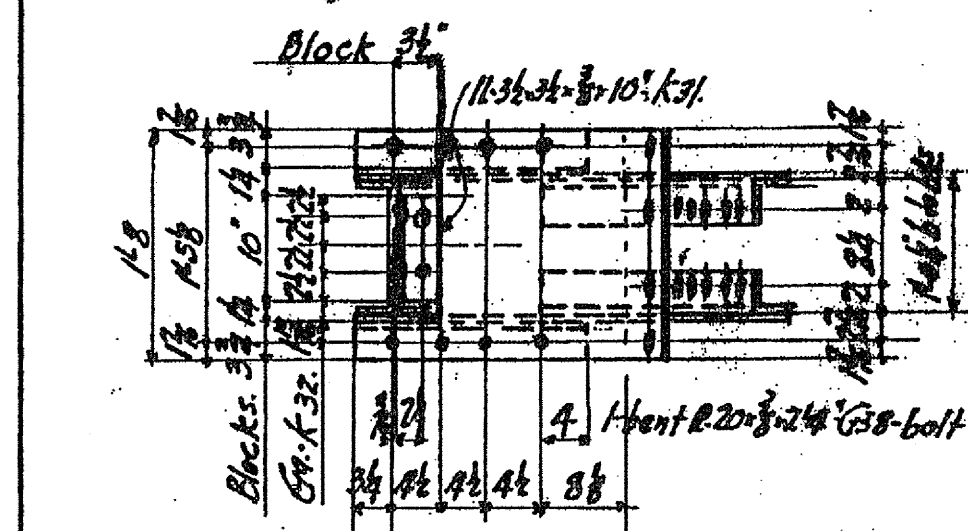


LIST OF MEMBERS.

2	TOP CHORDS - T.C.1
2	- T.C.2
1	BOV. CHORD - B.C.1
	B.C.2
	B.C.3
	B.C.4
	B.C.5
	B.C.6
4	POSTS - P.1
2	- P.2
2	- P.3
2	- P.4
2	- P.5
2	- P.6
2	- P.7
2	DIAGONALS - D.1
2	- D.2
2	- D.3
2	- D.4
2	- D.5
2	- D.6
2	- D.7
4	BRACES - B.1
4	- B.2
4	- B.3
4	- B.4

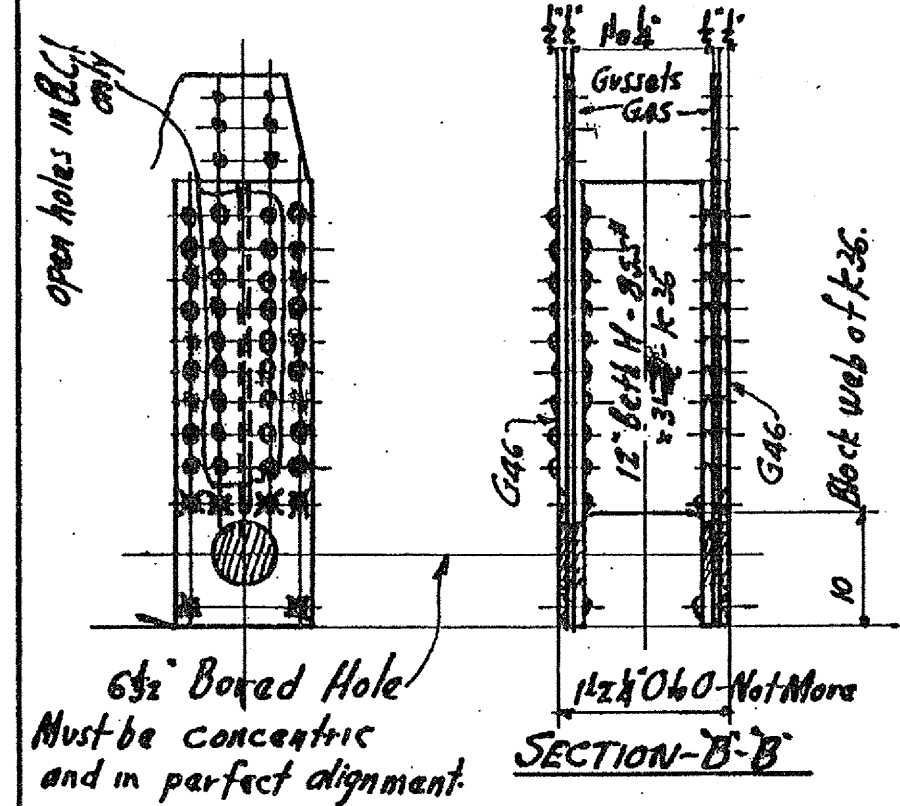

**TAYLOR ST BRIDGE
MONTPELIER VERMONT**

Rev. 5/6/29 checked & approval
TO BE INSPECTED

Rivets 7/8" Unless noted.
Holes 1/8" "
Field Connections.
Shop Bolt 1 Coat Red Lead and Oil as
per specifications.

THE BERLIN CONSTRUCTION CO. INC.
DRAWN BY W.E.D. DATE A
CHECKED BY B.M. (Rev.) DATE S
SCALE 3/8" = 1'-0"
CONTRACT No. 8150
SHEET No. 7 of 8