



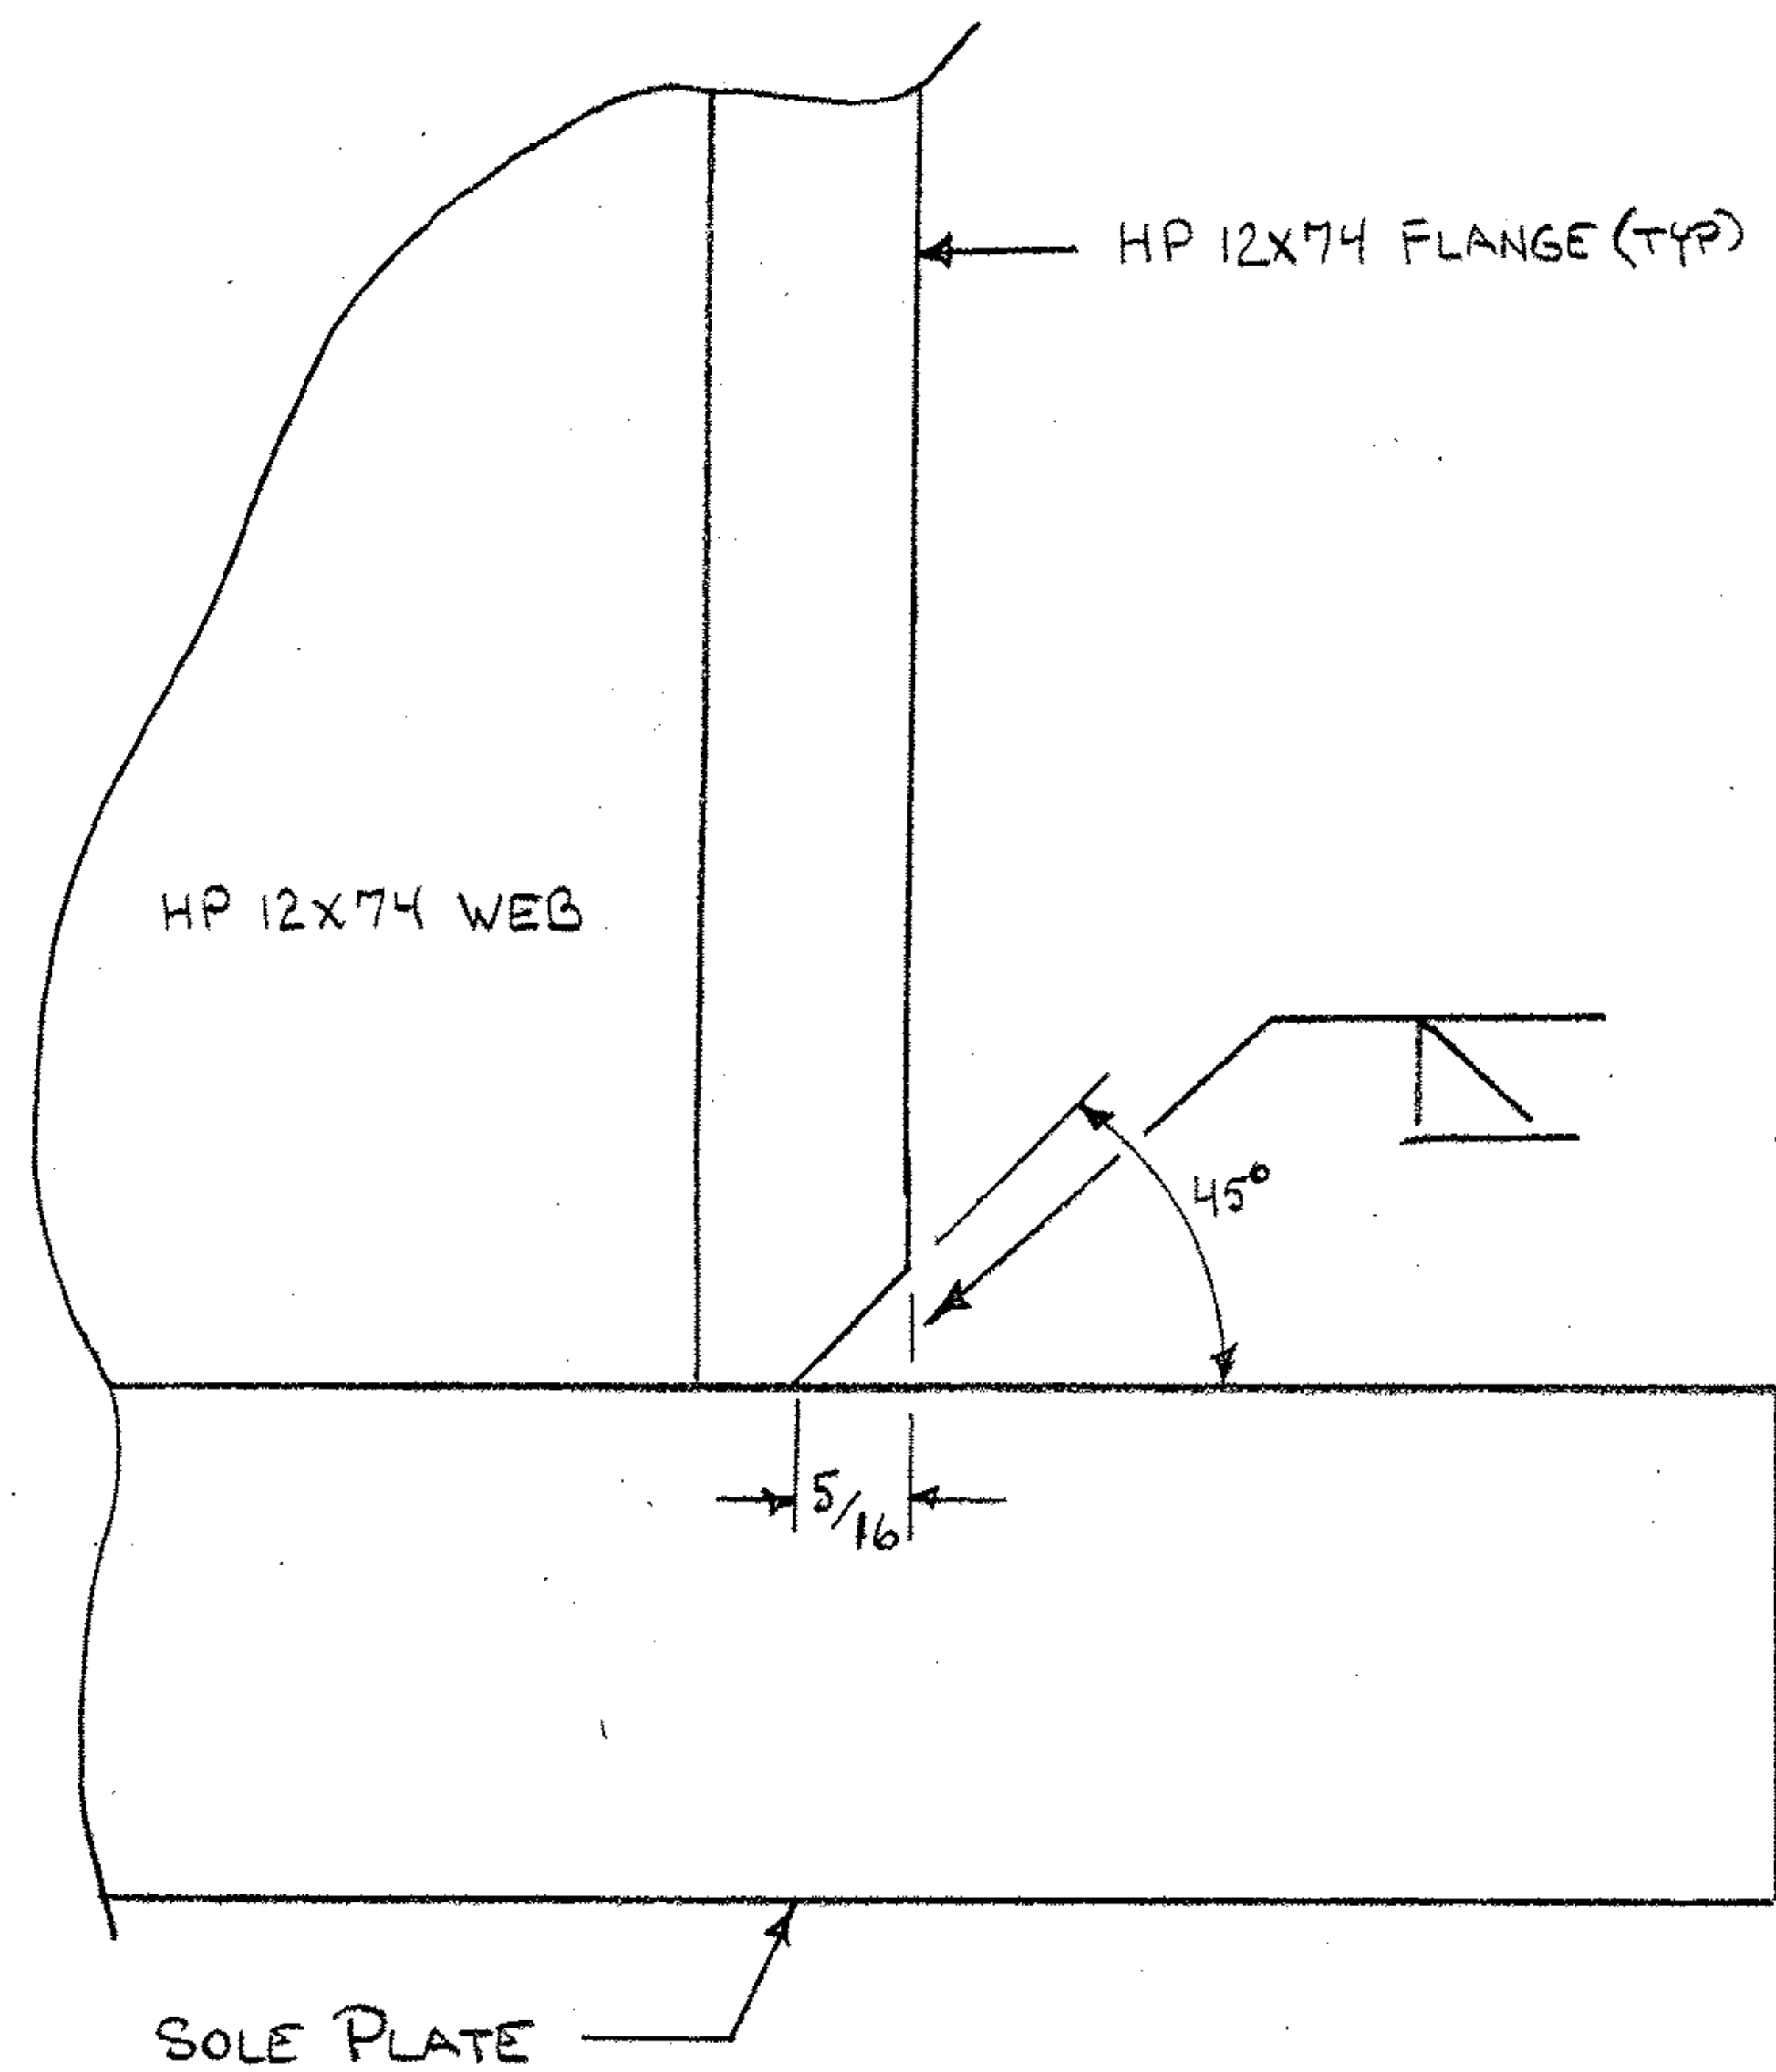

DETAIL 'A'
N.T.S.

SEAL WELD FLANGE ENDS (TYP)

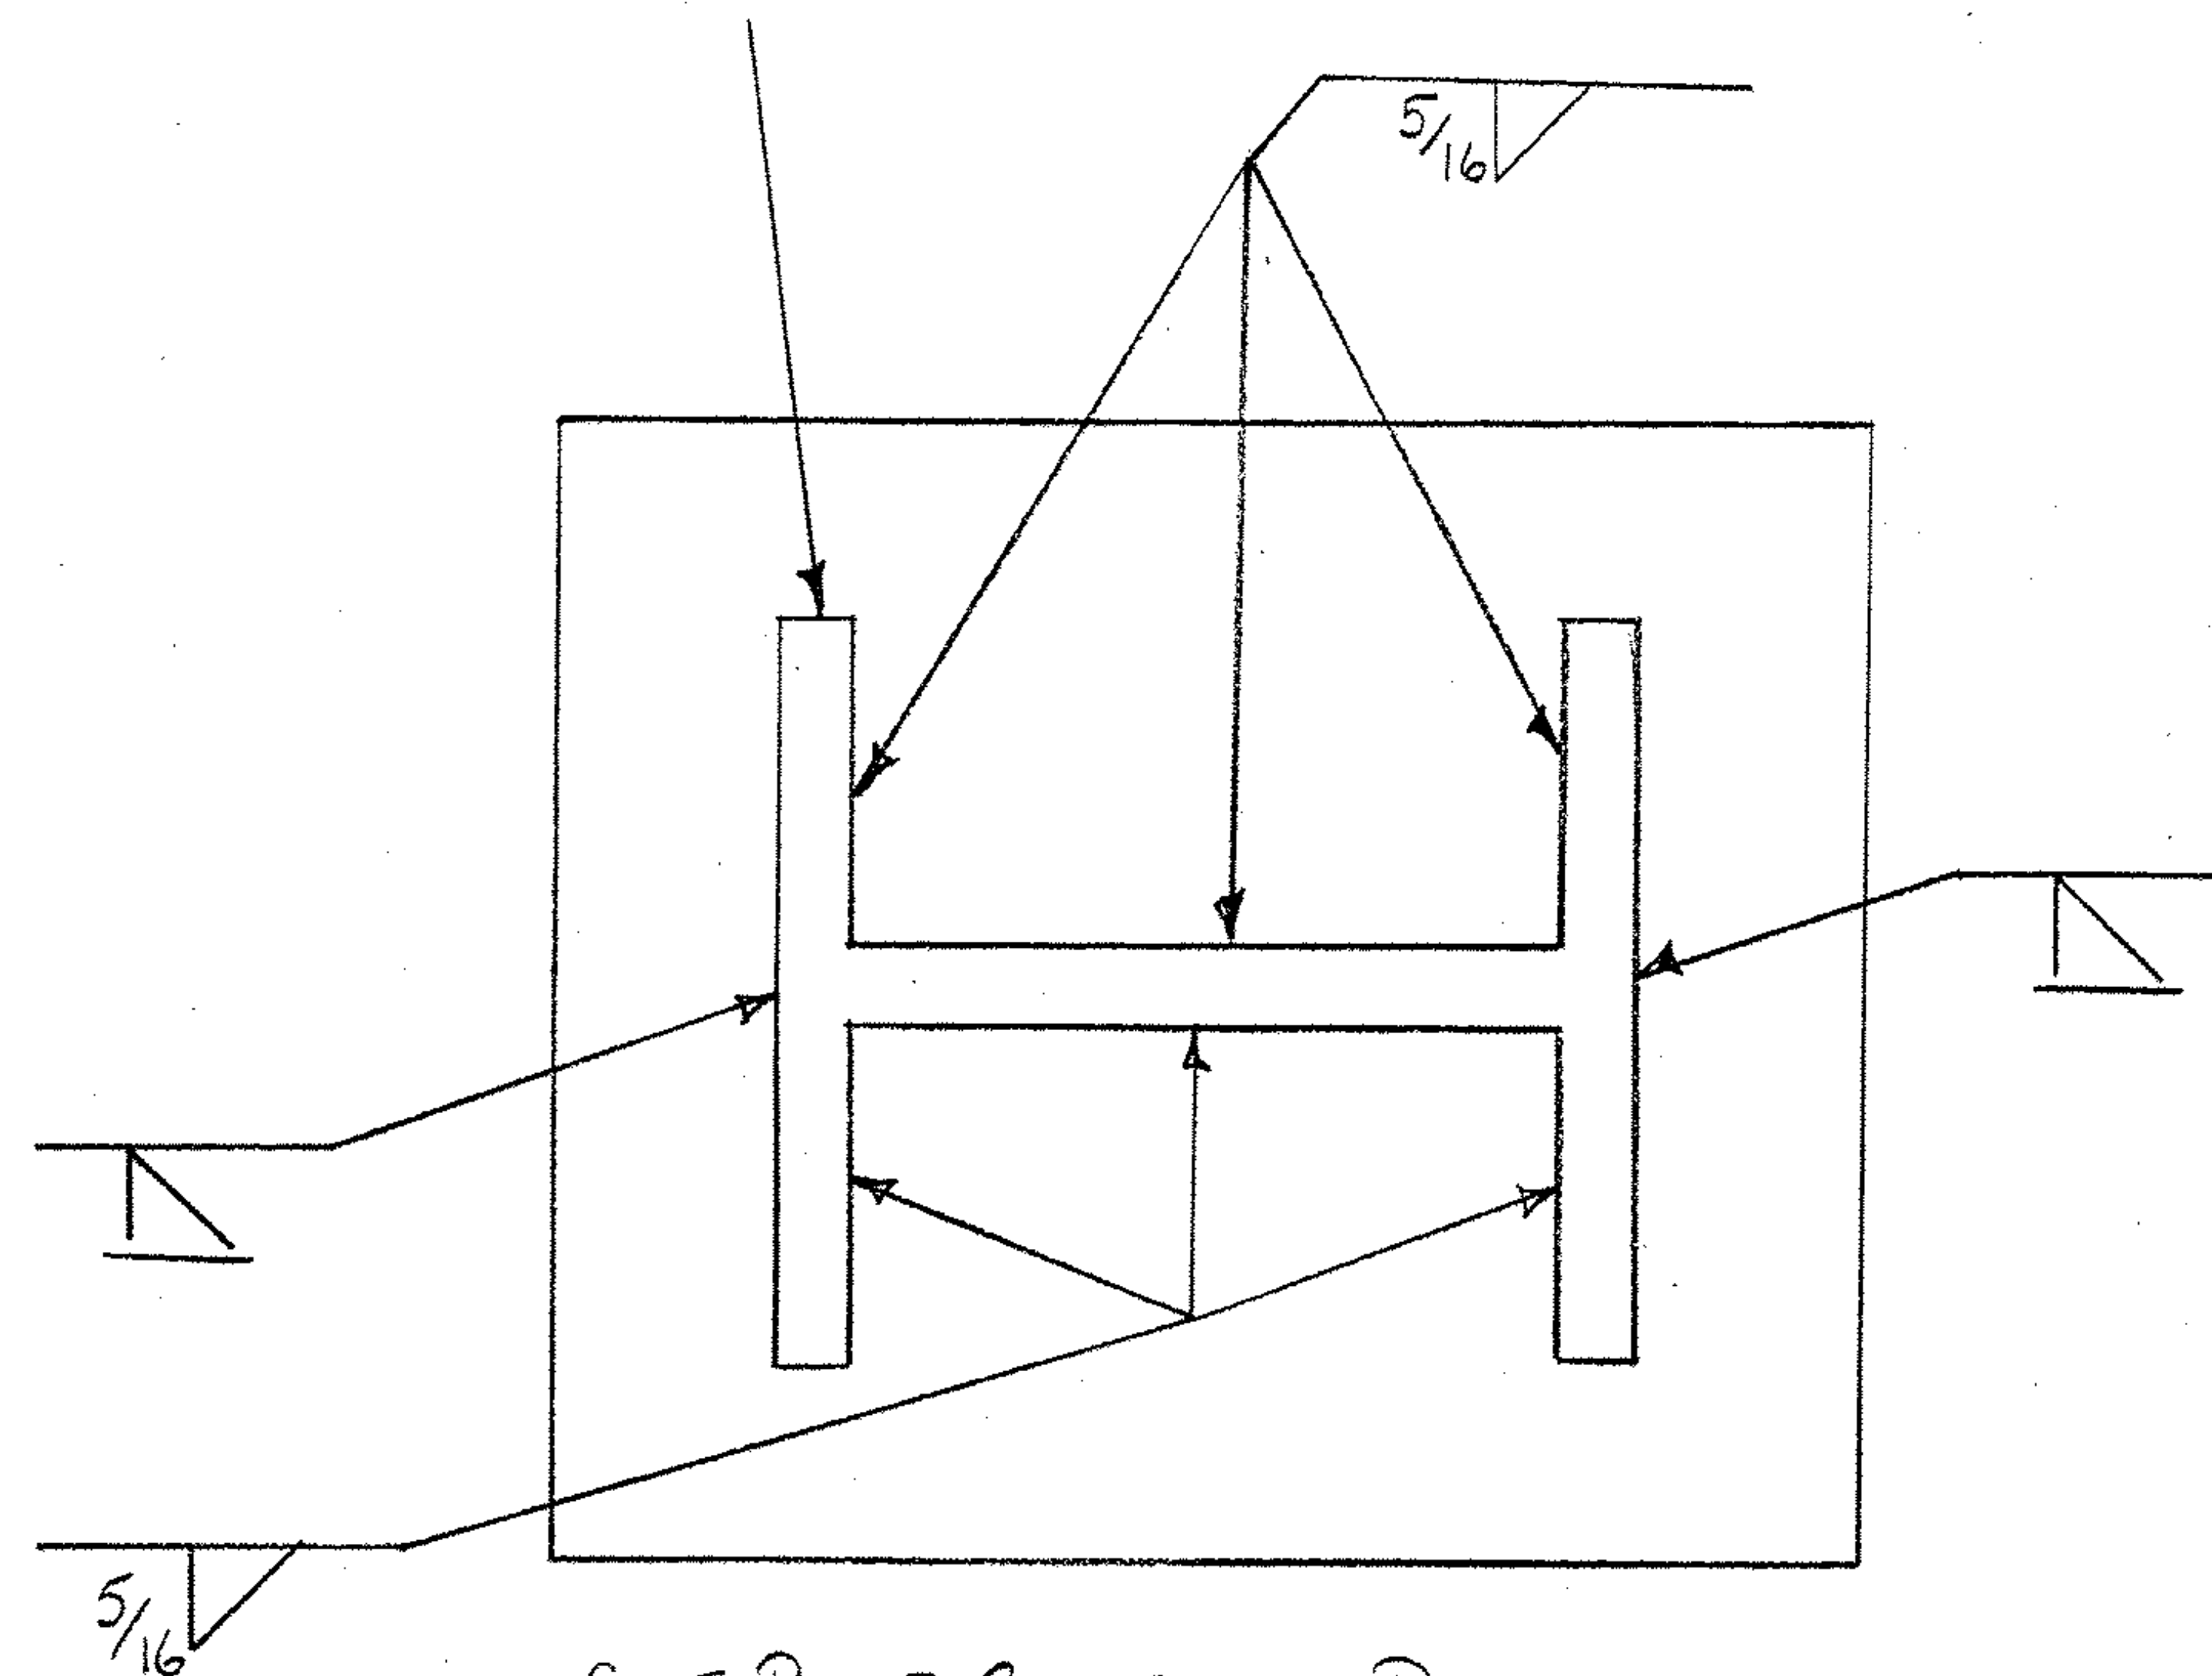

SOLE PLATE CONNECTION DETAIL

N.T.S.