


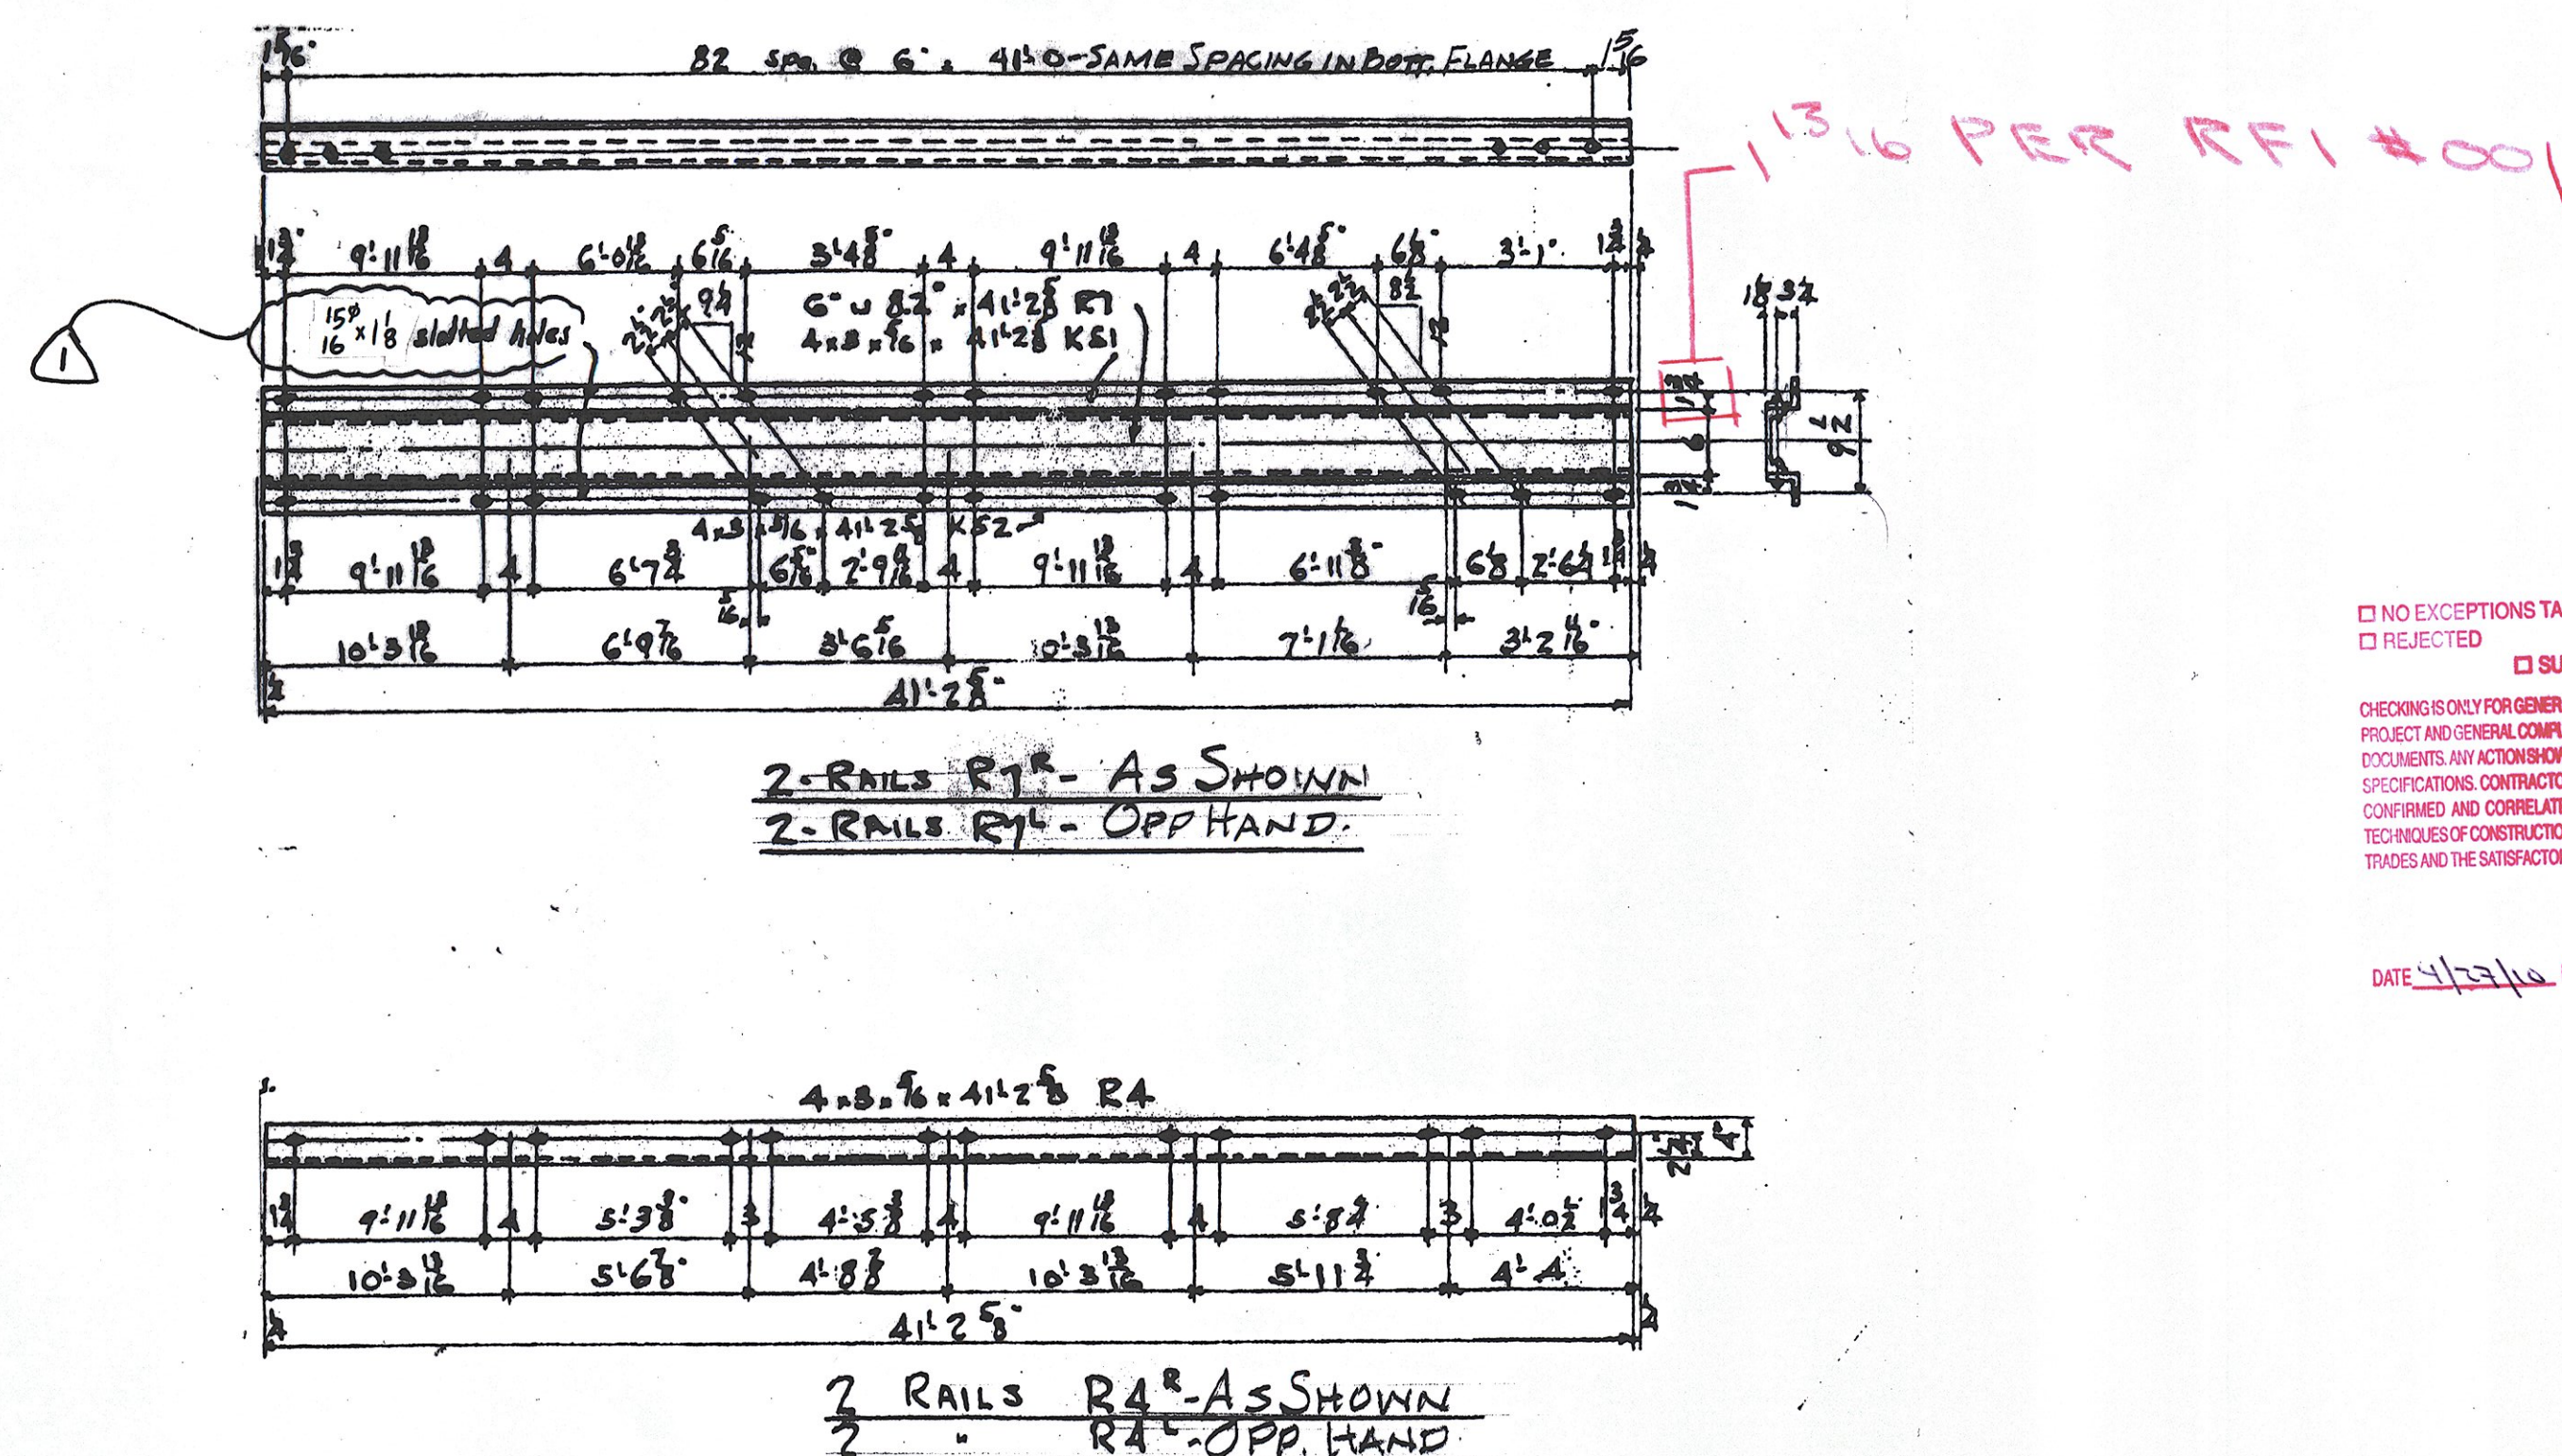

DATE 4/29/10 BY 

DATE 4/27/10 BY [Signature]

RECEIVED
CK# BY CWA OK'D BY _____
APR 22 2000
RESUBMIT _____ APPROVED As Not
BY WBS DATE 5/4/00

OUT FOR APPROVAL	1/20/10																		
OUT FOR APPROVAL	4/18/10																		
ISSUED TO SHOP																			
FIELD & OFFICE																			
2	REMOVED ITEMS SENDING S&A	4-17-10																	
1	SLOTS 1155 SOUTH	4/6/10																	
REV.	REMARKS	DATE	DWN	CHK	APP	Q.A.	NO.	DIA.	LGT	TYPE	WASHER								
PROJECT NO. BHF 6400 (31)		STATE PROJECT NO.																	
MATERIAL: A320 ASTM A320		ELECTRODES: -		HOLES: AS NOTED		SHOP BOLTS: 3/4" A325-12 GALV.													
SURFACE PREP. & PAINT:																			
BLAST CLEAN - SP10																			
CARBOLINE #859 ORGANIC ZINC PRIMER																			
3705 DET.																			
DESCRIPTION: BRIDGE RAIL												DRAWN BY		DATE					
JOB:												JFF		12-09					
TH9-TAYLOR ST. BRIDGE #5												CHKD BY							
MONTPELIER, VERMONT												CR							
												APPROV BY							
												Q.A.							
CUSTOMER: WINTERSET																			
CASCO BAY STEEL STRUCTURES, INC.												JOB NO.		DRG. NO.					
75: SPRING HILL ROAD SACO, MAINE 04072												434		54					
PHONE (207) 282-7360 FAX. (207) 282-1179												REV.		1					