


PROFILE
TAYLOR STREET

NOTE:
GRADES SHOWN TO NEAREST TENTH REPRESENT EXISTING GROUND ELEVATIONS ALONG CENTERLINE.
GRADES SHOWN TO NEAREST HUNDREDTH REPRESENT FINISHED GRADE ELEVATIONS ALONG CENTERLINE.
* GRADES BASED ON RESIDUAL CAMBER AFTER ALL DEAD LOADS APPLIED

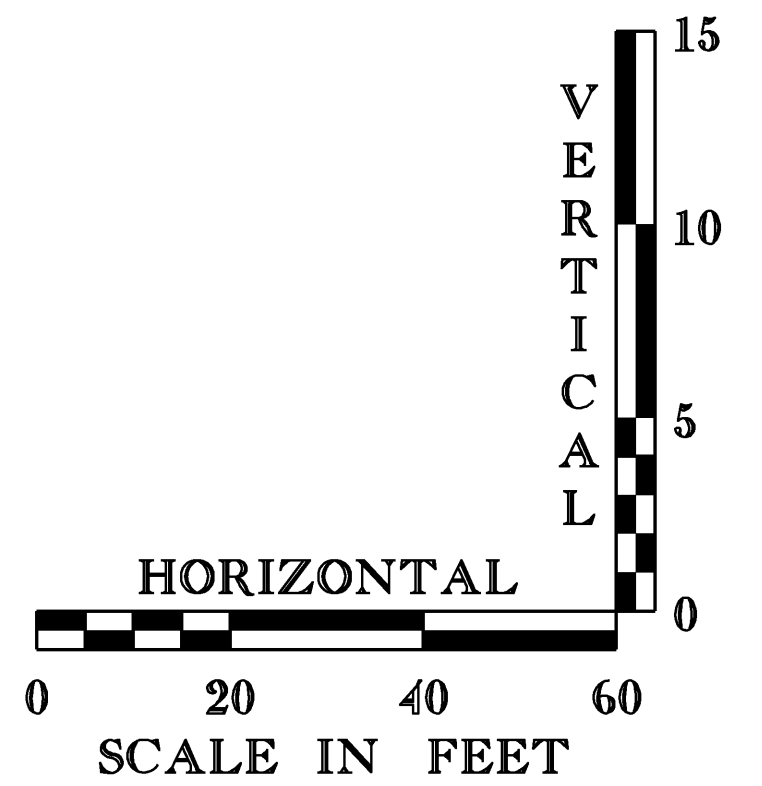

PROFILE

PROJECT NAME: MONTPELIER	FILE NAME: \$FILES\$	PLOT DATE: 10/12/2009
PROJECT NUMBER: BHF 6400(31)	PROJECT MANAGER: SUSAN SCRIBNER	DRAWN BY: D. D'AMATO
	DESIGNED BY: D. D'AMATO	CHECKED BY: P. PERKINS
	BRIDGE DESIGN SUPERVISOR: P. HALSTEAD	SHEET 14 OF 63



FILE NAME: I:\14596\mtn\p\lens\14596.prc.dgn
DATE/TIME: 10/12/2009
USER: 2552