


LEGEND	
	AREA OF SEED
	AREA OF SEED & EROSION MATTING
	AREA OF STONE FILL, TYPE II (SEE NOTE 3)
	SOIL MAP UNIT TYPE (SEE SHT. 18 FOR DETAIL)
	SOIL MAP UNIT BOUNDARY
	RIPARIAN BUFFER

NOTES:

- SEE CROSS SECTIONS FOR FINAL SLOPE GRADING INFORMATION.
- UPON COMPLETION OF CONSTRUCTION, THE CONTRACTOR SHALL REMOVE THE STABILIZED CONSTRUCTION ENTRANCE AND ANY MATERIAL PLACED ON THE EXISTING BANK FOR THE TEMPORARY CONSTRUCTION ACCESS. RIVER BANKS SHALL BE RESTORED TO ORIGINAL GRADE PRIOR TO IMPLEMENTATION OF PERMANENT EROSION CONTROLS AS DESCRIBED IN THE EPSC PLANS AND NOTES.
- STONE FILL, TYPE II SHALL ONLY BE PLACED BELOW THE BRIDGE SUPERSTRUCTURE AND 2 FEET TO EITHER SIDE OF THE SUPERSTRUCTURE IN AREAS THAT WERE DISTURBED BY EXCAVATION OR GRADING OF THE EXISTING RIVER BANK MATERIAL AS DIRECTED BY THE ON-SITE PLAN COORDINATOR. UNDER NO CIRCUMSTANCES SHALL THE PLACEMENT OF STONE FILL CREATE MORE AREA OF DISTURBANCE OF THE EXISTING BANK THAN THAT WHICH RESULTED FROM OTHER CONSTRUCTION ACTIVITIES.
- SILT FENCE AND TURBIDITY CURTAIN SHALL REMAIN IN PLACE UNTIL FINAL SLOPES HAVE BEEN STABILIZED.

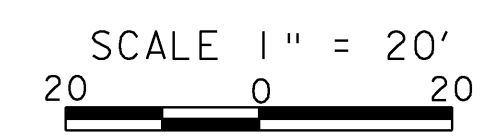

EPSC FINAL CONDITIONS SITE PLAN		
PROJECT NAME:	MONTPELIER	
PROJECT NUMBER:	BHF 6400(31)	
FILE NAME: \$FILES\$	DESIGNED BY: D. D'AMATO	PLOT DATE: 10/12/2009
PROJECT MANAGER: SUSAN SCRIBNER	BRIDGE DESIGN SUPERVISOR: P. HALSTEAD	DRAWN BY: D. D'AMATO
CHECKED BY: P. PERKINS		SHEET 24 OF 63

FILE NAME: h:\14596\mtn\p\lona\14596_esp03.dgn
 DATE/TIME: 10/12/2009 11:25:52
 USER: pperkins