


**ELEVATION**

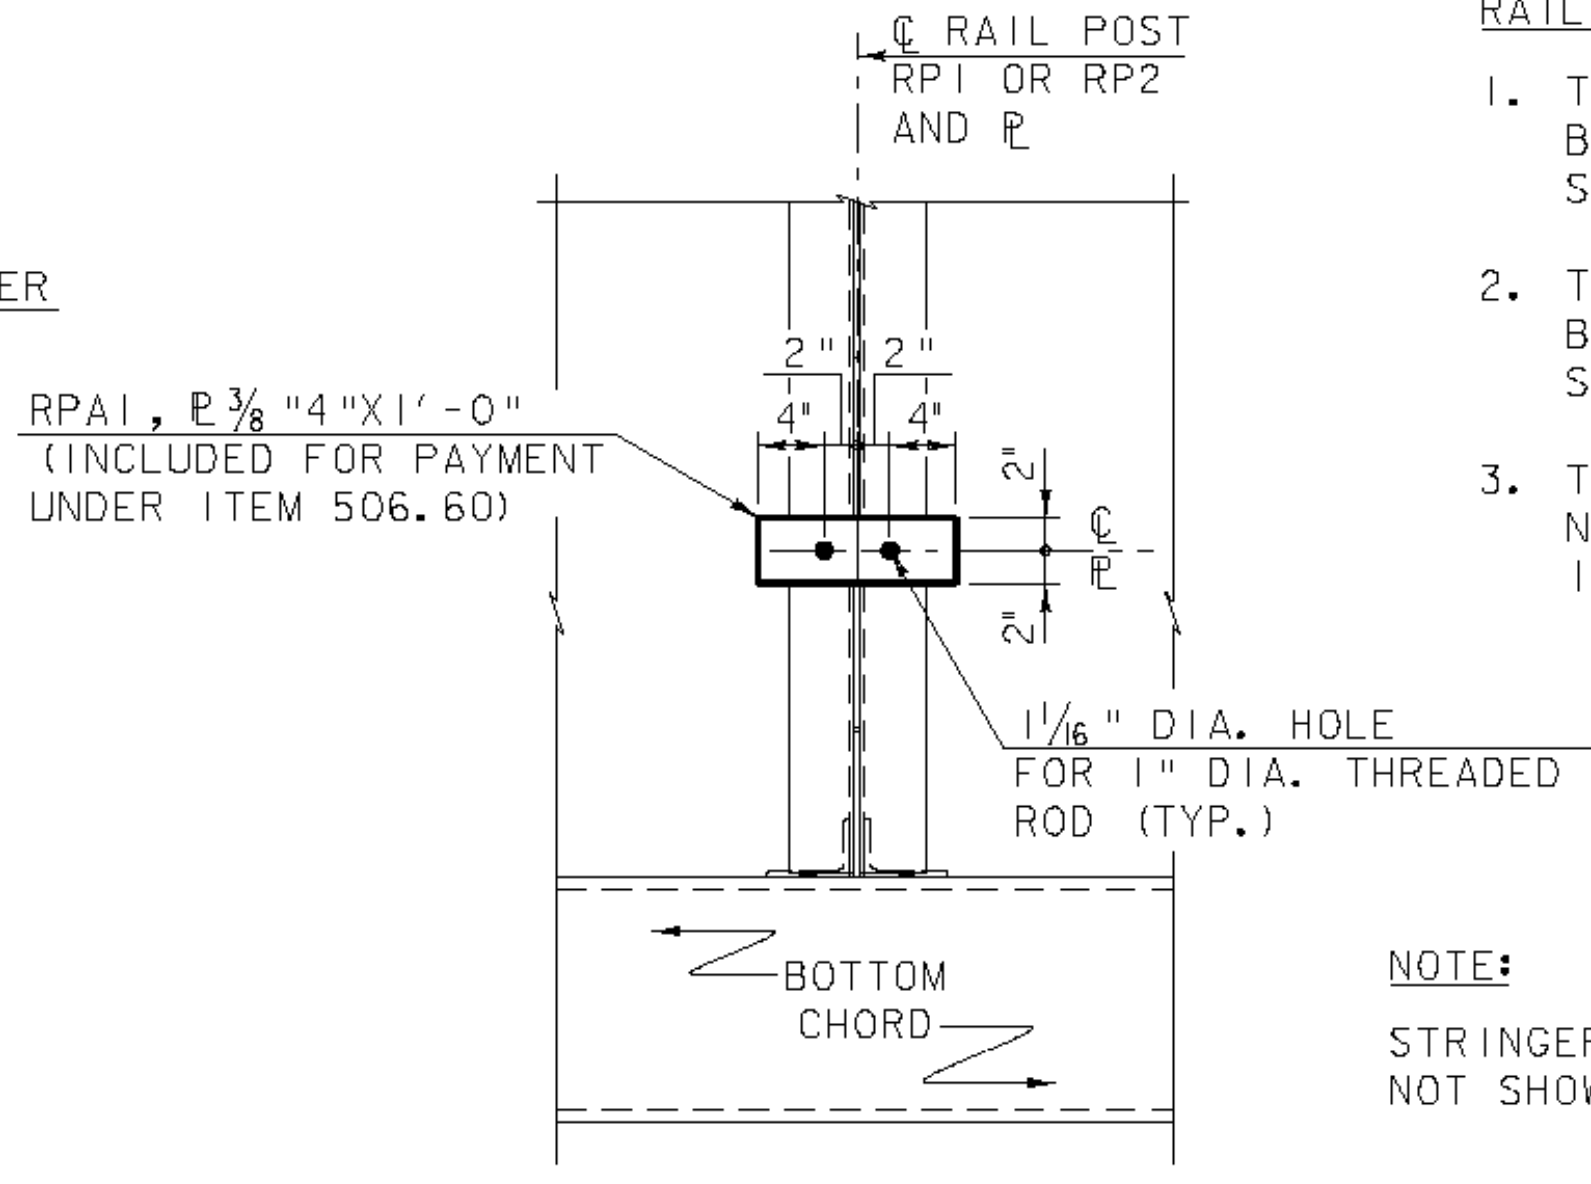

**SECTION A-A**

**RAIL POST ANCHORAGE NOTES:**

1. THREADED ROD, HEAVY HEX NUTS AND WASHERS SHALL BE IN ACCORDANCE WITH STANDARD SPECIFICATION SUBSECTION 714.07.
2. THREADED ROD, HEAVY HEX NUTS AND WASHERS SHALL BE GALVANIZED IN ACCORDANCE WITH STANDARD SPECIFICATION SUBSECTION 506.15.
3. THREADED ROD, HEAVY HEX NUTS AND WASHERS SHALL NOT BE PAID FOR DIRECTLY BUT ARE CONSIDERED INCIDENTAL TO ITEM 506.60.

**NOTE:**  
STRINGER, DECK AND CURB NOT SHOWN FOR CLARITY


**RAIL POST ANCHORAGE**  
(TYPICAL ALL RPI AND RP2 LOCATIONS)  
SCALE: 1" = 1'-0"

**ADDITIONAL REPAIR REQUIREMENTS (EAST TRUSS):**  
RAIL POST ANCHORAGE - MEMBER RPA1: INSTALL NEW ANCHORAGE 8-3/8"X4"X1'-0"

**ADDITIONAL REPAIR REQUIREMENTS (WEST TRUSS):**  
RAIL POST ANCHORAGE - MEMBER RPA1: INSTALL NEW ANCHORAGE 8-3/8"X4"X1'-0"

**STRUCTURAL STEEL DETAILS (6)**

PROJECT NAME: MONTPELIER	FILE NAME: #FILES#	PLOT DATE: 7/8/2010
PROJECT NUMBER: BHF 6400(31)	PROJECT MANAGER: SUSAN SCRIBNER	DRAWN BY: D. D'AMATO
	DESIGNED BY: D. D'AMATO	CHECKED BY: P. PERKINS
	BRIDGE DESIGN SUPERVISOR: P. HALSTEAD	SHEET 31D OF 63

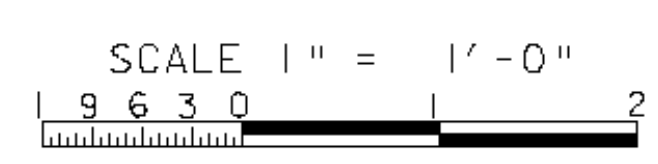

FILE NAME: K:\14506\Montpelier\p1\14506\_additional\_steel\_4.dgn  
 DATE/TIME: 7/8/2010 10:26:52  
 USER: PPERKINS