


21+25

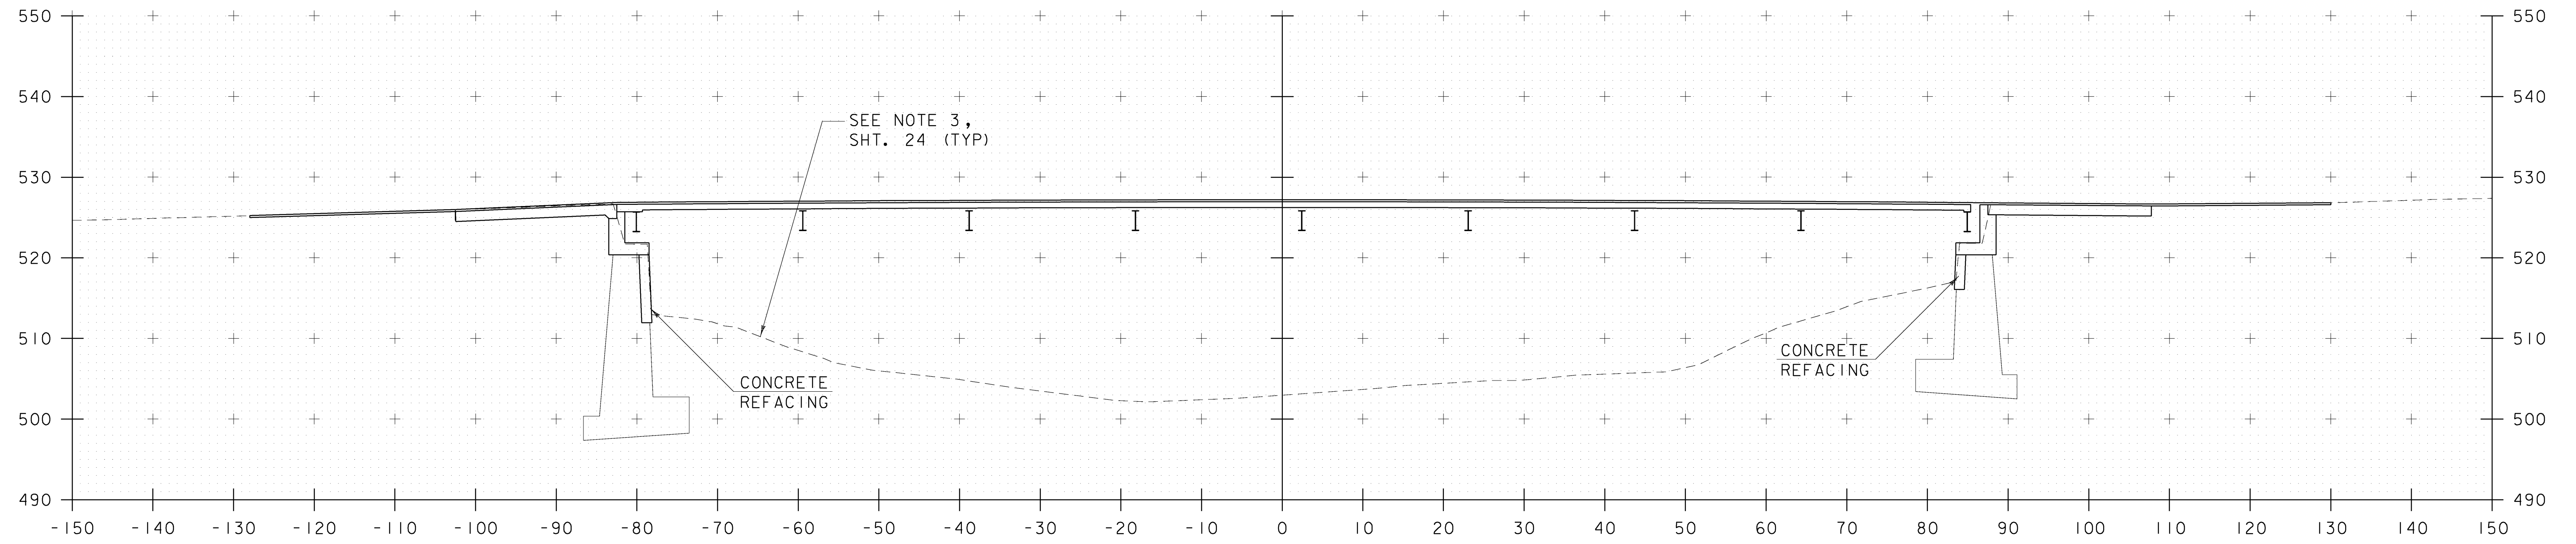

21+00

CHANNEL CROSS SECTIONS (2)

PROJECT NAME: MONTPELIER
 PROJECT NUMBER: BHF 6400(31)

FILE NAME: \$FILES\$
 PROJECT MANAGER: SUSAN SCRIBNER
 DESIGNED BY: D. D'AMATO
 BRIDGE DESIGN SUPERVISOR: P. HALSTEAD

PLOT DATE: 10/12/2009
 DRAWN BY: D. D'AMATO
 CHECKED BY: P. PERKINS
 SHEET 50 OF 63

