


LEGEND

- EXISTING MEMBER TO BE REPLACED UNDER ITEM 506.50, STRUCTURAL STEEL, ROLLED BEAM
- - - EXISTING MEMBER TO BE REPLACED UNDER ITEM 506.60, STRUCTURAL STEEL
- EXISTING MEMBER TO REMAIN (CLEAN TO BARE METAL UNDER ITEM 513.41, SURFACE PREPARATION, FIELD AND REPAINT UNDER ITEM 513.30, STRUCTURAL PAINTING, FIELD APPLIED)

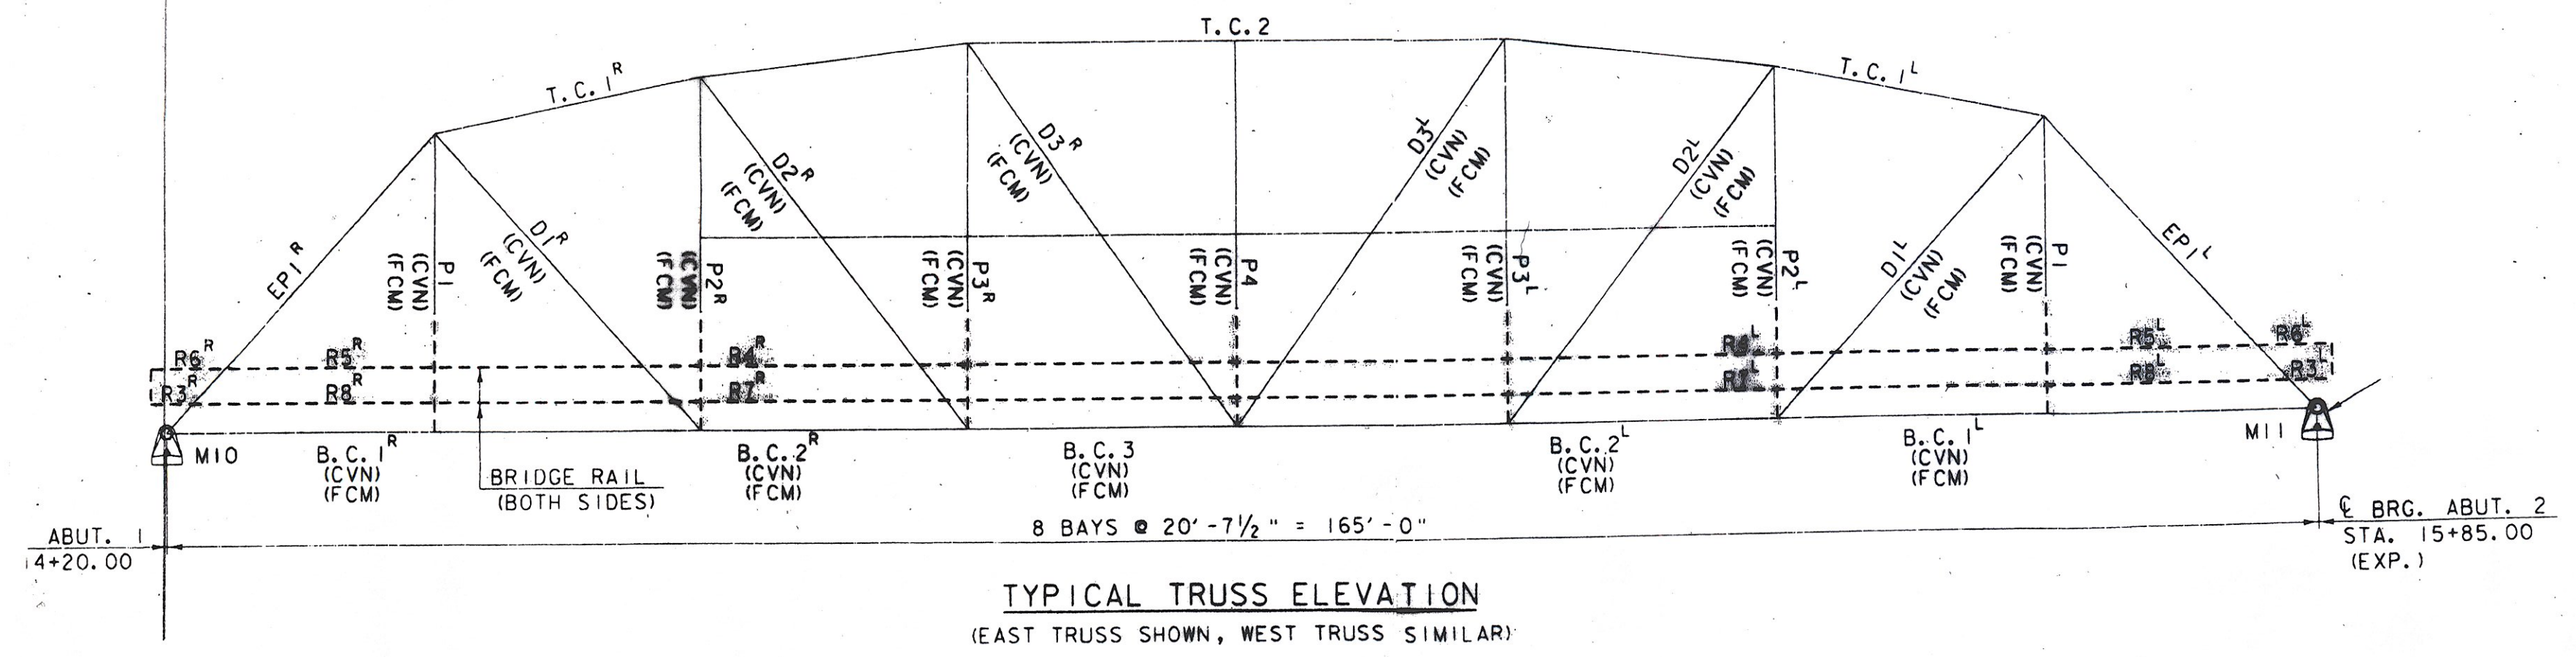

OUT FOR APPROVAL	1/2%										
OUT FOR APPROVAL											
ISSUED TO SHOP											
FIELD & OFFICE											
REV.	REMARKS	DATE	DWN	CHK	APP	Q.A.	NO.	DIA.	LGT	TYPE	WASHER
	PROJECT NO. BHF-6400 (3)										
	STATE PROJECT NO. BRIDGE NO. 5										
	MATERIAL: A270										
	ELECTRODES: —										
	HOLES: AS NOTED										
	SHOP BOLTS:										
	SURFACE PREP. & PAINT:										
	DESCRIPTION: FRAMING PLAN										
	DRAWN BY										
	DATE										
	JPF										
	12-09										
	TH9-TAYLOR ST.-BRIDGE NO. 5										
	CHKD BY										
	MONTPELIER, VERMONT.										
	APPROV BY										
	Q.A.										
	CUSTOMER: WINTER SET										
	CASCO BAY STEEL STRUCTURES, INC.										
	JOB NO.										
	DRG. NO.										
	434										
	E1										
	75 SPRING HILL ROAD										
	SACO, MAINE 04072										
	PHONE (207) 282-7360										
	FAX (207) 282-1179										
	REV.										
	△										

REVISIONS
 CHA
 JAN 27 2010
 APPROVED AS NOTED
 DATE 2/23/10
 WY B. S.