

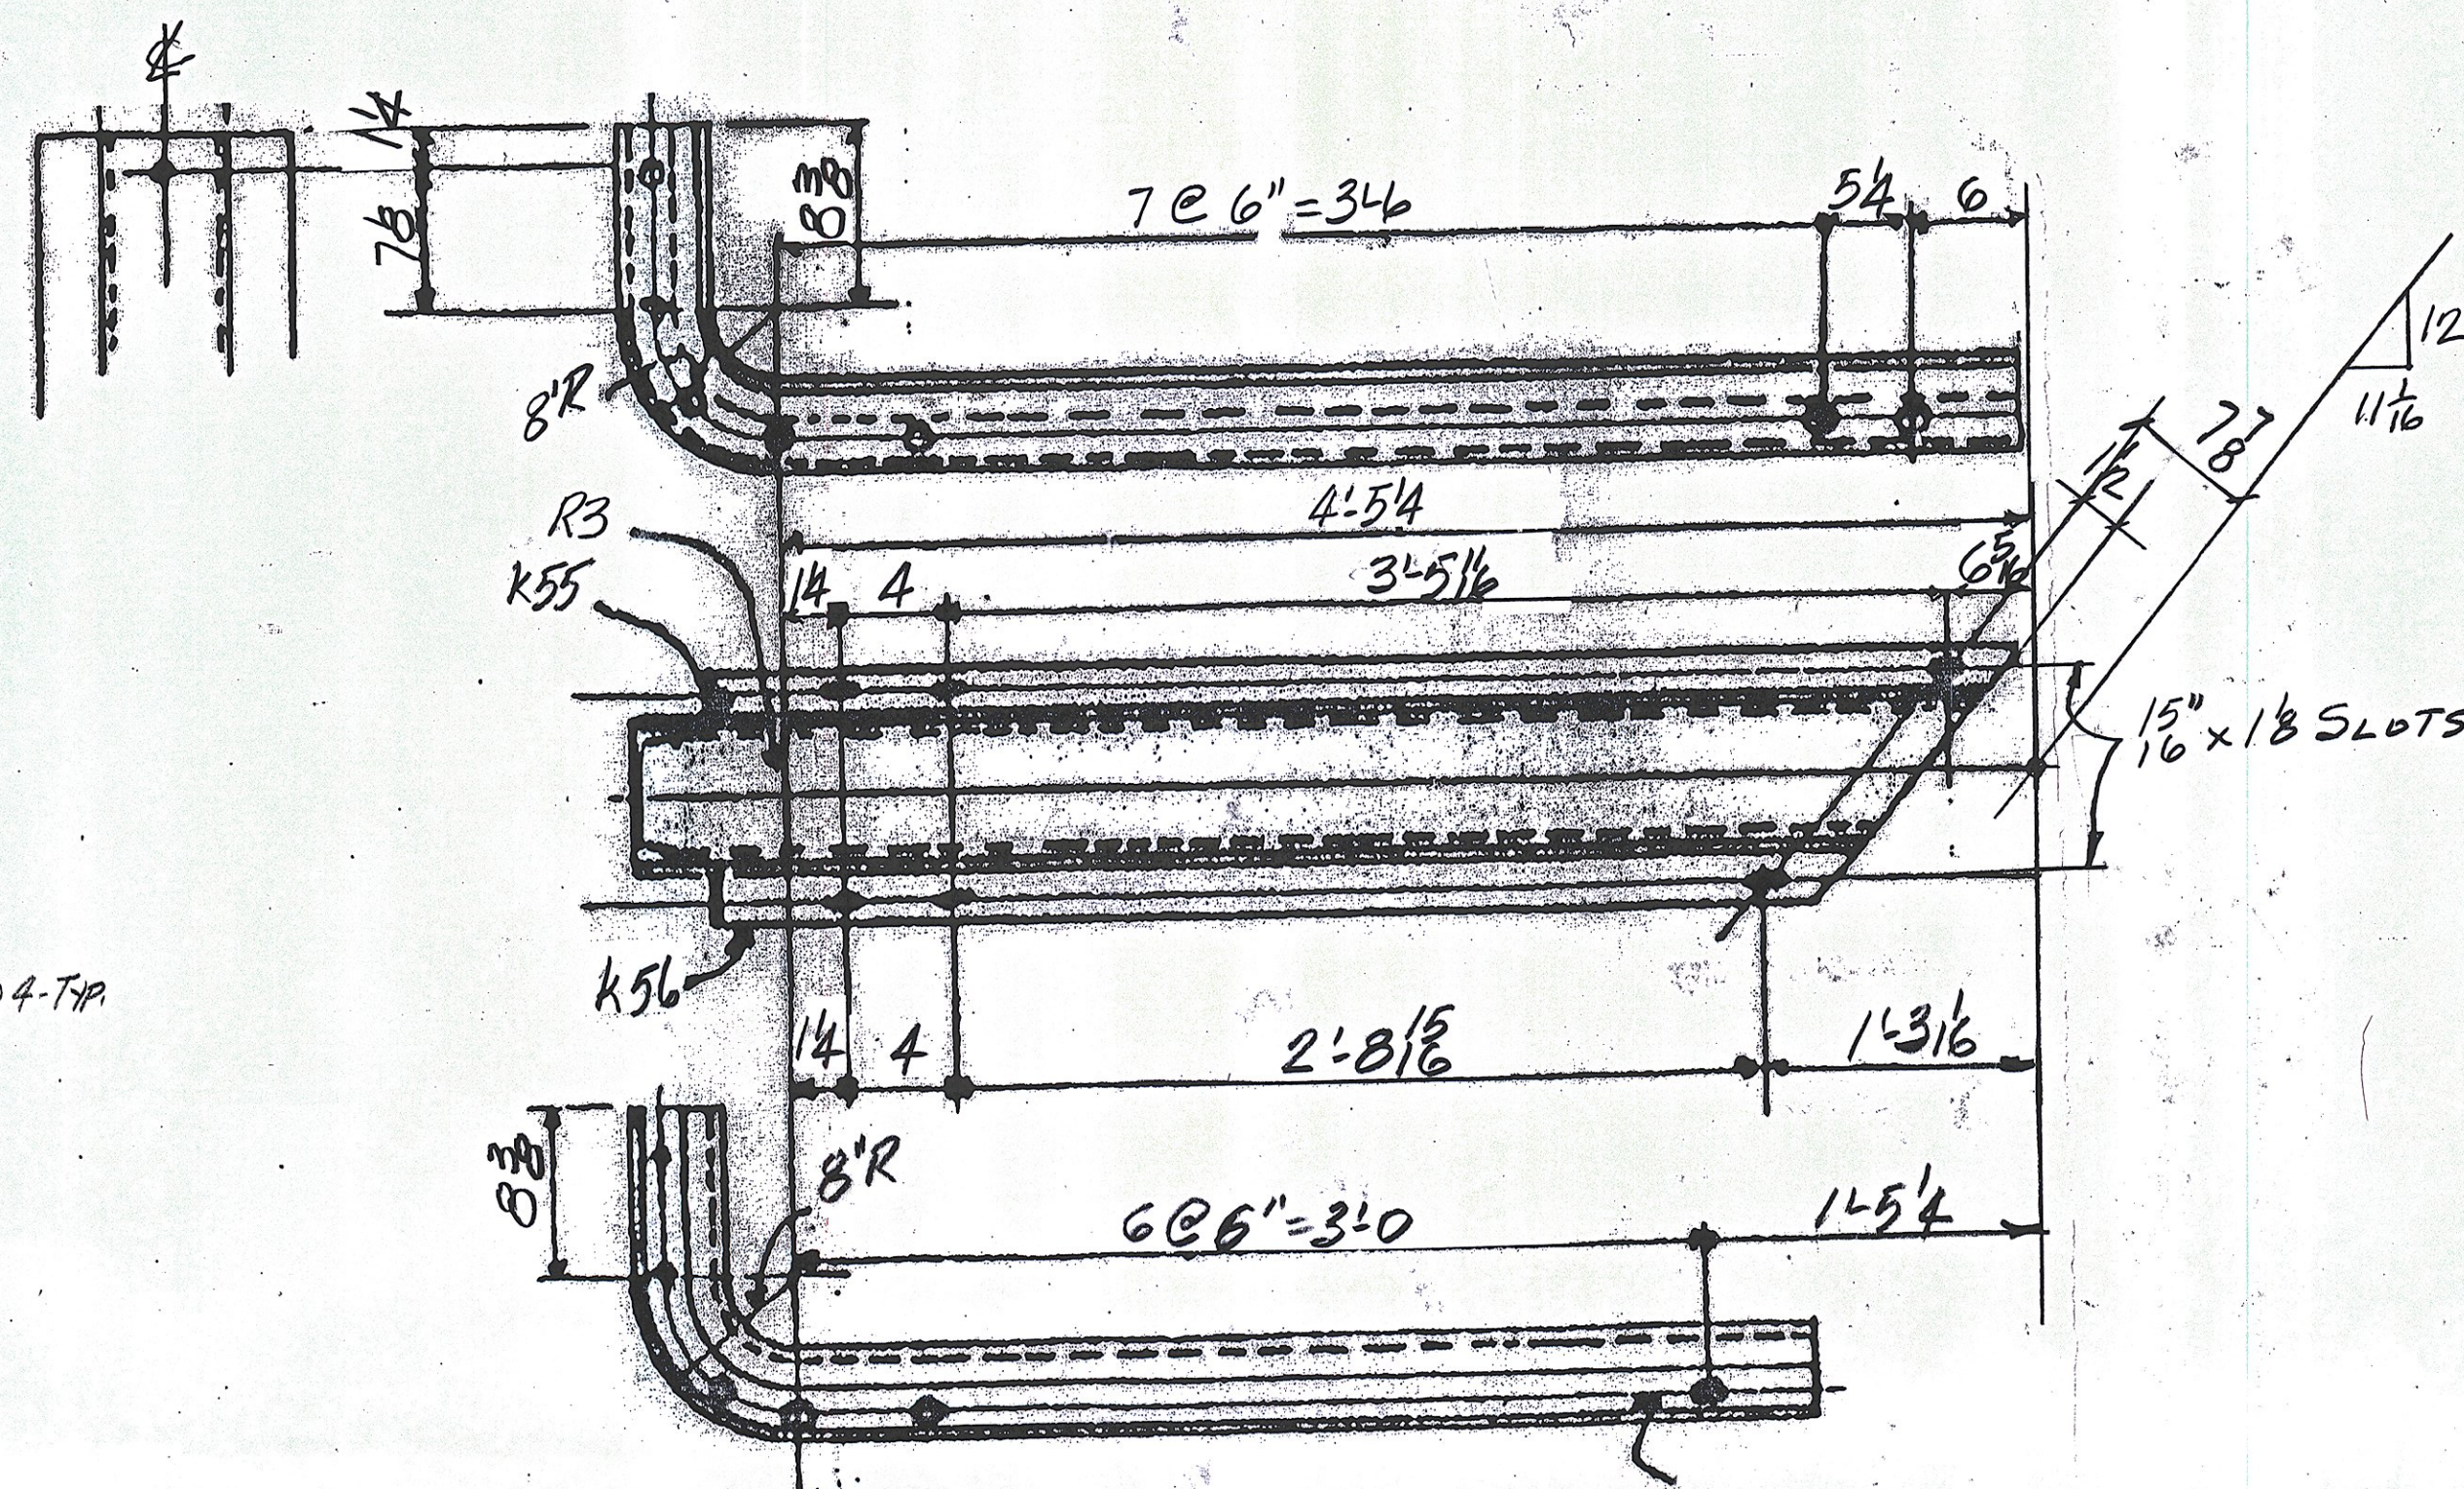
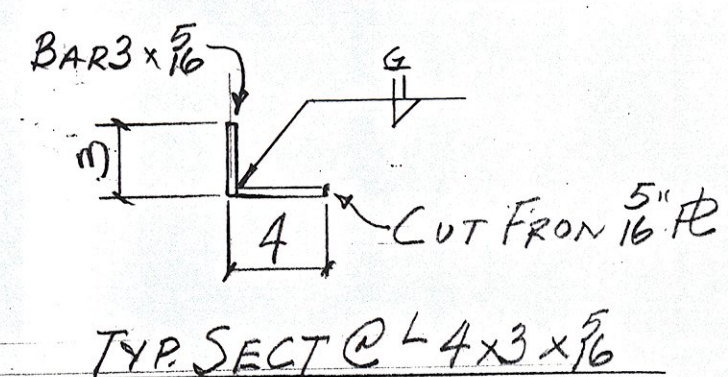
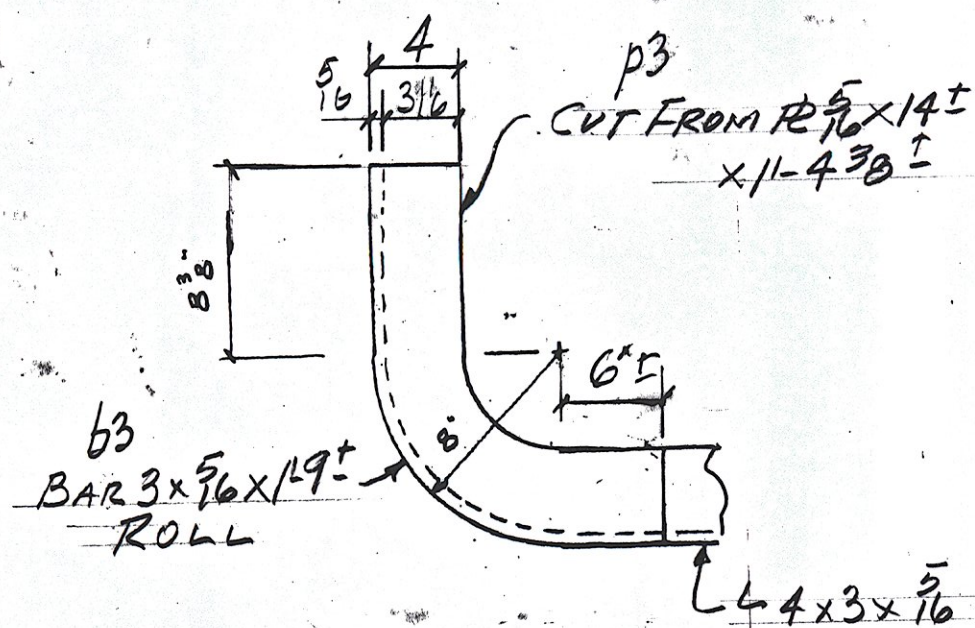
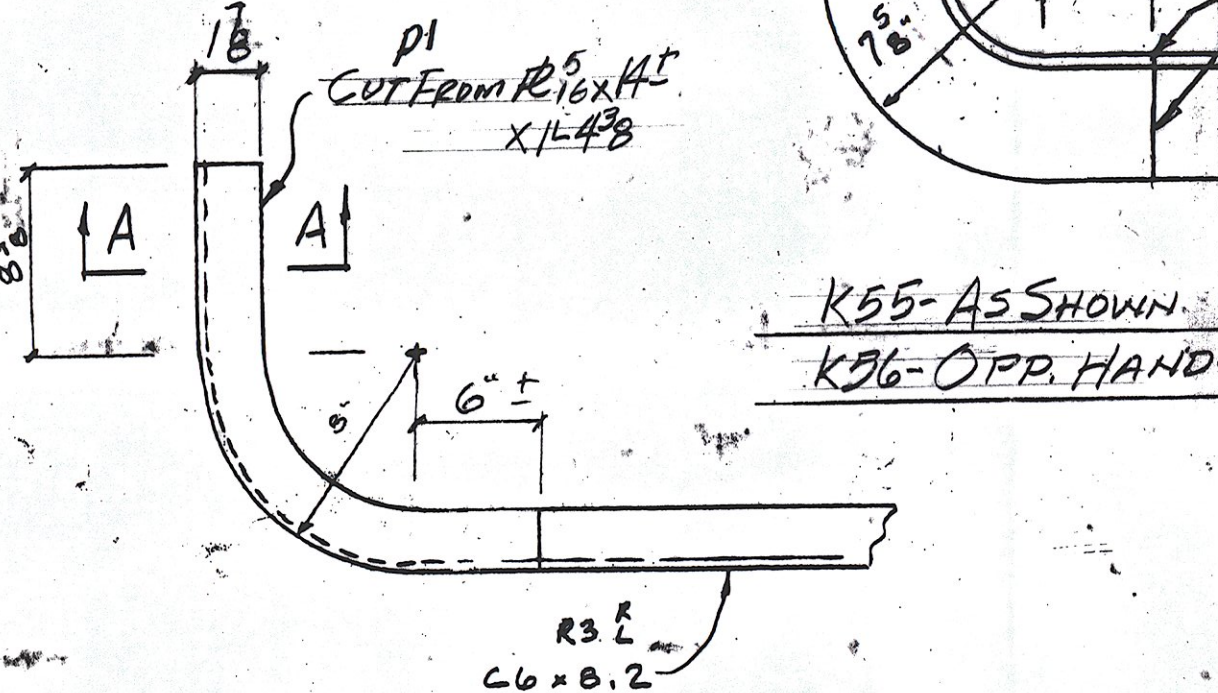


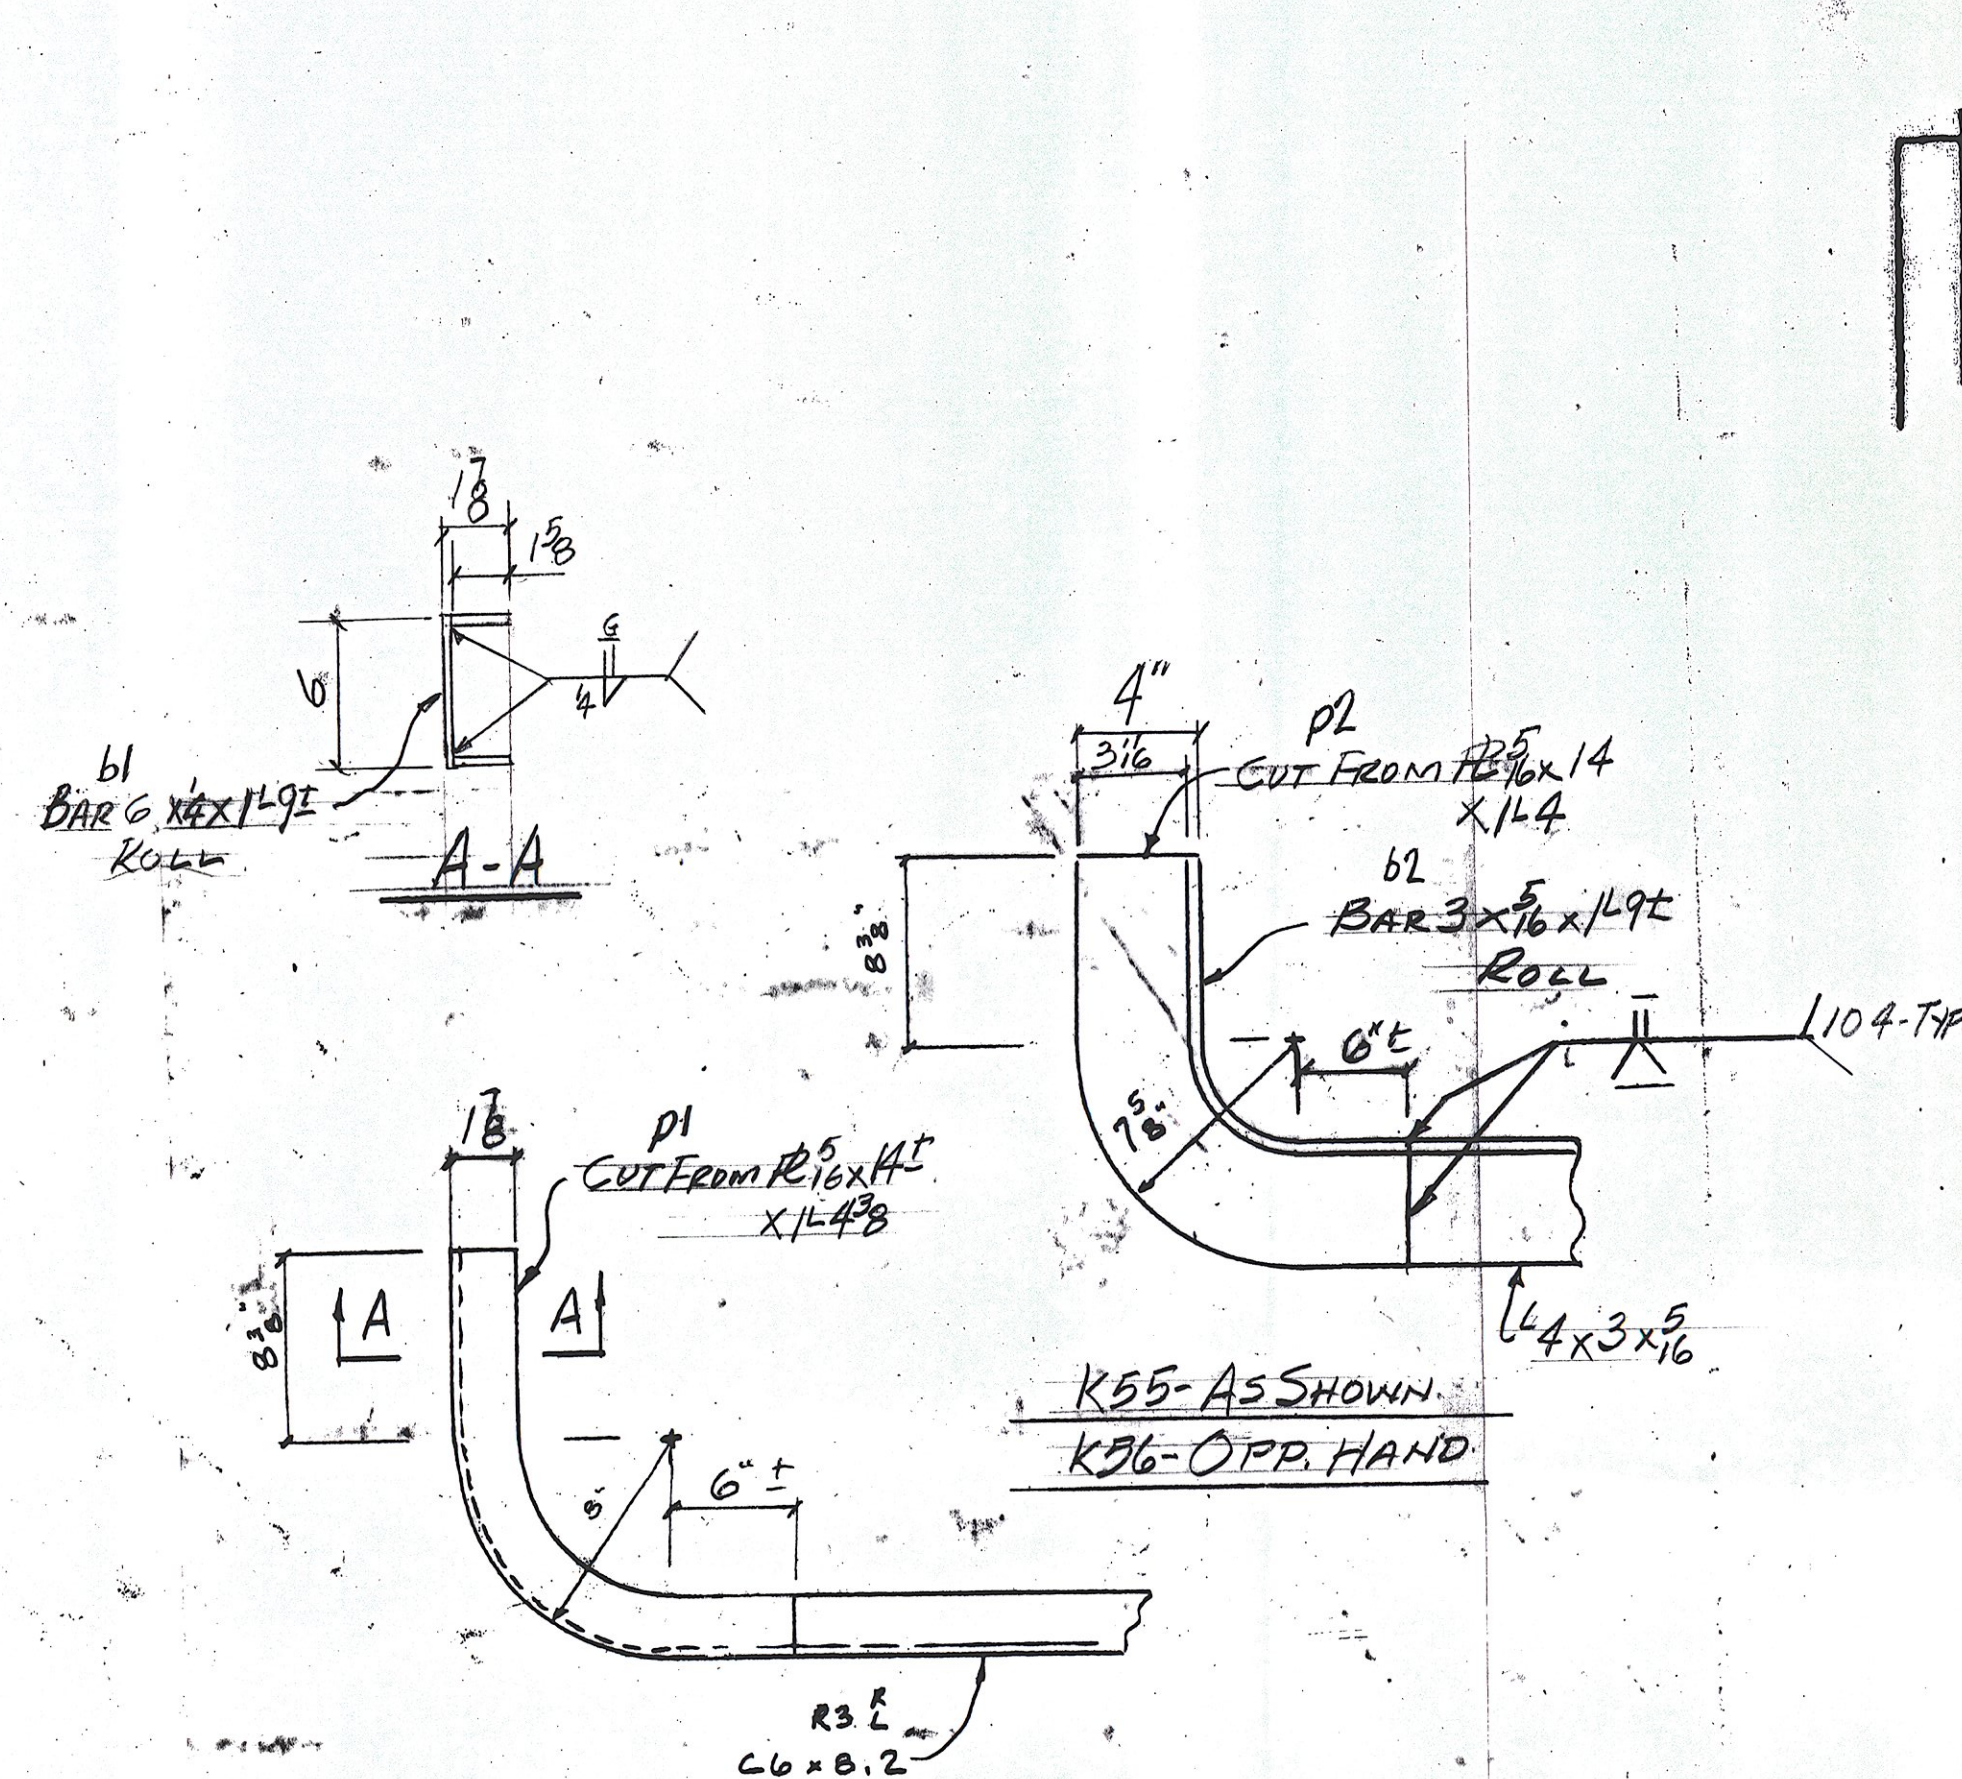

2 - RAILS R3^R AS SHOWN
2 - R3^L OPP. HAND

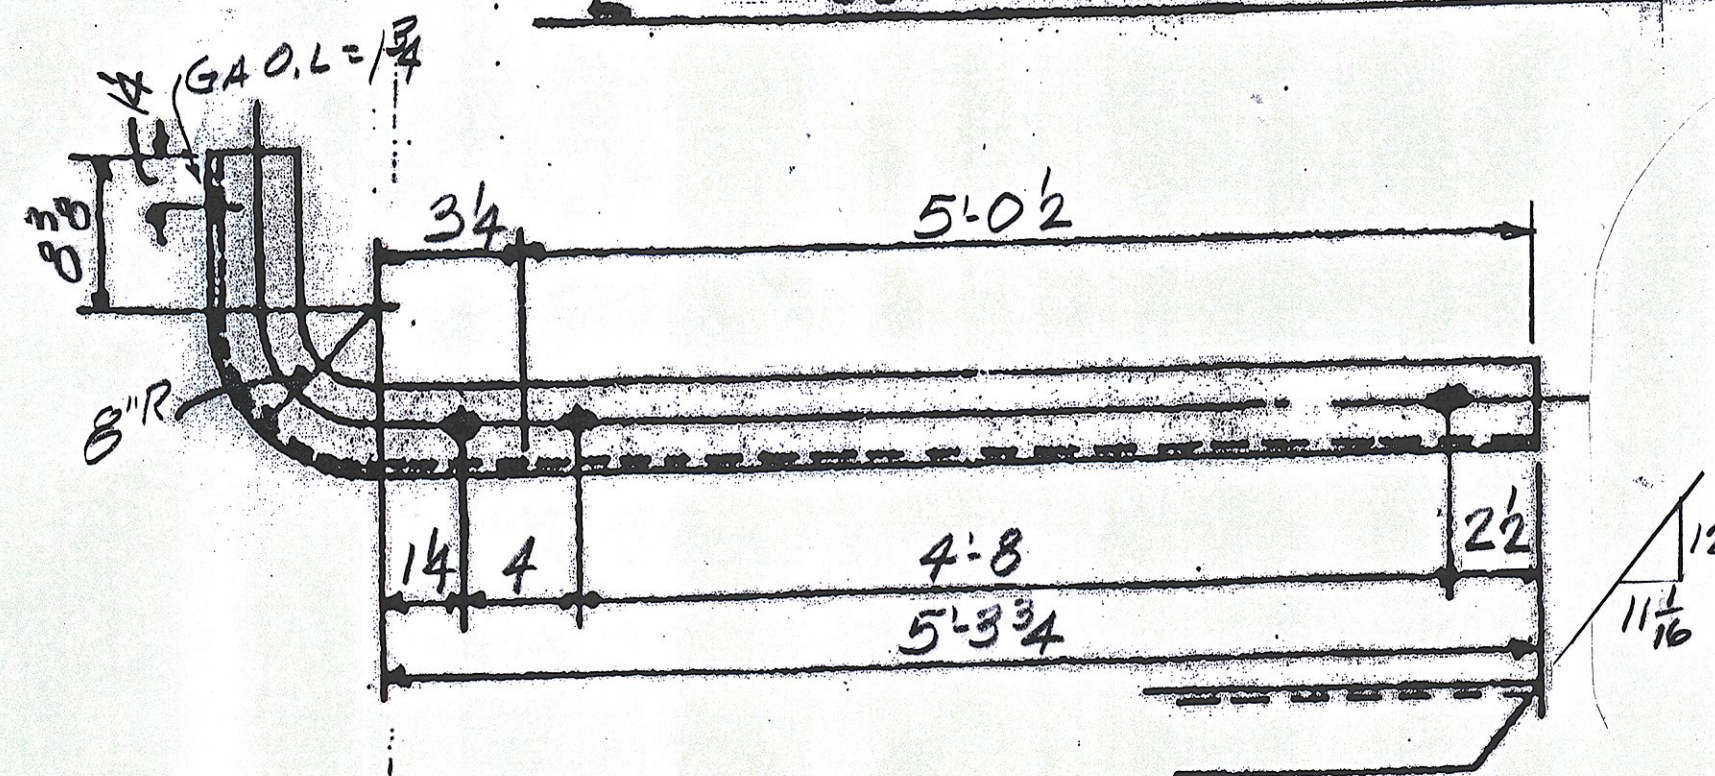

2 - RAILS R6^R AS SHOWN
2 - R6^L OPP. HAND

NO EXCEPTIONS TAKEN ☐ MAKE CORRECTIONS NOTED
☐ REJECTED ☐ REVISE & RESUBMIT
☐ SUBMIT SPECIFIED ITEM

CHECKING IS ONLY FOR GENERAL CONFORMANCE WITH THE DESIGN CONCEPT OF THE PROJECT AND GENERAL COMPLIANCE WITH THE INFORMATION GIVEN IN THE CONTRACT DOCUMENTS. ANY ACTION REQUIRED BY THE CONTRACTOR TO CORRECT DEFECTS OR TO COMPLY WITH THE REQUIREMENTS OF THE PROJECT IS THE RESPONSIBILITY OF THE CONTRACTOR. THE CONTRACTOR IS RESPONSIBLE FOR OBTAINING ALL NECESSARY PERMITS AND FOR OBTAINING ALL NECESSARY INFORMATION FROM THE PROJECT OWNER AND THE PROJECT ENGINEER. THE CONTRACTOR IS RESPONSIBLE FOR OBTAINING ALL NECESSARY INFORMATION FROM THE PROJECT OWNER AND THE PROJECT ENGINEER. THE CONTRACTOR IS RESPONSIBLE FOR OBTAINING ALL NECESSARY INFORMATION FROM THE PROJECT OWNER AND THE PROJECT ENGINEER.

DATE 4/22/10 BY [Signature]

RECEIVED
CHKD BY CHA DTD BY [Signature]
APR 22 2010

RESUBMIT APPROVED [Signature]
BY WYB J DATE 5/4/10

ABM INFO		SHOP BILL				JOB NO. 434	DRG. NO. 54A		
PAGE	LINE	NO.	DESCRIPTION	FT	IN	ASSEM. MARK	SHIPPING MARK	REMARKS	WEIGHT
		2	6x8.2	4	0±		K3R		
		2	DO	4	0±		K3L		
		4	BAR 6x4	1	9±	61			
		8	R ³ / ₁₆ x 14 ^I	1	43	P1			
		4	L4x3x ⁷ / ₈	4	0±	K55			
		4	DO	3	0±	K56			
		8	BAR 3x ⁵ / ₈	1	9±	P2			
		8	R ³ / ₁₆ x 14	1	4	P2			
		2	L4x3x ⁵ / ₈	4	10±		R6R		
		2	DO	4	10±		R6L		
		4	BAR 3x ⁵ / ₈	1	9±	P3			
		4	R ³ / ₁₆ x 14 ^I	1	43	P3			
FOR SHOP & FIELD BOLTS SEE DWG 54									
PAY ITEM 506.60									

OUT FOR APPROVAL	4/14/10																																																																																																																																																																																																																																																																																																																																																																																																																																																																																																																																																																																																																																																																																																																																																																																																																																																																																																																																																																																																																																																																																																																																																																																																																																																																																																																																																																																																																		
------------------	---------	--	--	