




DESCRIPTION: <u>EXPANSION JOINT- ABUT. 2</u>		DRAWN BY	DATE
JOB:		JPF	1-10
<u>TH9- TAYLOR ST. BRIDGE- NO. 5</u> <u>MONTPELIER, VERMONT</u>		CHKD BY	
		CR	
		APPROV BY	
CUSTOMER: <u>WINTERSET</u>		Q.A.	
CASCO BAY STEEL STRUCTURES, INC. 75 SPRING HILL ROAD SACO, MAINE 04072 PHONE (207) 282-7360 FAX. (207) 282-1179		JOB NO.	DRG. NO.
		434	J1
		REV.	△

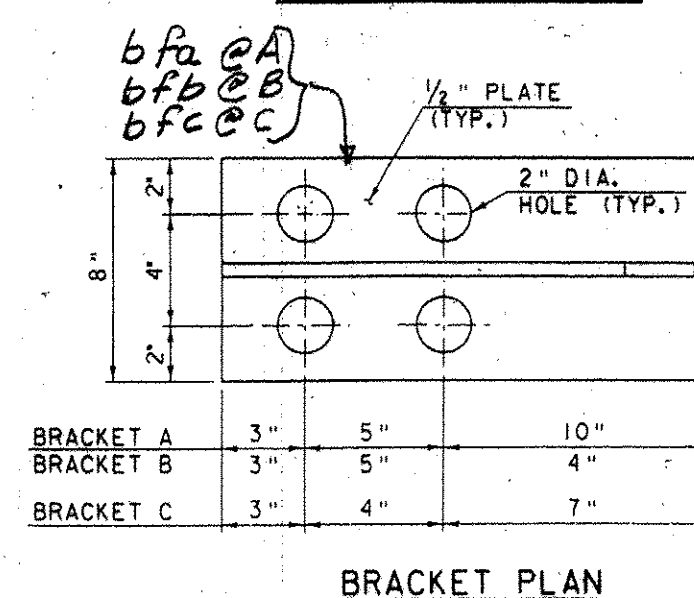