


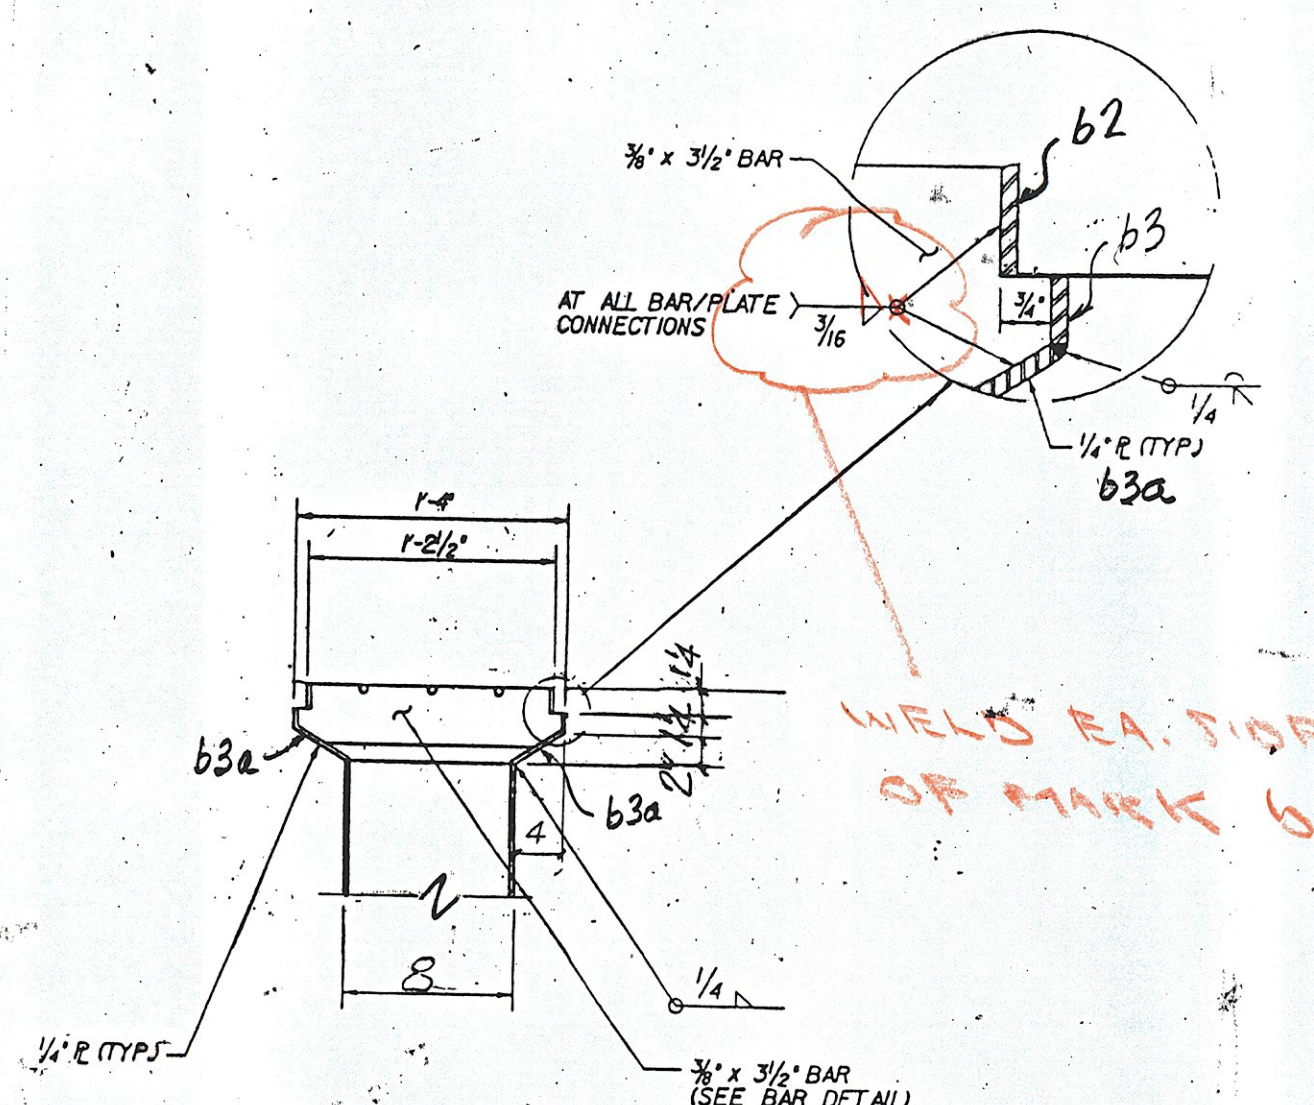


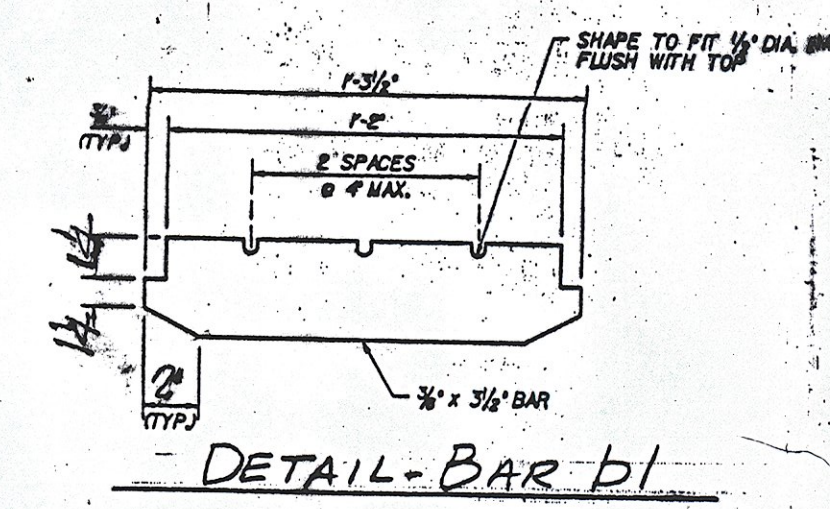

SECTION B-B

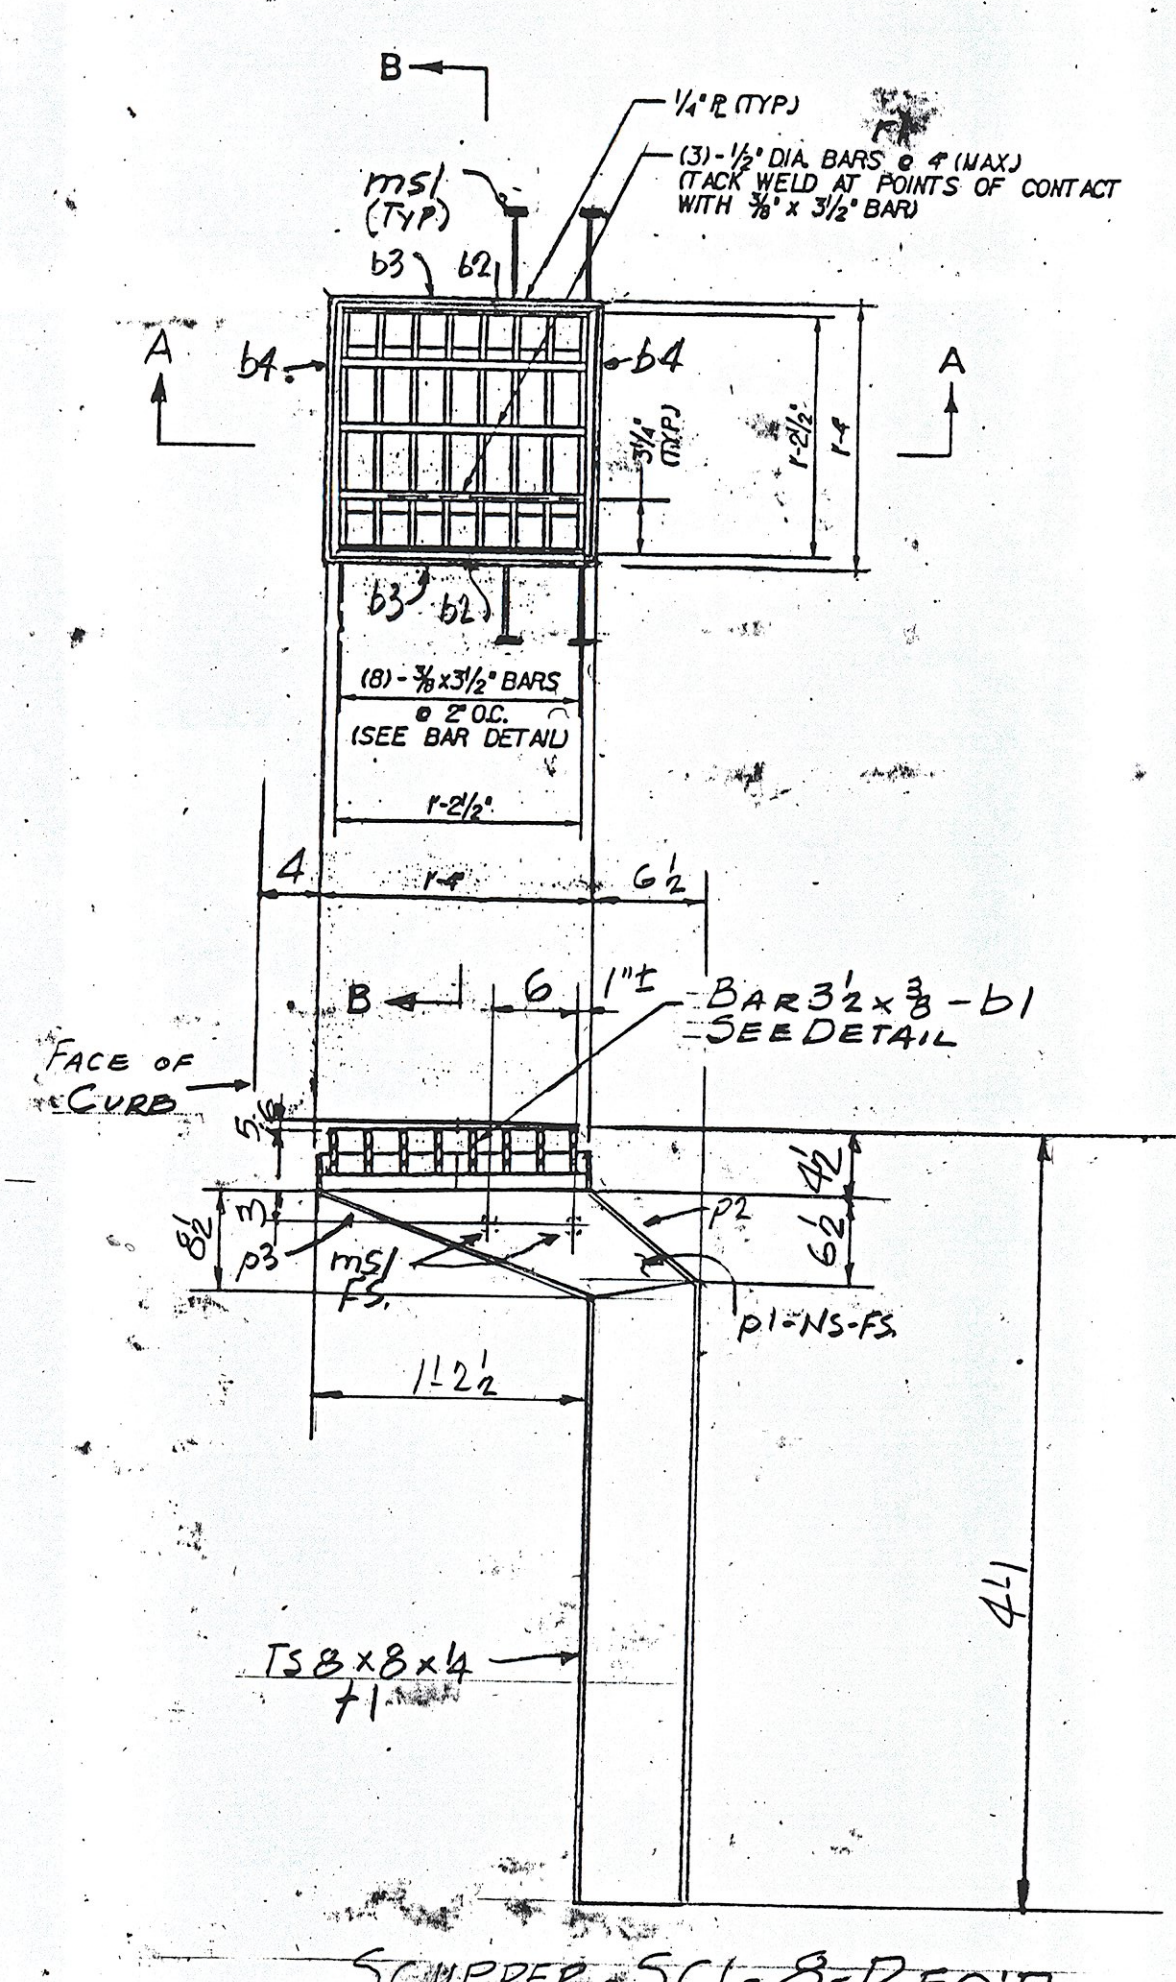


DETAIL - BAR b1

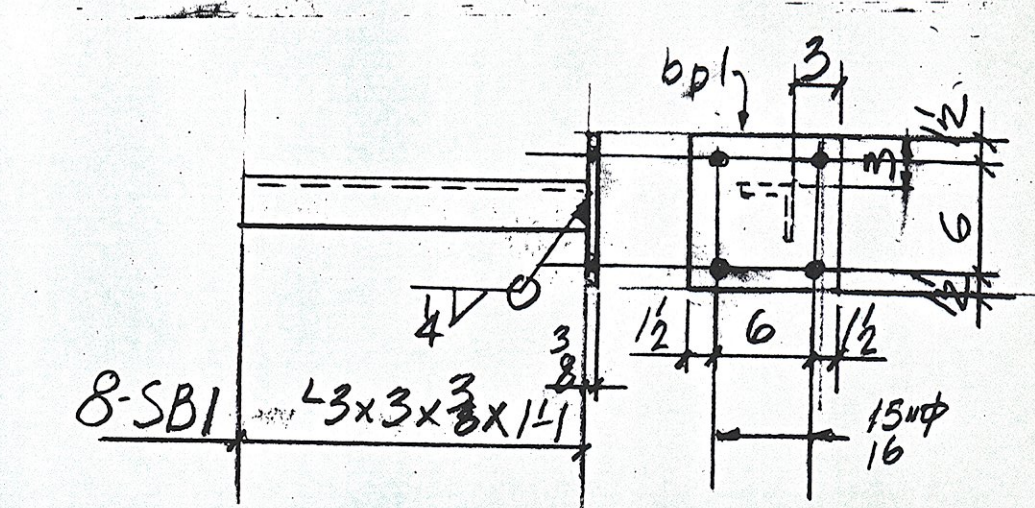


8-SBI

* INCLUDE BLOCKOUTS FOR BRIDGE RAIL POSTS RPI AND RPT (SEE PHT. 58 OF CONTRACT PLAN SET)

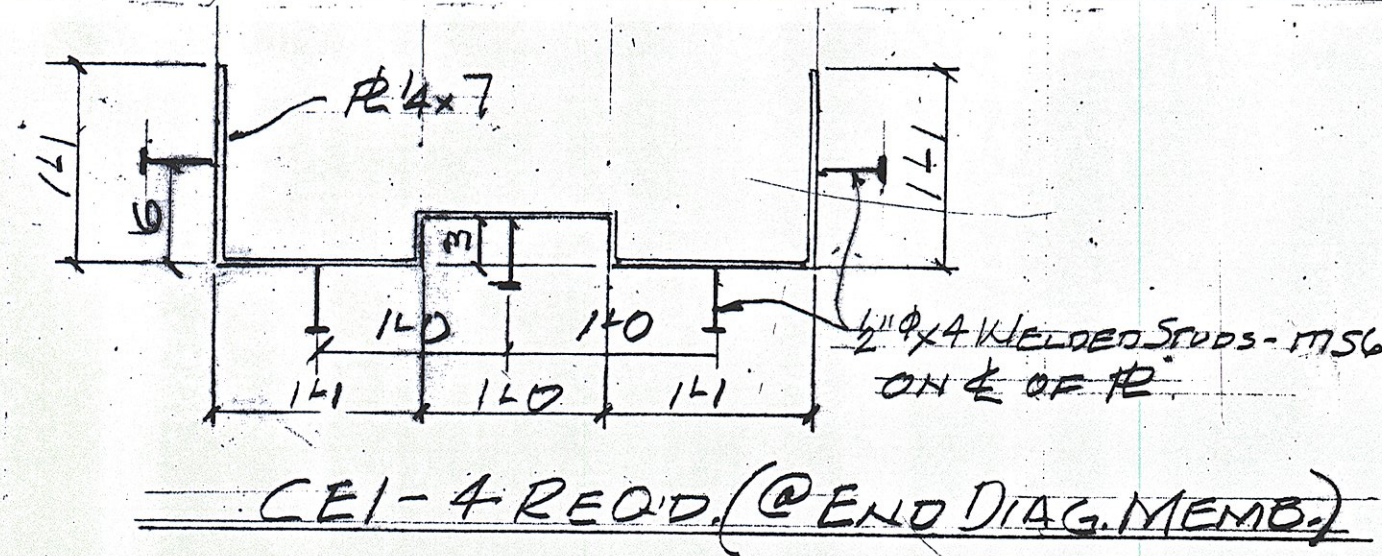


CE1-4 REQ'D (@ END DIAG. MEMB.)

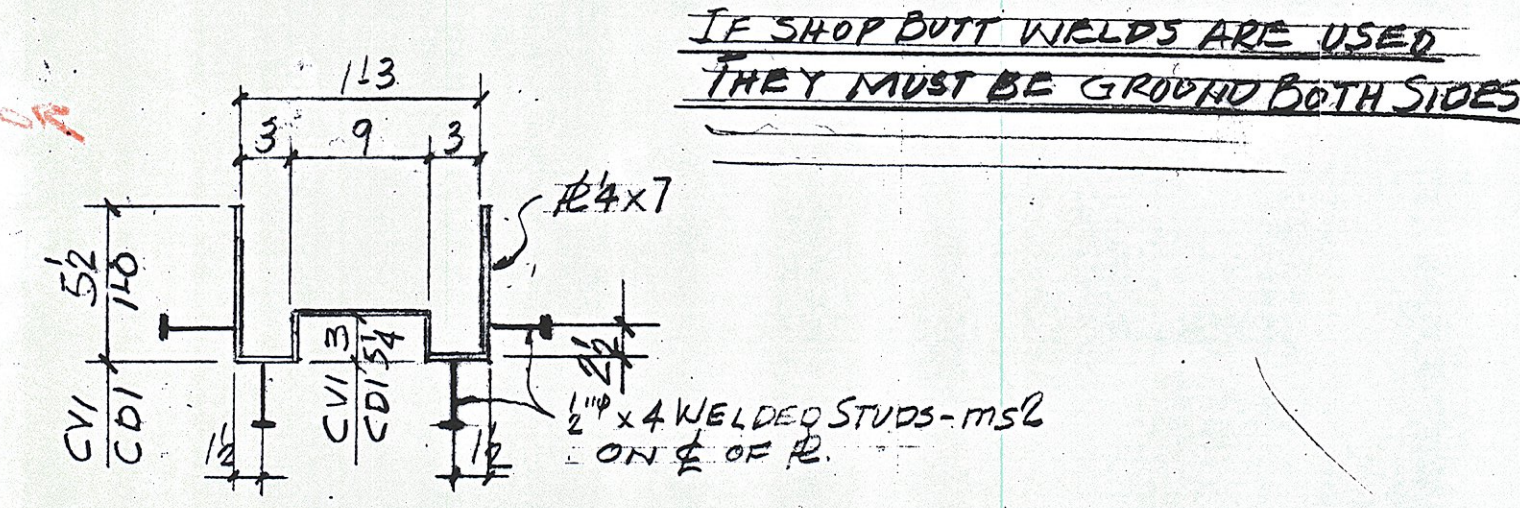

CVI-14-REQ'D (@ VERT. TRUSS MEMB.)
CDI-12-REQ'D (@ DIAG. TRUSS MEMB.)


SIDEWALK BLOCKOUT R'S.

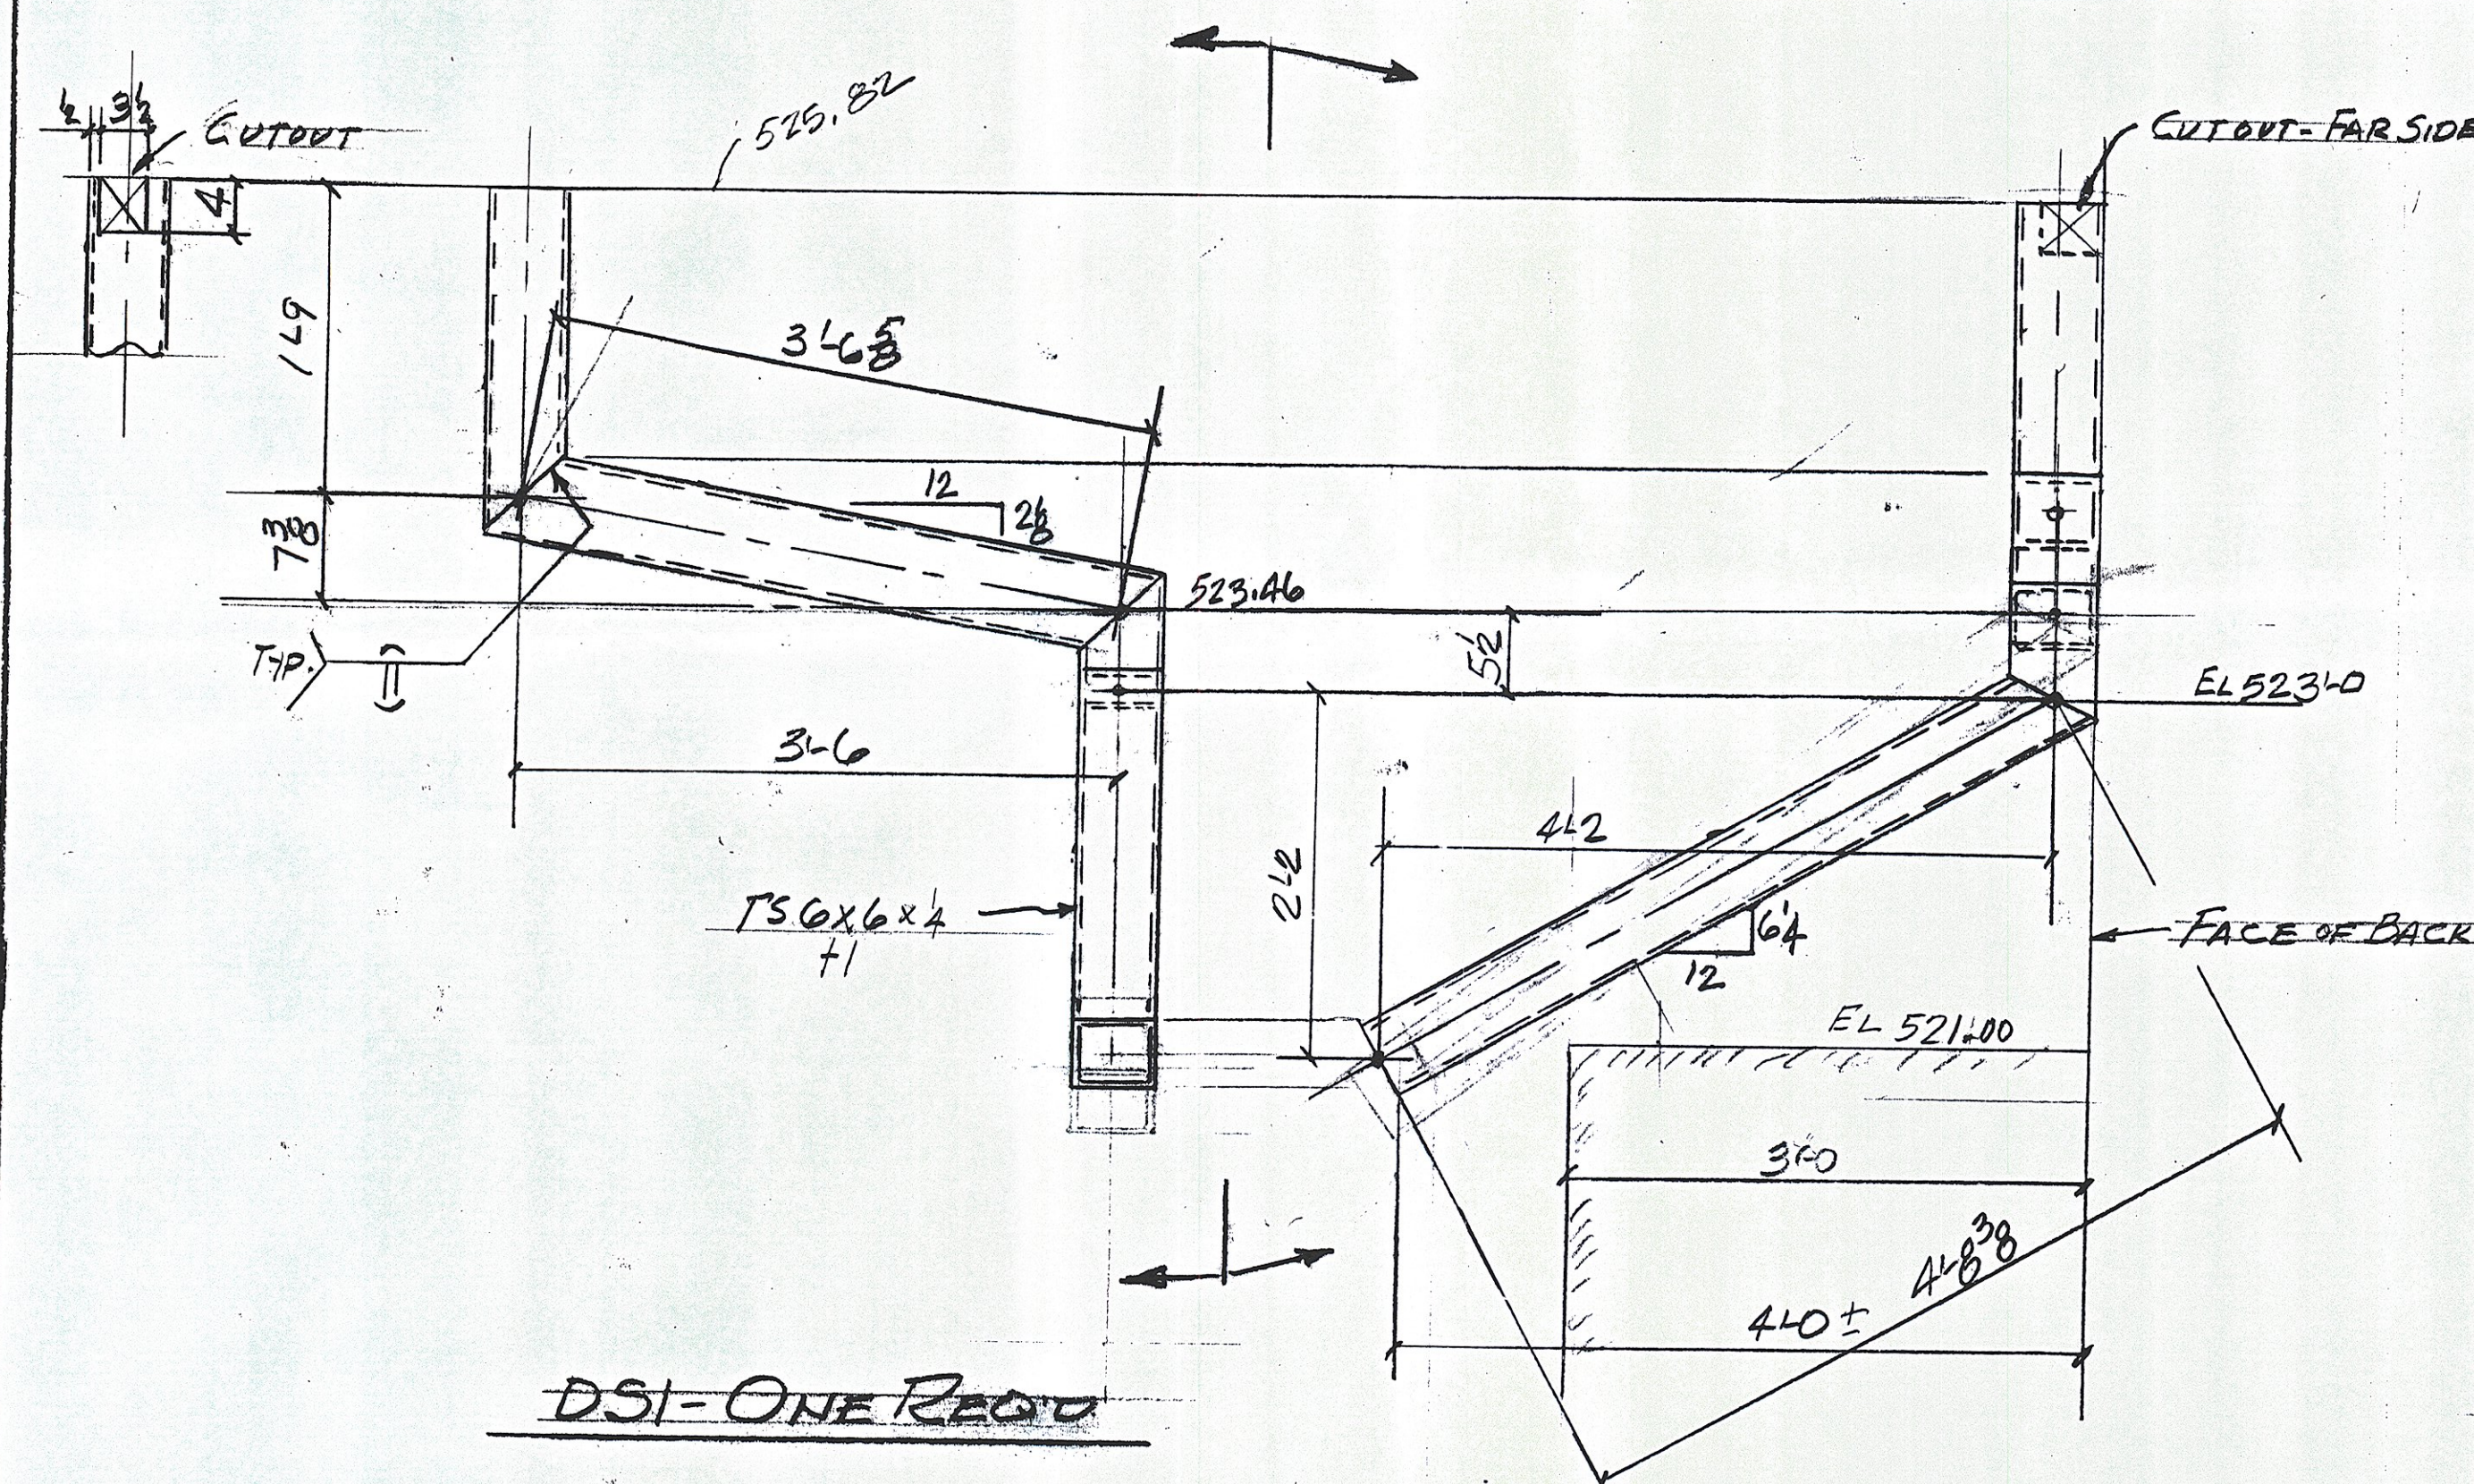


DSI-ONE REQ'D

NO EXCEPTIONS TAKEN. MAKE CORRECTIONS NOTED.
REVISIONS: 1. REVISE & RESUBMIT
2. SUBMIT SPECIFIED ITEM
CHECKING IS ONLY FOR GENERAL COMPLIANCE WITH THE DESIGN CONCEPT OF THE PROJECT AND GENERAL COMPLIANCE WITH THE INFORMATION GIVEN IN THE CONTRACT DOCUMENTS. ANY ACTION REQUIRED TO CORRECT DEFICIENCIES IN THE PLANS AND SPECIFICATIONS, CONTRACTORS ARE RESPONSIBLE FOR IDENTIFYING WHICH SHALL BE CONFIRMED AND CORRELATED AT THE JOB SITE. PROVISIONS FOR PROCESSES AND TECHNIQUES OF CONSTRUCTION COORDINATION ARE THE RESPONSIBILITY OF ALL OTHER TRADES AND THE SATISFACTORY PERFORMANCE OF HIS WORK.
DATE 3/10/10 BY [Signature]

RECEIVED
CHK'D BY CUA OK'D BY
FEB 18 2010
RESUBMIT APPROVED AS N.H.
BY [Signature] DATE 3/4/10

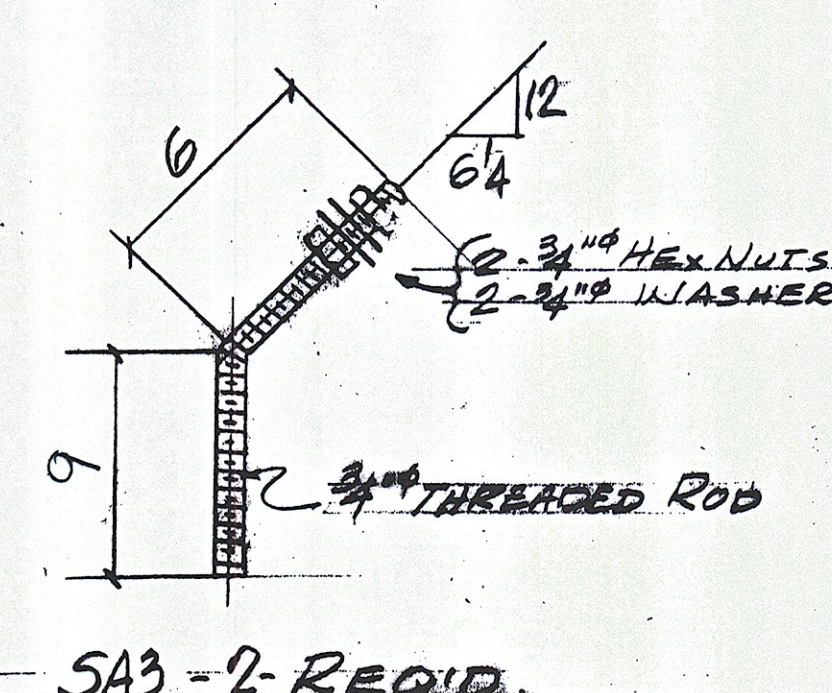

SA3-2-REQ'D

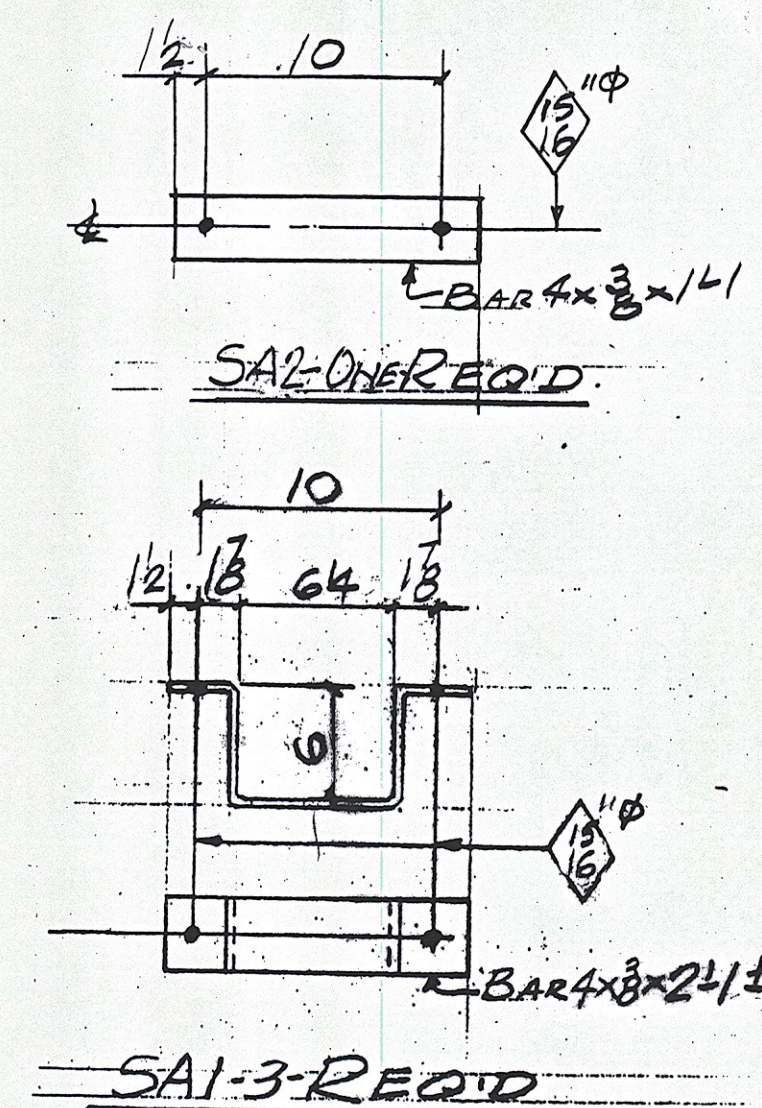

SA1-3-REQ'D

SHOP BILL										JOB NO.	DRG. NO.
										434	M1
PAGE	LINE	NO.	DESCRIPTION	FT	IN	ASSEM.	SHIPPING	MARK	REMARKS	WEIGHT	
	8		SCUPPERS	4	12				SCI		
	8		TS 8x8x4	3	2	7					
	64		BAR 3/2x3/4	1	32	b1					
	16		BAR 1/4x4	1	22	b2					
	16		DO	1	4	b3					
	16		BAR 7/8x4	1	4	b3a					
	16		BAR 3/4x4	1	32	b4					
	24		6" BAR	1	22	F1					
	16		10x4x9/16	1	102	P1					
	8		10x4x9	1	52	P2					
	8		10x4x15/16	1	43	P3					
	32		3/4" ANG STUBS	7	msl	S					
	8		1/2x3x3/4	1	1	SE1					
	8		1/2x3x9	9	bpl						
	32		1/2" A325TC BOLTS	26		FIELD			W/NEW		
	1		DOWNSPOUT	8	02	DS1					
	1		TS 6x6x4	12	02	H1					
	3		BAR 4x3/4	2	12	SA1			BEND		
	1		DO	1	1	SA2					
	2		3/4" THREADED ROD	1	3	SA3			BEND		
	4		3/4" HEX NUTS			SHOP					
	4		3/4" WASHERS			DO					
	4		3/4" EXR BOLTS	9		FIELD			W/NEW		
SIDEWALK BLOCKOUTS (PAY ITEM 506.60)											
	4		10x4x7	5	102	CE1			BEND		
	12		DO	2	82	CV1			DO		
	12		DO	5	32	CD1			DO		
	12		1/2" CONC STUBS	4	SHOP						
PAY ITEM 506.50 (UNLESS NOTED)											

OUT FOR APPROVAL 2/1/10

OUT FOR APPROVAL

ISSUED TO SHOP

FIELD & OFFICE

REV.	REMARKS	DATE	DWN	CHK	APP	Q.A.	NO.	DIA.	LGT	TYPE	WASHER	
PROJECT NO. 84F-6400(31)	STATE PROJECT NO. BRIDGE NO. 5											
MATERIAL: SUBSECTION	ELECTRODES: PROC	HOLES: AS NOTED	SHOP BOLTS:									
SURFACE PREP. & PAINT:												
GALVANIZE AFTER FAB - ASTM-A123												
DESCRIPTION: SCUPPERS, DOWNSPOUTS, CURBS												
JOB:	TH9-TAYLOR ST. BRIDGE NO. 5											
	MONTPELIER, VERMONT											
CUSTOMER: WINTERSET												
DRAWN BY:	JPF	DATE:	1-10									
CHKD BY:	CR											
APPROV BY:												
Q.A.												
CASCO BAY STEEL STRUCTURES, INC.												
75 SPRING HILL ROAD SACO, MAINE 04072												
PHONE (207) 282-7360 FAX (207) 282-1179												
JOB NO.	434	DRG. NO.	M1									
REV.												