

LEGEND

- T - - - AERIAL TELEPHONE
- [Hatched Box] DISTURBED AREAS REQUIRING RE-VEGETATION
- ▲-○ LIMITS OF SOIL DISTURBANCE
- - - RIPARIAN BUFFER ZONE

SOIL CLASSIFICATION

VERSHIRE B
GLOVER ROCKY LOAMS
3% TO 8% SLOPES
"K FACTOR" 0.49
CLASSIFIED HIGH EROSION POTENTIAL

MAP 10 BLOCK 1 LOT 39-11
N/F
JOHNS H. CONGDON &
JOANNE B. CONGDON
VOL. 76 PAGES 419-420


MAP 10 BLOCK 2 LOT 26
N/F
JAMES SHELDON-DEAN
& ABBY SHELDON-DEAN
VOL. 33 PAGE 186

MAP 10 BLOCK 2 LOT 27
N/F
JAMES L. MORSE
& GRETCHEN B. MORSE
VOL. 31 PAGES 165-166

SOIL CLASSIFICATION

HADLEY
VERY FINE SANDY LOAMS
0% TO 3% SLOPES
"K FACTOR" 0.49
CLASSIFIED HIGH EROSION POTENTIAL

MAP 10 BLOCK 2 LOT 27
N/F
JAMES L. MORSE &
GRETCHEN B. MORSE
VOL. 31 PAGES 165-166

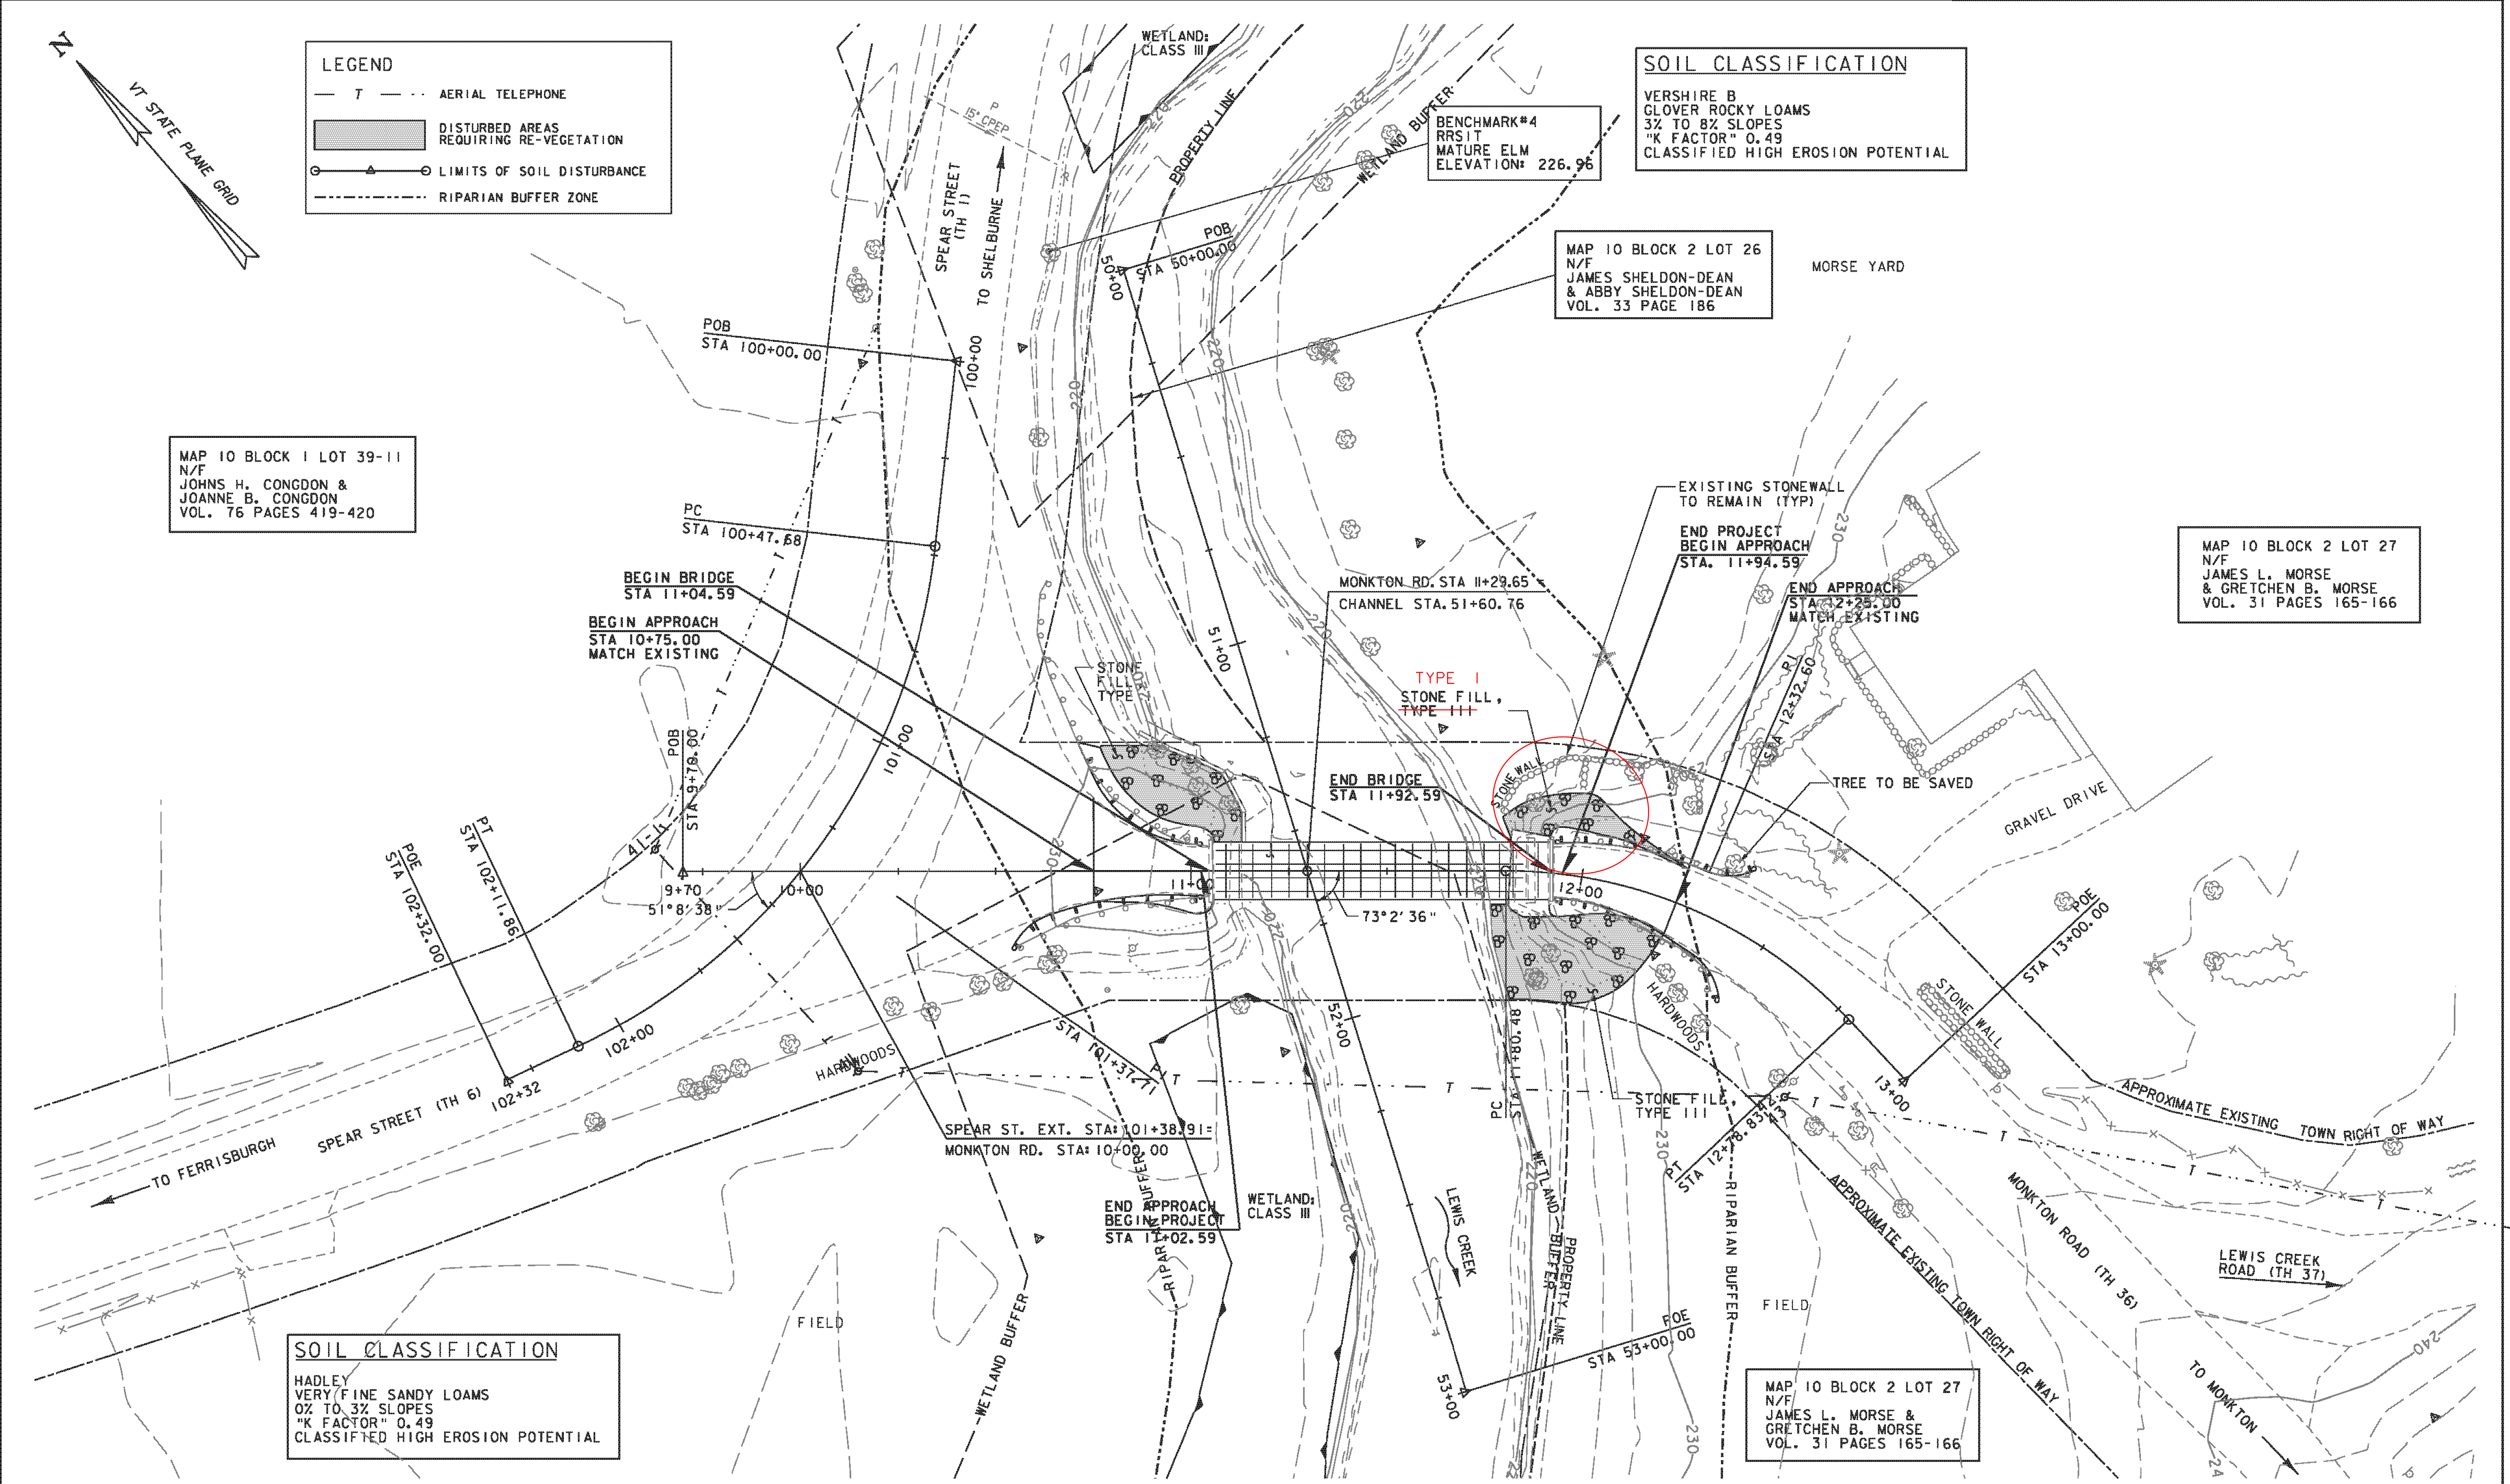

SCALE 1" = 20'-0"
20 0 20

DATUM
VERTICAL: NAVD 88
HORIZONTAL: NAD 83 (07)



PROJECT NAME: CHARLOTTE	PLOT DATE: 10/4/2012
PROJECT NUMBER: BHO 1445(34)	DRAWN BY: J.W. GOLEK
FILE NAME: z06j088bdr_ero.dgn	CHECKED BY: B.O. CRONIN
PROJECT LEADER: M.A. COLGAN	SHEET 13 OF 55
DESIGNED BY: J.W. GOLEK	
EPSC FINAL CONDITIONS SITE PLAN	